


13871.TIF

HISTORICAL DATA

11039.TIF
SWING TIES

FOUND 1/2" I.P. NO TAG
IN WELL, DOWN 1.00'
NOTE: WELL HAS GATE VALVE
LID AS COVER

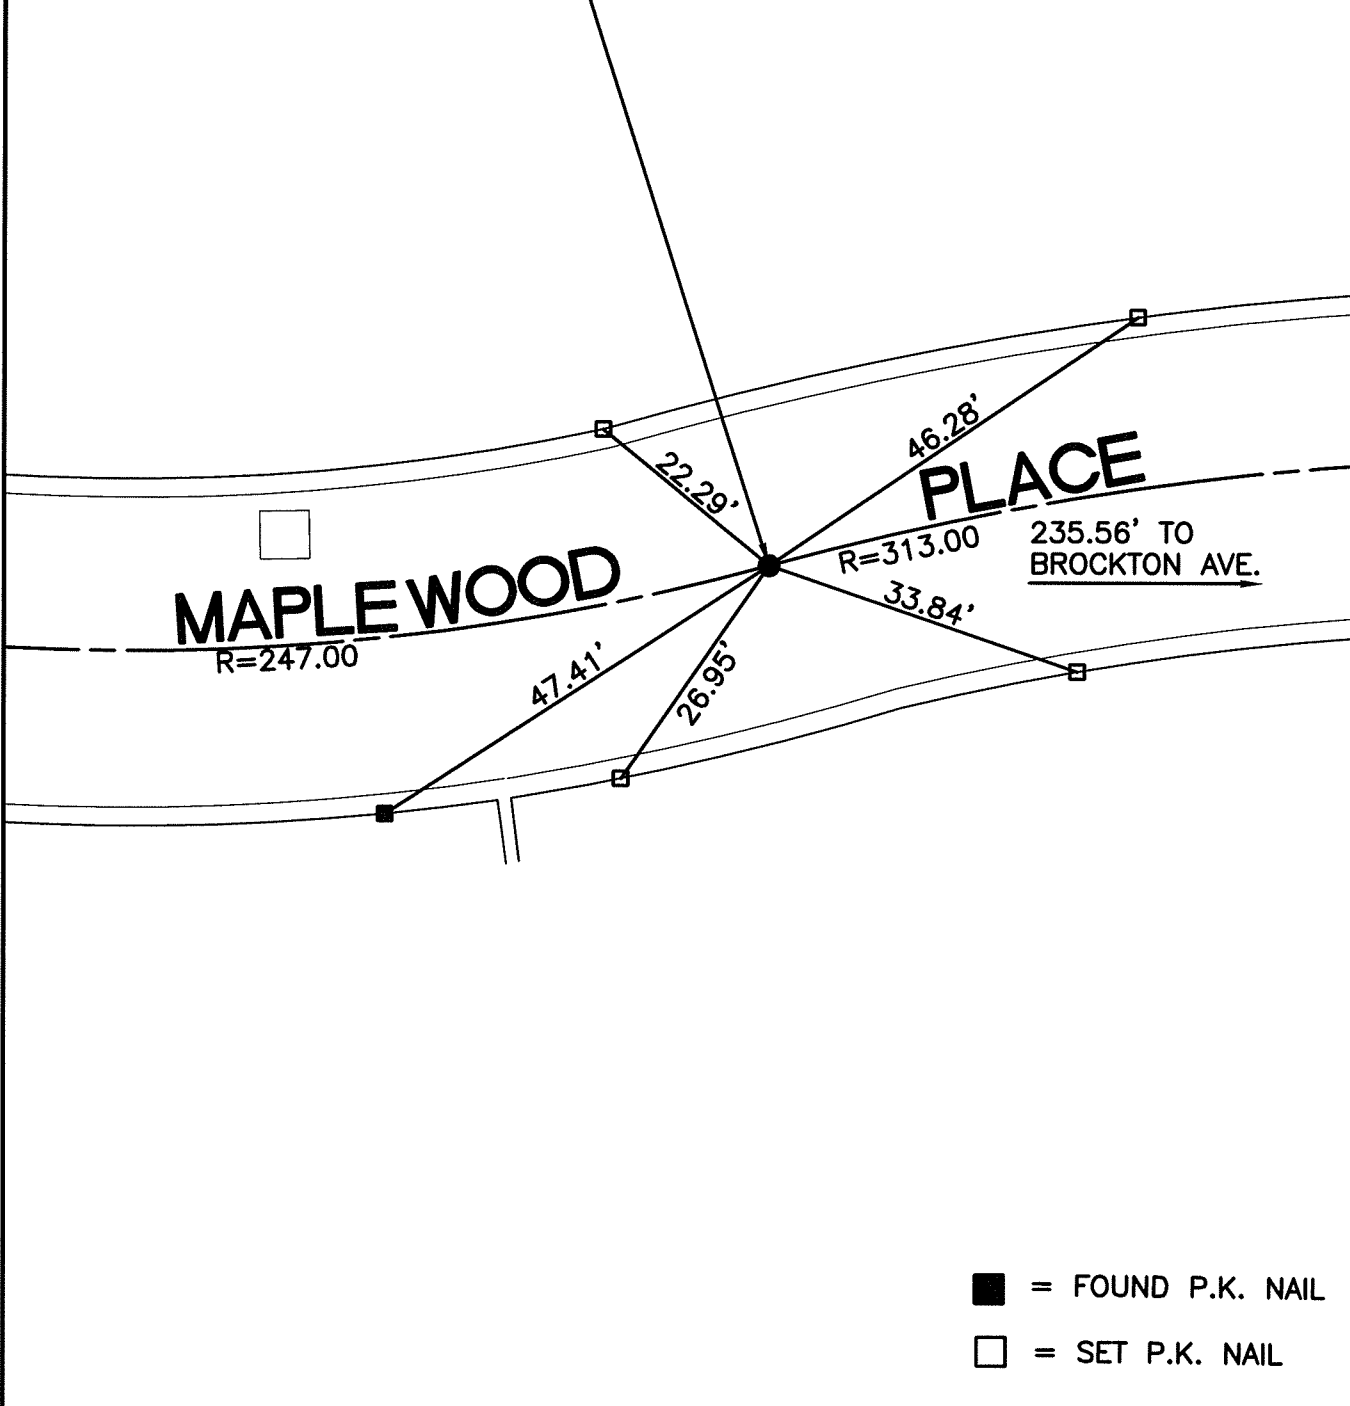

STREET: MAPLEWOOD PLACE

OFFICIAL USE ONLY

X-STREET: BC

SCALE: 1"=20'

DATE: 05/10/2011


DRAWN BY: B DURENTE

F.B.: SEE HISTORICAL DATA

SEC: 27 T.2 S., R.5 W

OFFICIAL TIE PLAT
CITY OF RIVERSIDE

THESE TIES ARE FOR THE PURPOSE OF PERPETUATING THE FOUND
MONUMENTATION. NO CLAIM IS MADE AS THE RELATIONSHIP OF THE
POINTS OR LINES SHOWN HEREON TO TRUE BOUNDARY LOCATIONS

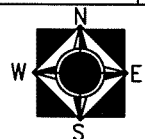

SHEET 1 OF 1