



CENTERLINE TIE SHEET

SHEET 4 OF 5

14377.TIF

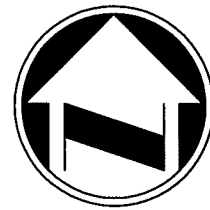

NOT TO SCALE

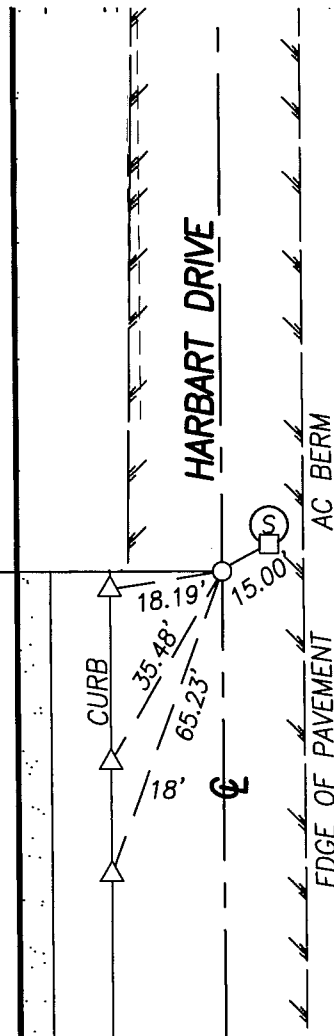

LOT 10

TRACT NO. 33029-1  
MB 434 / 60-63

**SURVEYOR'S NOTES**

- -INDICATES SET 1"IP & LS 5390 TAG FLUSH PER TRACT NO. 33029-1, MB 434/60-63
- △ -INDICATES SET LEAD & LS 5390 "TIE" TAG IN TOP OF CURB
- -INDICATES SET PUNCH MARK ON MANHOLE RIM

PLAT PREPARED BY:

**adkan**  
**ENGINEERS**

Civil Engineering · Surveying · Planning  
6879 Airport Drive, Riverside, CA 92504  
Tel:(951) 688-0241 · Fax:(951) 688-0599

CENTERLINE TIE SHEET

TRACT NO. 33029-1, MB 434 / 60-63