


# SWING TIES

**HISTORICAL DATA**

- 4311.TIF
- [xx.xx] RECORD DISTANCE PER MAP OF ROYAL GROVES UNIT NO. 1 MB 28/21-22
- {xx.xx} RECORD DISTANCE PER MAP OF LINCOLN KNOLLS TRACT, MB 28/86-87

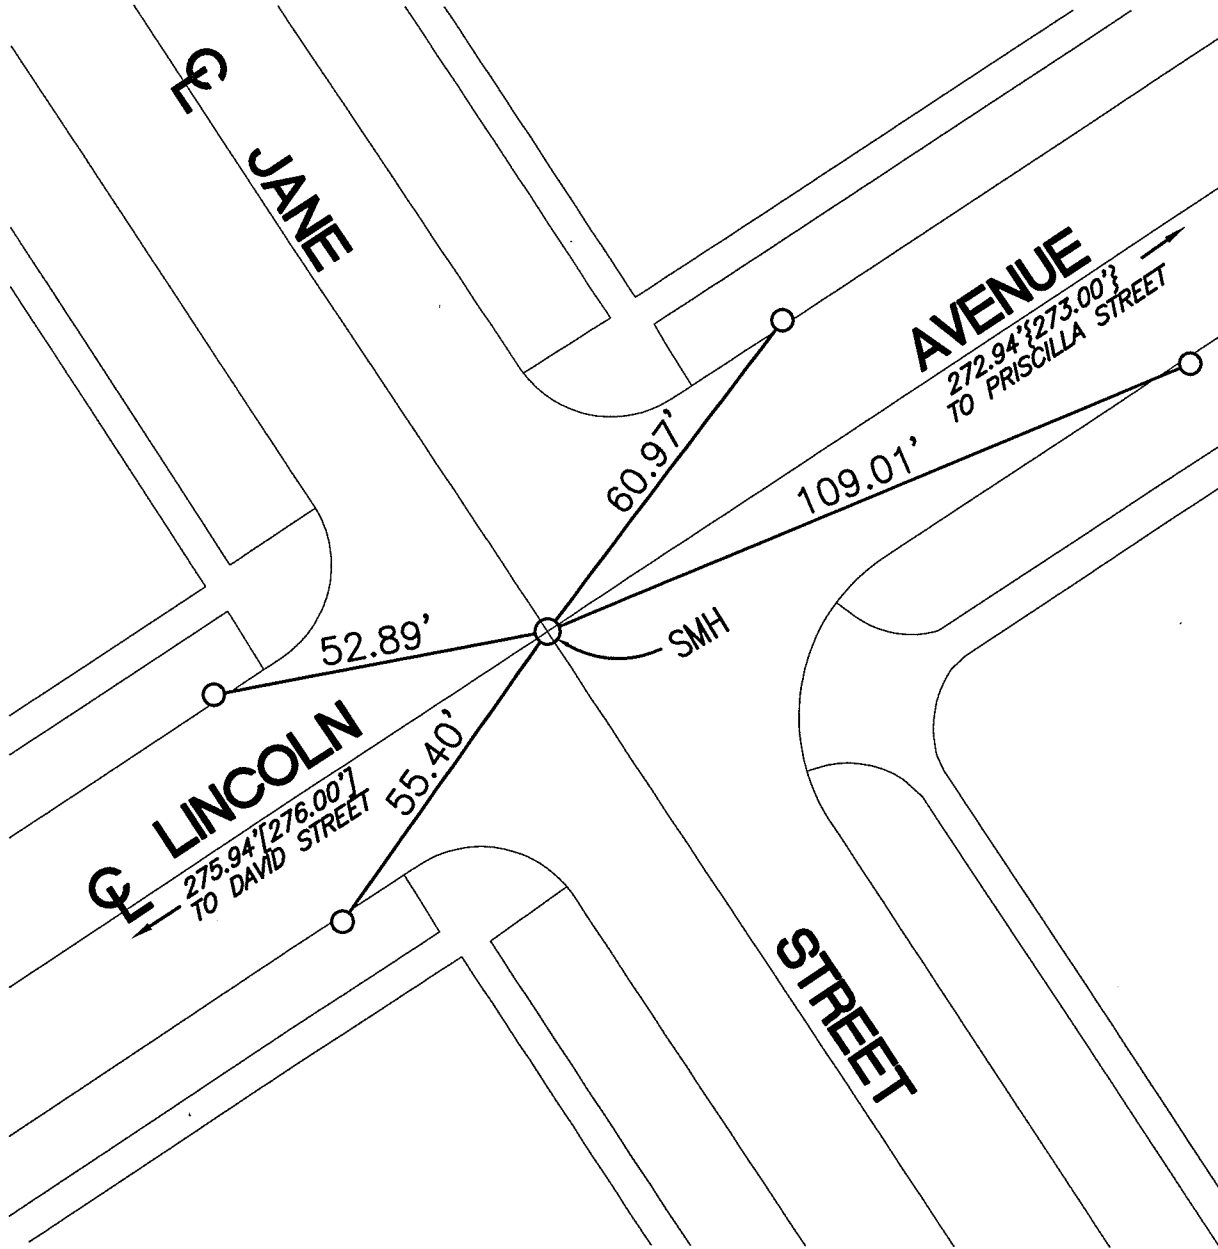

○ - SET CTT IN T.C.

\*\* INTERSECTION FALLS ON SEWER MANHOLE, NO TIES WERE FOUND. INTERSECTION WAS ESTABLISHED BY PROPORTIONED DISTANCE BETWEEN DAVID STREET AND PRISCILLA STREET

STREET: LINCOLN AVENUE

X-STREET: JANE STREET

OFFICIAL USE ONLY

14448.TIF

SCALE: 1"=30'

DATE: AUGUST 26, 2016

DRAWN BY: JDF

F.B.:

SEC: 2 T.3S.,R.5W

## OFFICIAL TIE PLAT CITY OF RIVERSIDE

THESE TIES ARE FOR THE PURPOSE OF PERPETUATING THE FOUND MONUMENTATION. NO CLAIM IS MADE AS THE RELATIONSHIP OF THE POINTS OR LINES SHOWN HEREON TO TRUE BOUNDARY LOCATIONS



SHEET 1 OF 1