


STREET ~~CYNTHIA~~ X-STREET ~~HOLLENBECK~~
OFFICE USE ONLY

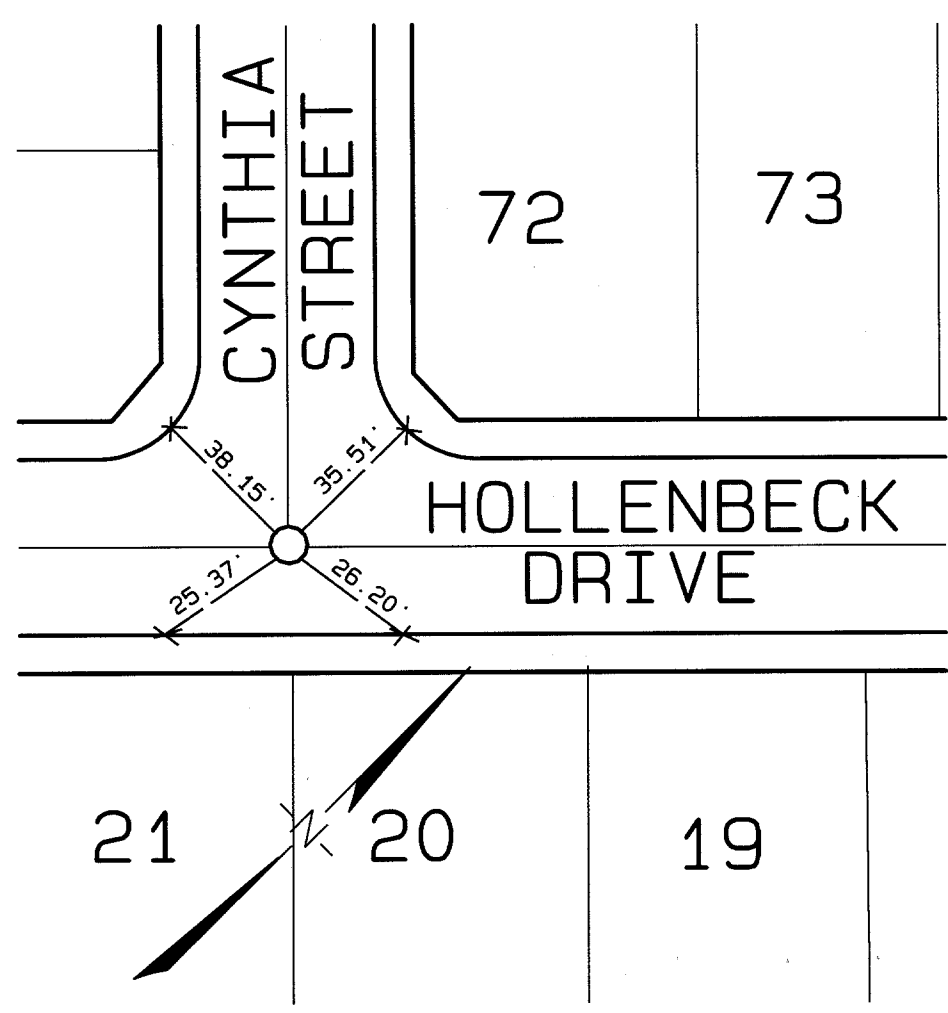

TRACT NO. 6992

SCALE: 1"=50'	OFFICIAL TIE PLAT CITY OF RIVERSIDE	SHEET
DATE: 10/10/96		5
DR. BY: bel	PREPARED BY: ALBERT A. WEBB ASSOCIATES	OF 8 SHEETS
W.O.: 76-85		FILE NO.:
F.B.:1039/103-105		