


STREET CALIFORNIA AVE. X-STREET BOLTON AVE. OFFICE USE ONLY

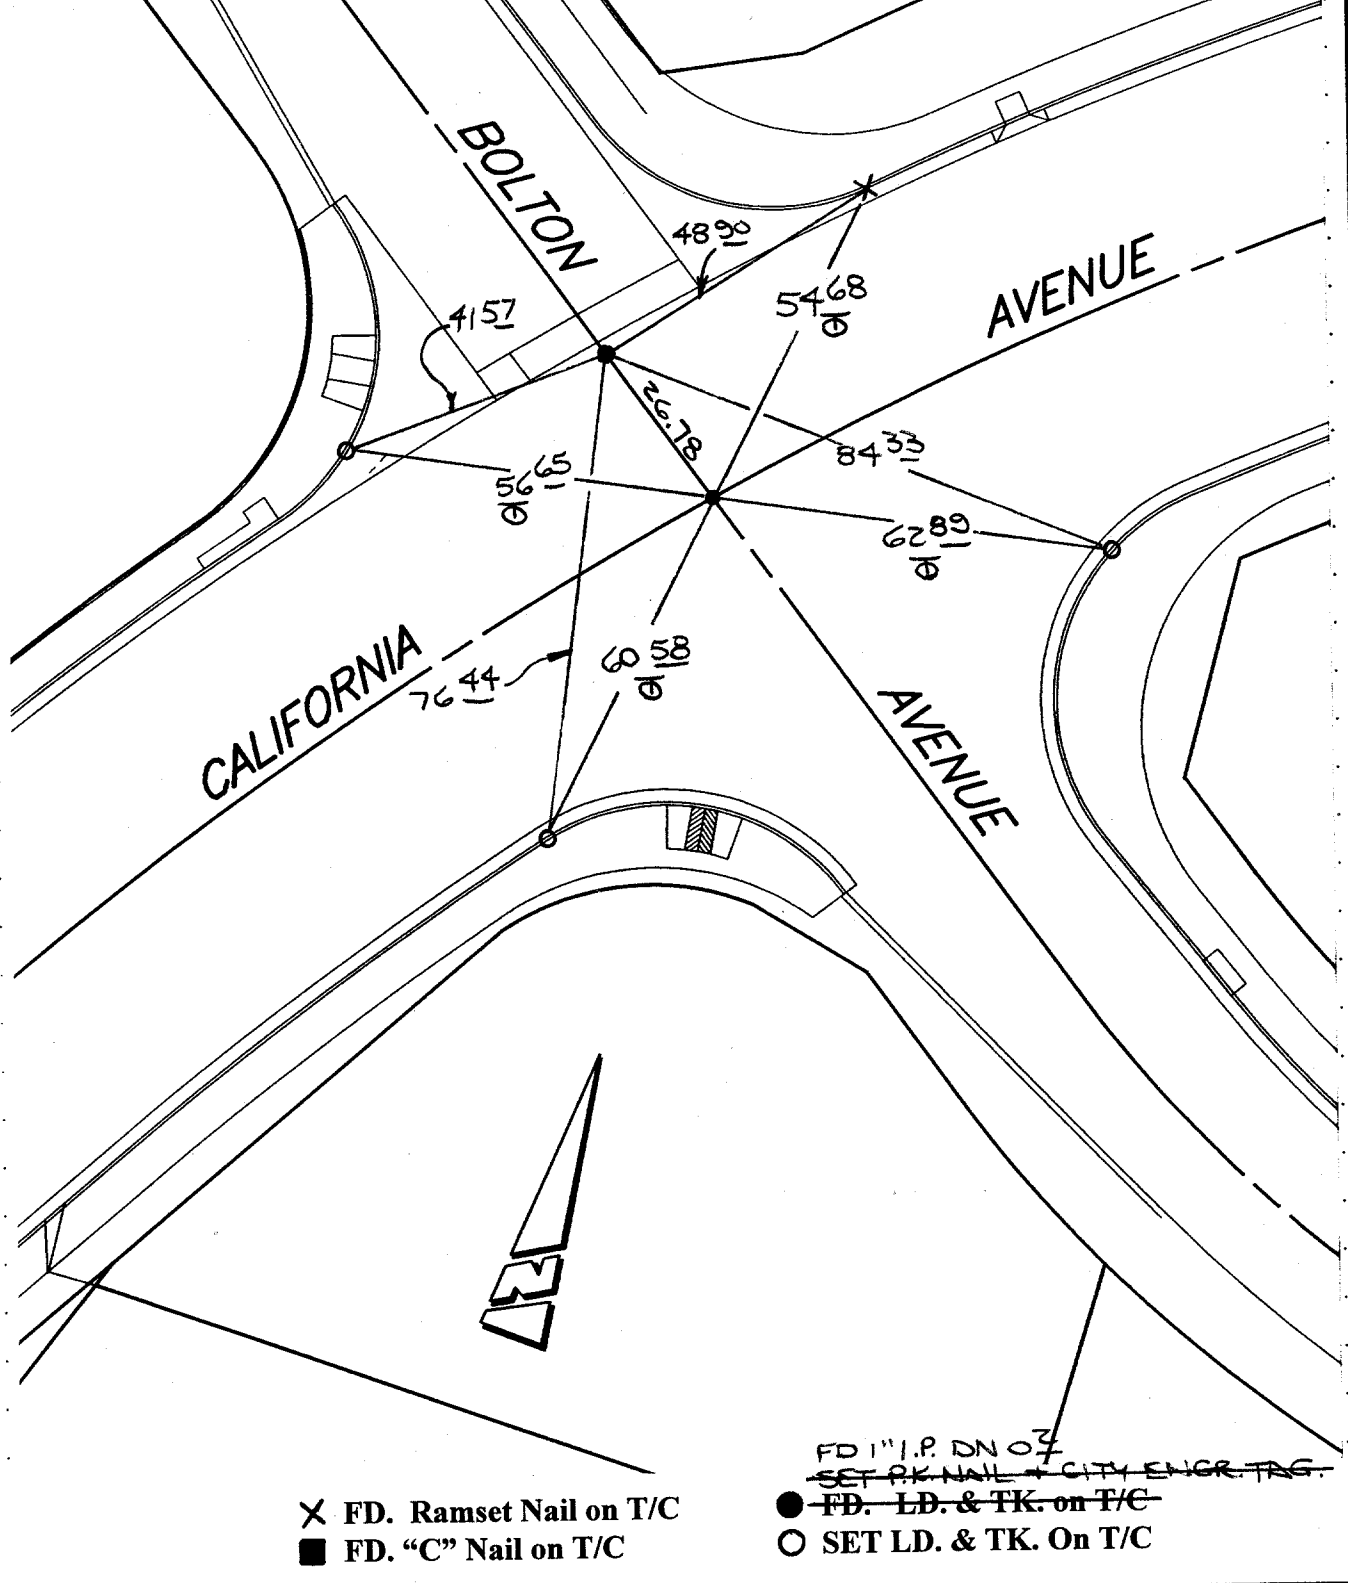

- ✕ FD. Ramset Nail on T/C
- FD. "C" Nail on T/C

- ~~FD. LD. & TK. on T/C~~
 - SET LD. & TK. On T/C
- FD 1" I.P. DN 07
~~SET PK NAIL CITY ENGR. TRG.~~

SCALE: 1" = 30'
 DATE: 3-24-97
 DR. BY: LOPEZ
 W.O.: KT1000
 F.B.:

OFFICIAL TIE PLAT

CITY OF RIVERSIDE

*These ties are for the purpose of perpetuating the found
 monumentation. No claim is made as to the relationship of
 the points or lines shown hereon to true boundary locations.*

SHEET
 1
 OF 1 SHEETS
 FILE NO.: