


3010.TIF

Street: ELSINORE RD.

X-Street: NOTTINGHAM

OFFICIAL USE ONLY

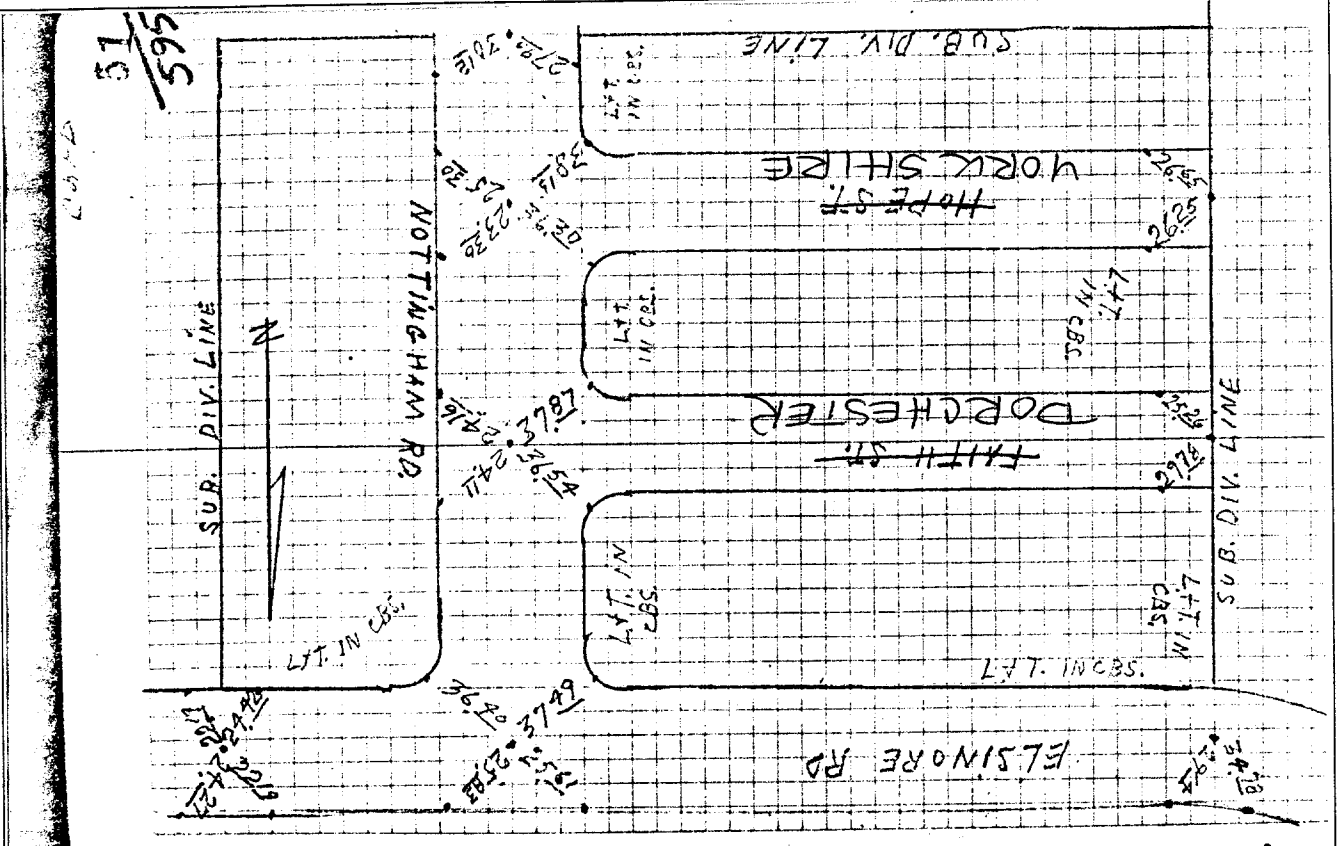

ELSINORE ROAD
 NOTTINGHAM RD
~~FIFTH ST~~ DORCHESTER
~~HOPPE ST~~ YORKSHIRE
 & TIES

8-15-56
 BRADLEY
 BERKEY

ALL POINT 3/4" I. PIPE
 PENNY RE. 862.

Elsinore Heights

- ✗ FD. Ramset Nail on T/C
- FD. "C" Nail on T/C

- FD. LD. & TK. on T/C
- Set LD. & TK. on T/C

Scale:
 Date:
 Drawn by:
 W.O.:
 F.B.:

OFFICIAL TIE PLAT

CITY OF RIVERSIDE

These ties are for the purpose of perpetuating the found monumentation. No claim is made as to the relationship of the points or lines shown hereon to true boundary locations.

Sheet 1 of 1
 File No.: