

FILE 11-7925


F.B.:
W.O.:
Drawn by: scurtis
Date: 11/17/98
Scale: 1" = 20'

OFFICIAL TIE PLAT

CITY OF RIVERSIDE


These ties are for the purpose of perpetuating the found monumentation. No claim is made as to the relationship of the points or lines shown hereon to true boundary locations.

File No.:
Sheet 1 of 1

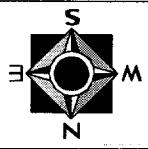

- × FD. Ramset Nail on T/C
- FD. "C" Nail on T/C
- FD. LD. & TK. on T/C
- Set LD. & TK. on T/C

Street: **THIRD**
X-Street: **FRANKLIN**
OFFICIAL USE ONLY

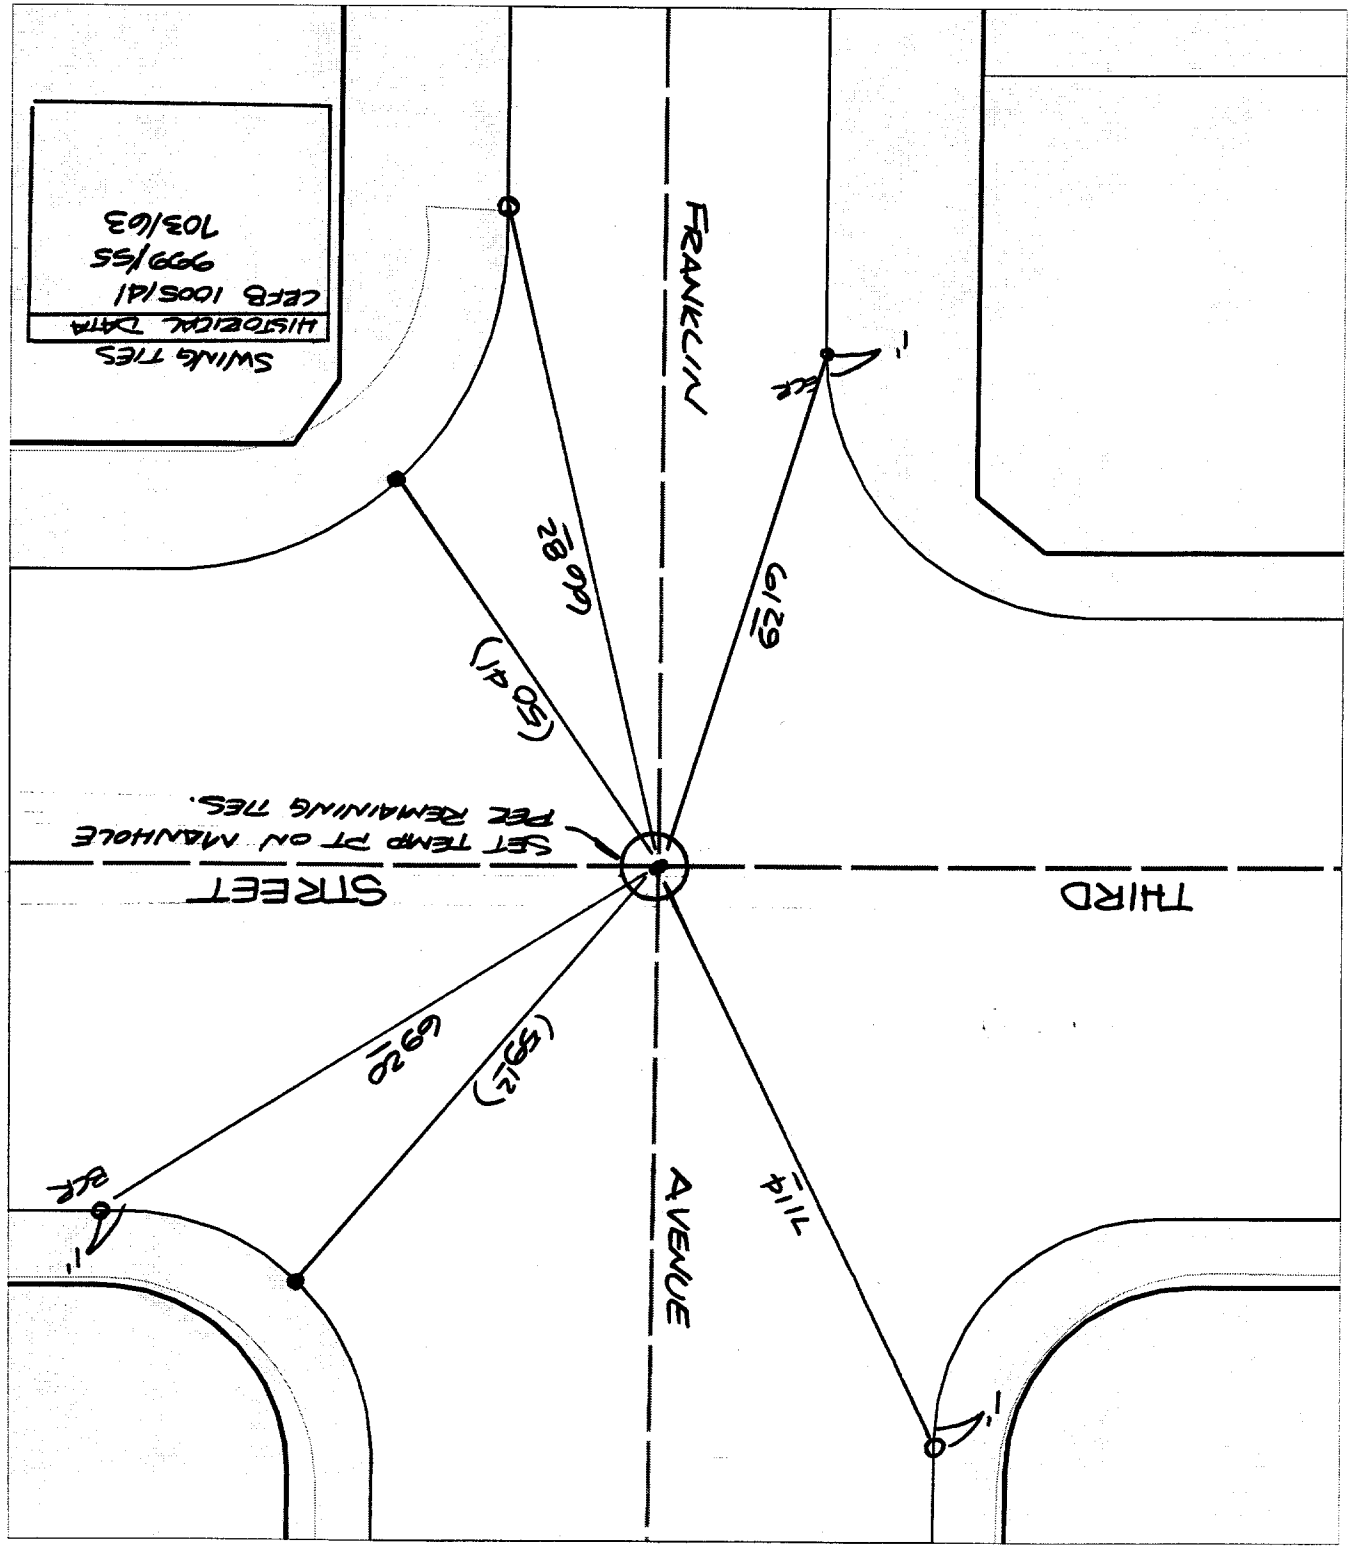

SWING TIES
CEFB 1005/1
999/55
703/63

SET TEMP PT ON MANHOLE
PER REMAINING TIES.

THIRD STREET

FRANKLIN

AVENUE

THIRD

FRANKLIN