


FILE NO.: 103-105	DR. BY: del
OF 8 SHEETS	DATE: 10/10/96
1 SHEET	SCALE: 1"=50'
PREPARED BY: ALBERT A. WEBB ASSOCIATES	
OFFICIAL TIE PLAT CITY OF RIVERSIDE	

STREET \_\_\_\_\_ ~~JONES~~ \_\_\_\_\_ X-STREET \_\_\_\_\_ ~~HOUE~~ \_\_\_\_\_  
 OFFICE USE ONLY

*FILE 94471F*  
 TRACT NO. 6992

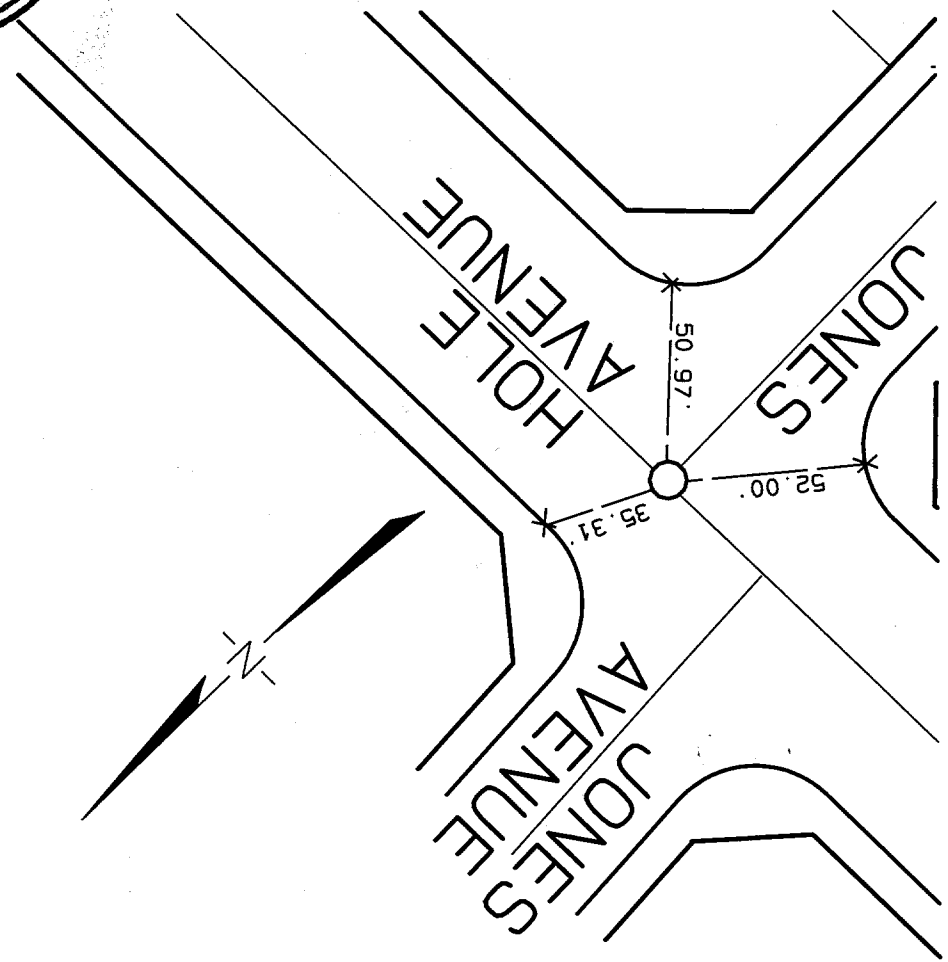

○ 1" IRON PIPE TAGGED R.C.E. 9876 , FLUSH  
 X = STEEL PIN & TAG R.C.E. 9876 IN T.C.

(14A)