


FILE NO.:  
OF 2 SHEETS  
SHEET 2

PREPARED BY: Douglas W. Beechcroft  
LS 4502 exp. 9-30-98

OFFICIAL TIE PLAT  
CITY OF RIVERSIDE


SCALE: N.T.S.  
DATE: May 5, 1998  
DR. BY: D.W.B.  
W.O.:  
F.B.:

FILE 8845

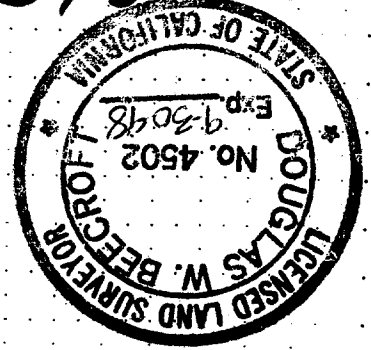

STREET MULL AVE X-STREET MOBLEY AVE  
OFFICE USE ONLY

STATEMENT OF PURPOSE:  
To establish ties to & monuments  
for the purpose of monumenting  
P.M. No. 28723

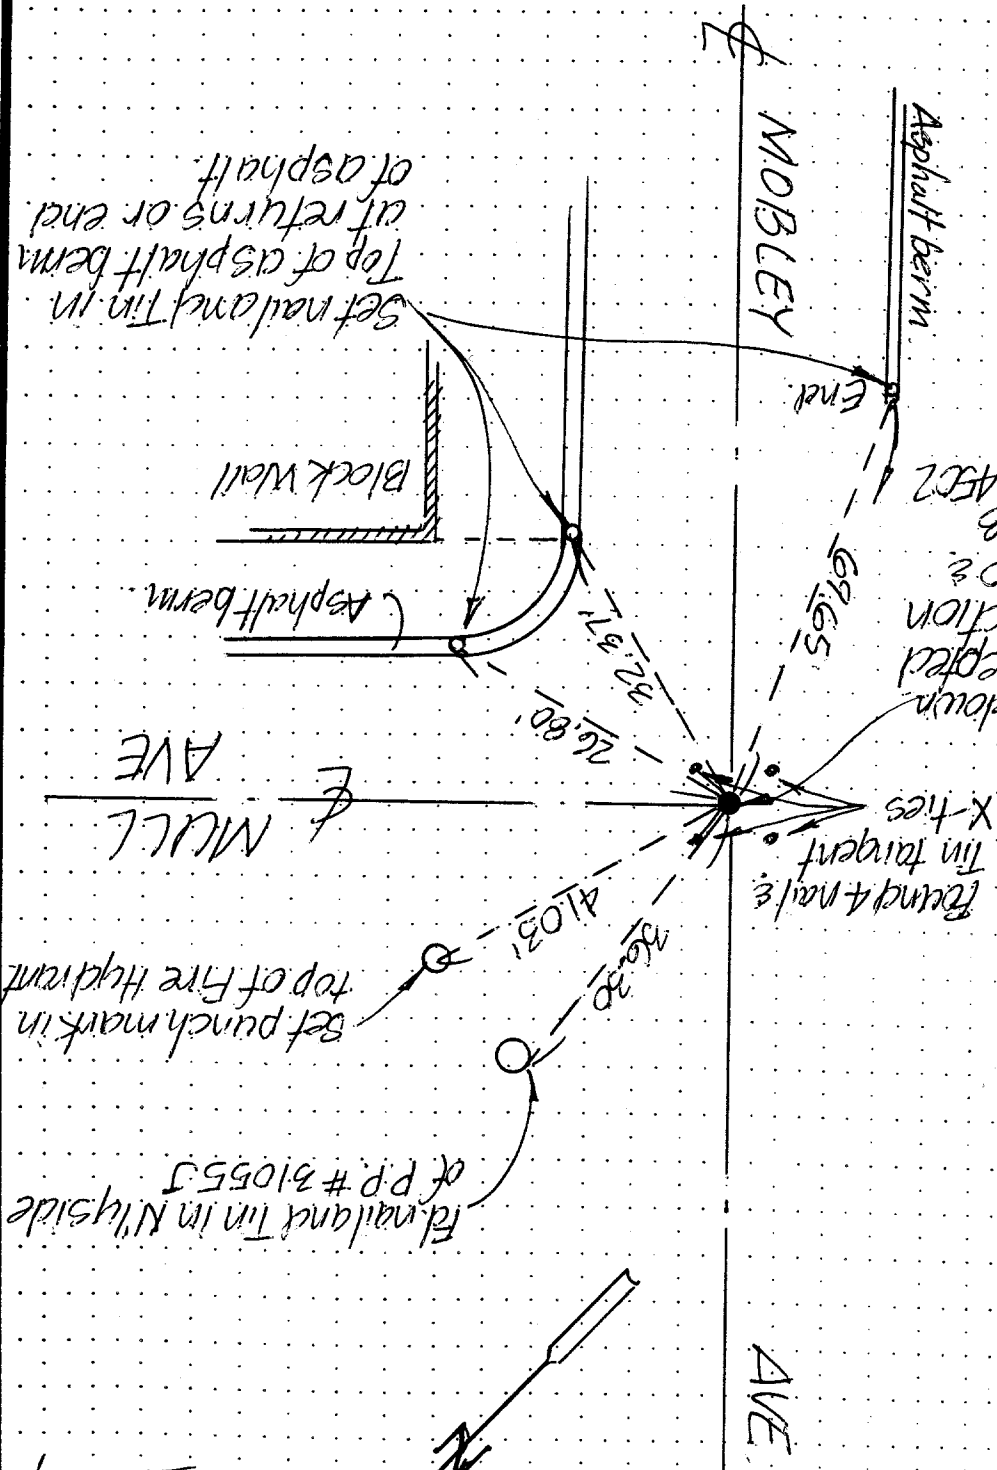

NOTE: All  
set tie points  
are not tangy.

Found and tin in N/ly side  
of P.P. # 310555  
Set punch mark in  
top of fire hydrant

Found 4 nails  
tin tangent  
X-ties

Found 2 1/2" P. down  
8" no tag, accepted  
as & intersection  
per P.M. 31902  
P.M. 82/56-58  
Set L.S. tag 4502

Set nail and tin in  
top of asphalt berm  
at returns or end  
of asphalt.