

Street: MYERS


~~5866.71C~~ OFFICIAL USE ONLY

X-Street: LINCOLN

~~5866.71C~~

MYERS  
@ LINCOLN

Joe Aguilera J. Perez D. Robertson 1032 161

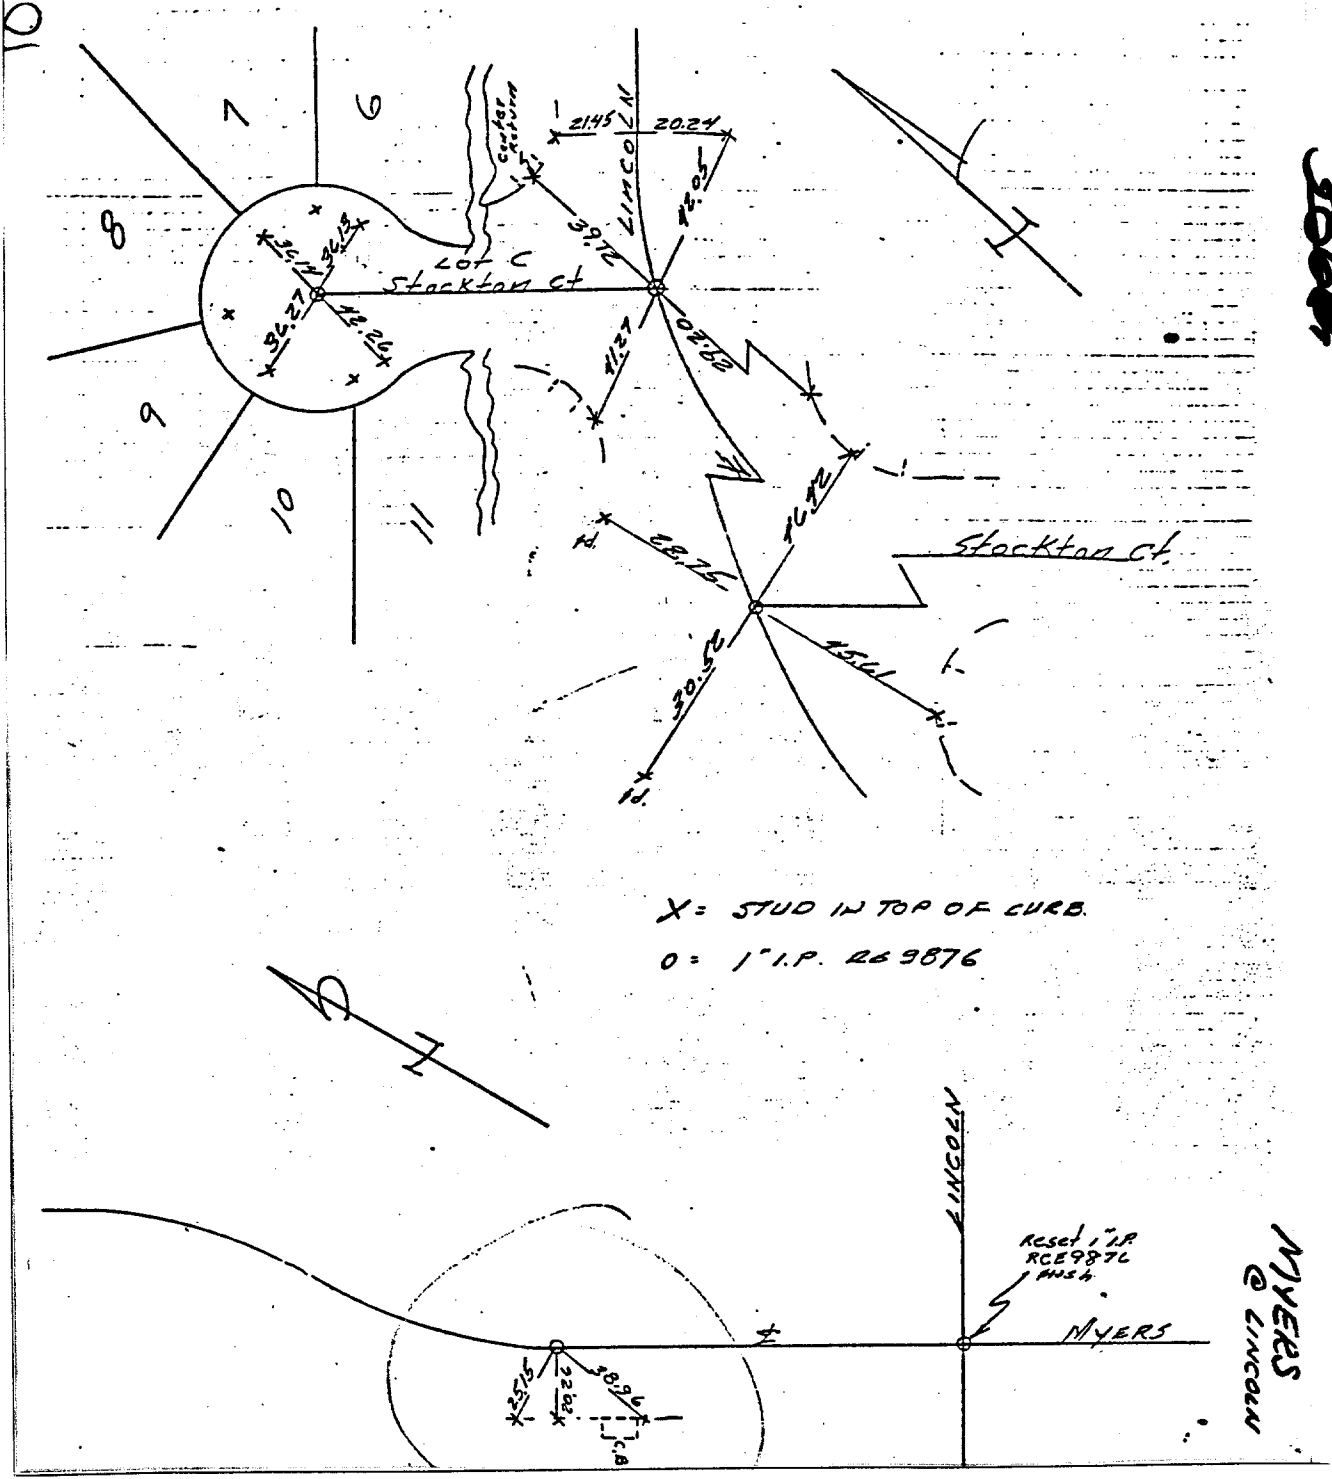

X = STUD IN TOP OF CURB.  
O = 1" I.P. 269876

- ✕ FD. Ramset Nail on T/C
- FD. LD. & TK. on T/C
- FD. "C" Nail on T/C
- Set LD. & TK. on T/C

Scale:  
 Date: 2-27-75  
 Drawn by:  
 W.O.:  
 F.B.:

## OFFICIAL TIE PLAT

### CITY OF RIVERSIDE

These ties are for the purpose of perpetuating the found monumentation. No claim is made as to the relationship of the points or lines shown hereon to true boundary locations.

TR 5513  
 Sheet 1 of 1  
 File No.: