


Street: Rumsey
7005. TIF

OFFICIAL USE ONLY

X-Street: EC - ~~EC~~ @ Carmel way

EC - ~~EC~~ @ Carmel way

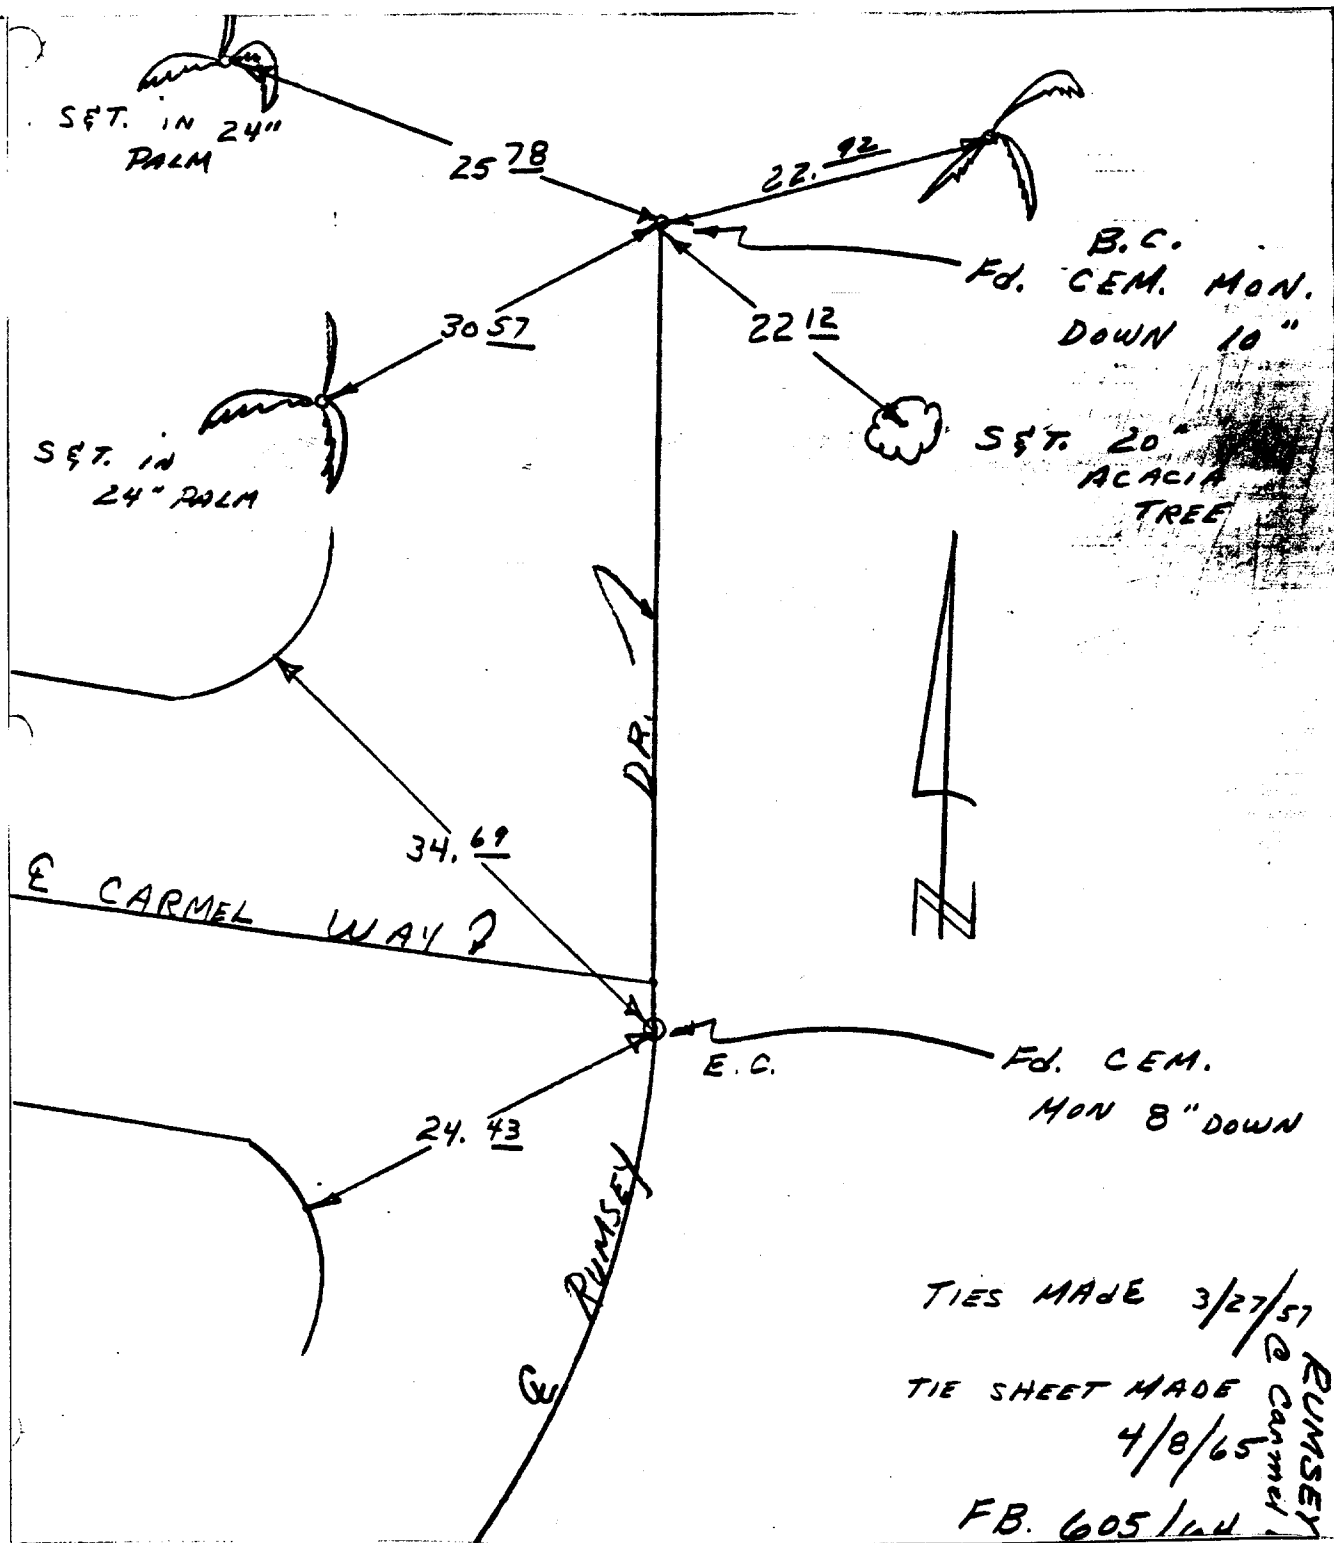

× FD. Ramset Nail on T/C
■ FD. "C" Nail on T/C

● FD. LD. & TK. on T/C
○ Set LD. & TK. on T/C

TIES MADE 3/27/57
TIE SHEET MADE 4/8/65
FB. 605/144
@ Carmel RUMSEY

Scale:
Date:
Drawn by:
W.O.:
F.B.:

OFFICIAL TIE PLAT CITY OF RIVERSIDE

These ties are for the purpose of perpetuating the found monumentation. No claim is made as to the relationship of the points or lines shown hereon to true boundary locations.

Sheet 1 of 1
File No.: