


SURVEY OF E TIES (TR 21834-3) SHEET 1 OF 2 SHEETS  
 OR U.S. HOMES W.O. No. 10972 Date 9-6-89  
 SURVEY PARTY ANNAROZZI STEAD CHACON REF. \_\_\_\_\_ A.M. \_\_\_\_\_

- SET 1" I.P. W. PP. LS. 3018 FLUSH  
 ○ - SET RAMSET ON T/C  
 △ - SET NAIL/TAG LS 3018 ON TP PROD. COTS 1-79

SURVEY NOTES

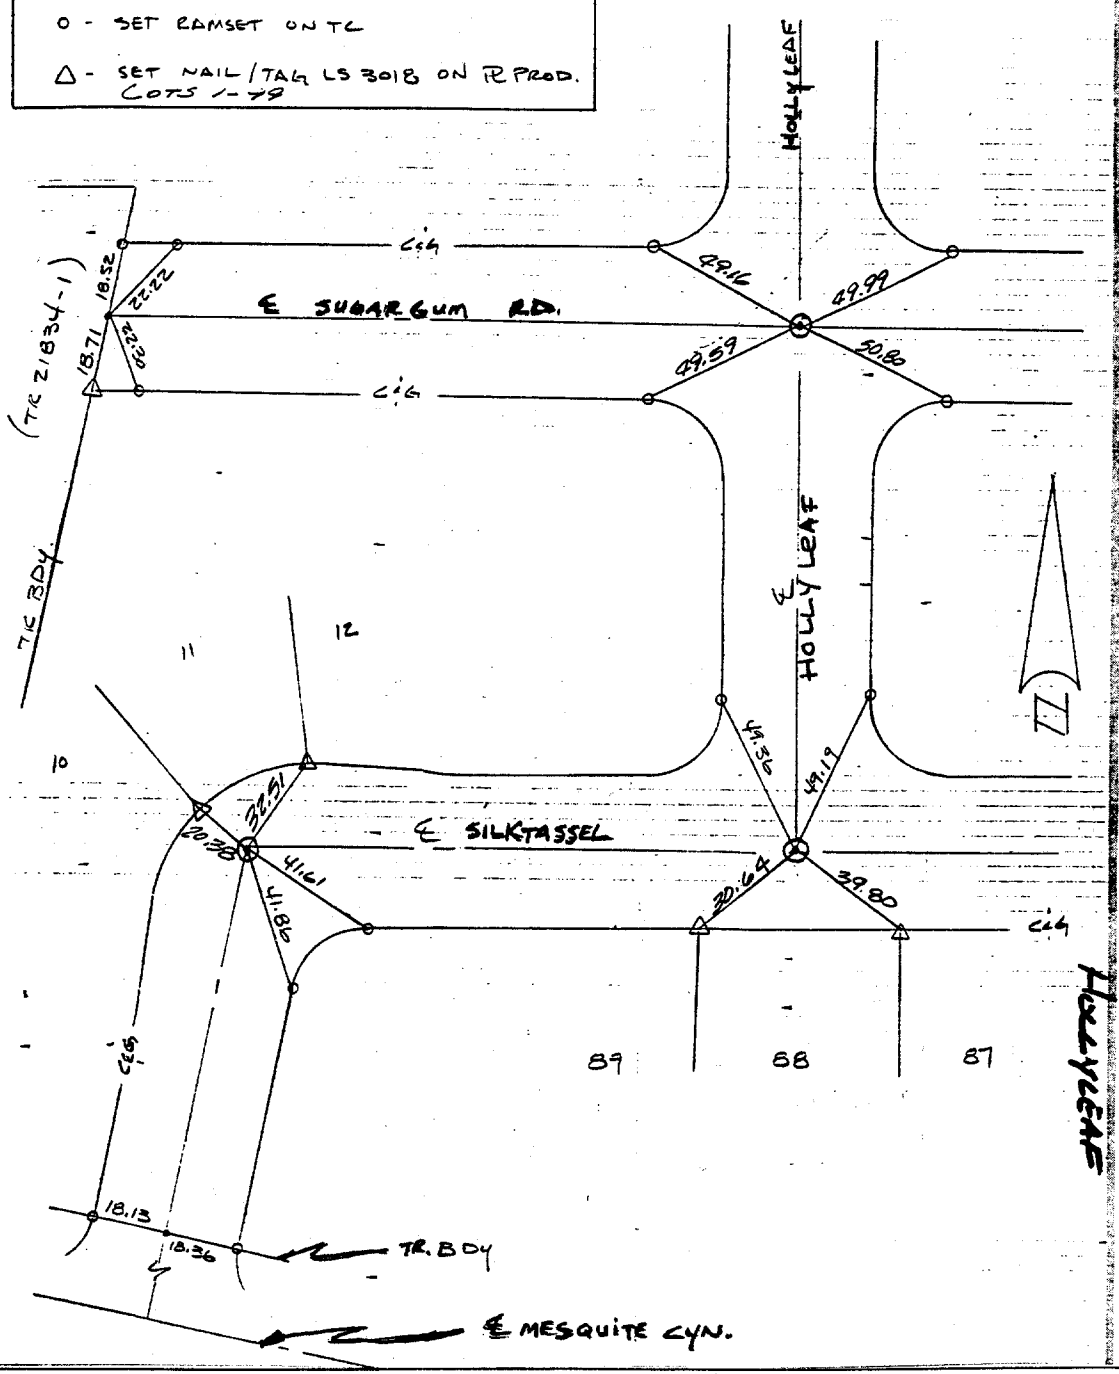

- X FD. Ramset Nail on T/C      ● FD. LD. & TK. on T/C  
 ■ FD. "C" Nail on T/C      ○ Set LD. & TK. on T/C

Scale: \_\_\_\_\_  
 Date: \_\_\_\_\_  
 Drawn by: \_\_\_\_\_  
 W.O.: \_\_\_\_\_  
 F.B.: \_\_\_\_\_

**OFFICIAL TIE PLAT**  
**CITY OF RIVERSIDE**

*These ties are for the purpose of perpetuating the found monumentation. No claim is made as to the relationship of the points or lines shown hereon to true boundary locations.*

Sheet 1 of 1  
 File No.: \_\_\_\_\_

Street: ~~SILKTASSEL~~  
**SILKTASSEL**  
 7321, 71F  
 X-Street: ~~HOLLY LEAF~~  
**HOLLY LEAF**  
 OFFICIAL USE ONLY