


909.71F

SWING TIES

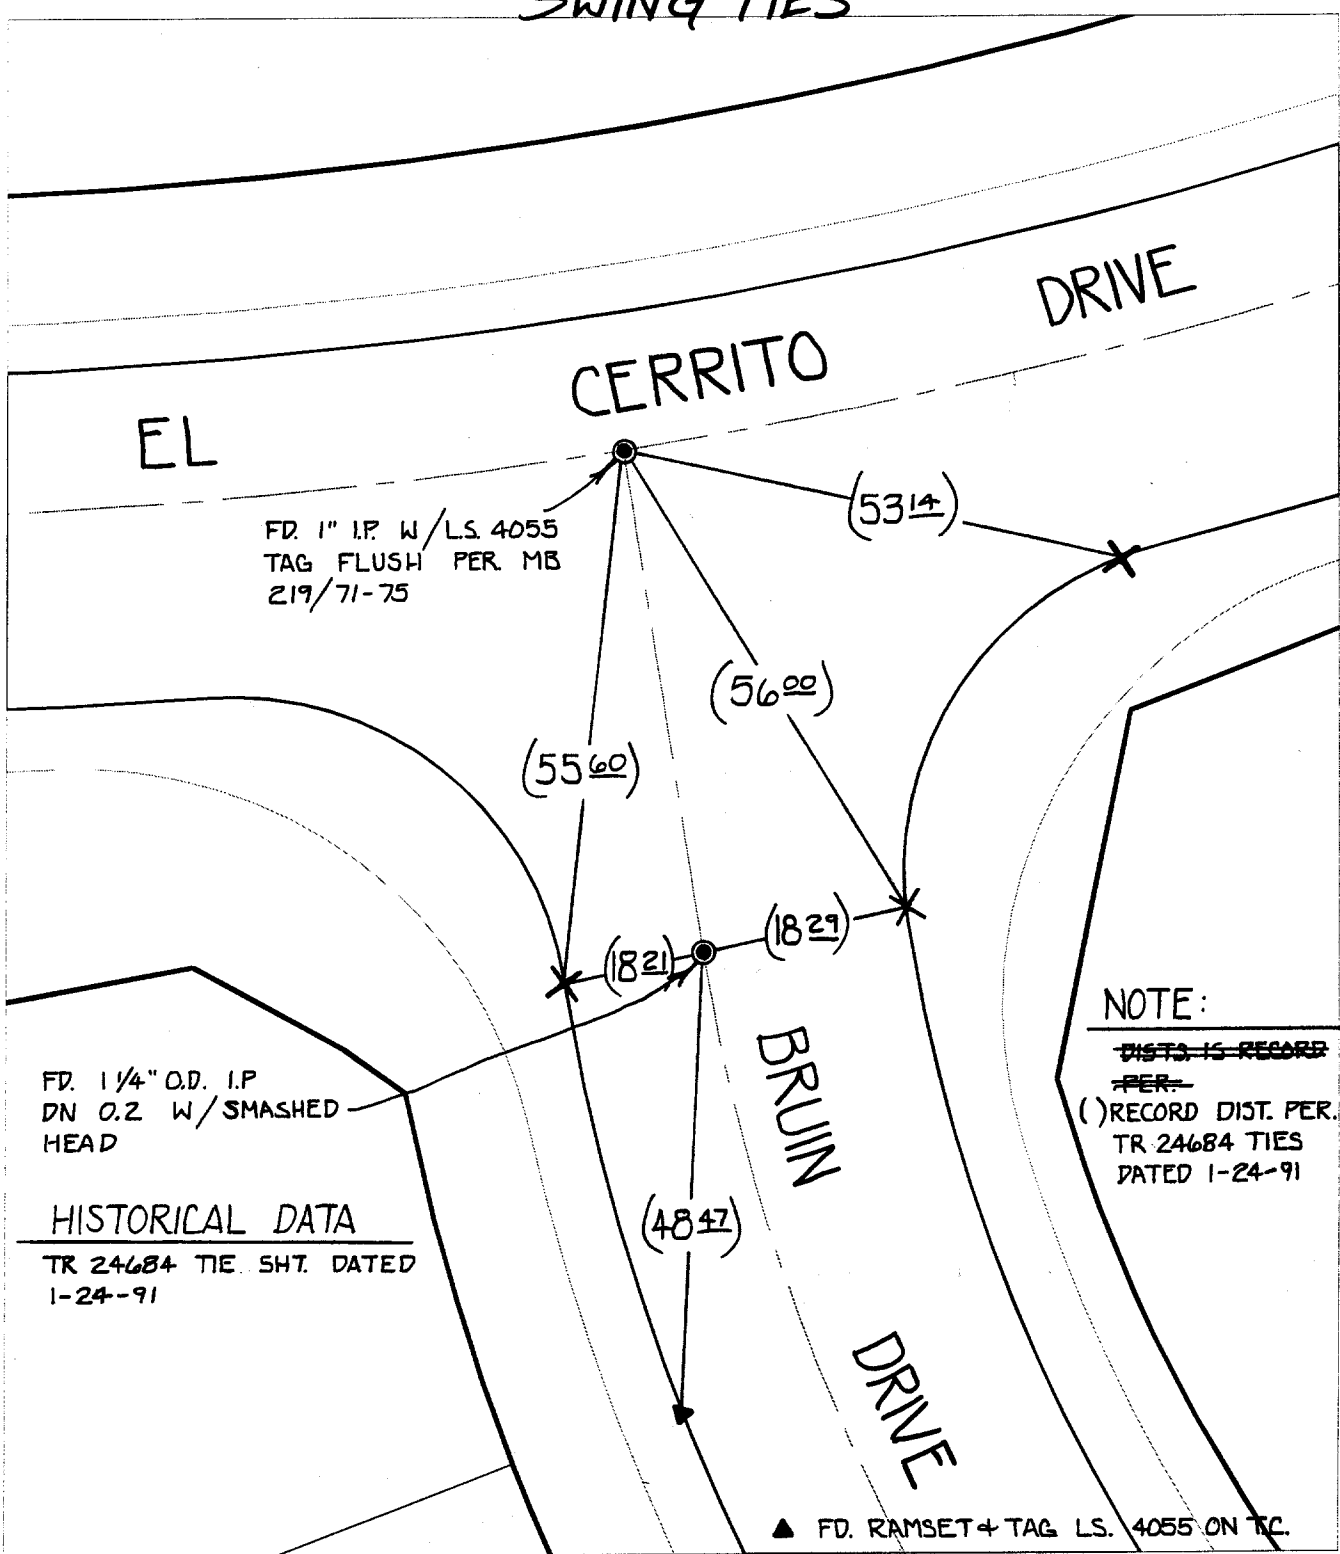

FD. 1" I.P. W/LS. 4055  
TAG FLUSH PER. MB  
2/19/71-75

FD. 1/4" O.D. I.P.  
DN 0.2 W/SMASHED  
HEAD

HISTORICAL DATA  
TR 24684 TIE. SHT. DATED  
1-24-91

NOTE:  
~~DISTS. IS RECORD~~  
~~PER.~~  
( ) RECORD DIST. PER.  
TR 24684 TIES  
DATED 1-24-91

▲ FD. RAMSET + TAG LS. 4055 ON T.C.

- ✕ FD. Ramset Nail on T/C
- FD. LD. & TK. on T/C
- FD. "C" Nail on T/C
- Set LD. & TK. on T/C

Street:

EL CERRITO DRIVE

X-Street:  
OFFICIAL USE ONLY

BRUIN DRIVE

Scale: 1" = 20'  
Date: 03/9/00  
Drawn by: SURVEY  
W.O.:  
F.B.:

**OFFICIAL TIE PLAT**  
CITY OF RIVERSIDE

*These ties are for the purpose of perpetuating the found monumentation. No claim is made as to the relationship of the points or lines shown hereon to true boundary locations.*



Sheet 1 of 1  
File No.: