


SWING TIES

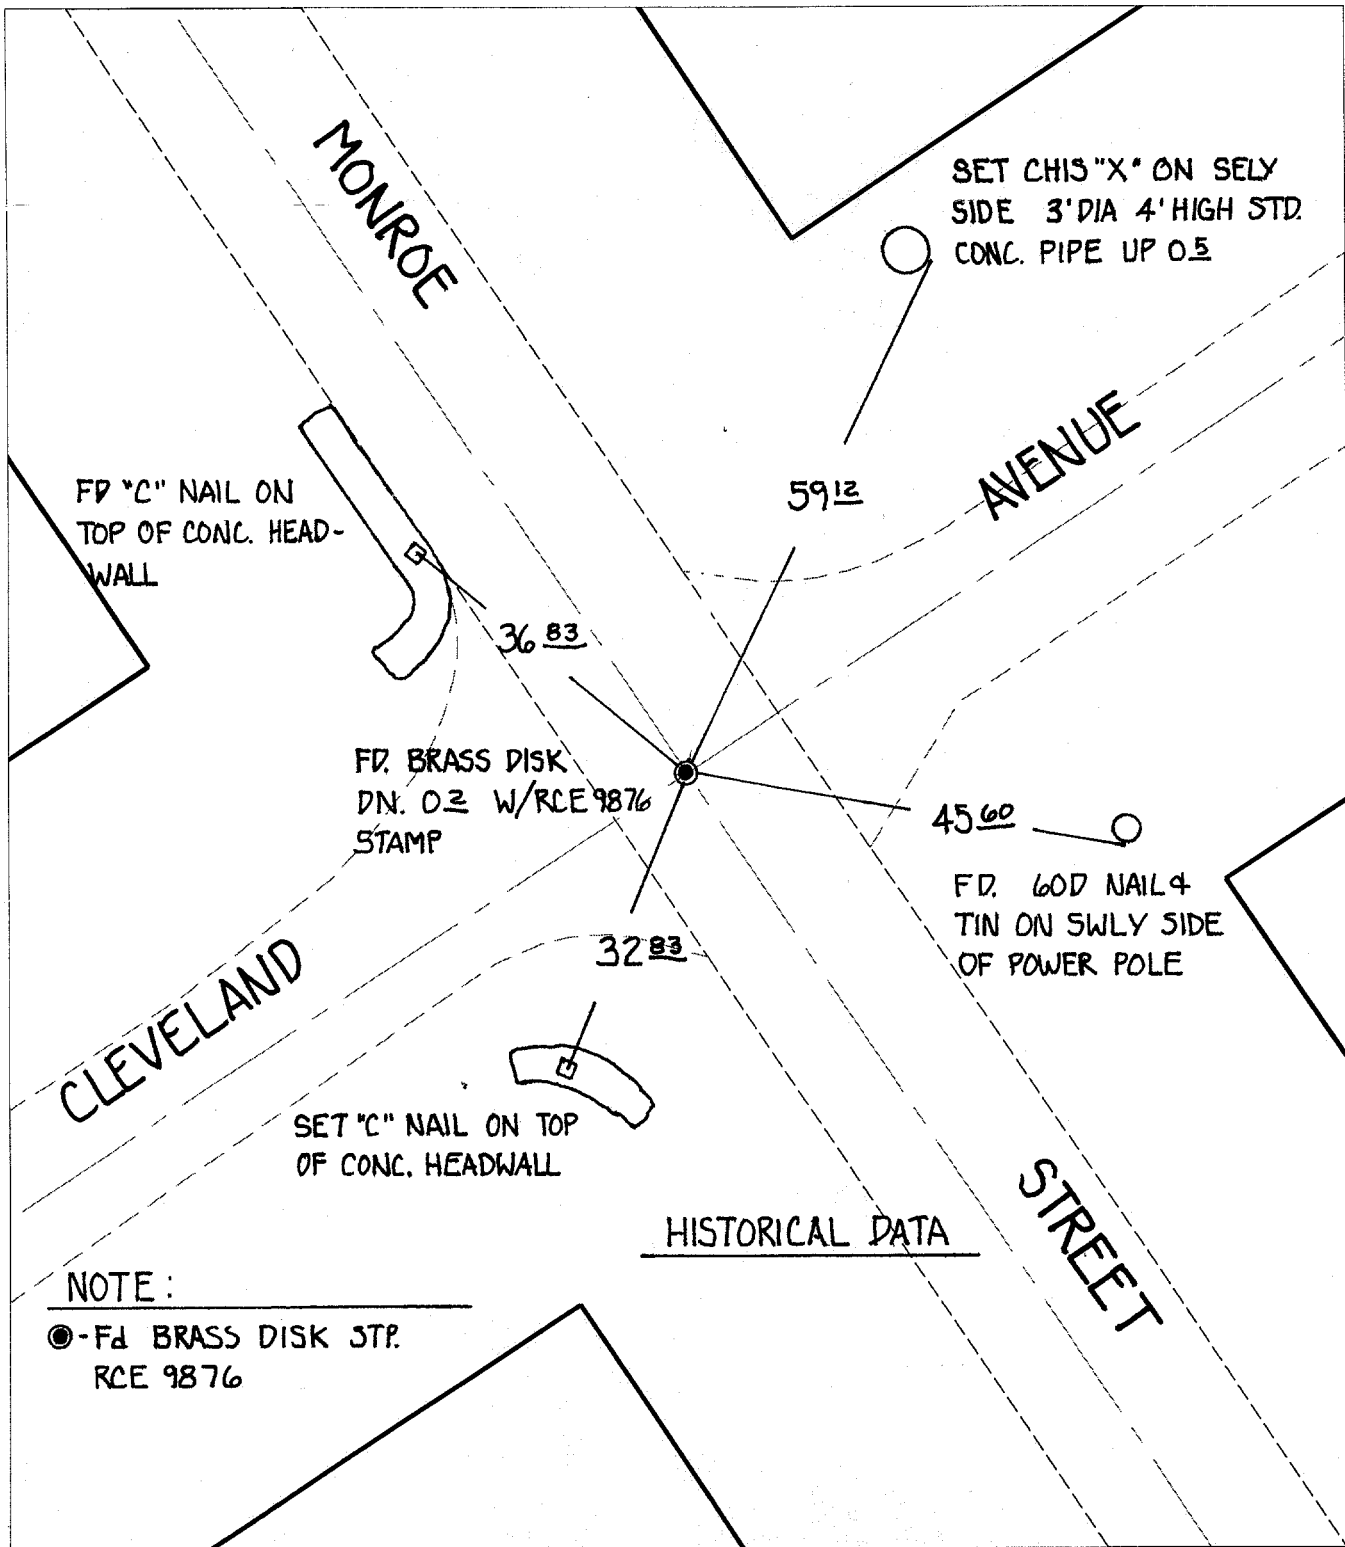

Street: 9902
 TIF
 MONROE STREET
 X-Street: CLEVELAND AVENUE
 OFFICIAL USE ONLY

SET THIS "X" ON SELY SIDE 3'DIA 4' HIGH STD. CONC. PIPE UP 0.5

FD "C" NAIL ON TOP OF CONC. HEADWALL

FD. BRASS DISK DN. 0.3 W/RCE 9876 STAMP

FD. 60D NAIL & TIN ON SWLY SIDE OF POWER POLE

SET "C" NAIL ON TOP OF CONC. HEADWALL

HISTORICAL DATA

NOTE:

- - FD BRASS DISK STP. RCE 9876

- ✕ FD. Ramset Nail on T/C
- FD. LD. & TK. on T/C
- FD. "C" Nail on T/C
- Set LD. & TK. on T/C

P.K. and City Engineer tag to be set @ surface after street construction is complete. (If possible)

Scale: 1" = 20'
 Date: 12/29/00
 Drawn by: SURVEY
 W.O.:
 F.B.:

OFFICIAL TIE PLAT CITY OF RIVERSIDE



These ties are for the purpose of perpetuating the found monumentation. No claim is made as to the relationship of the points or lines shown hereon to true boundary locations.

Sheet 1 of 1
 File No.: