

EQUIPMENT SCHEDULE

NO.	SIGNAL STANDARD TYPE	LUMINAIRE		S.N.S.		SIGNAL MOUNTINGS		PPB PHASE	REMARKS		
		H'GHT	M.A.	L.A.	H.P.S.V.	LEGEND	VEHICLE			PEDESTRIAN	
(A)	Type 26 (E)	30'(E)	40'(E)	15'(E)	250W(E)	HOWARD	AV ₄₃₀₀ (E)	MAS(N) MAS(E) SV-1-T(N)	SP-1-T(E)	4(N)	ROTATE PEDESTRIAN SIGNAL AS SHOWN.
(B)	Type 1 (E)	10'(E)						TV-1-T(N)	SP-1-T(E)	6(N)	ROTATE PEDESTRIAN SIGNAL AS SHOWN.
(C)	Type 17 (E)	30'(E)	18'(E)	15'(E)	200W(E)	FOURTEENTH	ST ₂₉₀₀ (E)	MAS(E) SV-1-T(N)	SP-1-T(E)	6(N)	ROTATE PEDESTRIAN SIGNAL AS SHOWN.
(D)	Type 1 (R)	10'(R)						TV-2-T(N)	SP-1-T(E)	8(N)	ROTATE PEDESTRIAN SIGNAL AS SHOWN.
(E)	Type 19 (E)	30'(E)	30'(E)	15'(E)	250W(E)	HOWARD	AV ₄₄₀₀ (E)	MAS(N) MAS(E) SV-1-T(N)	SP-1-T(E)	8(N)	ROTATE PEDESTRIAN SIGNAL AS SHOWN.
(F)	Type 1 (E)	10'(E)						TV-1-T(N)	SP-1-T(E)	2(N)	ROTATE PEDESTRIAN SIGNAL AS SHOWN.
(G)	17-2-80(N)	30'(N)	20'(N)	15'(N)	200W(N)	FOURTEENTH	ST ₃₀₀₀ (R)	MAS(N) SV-1-T(N)	SP-1-T(N)	2(N)	REMOVE AND SALVAGE EXIST. POLE AND EQUIP. RELOCATE S.N.S. TO NEW POLE.
(H)	Type 15 (E)	30'(E)		15'(E)	250W(E)			TV-2-T(N)	SP-1-T(E)	4(N)	ROTATE PEDESTRIAN SIGNAL AS SHOWN.


(E) = EXISTING, (N) = NEW, (R) = REUSE

- NOTES:**
- ALL VEHICULAR HEADS SHALL HAVE 12" LENSES.
 - ALL LEFT TURN HEADS SHALL HAVE ALL ARROWS.
 - PEDESTRIAN PUSH BUTTONS SHALL BE INSTALLED ON THE POLE IN THE QUADRANT NEAREST THE CROSSWALK SERVING THE PHASE.


CONDUCTOR TABLE

CONTROL FUNCTION	CONDUCTORS	CONDUCTOR RUNS																		
		1	2	3	4	5	6	7	8	9	10									
VEHICLE & PEDESTRIAN HEADS, PEDESTRIAN PUSH BUTTONS, SPARES & COMMONS	12 WIRE IMSA	1	2	3	8	5	4	3	2	1										
	3 WIRE IMSA	1	1	2	4	2	2	1	1											
DETECTOR CABLE	#16/2																			
PHASE 1							1	1												
PHASE 2			3	3	3	3	3													
PHASE 3																				
PHASE 4					1	1	1													
PHASE 5			1	1	1	1	1													
PHASE 6							2	2												
PHASE 7																				
PHASE 8							1	1	1	1										
VEHICLE PRE-EMPTION	#20			1	1	2	4	2	2	1	1									
INTERCONNECT	#19		1	1	1	1	2	1												
I.I.S.N.S.	#12																			
LUMINAIRES	#8		2	2	2	2	2	2	2	2	2									
SIGNAL SERVICE	#6						2	2												
CONDUIT SIZE		2.5"	2.5"	2.5"	3"	2-3"	3"	3"	3"	3"	3"	2"								
		(E)	(E)	(E)	(N)	(N)	(N)	(N)	(N)	(N)	(N)	(N)								

- NOTE:**
- SIGNAL SYSTEM SHALL HAVE NEW CABLES AND CONDUCTORS.
 - INTERCONNECT CABLE SHALL BE 6 PAIR #19 GAUGE (SEE SPECIAL PROVISIONS).
 - INTERCONNECT CABLE SPLICE SHALL BE 3M SCOTCHCAST MODEL 78-R1 OR CITY APPROVED EQUAL.

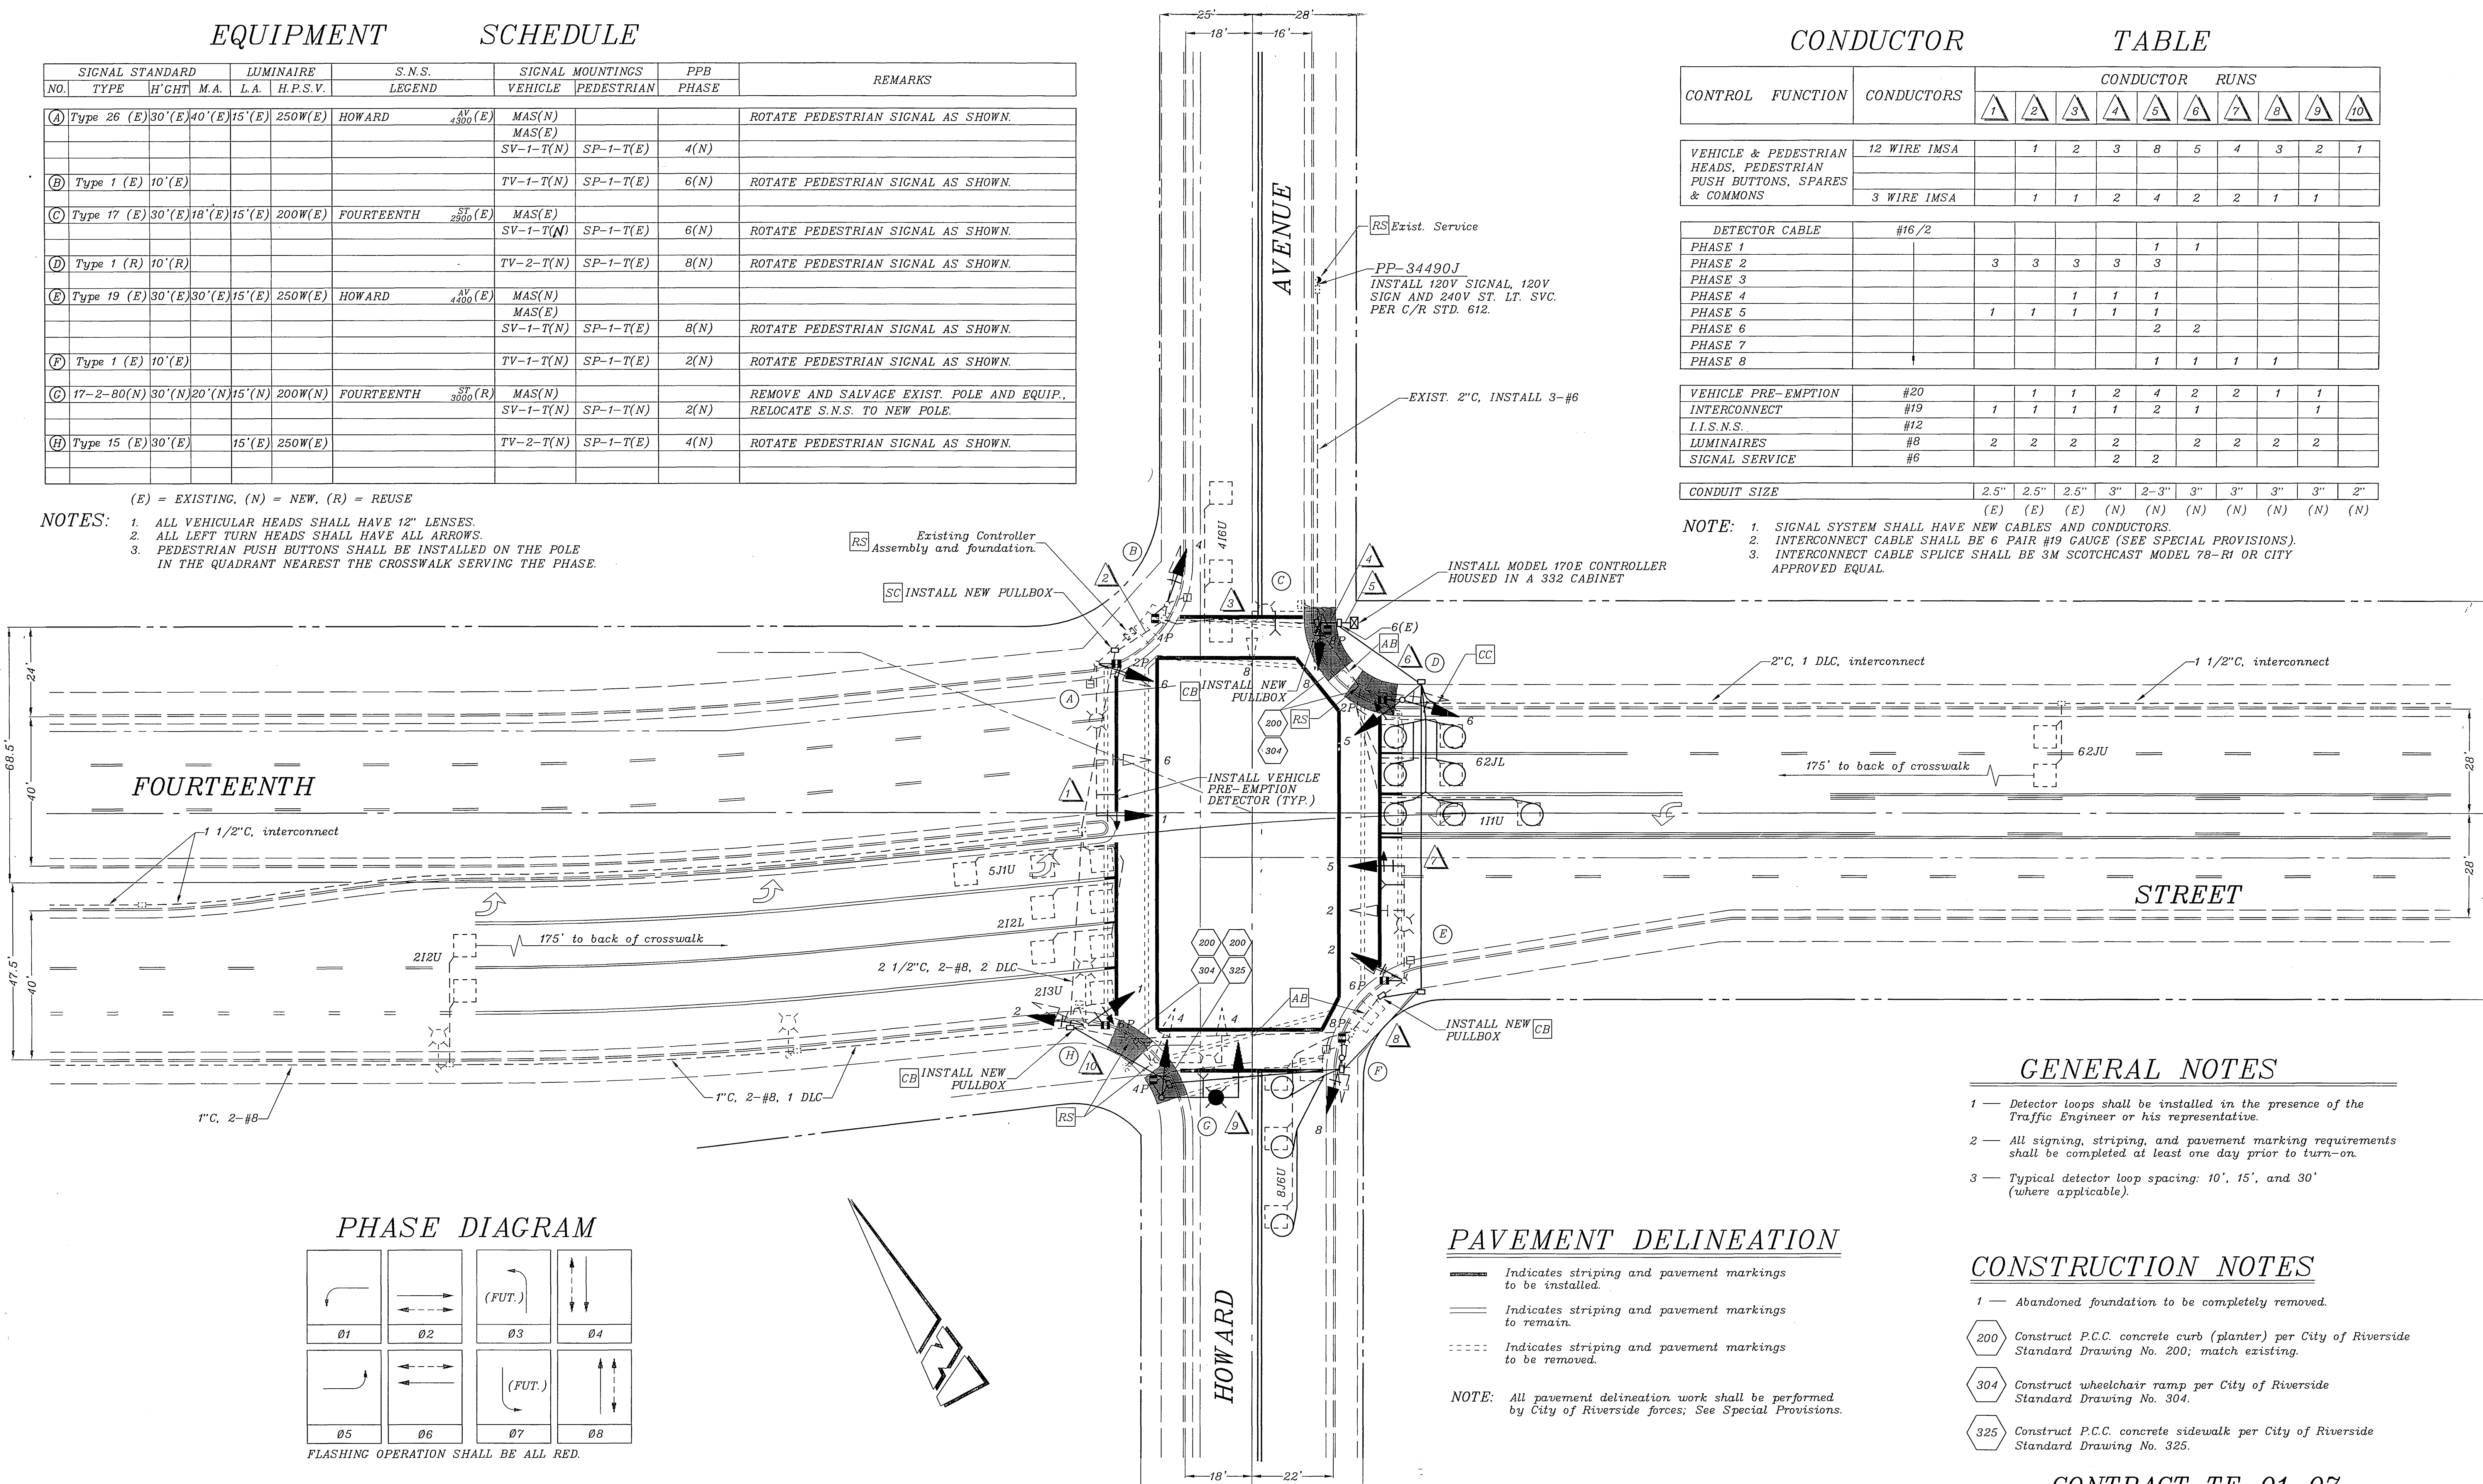

PHASE DIAGRAM

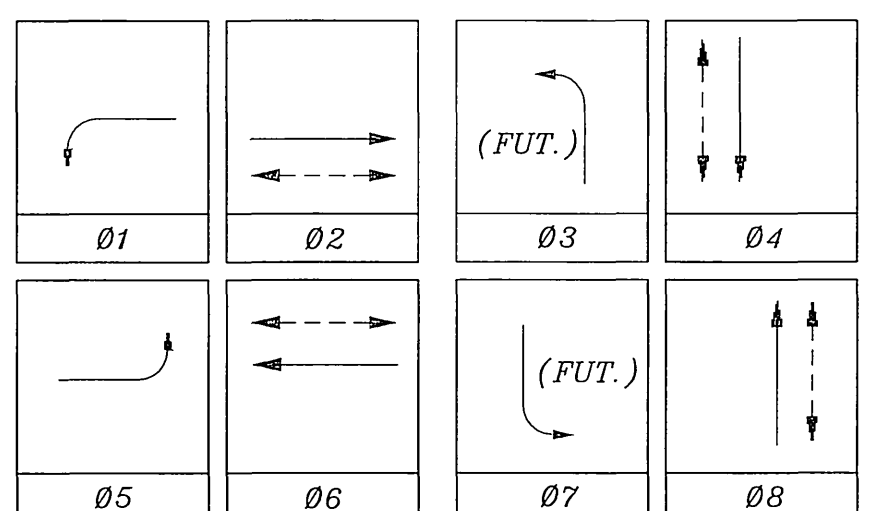

FLASHING OPERATION SHALL BE ALL RED.

GENERAL NOTES

- Detector loops shall be installed in the presence of the Traffic Engineer or his representative.
- All signing, striping, and pavement marking requirements shall be completed at least one day prior to turn-on.
- Typical detector loop spacing: 10', 15', and 30' (where applicable).

CONSTRUCTION NOTES

- Abandoned foundation to be completely removed.
- 200 Construct P.C.C. concrete curb (planter) per City of Riverside Standard Drawing No. 200; match existing.
- 304 Construct wheelchair ramp per City of Riverside Standard Drawing No. 304.
- 325 Construct P.C.C. concrete sidewalk per City of Riverside Standard Drawing No. 325.

PAVEMENT DELINEATION

- Indicates striping and pavement markings to be installed.
 - Indicates striping and pavement markings to remain.
 - Indicates striping and pavement markings to be removed.
- NOTE:** All pavement delineation work shall be performed by City of Riverside forces; See Special Provisions.

CONTRACT TE-01-07

IMPORTANT NOTICE
 Section 4216.4217 of the Government Code requires a Dig Alert Identification Number to be posted before a permit to excavate will be valid. For your Dig Alert I.D. Number call CALL TOLL FREE TWO WORKING DAYS BEFORE YOU DIG UNDERGROUND SERVICE ALERT 1-800-227-2600

ENGINEER IN RESPONSIBLE CHARGE
 Thomas John Boyd
 R.C.E. No. 38170 expires 6/30/04
 DATE 2/12/02

REGISTERED PROFESSIONAL ENGINEER
 THOMAS JOHN BOYD
 No. 36170
 Exp. 06-30-2004
 CIVIL
 STATE OF CALIFORNIA

MARK	REVISIONS	APPR.	DATE

CITY OF RIVERSIDE, CALIFORNIA DEPARTMENT OF PUBLIC WORKS			
APPROVED BY	BY	DATE	APPROVED BY
DEPUTY P.W. DIR./ENG.	Thomas Boyd	2/12/02	Thomas Boyd
PRINCIPAL ENGINEER			
P.W. INSPECTION			
TRAFFIC DIVISION			
PUBLIC UTILITIES			

TRAFFIC SIGNAL MODIFICATION		ACCT. NO.
FOURTEENTH ST. AND HOWARD AVE.		9743832204-44030400
SCALE: 1" = 20'		

X-100A
SHEET 1 OF 1
FILE NAME: X100A.DWG


CONDUCTOR SCHEDULE

Control Function	Conductors Size Insulation	Conduit Run																		
		1	2	3	4	5	6	7	8	9	10									
Vehicle Heads	#14 T.W.	3	3	3	3	3	6	3	3	3										
φA		3	3	3	3	3	6	3	3											
φB		3	3	3	3	3	6	3	3											
φC		3	3	3	3	3	6	3	3											
Pedestrian Heads																				
φAw			2	2	2	2	4	2	2											
φBw			2	2	2	2	4	2	2											
Ped Push Button																				
φAw		1	1	1	2	3	5	1	1	1										
φBw		1	2	2	2	2	4	2	1											
Spares		3	3	3	3	3	3	3	3	3										
Detector Cable	#1/2 P.E.																			
φA					1	1	2	1	1	1										
φB			1	1	1	1	2	1	1	1										
φC					1	1	2	1	1	1										
Interconnect																				
12V Common	#12 T.W.	1	1	1	1	1	1	1	1	1										
120V Common	#10	1	1	1	1	1	1	1	1	1										
Signal Service	#8					2	2	2	2											
Luminaires	T.H.W.	2	2	2	2	2		4	4											
Totals	#14 P.E.	13	19	19	20	21	38	19	18	12										
	#1/2		1	1	2	3	6	3	2	2										
	#12 T.W.	1	1	1	1	1	1	1	1	1										
	#10	1	1	1	1	1	1	1	1	1										
	#8 T.H.W.	2	2	2	2	2		2	2											
Conduit Size		2"	2"	2"	2 1/2"	2 1/2"	3 1/2"	2 1/2"	2 1/2"	2"										

SIGNING REQUIREMENTS

Loc.	Code No.	Size	Mounting	facing	Remarks
A	R53UA	38x22"	OH Sig. Arm	E	See SES-6-C-1 for mtg detail.
D	R53(U)	30x28"	Signal Std.	W	See Std. Dwg. #66B for mtg. detail.
E	R53UA	38x22"	OH Sig. Arm	W	See SES-6-C-1 for mtg. detail.
H	R53(U)	30x28"	Signal Std.	E	See Std. Dwg. #66B for mtg. detail.


NOTE: All sign codes are California State Standard.

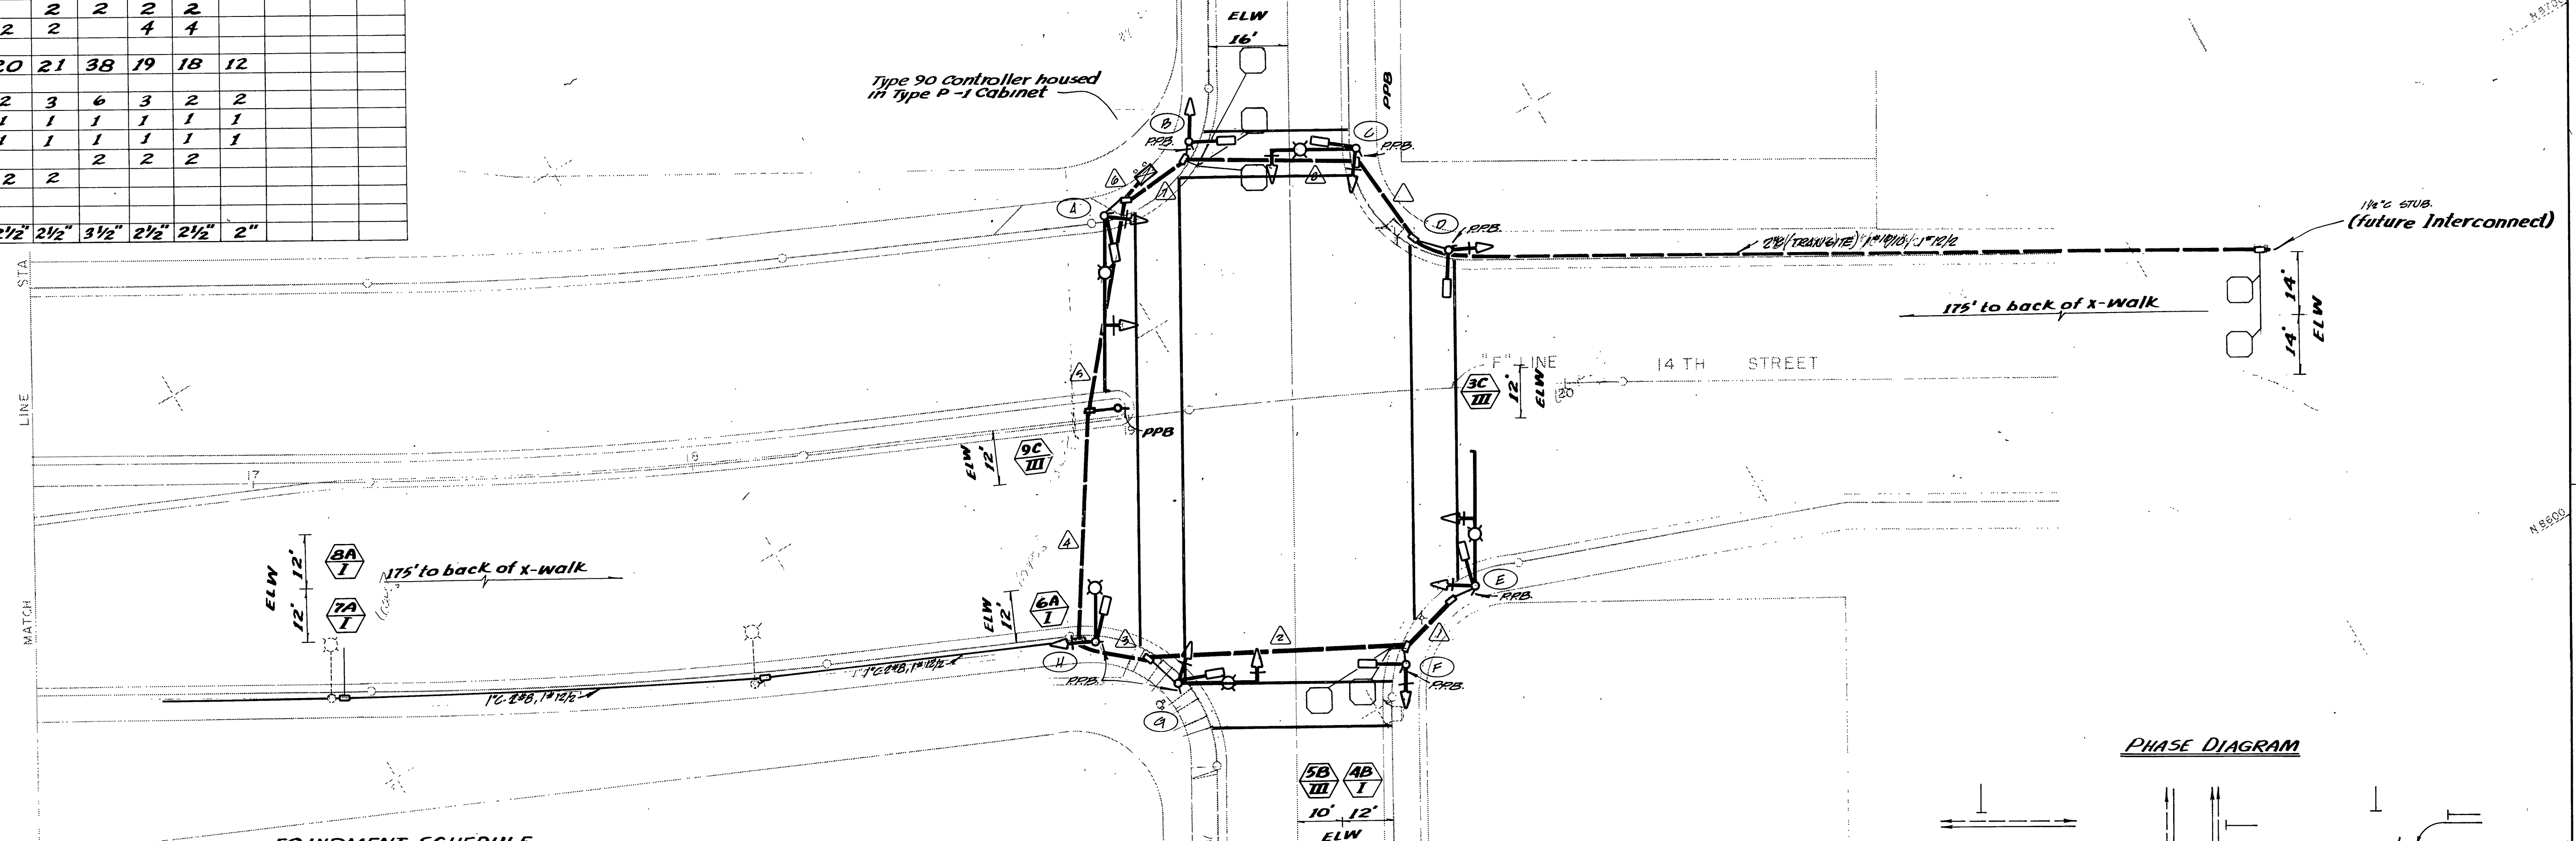

EQUIPMENT SCHEDULE

Location	Standard	Vehicle Equipment			Low.	Ped. Equipment			Luminaire
		Heads	Mtg.'s	Back Plate		Heads	Mtg.'s	PPB's	
A	Type XXVI 15'LA, 40SA	1W3C(12")	M-2	1				1000W	
		1W3C	B-1	1		1W2C	W-O	1	
B	Type I	1W3C	A-2	1		1W2C	W-O	1	
C	Type XXVII 15'LA, 18SA	1W3C(12")	M-2	1				400W	
		1W3C	B-1	1		1W2C	W-O	1	
D	Type I	2W3C	A-4	1		1W2C	W-I	1	
E	Type XXIX 15'LA, 30SA	1W3C(12")	M-2	1				1000W	
		1W3C	B-1	1					
		1W3C	A-2	1		1W2C	W-O	1	
F	Type I	1W3C	A-2	1		1W2C	W-O	1	
G	Type XXVII 15'LA, 18SA	1W3C(12")	M-2	1				400W	
		1W3C	B-1	1		1W2C	W-O	1	
H	Type XX 15'LA	2W3C	B-2	1		1W2C	W-O	1000W	
I	Ped Post							1	

PHASE DIAGRAM

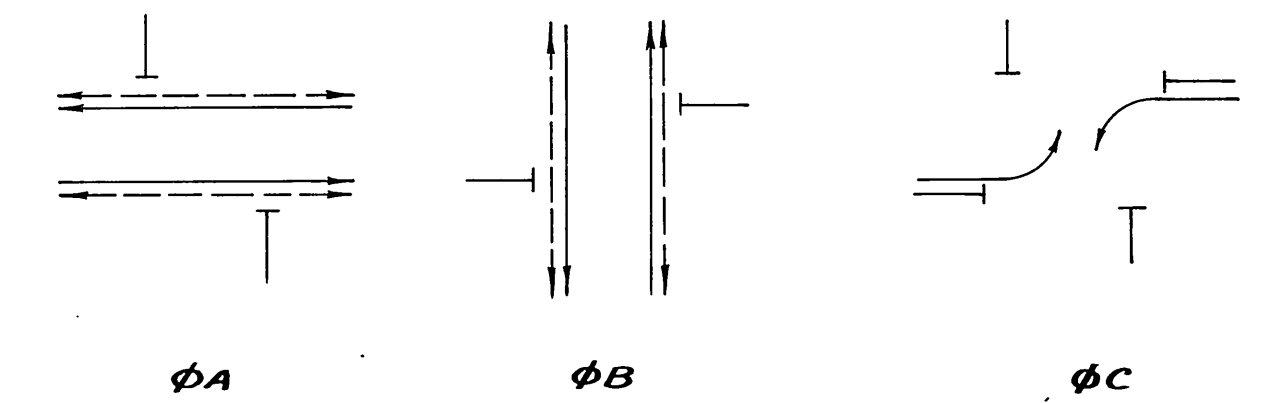

Flashing Indication:
φA = yellow
φB = red

φA - Type DP Module
φB - Type SP Module
φC - Type S Module

CITY OF RIVERSIDE
14 TH STREET UNDERPASS
STA. 16+50 TO EAST OF HOWARD AVE.
DE LEUW, CATHER & COMPANY
CONSULTING ENGINEERS
SAN FRANCISCO, CALIFORNIA
SCALE 1" = 20'
DATE _____ SHEET NO. _____
DESIGNED _____ CHECKED _____
DRAWN _____ APPROVED _____

REV.	DESCRIPTION	DATE	BY

CONDUCTOR SCHEDULE

Control Function	Conductors Size Insulation	Conduit Run									
		1	2	3	4	5	6	7	8	9	10
Vehicle Heads	#14 T.W.	3	3	3	3	3	6	3	3	3	
ΦA		3	3	3	3	3	6	3	3		
ΦB		3	3	3	3	3	6	3	3		
ΦC		3	3	3	3	3	6	3	3		
Pedestrian Heads											
ΦAw			2	2	2	2	4	2	2		
ΦBw			2	2	2	2	4	2	2		
Ped. Push Button											
ΦAw		1	1	1	2	3	5	1	1	1	
ΦBw		1	2	2	2	2	4	2	1		
Spares		3	3	3	3	3	3	3	3	3	
Detector Cable #12	P.E.										
ΦA					1	1	2	1	1	1	
ΦB			1	1	1	1	2	1			
ΦC						1	2	1	1	1	
Interconnect											
12V Common #12	T.W.	1	1	1	1	1	1	1	1	1	
120V Common #10		1	1	1	1	1	1	1	1	1	
Signal Service #8						2	2	2	2		
Luminaires	T.H.W.	2	2	2	2	2		4	4		
Totals	#14 P.E.	13	19	19	20	21	38	19	18	12	
	#12		1	1	2	3	6	3	2	2	
	#12 T.W.	1	1	1	1	1	1	1	1	1	
	#10	1	1	1	1	1	1	1	1	1	
	#8										
	T.H.W.	2	2	2	2	2		2	2		
Conduit Size		2"	2"	2"	2 1/2"	2 1/2"	3 1/2"	2 1/2"	2 1/2"	2"	


EXIST. SIGNING REQUIREMENTS

Loc.	Code No.	Size	Mounting	Facing	Remarks
A	R53UA	38x22"	OH Sig. Arm	E	see S&S-6-C-1 for mtg detail.
D	R53(U)	30x28"	Signal Std.	W	see Std. Dwg. #66B for mtg. detail.
E	R53UA	38x22"	OH Sig. Arm	W	see S&S-6-C-1 for mtg. detail.
H	R53(U)	30x28"	Signal Std.	E	see Std. Dwg. #66B for mtg. detail.

NOTE: All sign codes are California State Standard.

NOTES - MODIFICATIONS

- ADD 2-LOOP DETECTOR SENSORS AND WIRING TO EXIST. CONTROLLER CABINET. INSTALL AND WIRE INTERCONNECT INTERFACE. CONNECT CONTROLLER. SEE NOTE 4
- INSTALL LOOP DETECTORS 1-E-2 & 1-W-2 AS SHOWN ALL OTHER DETECTION IS EXIST.
- PULL DETECTOR CABLES FOR 1-E-2 & 1-W-2 THROUGH RUNS 5, 6, 7, 8 & 9 TO CONTROLLER.
- ADD A 2-CHANNEL SENSOR FOR LOOPS ELW1 & ELW2 WITH INTEGRAL EXTENSION TIMERS. ONE INPUT TO CONTROLLER AND ONE INPUT FOR SAMPLING. USE EXIST. SENSORS FOR 1-E-2 & 1-W-2.

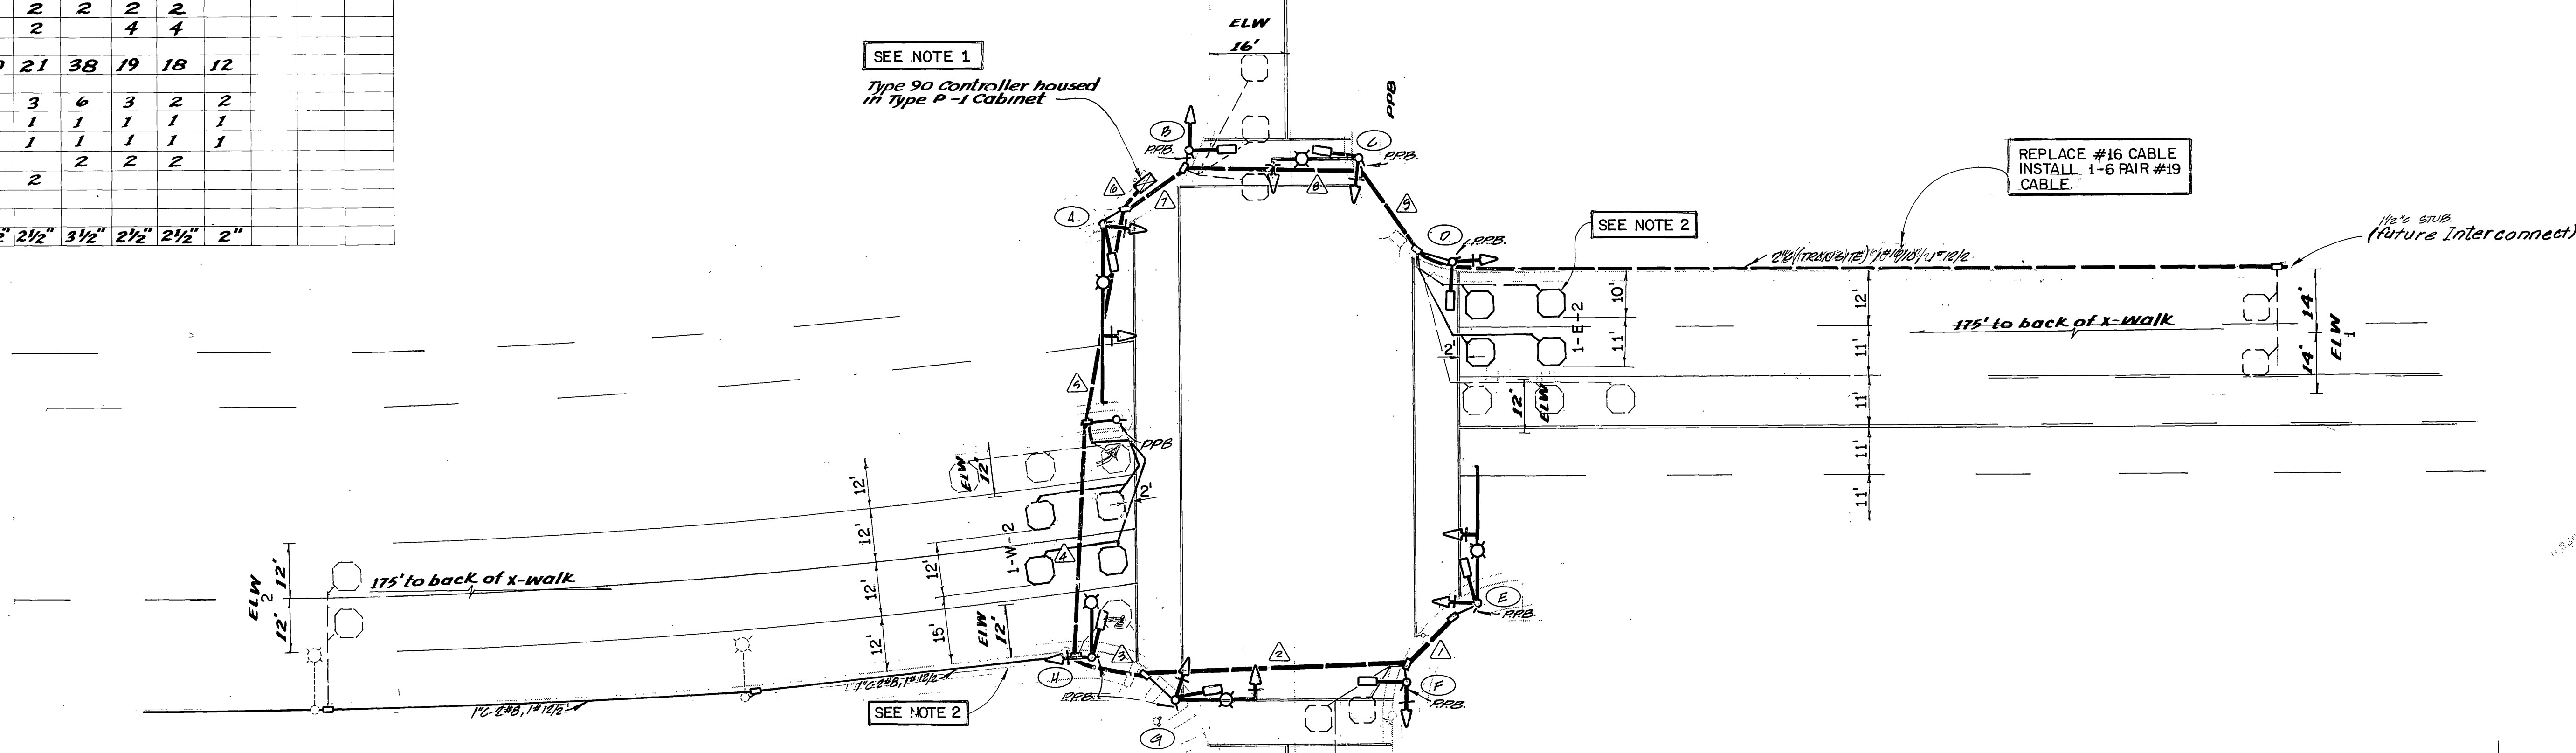

SEE NOTE 1
Type 90 Controller housed in Type P-1 Cabinet


REPLACE #16 CABLE INSTALL 1-6 PAIR #19 CABLE.

SEE NOTE 2

EQUIPMENT SCHEDULE

Location	Standard	Vehicle Equipment			Ped. Equipment			Luminaire
		Heads	Mtg.'s	Back Plate	Low.	Heads	Mtg.'s	
A	Type XXV 151A, 405A	1W3C(12")	M-2	1				1000W
		1W3C	B-1	1		1W2C	W-O	1
B	Type I	1W3C	A-2	1		1W2C	W-O	1
C	Type XXV 151A, 185A	1W3C(12")	M-2	1				400W
		1W3C	B-1	1		1W2C	W-O	1
D	Type I	2W3C	A-4	1		1W2C	W-1	1
E	Type XIX 151A, 305A	1W3C(12")	M-2	1				1000W
		1W3C	B-1	1				
F	Type I	1W3C	A-2	1		1W2C	W-O	1
G	Type XXV 151A, 185A	1W3C(12")	M-2	1				400W
		1W3C	B-1	1		1W2C	W-O	1
H	Type XV 151A	2W3C	B-2	1		1W2C	W-O	1
I	Ped Rest							1

PHASE DIAGRAM

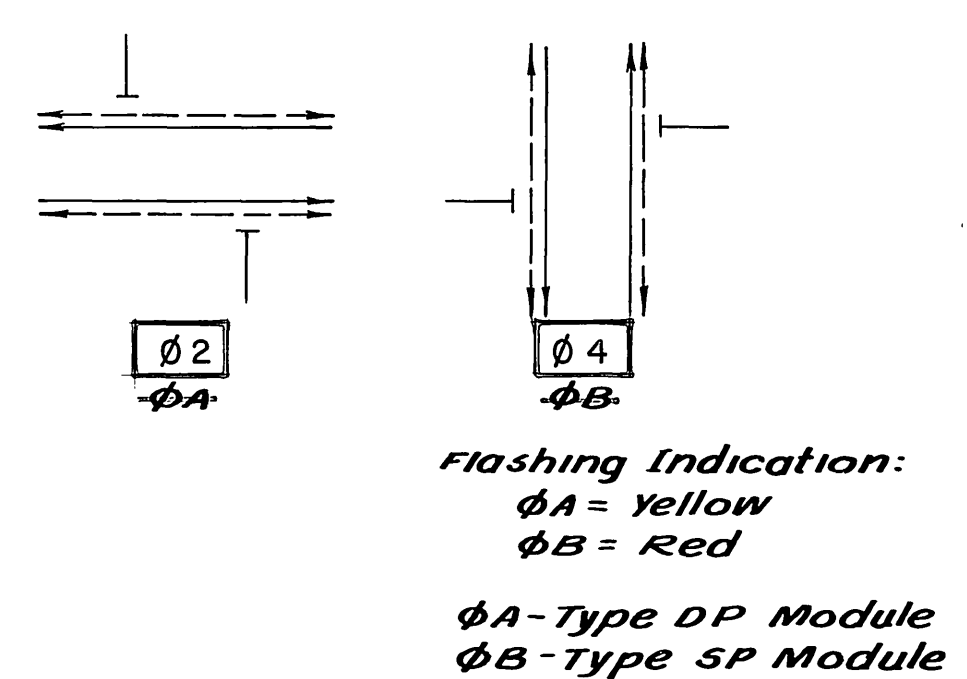

PREPARED BY: *R.H. Moller* Oct 9, 1982
 MOHLE, PERRY & ASSOC. DESIGN ENGR. R.C.E. 10692 DATE

REV.	DESCRIPTION	DATE	BY

CITY OF RIVERSIDE
 14 TH STREET UNDERPASS
 AT
 HOWARD AVENUE
 STA 16+50 TO EAST OF HOWARD AVE.
 DE LEUW, CATHER & COMPANY
 CONSULTING ENGINEERS
 SAN FRANCISCO, CALIFORNIA
 SCALE 1" = 20'
 DATE: _____ SHEET NO. 44 of 50
 DESIGNED: _____ CHECKED: *[Signature]*
 DRAWN: _____ APPROVED: *[Signature]*

CONDUCTOR SCHEDULE

Control Function	Conductors size insulation	Conduit Run									
		1	2	3	4	5	6	7	8	9	10
Vehicle Heads	#14 T.W.	3	3	3	3	3	6	3	3	3	
φA		3	3	3	3	3	6	3	3	3	
φB		3	3	3	3	3	6	3	3	3	
φC		3	3	3	3	3	6	3	3	3	
Pedestrian Heads											
φAw			2	2	2	2	4	2	2		
φBw			2	2	2	2	4	2	2		
Ped Push Button											
φAw		1	1	1	2	3	5	1	1	1	
φBw		1	2	2	2	2	4	2	1		
Spares		3	3	3	3	3	3	3	3	3	
Detector Cable #12 PE					1	1	2	1	1	1	
φA					1	1	2	1	1	1	
φB			1	1	1	1	2	1	1	1	
φC						1	2	1	1	1	
Interconnect											
12V Common #12 T.W.		1	1	1	1	1	1	1	1	1	
120V Common #10		1	1	1	1	1	1	1	1	1	
Signal Service #8					2	2	2	2	2		
Luminaires	T.H.W.	2	2	2	2	2	4	4			
Totals	#14 P.E.	13	19	19	20	21	38	19	18	12	
	#12		1	1	2	3	6	3	2	2	
	#12 T.W.	1	1	1	1	1	1	1	1	1	
	#10	1	1	1	1	1	1	1	1	1	
	#8				2	2	2				
	T.H.W.	2	2	2	2	2					
Conduit Size		2"	2"	2"	2 1/2"	2 1/2"	3 1/2"	2 1/2"	2 1/2"	2"	

EXIST. SIGNING REQUIREMENTS

Loc.	Code No.	Size	Mounting	Facing	Remarks
A	R53UA	38x22"	OH Sig. Arm	E	See S&S-6-C-1 for mtg detail.
D	R53(U)	30x28"	Signal Std.	W	See Std. Dwg. #66B for mtg detail.
E	R53UA	38x22"	OH Sig. Arm	W	See S&S-6-C-1 for mtg detail.
H	R53(U)	30x28"	Signal Std.	E	See Std. Dwg. #66B for mtg detail.

NOTE: All sign codes are California State Standard.

NOTES - MODIFICATIONS


- ADD 2-LOOP DETECTOR SENSORS AND WIRING TO EXIST. CONTROLLER CABINET. INSTALL AND WIRE INTERCONNECT INTERFACE. CONNECT CONTROLLER. SEE NOTE 4
- INSTALL LOOP DETECTORS 1-E-2 & 1-W-2 AS SHOWN ALL OTHER DETECTION IS EXIST.
- PULL DETECTOR CABLES FOR 1-E-2 & 1-W-2 THROUGH RUNS 6, 6, 7, 8 & 9 TO CONTROLLER.
- ADD A 2-CHANNEL SENSOR FOR LOOPS ELW1 & ELW2 WITH INTEGRAL EXTENSION TIMERS. ONE INPUT TO CONTROLLER AND ONE INPUT FOR SAMPLING. USE EXIST. SENSORS FOR 1-E-2 & 1-W-2.

SEE NOTE 1

Type 90 Controller housed in Type P-1 Cabinet

REPLACE #16 CABLE INSTALL 1-6 PAIR #19 CABLE


SEE NOTE 2

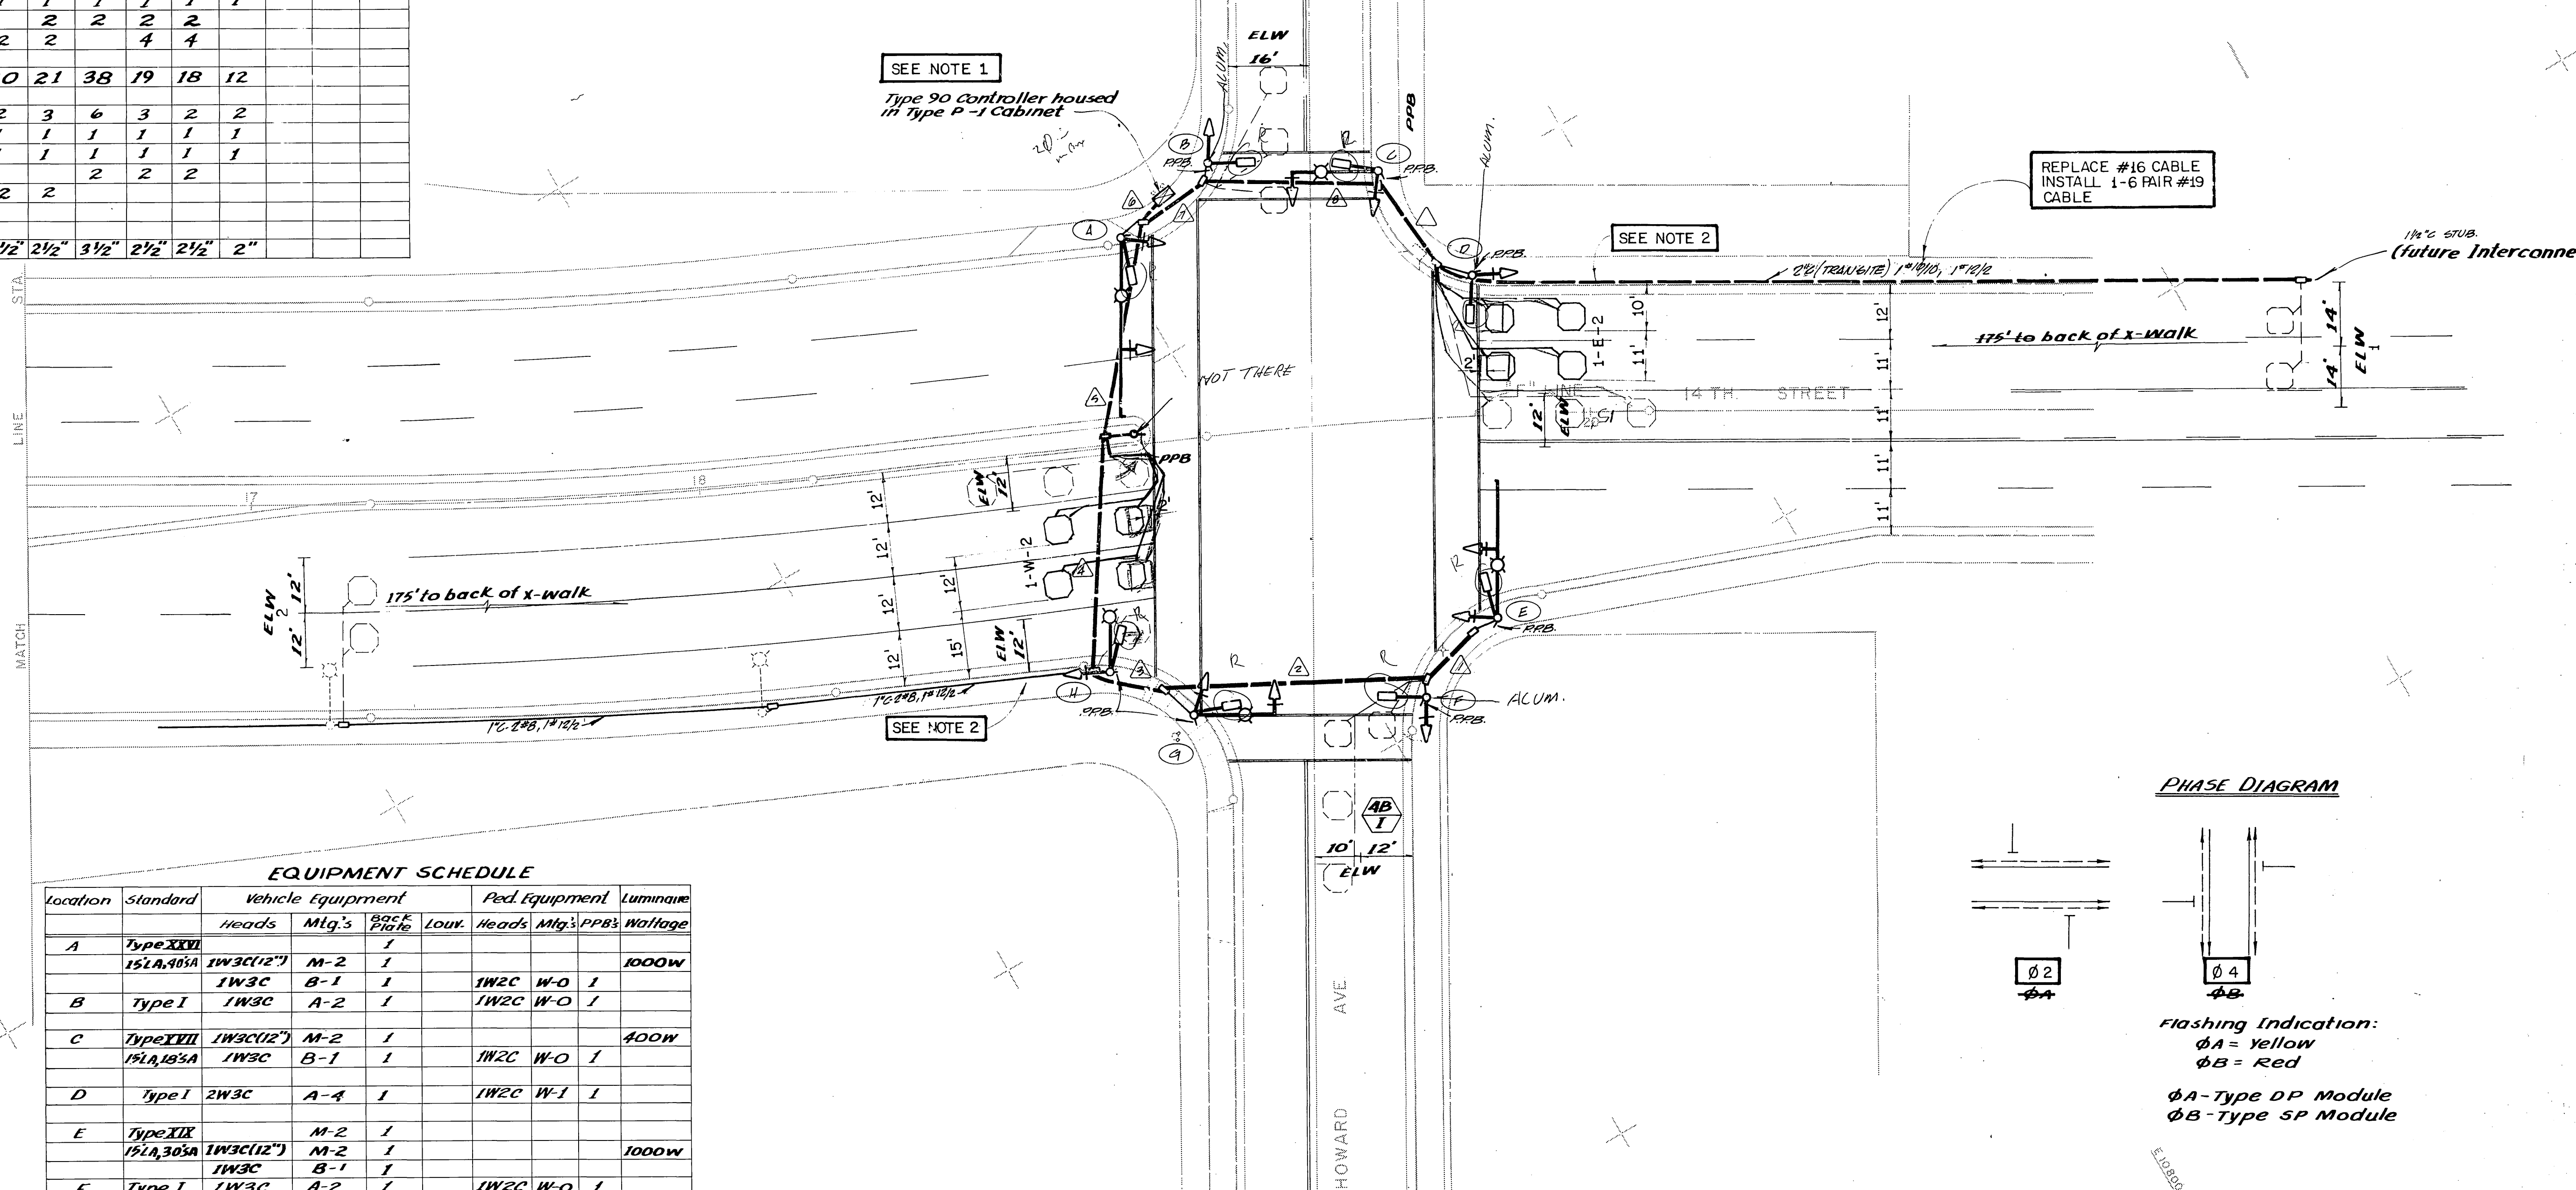

EQUIPMENT SCHEDULE

Location	Standard	Vehicle Equipment			Ped. Equipment			Luminaire
		Heads	Mtg.'s	Back Plate	Low.	Heads	Mtg.'s	
A	Type XXVI 151A, 403A	1W3C(12")	M-2	1				1000W
		1W3C	B-1	1	1W2C	W-O	1	
B	Type I	1W3C	A-2	1	1W2C	W-O	1	
C	Type XXVII 151A, 183A	1W3C(12")	M-2	1				400W
		1W3C	B-1	1	1W2C	W-O	1	
D	Type I	2W3C	A-4	1	1W2C	W-1	1	
E	Type XIX 151A, 303A	1W3C(12")	M-2	1				1000W
		1W3C	B-1	1	1W2C	W-O	1	
F	Type I	1W3C	A-2	1	1W2C	W-O	1	
G	Type XXVIII 151A, 183A	1W3C(12")	M-2	1				400W
		1W3C	B-1	1	1W2C	W-O	1	
H	Type XX 151A	2W3C	B-2	1	1W2C	W-O	1	1000W
I	Ped Post						1	

PHASE DIAGRAM

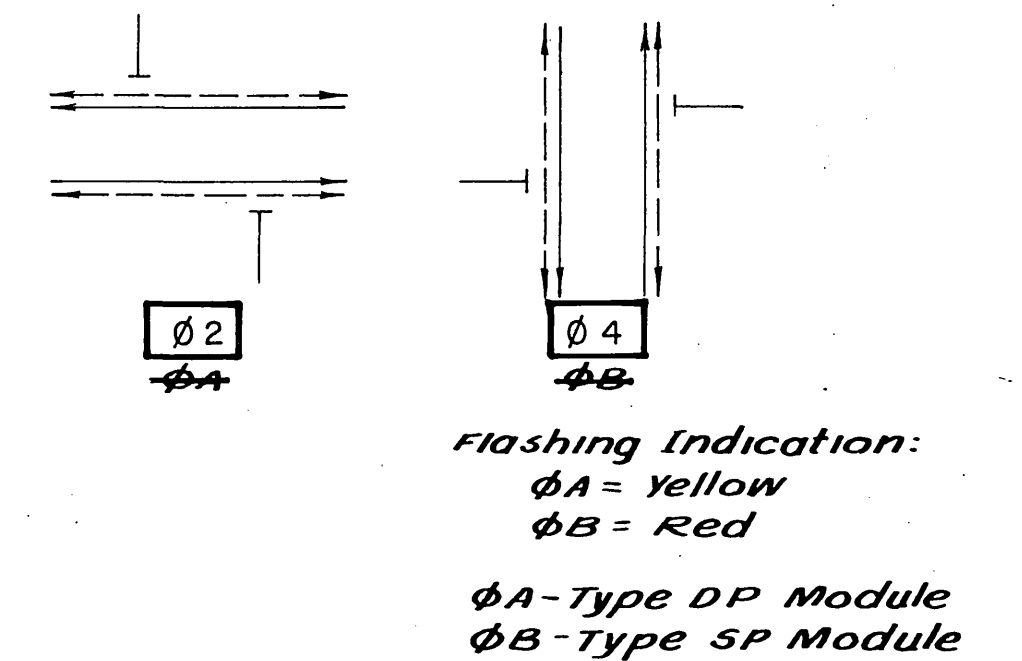

CITY OF RIVERSIDE
 14 TH STREET UNDERPASS
 AT
 HOWARD AVENUE
 STA. 16+50 TO EAST OF HOWARD AVE.
 DE LEUW, CATHER & COMPANY
 CONSULTING ENGINEERS
 SAN FRANCISCO, CALIFORNIA
 SCALE 1" = 20'
 SHEET NO. 44 of 50
 PROJECT NO. 2023-01

NPI MOHLE, PERRY & ASSOC.
 PREPARED BY: R.H. Madh...
 DESIGN ENGR. R.C.E. 10692 DATE

REV.	DESCRIPTION	DATE	BY