



**DETAIL "A" - TYPE "E" LOOP DETECTOR LAYOUT**

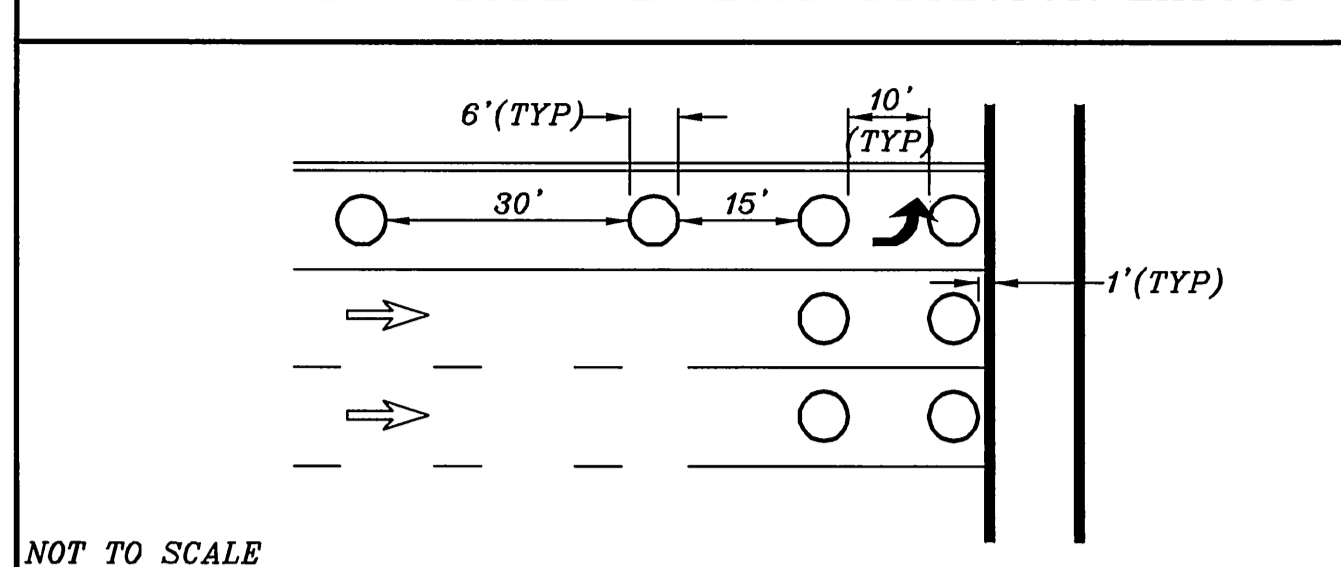

**PHASE DIAGRAM**

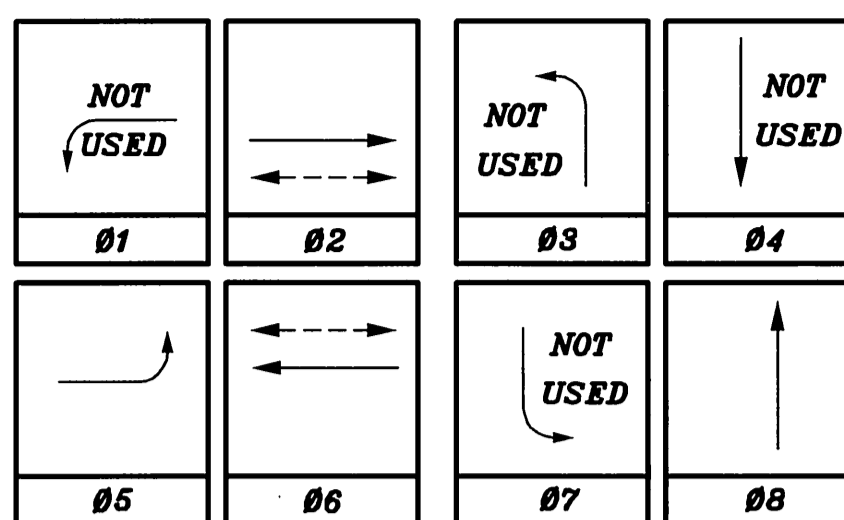

**EQUIPMENT SCHEDULE**

NO.	SIGNAL STANDARD		LUMINAIRE		SIGNAL MOUNTING		REMARKS
	TYPE	H'GHT	M.A.	L.A.	H.P.S.V.	VEHICLE	
Ø1	TYPE 17	30'	20'	15'	250W	MAS	SV-2-TB SP-1-T
Ø2	TYPE 16	17'	15'		250W	MAS	SV-1-T
Ø3	TYPE 15	30'		15'	250W	SV-2-TB	SP-1-T
Ø4	* 1A	10'				TV-1-T	
Ø5	TYPE 17	30'	20'	15'	250W	MAS	SV-1-T SP-1-T
Ø6	TYPE 18 (SPEC.)						
Ø7	TYPE 15	30'		15'	250W	SV-1-T	SP-1-T

\* CONTRACTOR SHALL ADJUST THE VEHICLE INDICATION TO LINE UP WITH THE CENTER LANE LINE OF THE DUAL LEFT-TURN LANES. ENGINEER OR ENGINEER'S REPRESENTATIVE SHALL BE PRESENT FOR THIS WORK

**CONDUCTOR SCHEDULE**

CONTROL FUNCTION	CONDUCTORS		RUNS							
	SIZE	INSULATION	1	2	3	4	5	6	7	8
VEHICLE HEADS	#14	T.W.	-	-	-	-	-	-	-	-
PHASE 1			-	-	-	3	-	-	-	-
PHASE 2			-	-	-	-	-	-	-	-
PHASE 4			-	-	-	-	-	-	-	-
PHASE 5			-	-	3	3	3	-	-	-
PHASE 6			3	3	3	3	-	-	-	-
PHASE 8			3	3	3	3	-	-	-	-
PED. HEADS			-	-	-	-	2	2	2	-
PHASE 2			-	-	-	-	-	-	-	-
PHASE 6			2	2	2	2	-	-	-	-
PED. PUSH BUTTONS			-	-	-	1	1	1	-	-
PHASE 2			-	-	-	-	-	-	-	-
PHASE 6			1	1	1	1	-	1	-	-
12V COMMON			1	1	1	-	-	-	-	-
SPARES			3	3	3	3	3	3	-	-
DETECTORS	TYPE C	P.E.	-	-	-	-	-	-	-	-
PHASE 1			-	-	-	-	-	-	-	-
PHASE 2			-	-	-	3	3	3	-	-
PHASE 4			-	-	-	-	-	-	-	-
PHASE 5			-	-	-	(N)4	(N)4	(N)4	-	-
PHASE 6			-	-	-	2	6	6	-	-
PHASE 8			-	-	-	-	6	6	-	-
120V COMMON	#10	T.W.	-	-	-	-	-	-	-	-
LUMINAIRES	#8	T.H.W.	2	2	2	-	2	2	2	-
SIGN LIGHTING	#8	T.H.W.	-	-	-	-	-	-	-	-
SIGNAL SERVICE	#6	T.W.	-	-	-	-	-	-	-	-
INTERCONNECT	#20	P.E.	-	-	-	1	1	1	1	1
CONDUIT SIZE			2"	2 1/2"	2 1/2"	2-3"	3"	3"	3"	3"

(N) = NEW EQUIPMENT TO BE INSTALLED  
 1. CONTRACTOR SHALL MODIFY THE DLC'S IN THE TYPE 332 CONTROLLER CABINET TO PROVIDE DETECTION FOR THE 5JL LOOPS AND REMOVE THE 213U DETECTION CHANNEL.

**DETECTION REPLACEMENT NOTES:**

- INSTALL TYPE "E" DETECTOR LOOPS PER DETAIL "A". SPLICE TO DLC(S) AT ADJACENT PULL BOX.
- EACH GROUP OF LOOPS WITHIN A LANE SHALL BE WIRED IN SERIES IN THE PULL BOX, ALTERNATING CLOCKWISE TO COUNTERCLOCKWISE.
- CONTRACTOR SHALL BE RESPONSIBLE TO REPLACE ANY DAMAGED TRAFFIC SIGNAL EQUIPMENT DURING CONSTRUCTION WHICH INCLUDES BUT IS NOT LIMITED TO DLC(S), DETECTOR LOOPS, CONDUIT, PULL BOXES, ETC.
- INSTALL TYPE "A" LOOP CURB TERMINATION PER CALTRANS SPECIFICATION.
- INSTALL 6-FOOT LOOP DETECTOR, CENTERED IN THE LANE, WITH 10' (CLEAR) SPACING IN THE DIRECTION OF TRAVEL. PER CALTRANS STANDARD PLAN ES-5B, TYPE "E" LOOP SAW CUT SHALL BE 4-INCH DEEP. INSTALL LOOPS 1-FOOT OUTSIDE CROSSWALK OR LIMIT LINE AREA. ALL NEW ADVANCED DETECTION LOOPS SHALL HAVE FOUR TURNS OF LOOP WIRE.

- AB ABANDON EXISTING EQUIPMENT
- I INSTALL NEW EQUIPMENT
- IS INSTALL NEW SIGN
- SC SPLICE NEW TO EXISTING CONDUCTORS
- E EXISTING EQUIPMENT, PROTECT IN PLACE

**IMPORTANT NOTICE**  
 Section 41314.01 of the Government Code requires a City of Riverside identification number to be placed on all signs. For your sign to be visible, please call toll free 1-800-227-2600 TWO WORKING DAYS BEFORE YOU DIG UNDERGROUND SERVICE ALERT

**ENGINEER IN RESPONSIBLE CHARGE**  
 GILBERT M. HERNANDEZ  
 R.C.E. No. 69170 expires 6-30-08  
 DATE 4-24-08

**CITY OF RIVERSIDE, CALIFORNIA DEPARTMENT OF PUBLIC WORKS**  
 APPROVED BY: [Signature] DATE: 4/24/08  
 PRINCIPAL ENGINEER  
 ENGINEERING MANAGER  
 TRAFFIC DIVISION  
 CONSTRUCTION ADMIN.

**CONSTRUCTION NOTES:**

- CONTRACTOR SHALL COORDINATE WITH CITY OF RIVERSIDE FORCES AND/OR CALTRANS TO ADJUST SIGNAL HEAD TO SERVE BOTH LEFT TURN LANES FOR THE EASTBOUND FREEWAY ENTRANCE RAMP.

CALTRANS ENCROACHMENT PERMIT # 08-07-N-MC-0768

**TRAFFIC SIGNAL MODIFICATION**

FOURTEENTH STREET  
 @  
 91 FREEWAY RAMPS

X-104A

SHEET 1 OF 1


SCALE: 1" = 20'

FILE NAME: X104-2A.DWG


# SIGNING REQUIREMENTS

LOC.	CODE NO.	SIZE	MOUNTING	FACING
Ⓒ	2-C77	12' X 78"	O.H. SIGN STD.	E & W
Ⓓ	R61-4 (RT)	45" X 45"	MAST ARM	N
	R69 (LT)	42" X 45"	MAST ARM	N

## PHASE DIAGRAM

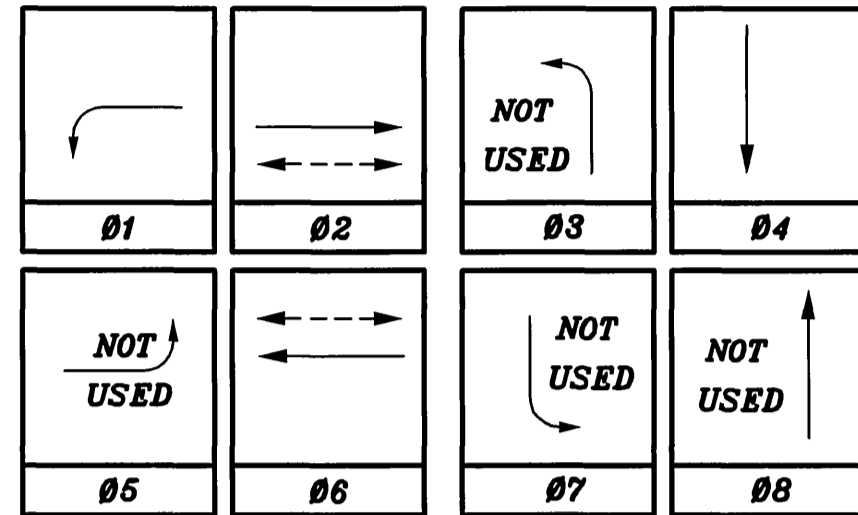

FLASHING OPERATION SHALL BE ALL RED.

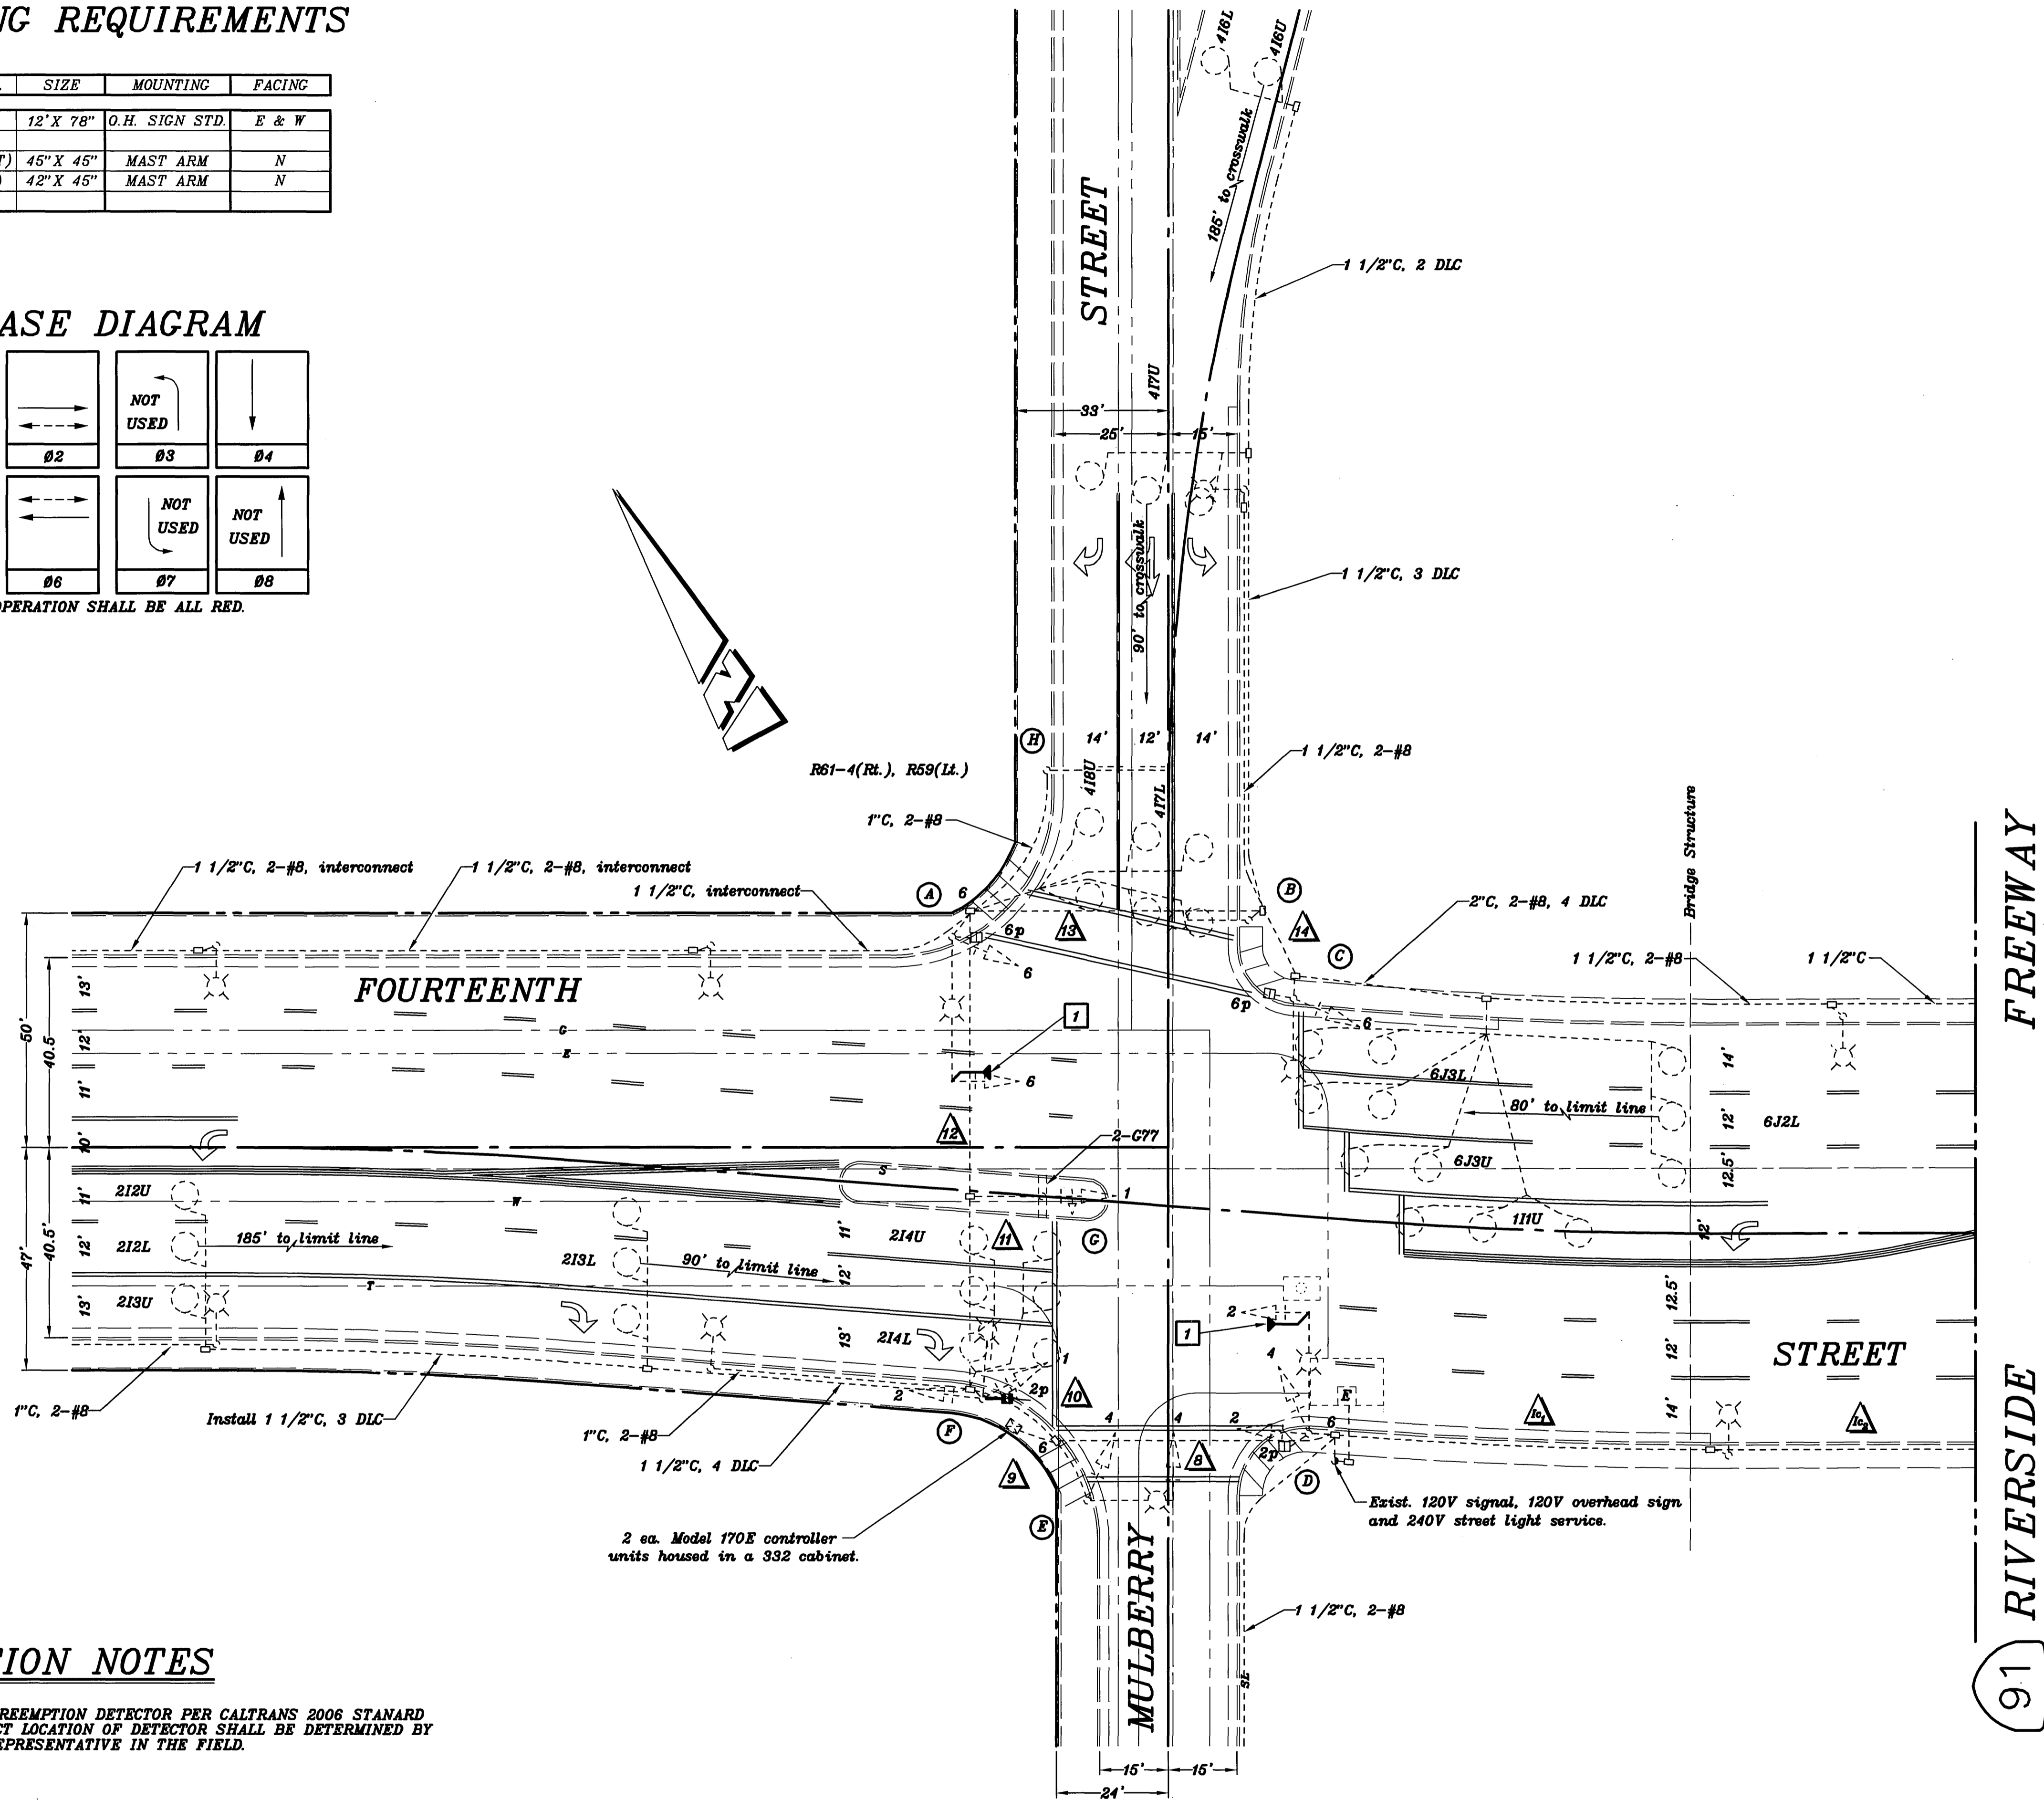

## CONSTRUCTION NOTES

- 1 - INSTALL VEHICLE PREEMPTION DETECTOR PER CALTRANS 2006 STANARD PLANS ES-4E. EXACT LOCATION OF DETECTOR SHALL BE DETERMINED BY THE ENGINEER'S REPRESENTATIVE IN THE FIELD.

**IMPORTANT NOTICE**  
 Section 4316.4217 of the Government Code requires a Dig Alert Identification Number to be placed before a "Hazard to Excavate" will be noted. For your Dig Alert ID Number call CALL TOLL FREE TWO WORKING DAYS BEFORE YOU DIG UNDERGROUND SERVICE ALERT 1-800-227-2600

**ENGINEER IN RESPONSIBLE CHARGE**  
 GILBERT M. HERNANDEZ  
 R.C.E. No. 69170 expires 6-30-08  
 DATE 3-3-08

MARK	REVISIONS	APPR.	DATE

**CITY OF RIVERSIDE, CALIFORNIA**  
**DEPARTMENT OF PUBLIC WORKS**

APPROVED BY: *[Signature]* DATE: 3/3/08  
 PRINCIPAL ENGINEER  
 ENGINEERING MANAGER  
 CONTRACT ADMIN.  
 TRAFFIC ENGINEERING

TRAFFIC SIGNAL MODIFICATION  
**FOURTEENTH STREET**  
 91 FREEWAY RAMPS

ACCT. NO. X-104  
 SHEET 1 OF 3  
 FILE NAME: X104-1A.DWG


08-07-N-SN-1287

SCALE: 1" = 20'



FREEWAY

RIVERSIDE

91

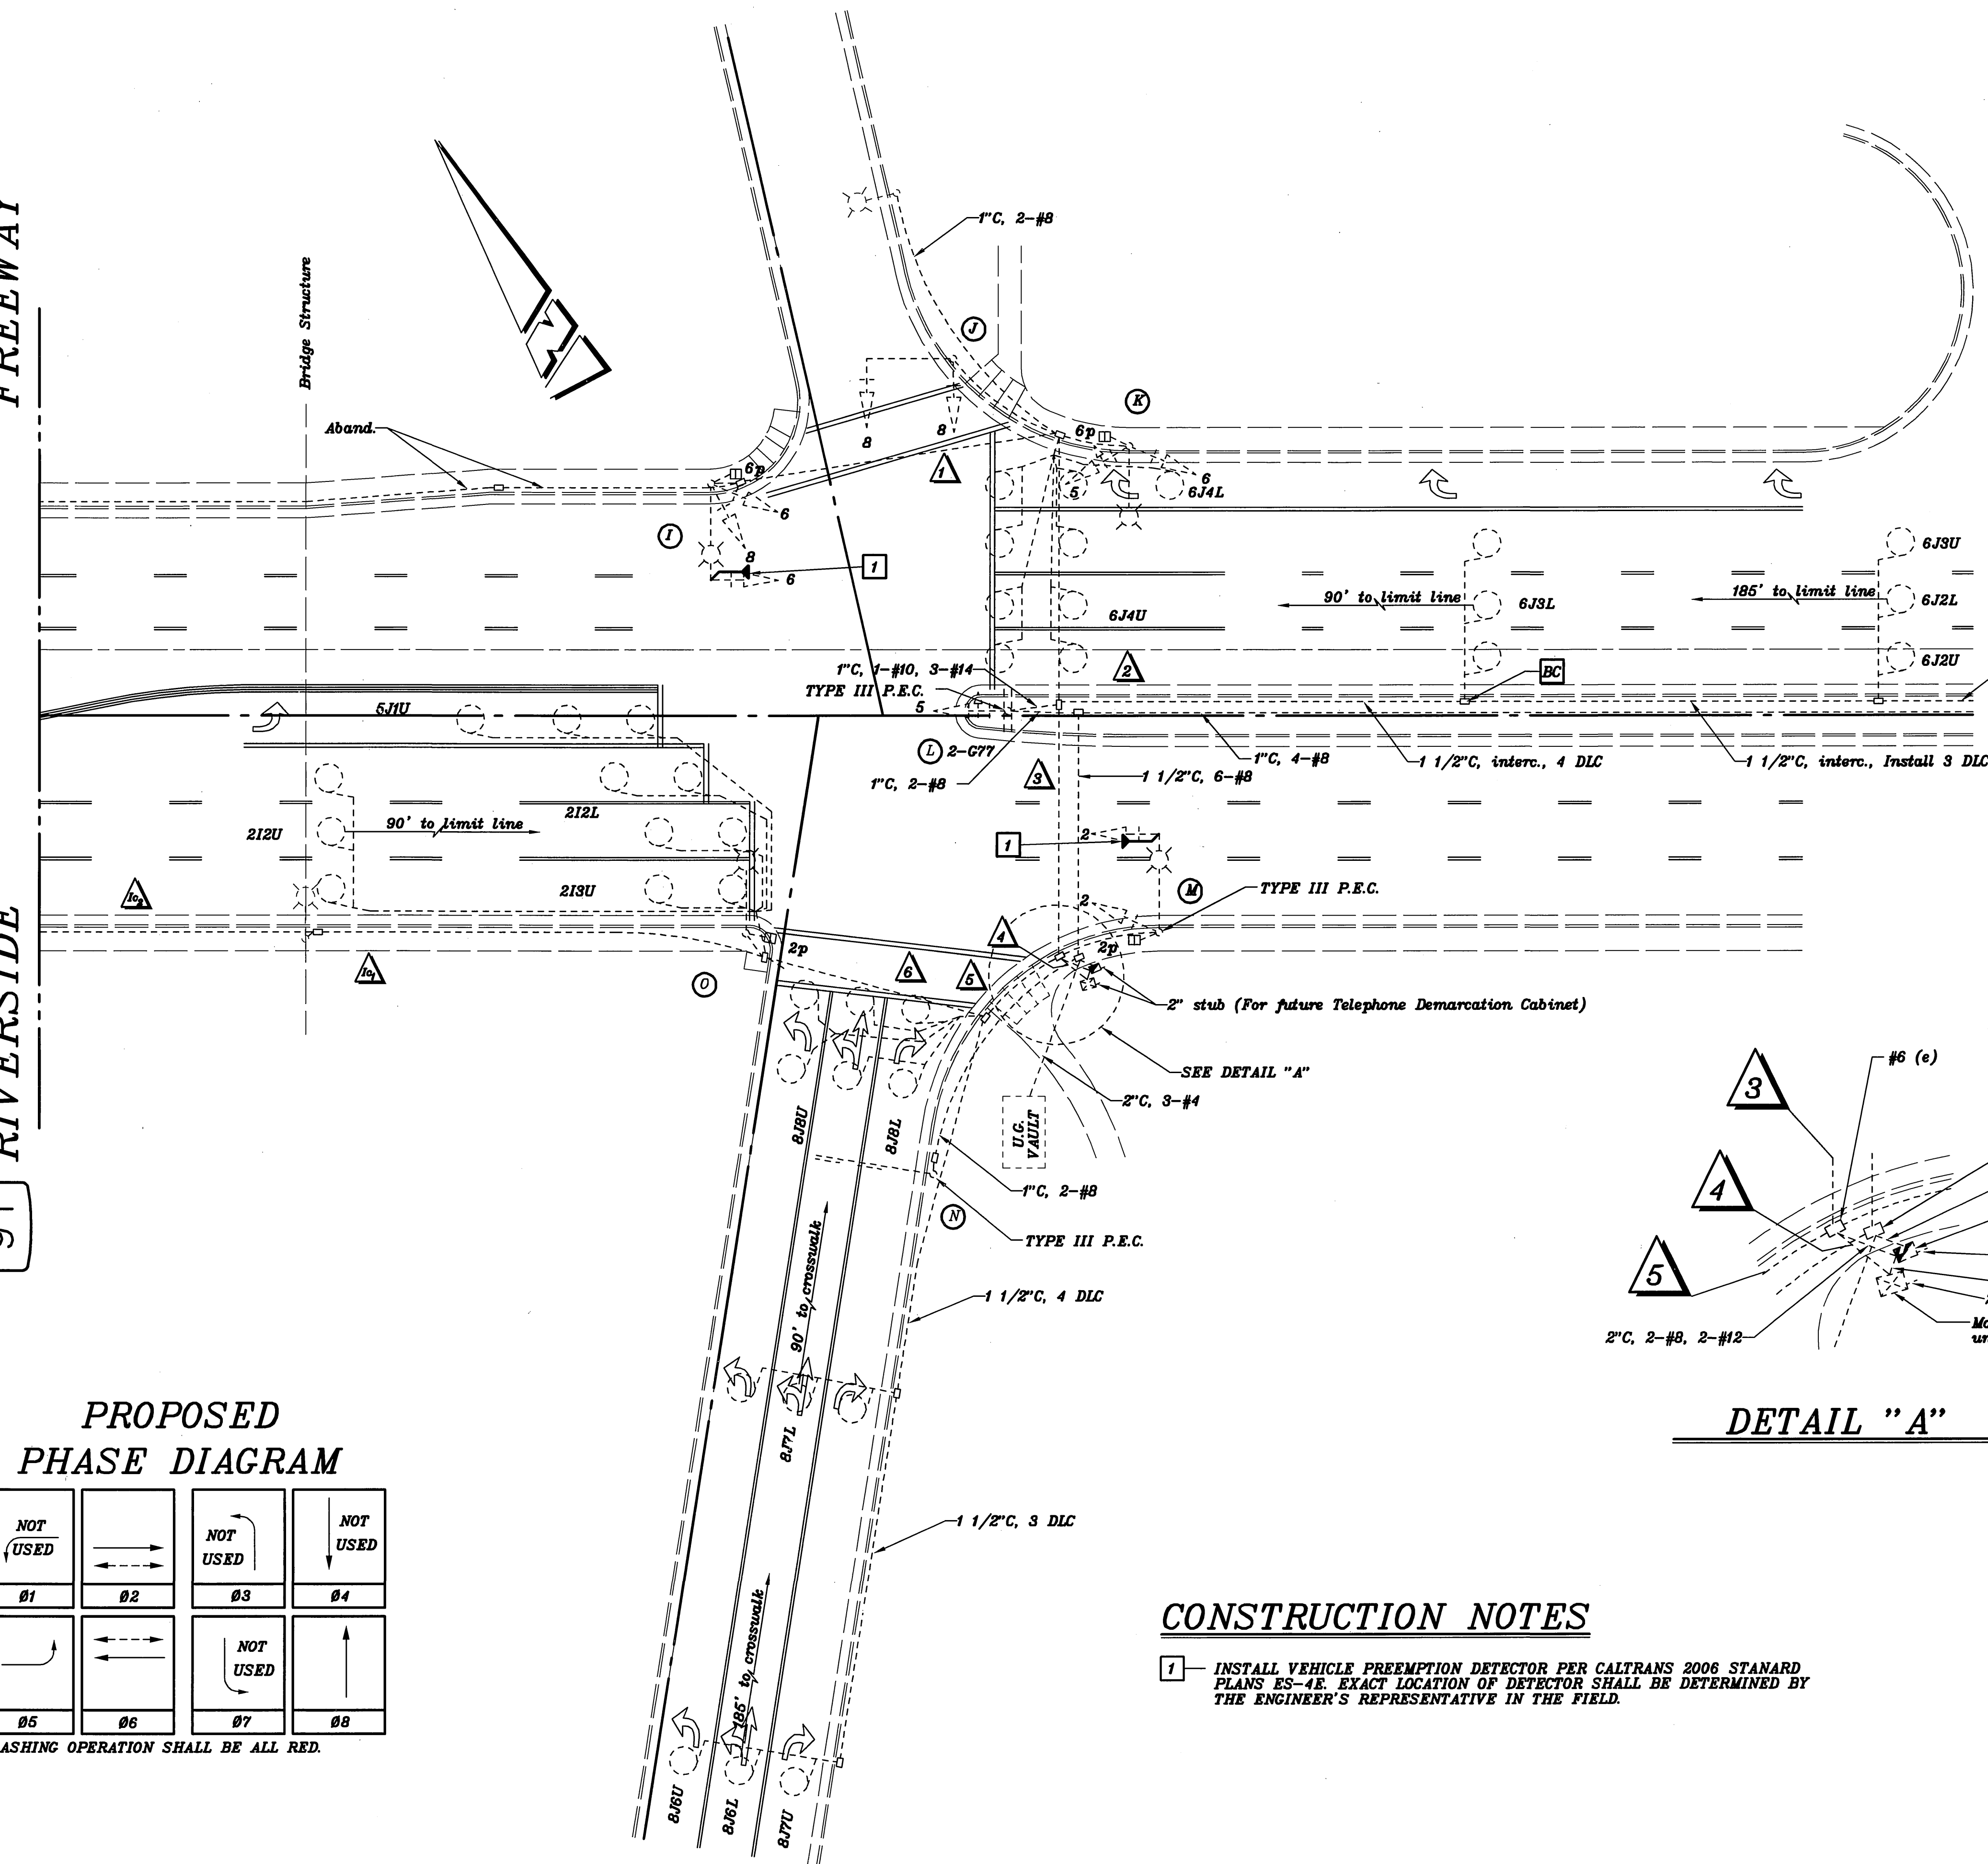

PROPOSED PHASE DIAGRAM

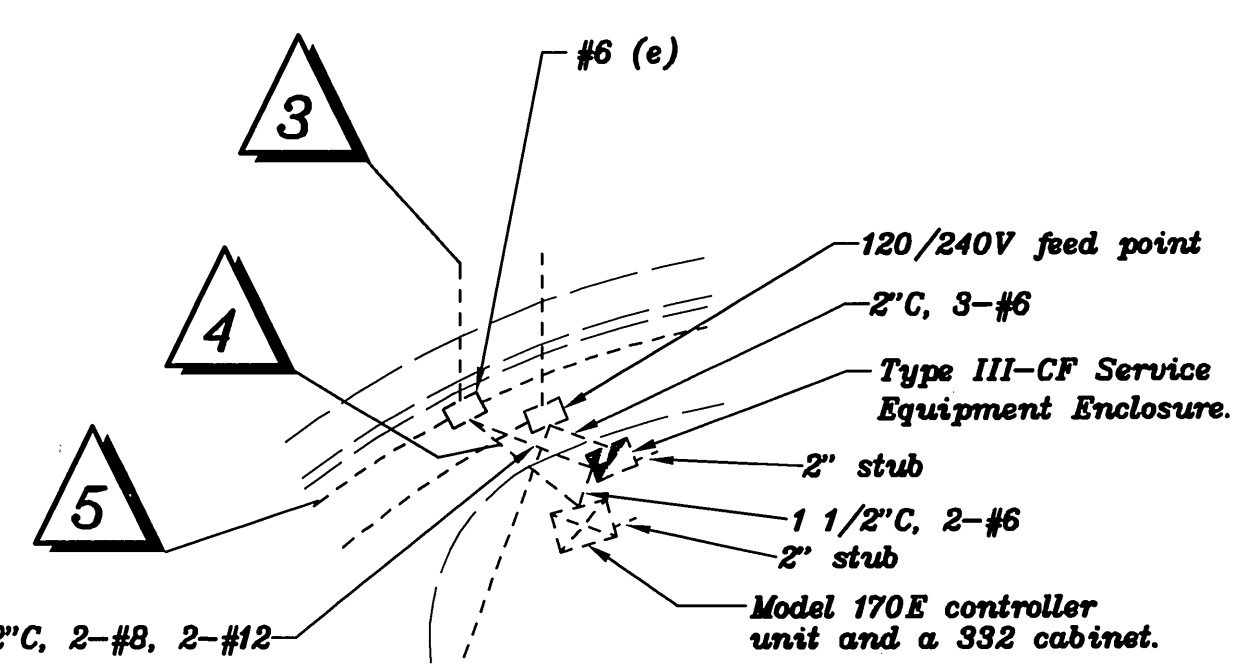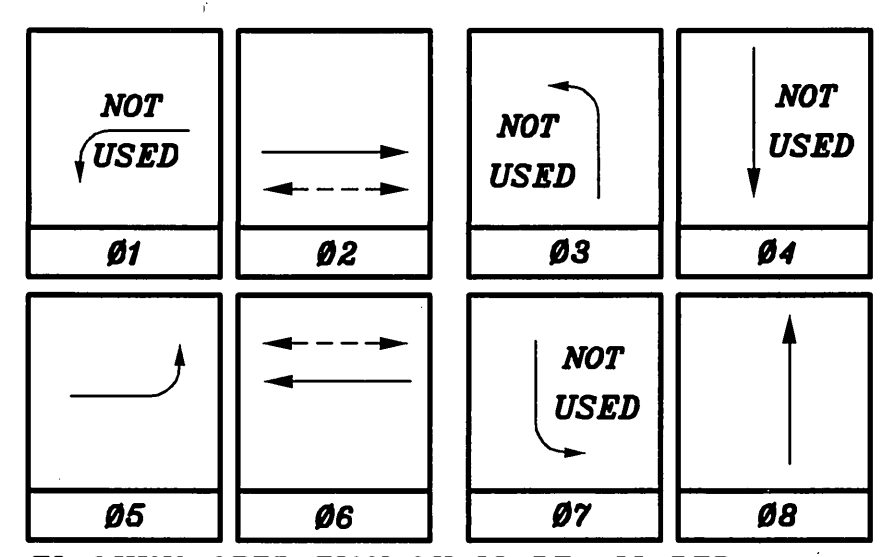

DETAIL "A"

CONSTRUCTION NOTES

- 1 - INSTALL VEHICLE PREEMPTION DETECTOR PER CALTRANS 2006 STANDARD PLANS ES-4E. EXACT LOCATION OF DETECTOR SHALL BE DETERMINED BY THE ENGINEER'S REPRESENTATIVE IN THE FIELD.

08-07-N-SN-1287

**IMPORTANT NOTICE**  
 Section 4136/4137 of the Government Code requires a 14-day advance notice to be given to the public before a permit to dig is issued. For your City Alert ID, please call CALL TOLL FREE TWO WORKING DAYS BEFORE YOU DIG UNDERGROUND SERVICE ALERT 1-800-227-2600

**ENGINEER IN RESPONSIBLE CHARGE**  
 GILBERT M. HERNANDEZ  
 R.C.E. No. 69170 expires 6-30-08  
 DATE 3-2-08

MARK	REVISIONS	APPR.	DATE
DESIGNED BY	DRAWN BY	MAC	CHECKED BY

**CITY OF RIVERSIDE, CALIFORNIA**  
**DEPARTMENT OF PUBLIC WORKS**

APPROVED BY: [Signature]  
 PRINCIPAL ENGINEER  
 ENGINEERING MANAGER

APPROVED BY: [Signature]  
 CITY ENGINEER

CONTRACT ADMIN. [Signature]  
 TRAFFIC ENGINEERING [Signature]

DATE 2/20/08

**TRAFFIC SIGNAL MODIFICATION**  
**FOURTEENTH STREET**  
**91 FREEWAY RAMPS**

SCALE: 1" = 20'

ACCT. NO. X-104  
 SHEET 2 OF 3  
 FILE NAME: X104-2B.DWG

**CONDUCTOR**

**SCHEDULE**

**EQUIPMENT**


**SCHEDULE**

CONTROL FUNCTION	CONDUCTORS		RUNS														1c1	1c2
	SIZE	INSULATION	1	2	3	4	5	6	8	9	10	11	12	13	14			
VEHICLE HEADS	#14	T.W.																
PHASE 1			-	-	-	-	-	-	-	3	3	3	-	-	-	-	-	-
PHASE 2			-	-	-	3	-	-	3	6	3	-	-	-	-	-	-	-
PHASE 4			-	-	-	-	-	-	3	6	-	-	-	-	-	-	-	-
PHASE 5			-	3	3	3	-	-	-	-	-	-	-	-	-	-	-	-
PHASE 6			3	3	3	3	-	-	-	3	3	3	3	3	3	3	-	-
PHASE 8			3	3	3	3	-	-	-	-	-	-	-	-	-	-	-	-
PED. HEADS																		
PHASE 2			-	-	-	2	2	2	2	4	2	-	-	-	-	-	-	-
PHASE 6			2	2	2	2	-	-	-	2	2	2	2	2	2	2	-	-
PED. PUSH BUTTONS																		
PHASE 2			-	-	-	1	1	1	1	2	-	-	-	-	-	-	-	-
PHASE 6			1	1	1	1	-	1	-	1	1	1	1	1	-	-	-	-
12V COMMON			1	1	1	-	-	-	1	2	1	1	1	1	1	-	-	-
SPARES			3	3	3	3	3	3	-	-	-	-	-	-	-	-	-	-
DETECTORS	TYPE C	P.E.																
PHASE 1			-	-	-	-	-	-	-	1	1	1	1	1	1	-	-	-
PHASE 2			-	-	-	3	3	3	-	5	5	-	-	-	-	-	-	-
PHASE 4			-	-	-	-	-	-	-	5	5	5	5	-	-	-	-	-
PHASE 5			-	-	-	1	1	1	-	-	-	-	-	-	-	-	-	-
PHASE 6			-	2	6	6	-	-	-	3	3	3	3	3	3	-	-	-
PHASE 8			-	-	-	6	6	-	-	-	-	-	-	-	-	-	-	-
120V COMMON	#10	T.W.	-	-	-	-	-	-	-	1	3	1	1	1	1	-	-	-
LUMINAIRES	#8	T.H.W.	2	2	2	-	2	2	2	-	2	2	2	2	2	2	-	-
SIGN LIGHTING	#8	T.H.W.	-	-	-	-	-	-	2	-	2	2	2	-	-	-	-	-
SIGNAL SERVICE	#6	T.W.	-	-	-	-	-	-	2	2	-	-	-	-	-	-	-	-
INTERCONNECT	#20	P.E.	-	-	1	1	1	1	1	2	1	1	1	-	-	1	1	-
VEHICLE PREEMPTION	#19	P.E.	1(N)	1(N)	1(N)	2(N)	-	-	1(N)	2(N)	1(N)	1(N)	1(N)	-	-	-	-	-
CONDUIT SIZE			2"	2 1/2"	2 1/2"	2-3"	3"	3"	3 1/2"	2-3"	2-3"	2 1/2"	2 1/2"	2"	2"	3"	3"	3"

NO.	SIGNAL STANDARD			LUMINAIRE		SIGNAL MOUNTING		REMARKS
	TYPE	H'GHT	M.A.	L.A.	H.P.S.V.	VEHICLE	PEDESTRIAN	
(A)	TYPE 19	30'	30'	15'	250W	MAS	SV-1-T SP-1-T	
(B)	TYPE 15	30'		6'	200W			
(C)	TYPE 15	30'		15'	250W	MAS	SV-1-T SP-1-T	
(D)	TYPE 19	30'	25'	15'	250W	MAS	SV-2-TD SP-1-T	
(E)	TYPE 17	30'	18'	6'	200W	MAS	SV-1-T	
(F)	TYPE 15	30'		15'	250W	MAS	SV-1-T SP-1-T	
(G)	SIGN STD.						SV-1-T	
(H)	TYPE 18 (SPEC.)							
(I)	TYPE 17	30'	20'	15'	250W	MAS	SV-2-TB SP-1-T	
(J)	TYPE 16	17'	15'		250W	MAS	SV-1-T	
(K)	TYPE 15	30'		15'	250W	MAS	SV-2-TB SP-1-T	
(L)	SIGN STD.						SV-1-T	
(M)	TYPE 17	30'	20'	15'	250W	MAS	SV-1-T SP-1-T	
(N)	TYPE 18 (SPEC.)							
(O)	TYPE 15	30'		15'	250W	MAS	SV-1-T SP-1-T	

N = NEW EQUIPMENT TO BE PROVIDED AND INSTALLED. ALL OTHER EQUIPMENT, UNLESS OTHERWISE INDICATED, EXISTS AND SHALL REMAIN IN PLACE.

08-07-N-SN-1287

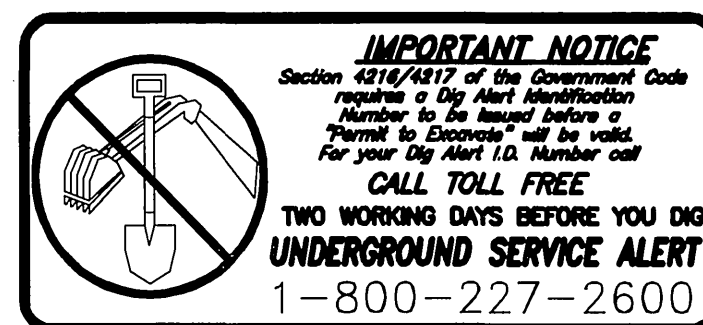

**ENGINEER IN RESPONSIBLE CHARGE**  
 GILBERT M. HERNANDEZ  
 R.C.E. No. 69170 expires 6-30-08  
 DATE 3-2-08

MARK	REVISIONS	APPR. DATE
DESIGNED BY	DRAWN BY MAC	CHECKED BY


**CITY OF RIVERSIDE, CALIFORNIA**  
**DEPARTMENT OF PUBLIC WORKS**

APPROVED BY: [Signature]  
 PRINCIPAL ENGINEER: [Signature]  
 ENGINEERING MANAGER: [Signature]  
 CONTRACT ADMIN: [Signature]  
 TRAFFIC ENGINEERING: [Signature]

**TRAFFIC SIGNAL MODIFICATION**  
**FOURTEENTH STREET**  
**91 FREEWAY RAMPS**


SCALE: 1" = 20'

ACCT. NO. X-104  
 SHEET 3 OF 3  
 FILE NAME: X104-SA.DWG

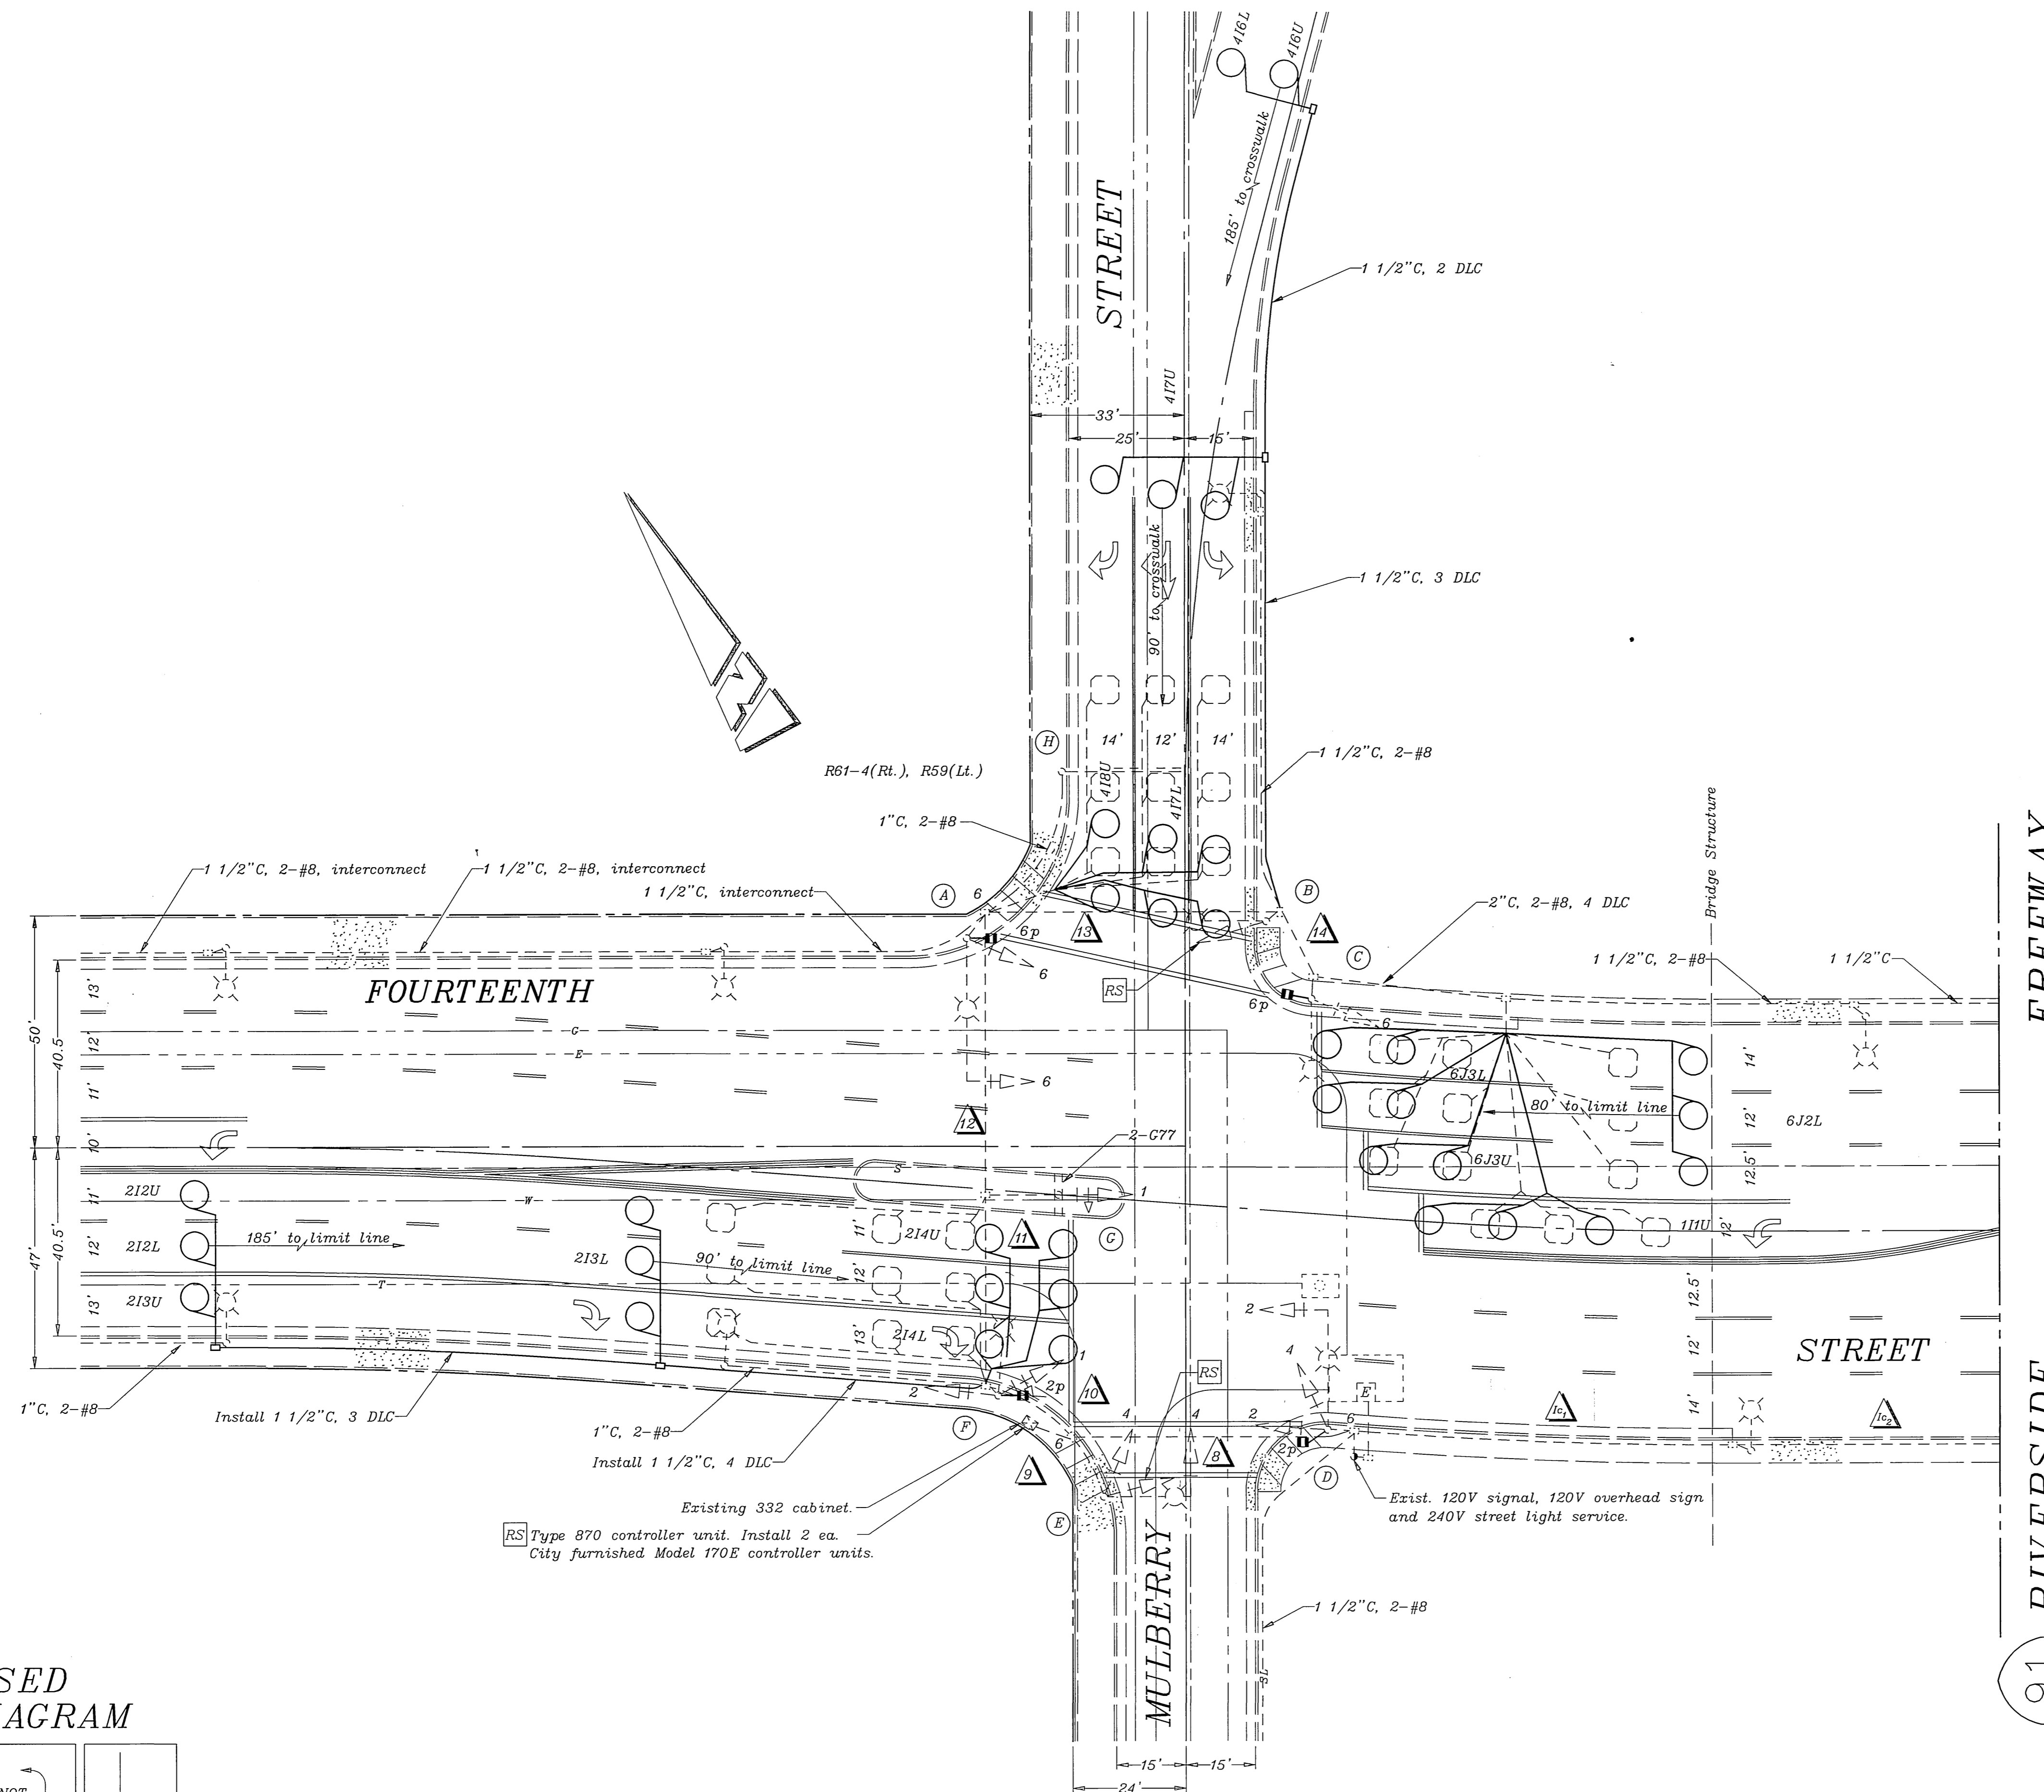

91 RIVERSIDE  
 FREEWAY

**PROPOSED PHASE DIAGRAM**

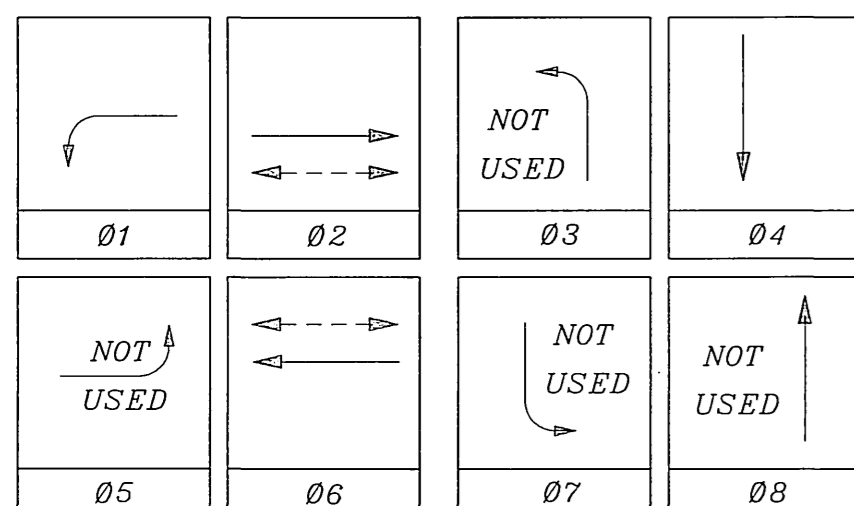

FLASHING OPERATION SHALL BE ALL RED.

**IMPORTANT NOTICE**  
 Section 4216/4217 of the Government Code requires a Dig Alert Identification Number to be issued before a "Permit to Excavate" will be valid. For your Dig Alert ID, Number call CALL TOLL FREE TWO WORKING DAYS BEFORE YOU DIG UNDERGROUND SERVICE ALERT 1-800-227-2600

**ENGINEER IN RESPONSIBLE CHARGE**  
  
 RICHARD D. McGRATH  
 R.C.E. No. 31952 expires 12-31-96  
 DATE 5-30-96

MARK	REVISIONS	APPR.	DATE

DESIGNED BY: \_\_\_\_\_ DRAWN BY: MAC CHECKED BY: [Signature]

CITY OF RIVERSIDE, CALIFORNIA DEPARTMENT OF PUBLIC WORKS			
APPROVED BY	BY	DATE	APPROVED BY
PRINCIPAL ENGINEER	[Signature]	5/30/96	[Signature]
P.W. INSPECTION	[Signature]	5/30/96	[Signature]
TRAFFIC DIVISION	[Signature]	5/30/96	[Signature]
CHIEF P.W. ENGR.	[Signature]	5/30/96	[Signature]
PUBLIC UTILITIES	[Signature]	5/30/96	[Signature]

TRAFFIC SIGNAL MODIFICATION		ACCT. NO.
FOURTEENTH STREET @ 91 FREEWAY RAMPS		0430-541600-440125-35060
SCALE: 1" = 20'		X-104
SHEET 1 OF 3		FILE NAME: X104.DWG

**GENERAL NOTES**



- Detector loops shall be installed in the presence of the Traffic Engineer or his representative.
- Typical detector loop spacing: 10', 15'. (where applicable).

**CONTRACT TE-96-5**  
**FEDERAL AID PROJECT NO. CMLN-5058(20)**

CONTRACTOR'S LICENSE REQUIREMENTS "A" OR "C-10"

91 RIVERSIDE

FREEWAY

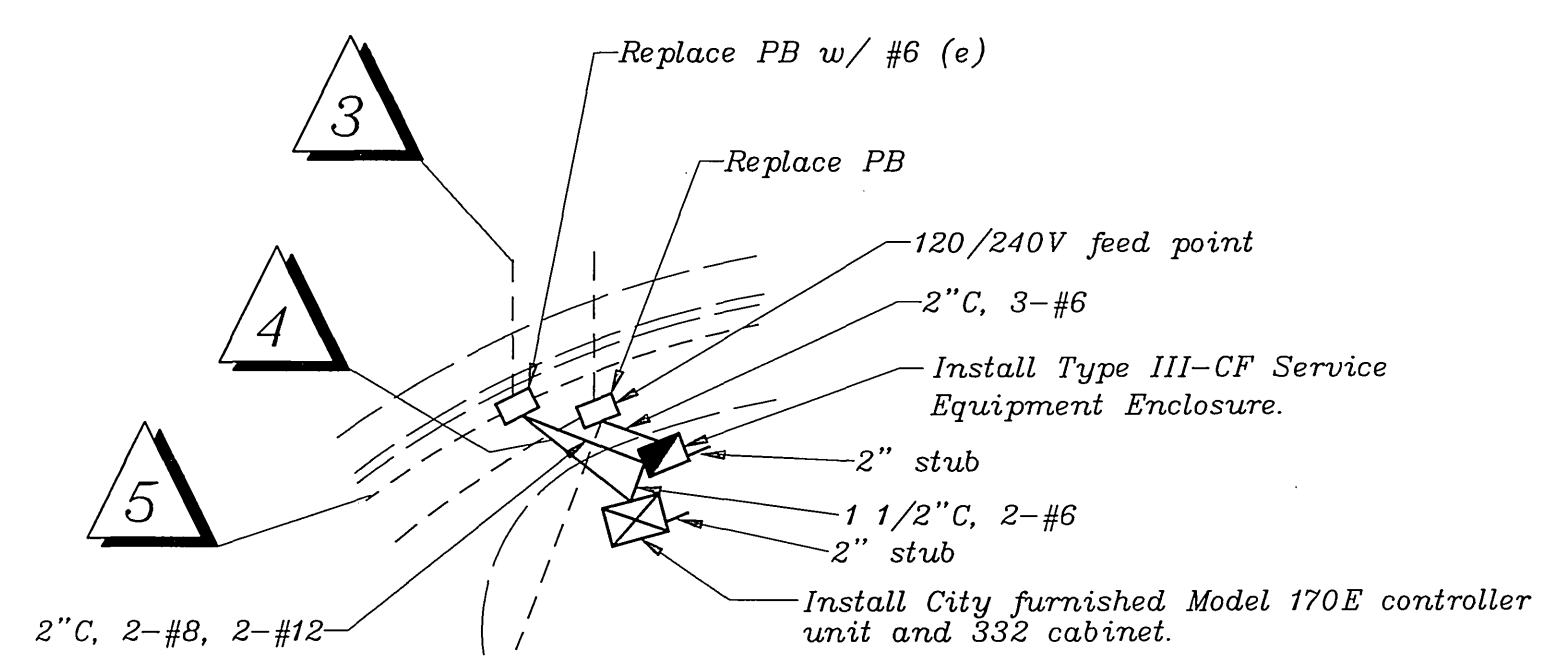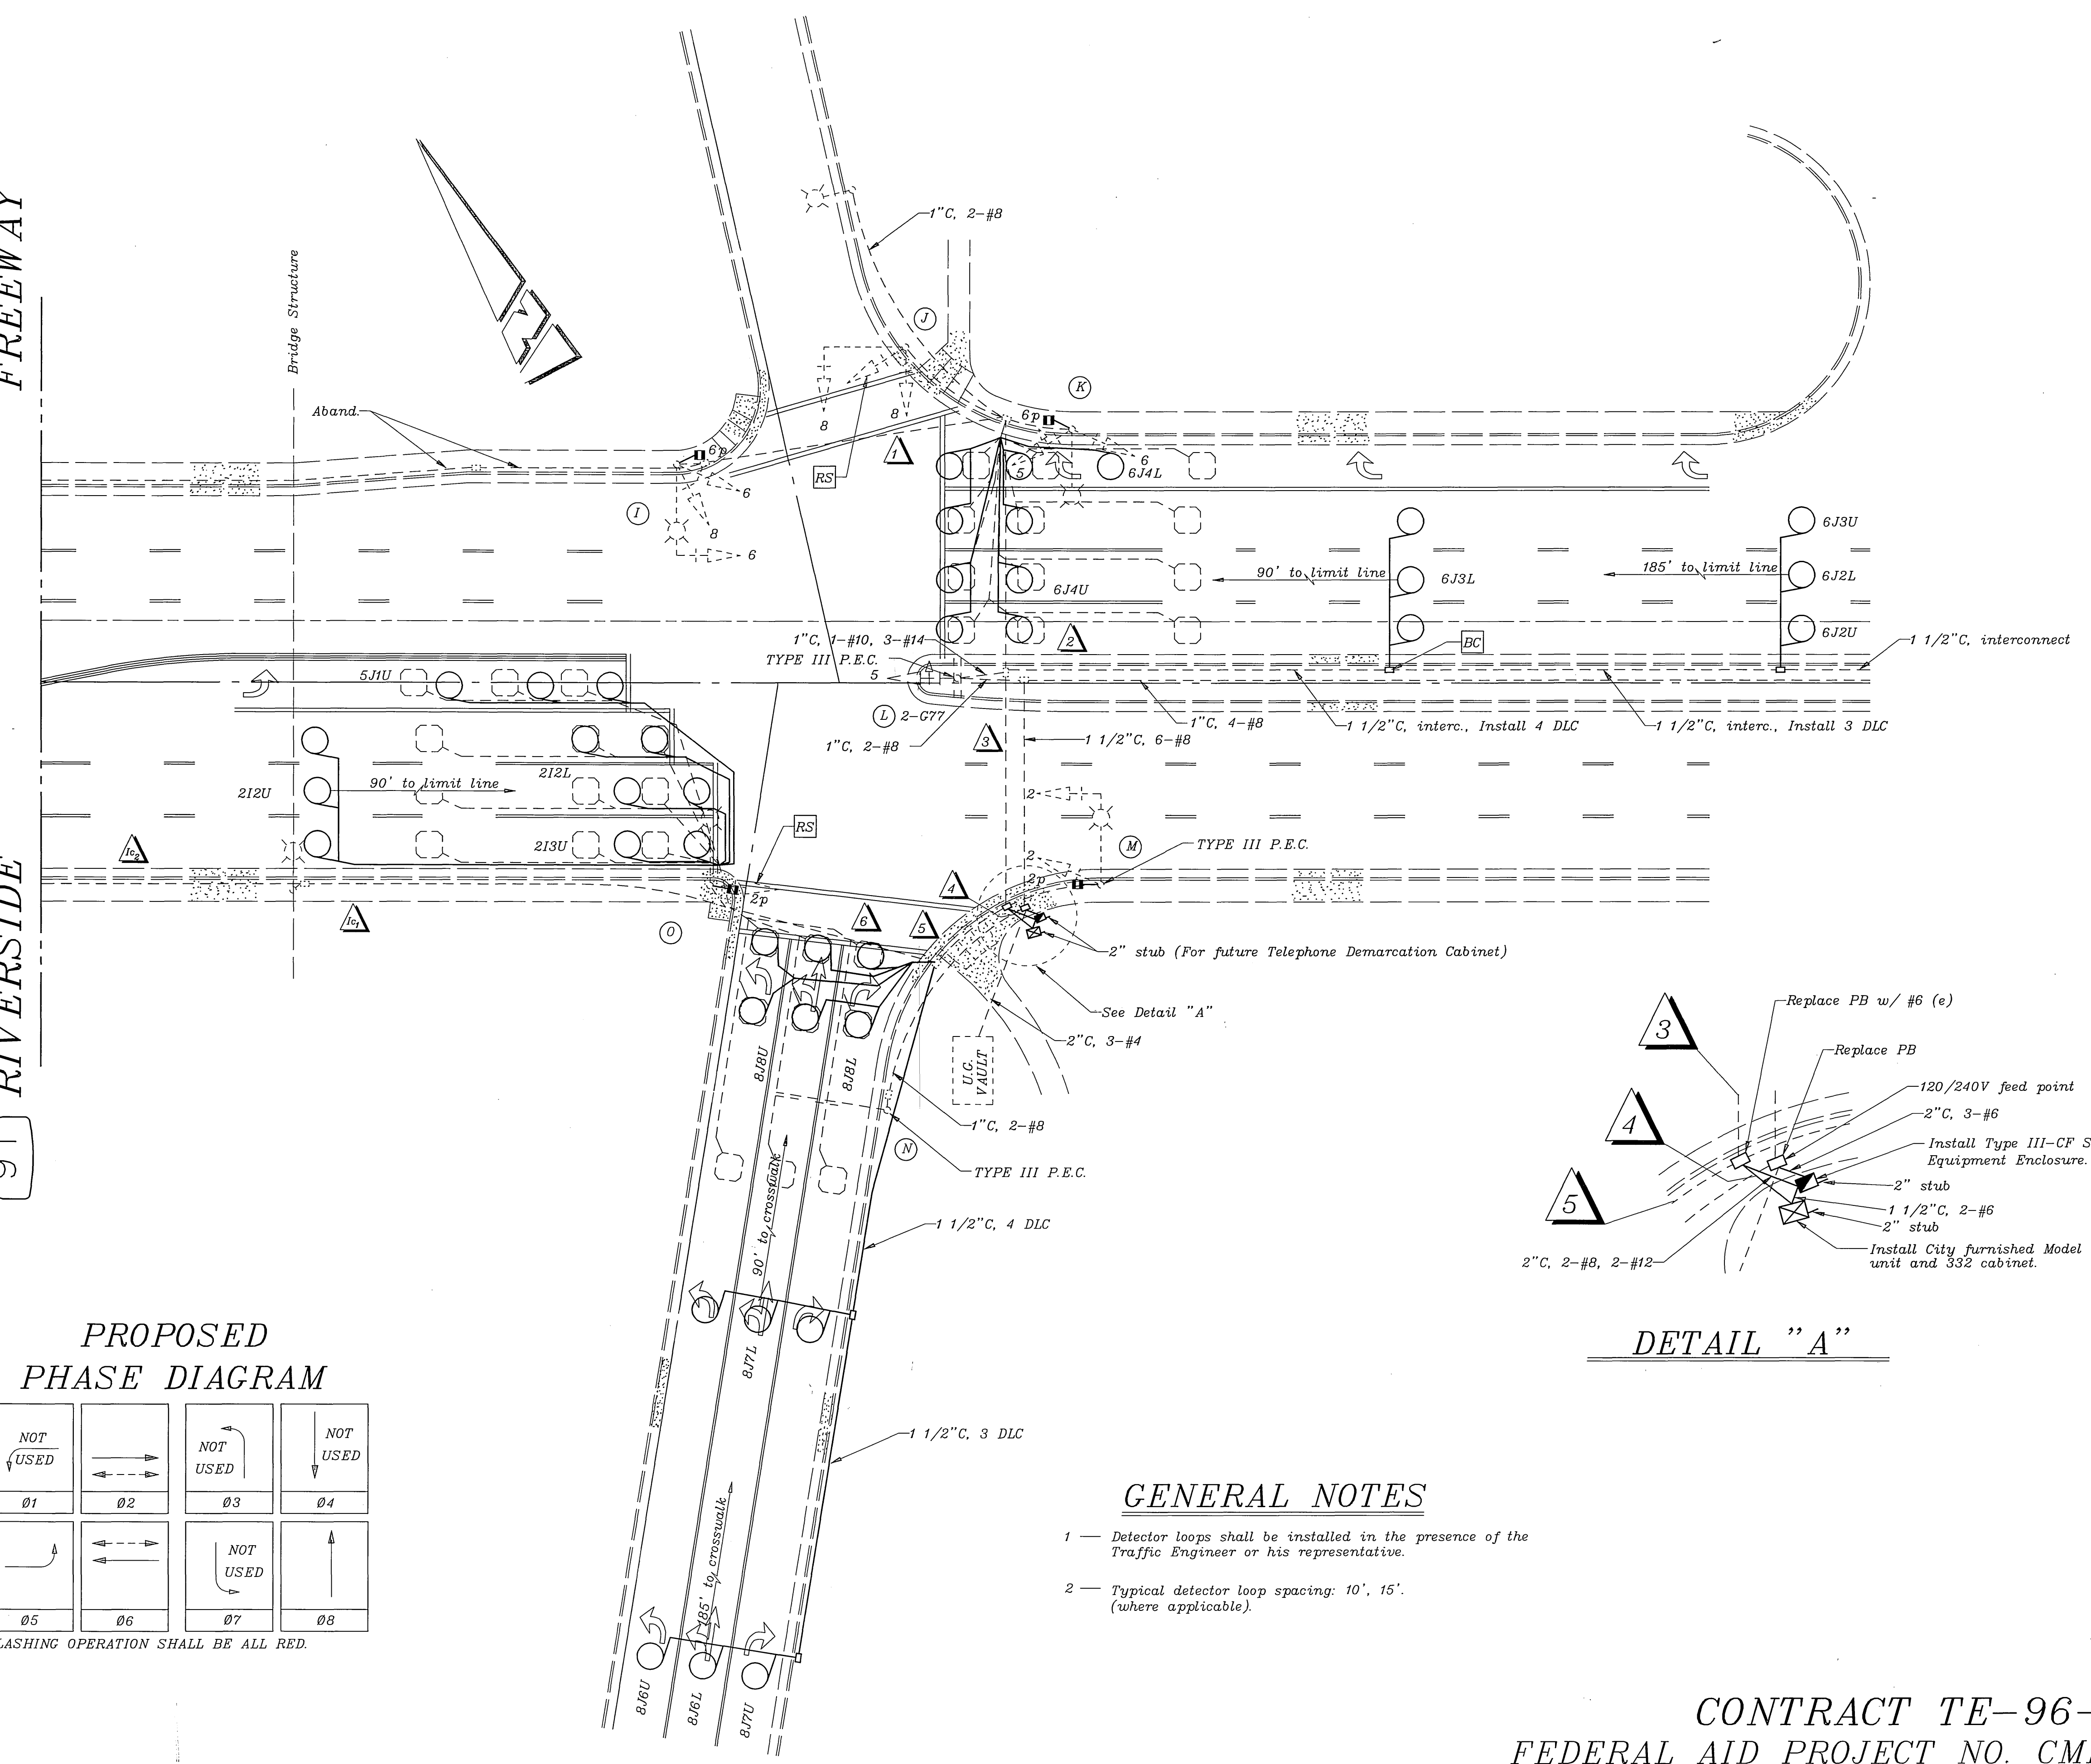

**PROPOSED PHASE DIAGRAM**

NOT USED 01	← → 02	NOT USED 03	NOT USED 04
↻ 05	← → 06	NOT USED 07	↑ 08


FLASHING OPERATION SHALL BE ALL RED.

**GENERAL NOTES**

- 1 — Detector loops shall be installed in the presence of the Traffic Engineer or his representative.
- 2 — Typical detector loop spacing: 10', 15'. (where applicable).

**CONTRACT TE-96-5**  
**FEDERAL AID PROJECT NO. CMLN-5058(20)**  
 CONTRACTOR'S LICENSE REQUIREMENTS "A" OR "C-10"

**IMPORTANT NOTICE**  
 Section 4216/4217 of the Government Code requires a Dig Alert Identification Number to be issued before a "Permit to Excavate" will be valid. For your Dig Alert ID Number call CALL TOLL FREE TWO WORKING DAYS BEFORE YOU DIG UNDERGROUND SERVICE ALERT 1-800-227-2600

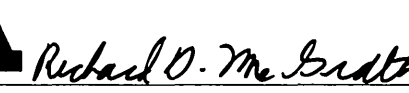**ENGINEER IN RESPONSIBLE CHARGE**  
  
 RICHARD D. McGRATH  
 R.C.E. No. 31952 expires 12-31-96  
 DATE 5-30-96



MARK	REVISIONS	APPR	DATE

DESIGNED BY: \_\_\_\_\_ DRAWN BY: MAC CHECKED BY: \_\_\_\_\_

CITY OF RIVERSIDE, CALIFORNIA  
 DEPARTMENT OF PUBLIC WORKS

APPROVED BY	BY	DATE	APPROVED BY	DATE
PRINCIPAL ENGINEER	<i>[Signature]</i>	5/30/96	<i>[Signature]</i>	5/30/96
P.W. INSPECTION	<i>[Signature]</i>		DIRECTOR OF PUBLIC WORKS	
TRAFFIC DIVISION	<i>[Signature]</i>			
CHIEF P.W. ENGR.	<i>[Signature]</i>			
PUBLIC UTILITIES	<i>[Signature]</i>			

TRAFFIC SIGNAL MODIFICATION  
**FOURTEENTH STREET**  
 @  
**91 FREEWAY RAMPS**

SCALE: 1" = 20'

ACCT. NO. 0430-541600-440125-35060  
**X-104**  
 SHEET 2 OF 3  
 FILE NAME: X104.DWG

CONDUCTOR

SCHEDULE

EQUIPMENT

SCHEDULE

CONTROL FUNCTION	CONDUCTORS		RUNS															
	SIZE	INSULATION	1	2	3	4	5	6	8	9	10	11	12	13	14	1c1	1c2	
VEHICLE HEADS	#14	T.W.	-	-	-	-	-	-	-	3	3	3	-	-	-	-	-	
PHASE 1			-	-	-	3	-	-	3	6	3	-	-	-	-	-	-	
PHASE 2			-	-	-	-	-	-	3	6	-	-	-	-	-	-	-	
PHASE 4			-	-	-	-	-	-	3	6	-	-	-	-	-	-	-	
PHASE 5			-	3	3	3	-	-	-	-	-	-	-	-	-	-	-	
PHASE 6			3	3	3	3	-	-	-	3	3	3	3	3	3	-	-	
PHASE 8			3	3	3	3	-	-	-	-	-	-	-	-	-	-	-	
PED. HEADS																		
PHASE 2			-	-	-	2	2	2	2	4	2	-	-	-	-	-	-	
PHASE 6			2	2	2	2	-	-	-	2	2	2	2	2	2	-	-	
PED. PUSH BUTTONS																		
PHASE 2			-	-	-	1	1	1	1	2	-	-	-	-	-	-	-	
PHASE 6			1	1	1	1	-	1	-	1	1	1	1	1	-	-	-	
12V COMMON			1	1	1	-	-	-	1	2	1	1	1	1	1	-	-	
SPARES			3	3	3	3	3	3	-	-	-	-	-	-	-	-	-	
DETECTORS	TYPE C	P.E.																
PHASE 1			-	-	-	-	-	-	-	1	1	1	1	1	1	-	-	
PHASE 2			-	-	-	3	3	3	-	5	5	-	-	-	-	-	-	
PHASE 4			-	-	-	-	-	-	-	5	5	5	5	-	-	-	-	
PHASE 5			-	-	-	1	1	1	-	-	-	-	-	-	-	-	-	
PHASE 6			-	2	6	6	-	-	-	3	3	3	3	3	3	-	-	
PHASE 8			-	-	-	6	6	-	-	-	-	-	-	-	-	-	-	
120V COMMON	#10	T.W.	-	-	-	-	-	-	-	1	3	1	1	1	1	-	-	
LUMINAIRES	#8	T.H.W.	2	2	2	-	2	2	2	-	2	2	2	2	2	2	-	
SIGN LIGHTING	#8	T.H.W.	-	-	-	-	-	-	2	-	2	2	2	-	-	-	-	
SIGNAL SERVICE	#6	T.W.	-	-	-	-	-	-	2	2	-	-	-	-	-	-	-	
INTERCONNECT	#20	P.E.	-	-	1	1	1	1	1	2	1	1	1	-	-	1	1	
CONDUIT SIZE			2"	2 1/2"	2 1/2"	2-3"	3"	3"	3 1/2"	2-3"	2-3"	2 1/2"	2 1/2"	2"	2"	3"	3"	



(E) (E) (E) (N) (E) (E) (E) (E) (E) (E) (E) (E) (E) (E) (E) (E) (E)

NO.	SIGNAL STANDARD			LUMINAIRE		SIGNAL MOUNTING		REMARKS
	TYPE	H'GHT	M.A.	L.A.	H.P.S.V.	VEHICLE	PEDESTRIAN	
(A)	TYPE 19	30'	30'	15'	250W	MAS	SV-1-T SP-1-T(N)	
(B)	TYPE 15	30'		6'	200W			
(C)	TYPE 15	30'		15'	250W	SV-1-T	SP-1-T(N)	
(D)	TYPE 19	30'	25'	15'	250W	MAS	SV-2-TD SP-1-T(N)	
(E)	TYPE 17	30'	18'	6'	200W	MAS	SV-1-T(N)	PROVIDE NEW FRAMEWORK FOR MOUNTING AS INDICATED.
(F)	TYPE 15	30'		15'	250W	SV-1-T	SP-1-T(N)	
(G)	SIGN STD.						SV-1-T	
(H)	TYPE 18 (SPEC.)							
(I)	TYPE 17	30'	20'	15'	250W	MAS	SV-2-TB SP-1-T(N)	
(J)	TYPE 16	17'	15'		250W	MAS	SV-1-T(N)	PROVIDE NEW FRAMEWORK FOR MOUNTING AS INDICATED.
(K)	TYPE 15	30'		15'	250W	SV-2-TB	SP-1-T(N)	
(L)	SIGN STD.						SV-1-T	
(M)	TYPE 17	30'	20'	15'	250W	MAS	SV-1-T SP-1-T(N)	
(N)	TYPE 18 (SPEC.)							
(O)	TYPE 15	30'		15'	250W	SV-1-T	SP-1-T(N)	

N = NEW EQUIPMENT TO BE PROVIDED AND INSTALLED. ALL OTHER EQUIPMENT, UNLESS OTHERWISE INDICATED, EXISTS AND SHALL REMAIN IN PLACE.  
NOTE L.E.D. REQUIREMENTS SHALL NOT APPLY.

1. THE TRAFFIC SIGNAL SYSTEM SHALL HAVE NEW CABLES AND CONDUCTORS.
2. THE EXISTING INTERCONNECT CABLE SHALL BE REUSED, EXCEPT THAT PORTION BETWEEN THE TRAFFIC SIGNAL CONTROLLER CABINETS. NEW CABLE SHALL BE INSTALLED, SEE CONTRACT SPECIAL PROVISIONS FOR CABLE SPECIFICATIONS.

CONTRACT TE-96-5  
FEDERAL AID PROJECT NO. CMLN-5058(20)  
CONTRACTOR'S LICENSE REQUIREMENTS "A" OR "C-10"

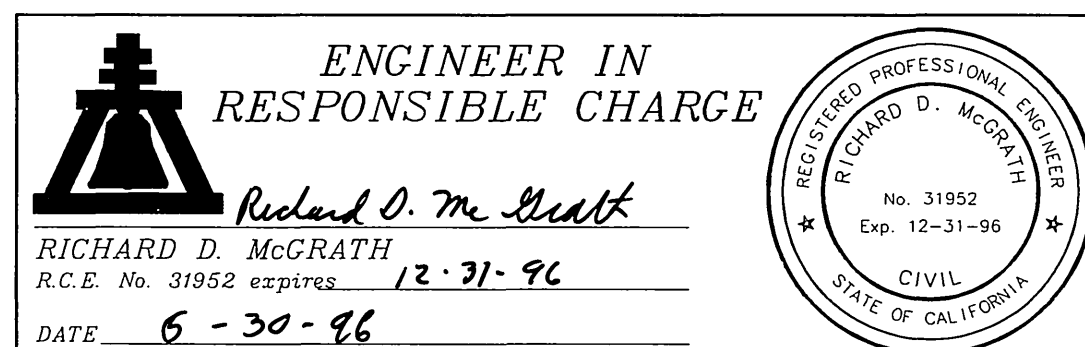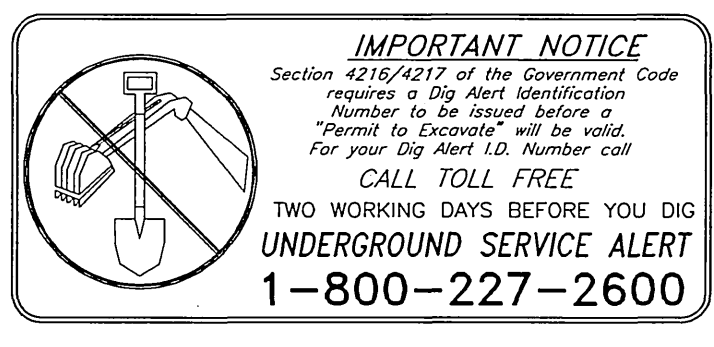

MARK	REVISIONS	APPR	DATE
DESIGNED BY	DRAWN BY	MAC	CHECKED BY

CITY OF RIVERSIDE, CALIFORNIA DEPARTMENT OF PUBLIC WORKS		
APPROVED BY	BY	DATE
PRINCIPAL ENGINEER	REZ	5/20/96
P.W. INSPECTION	REZ	5/20/96
TRAFFIC DIVISION	REZ	5/20/96
CHIEF P.W. ENGR	REZ	5/20/96
PUBLIC UTILITIES	REZ	5/20/96

TRAFFIC SIGNAL MODIFICATION	ACCT. NO. 0430-541600-440125-35060
FOURTEENTH STREET	X-104
91 FREEWAY RAMPS	SHEET 3 OF 3
SCALE: 1" = 20'	FILE NAME: X104-3.DWG

**SIGNING REQUIREMENTS**


Loc.	Code	Size	Mounting	Facing	Remarks
C	R53	24"x24"	Signal Std.	W	Mount above vehicle head
D	R53A	38"x22"	OH Sign Standard	W	Mount above vehicle head
	2-G77	12"x78"	OH Sign Standard	E&W	
F	R61-3(LT)	45"x45"	Mast Arm	S	
	R59(LRT)	42"x45"	Mast Arm	S	

NOTE: All sign codes are California State Std.

**EQUIPMENT SCHEDULE**

Location	Standard	Vehicle Equipment			Ped. Equipment			Luminaire
		Heads	Mtg's	Back Plate	Loak.	Heads	Mtg's	
A	Type XVII 15LA, 20SA	1W3C (12")	M-2	1				1000W
B	Type XII	1W3C (10")	M-2	1	3			
C	Type XV	2W3C	B-2	1				1000W
D	Type XV	R.Y. 12' GA	B-1	1				4-PRT/2
E	Type XVII	1W3C*	M-2	1				1000W
F	Type XVII (Spec.)	1W3C	B-1	1				2-F4T-6
G	Type XII	1W3C	B-1	1	3			1000W
H	Type XV	15' LA						1000W
I	Type IV	6' LA						400W

\* PROGRAMMED VISIBILITY HEAD.

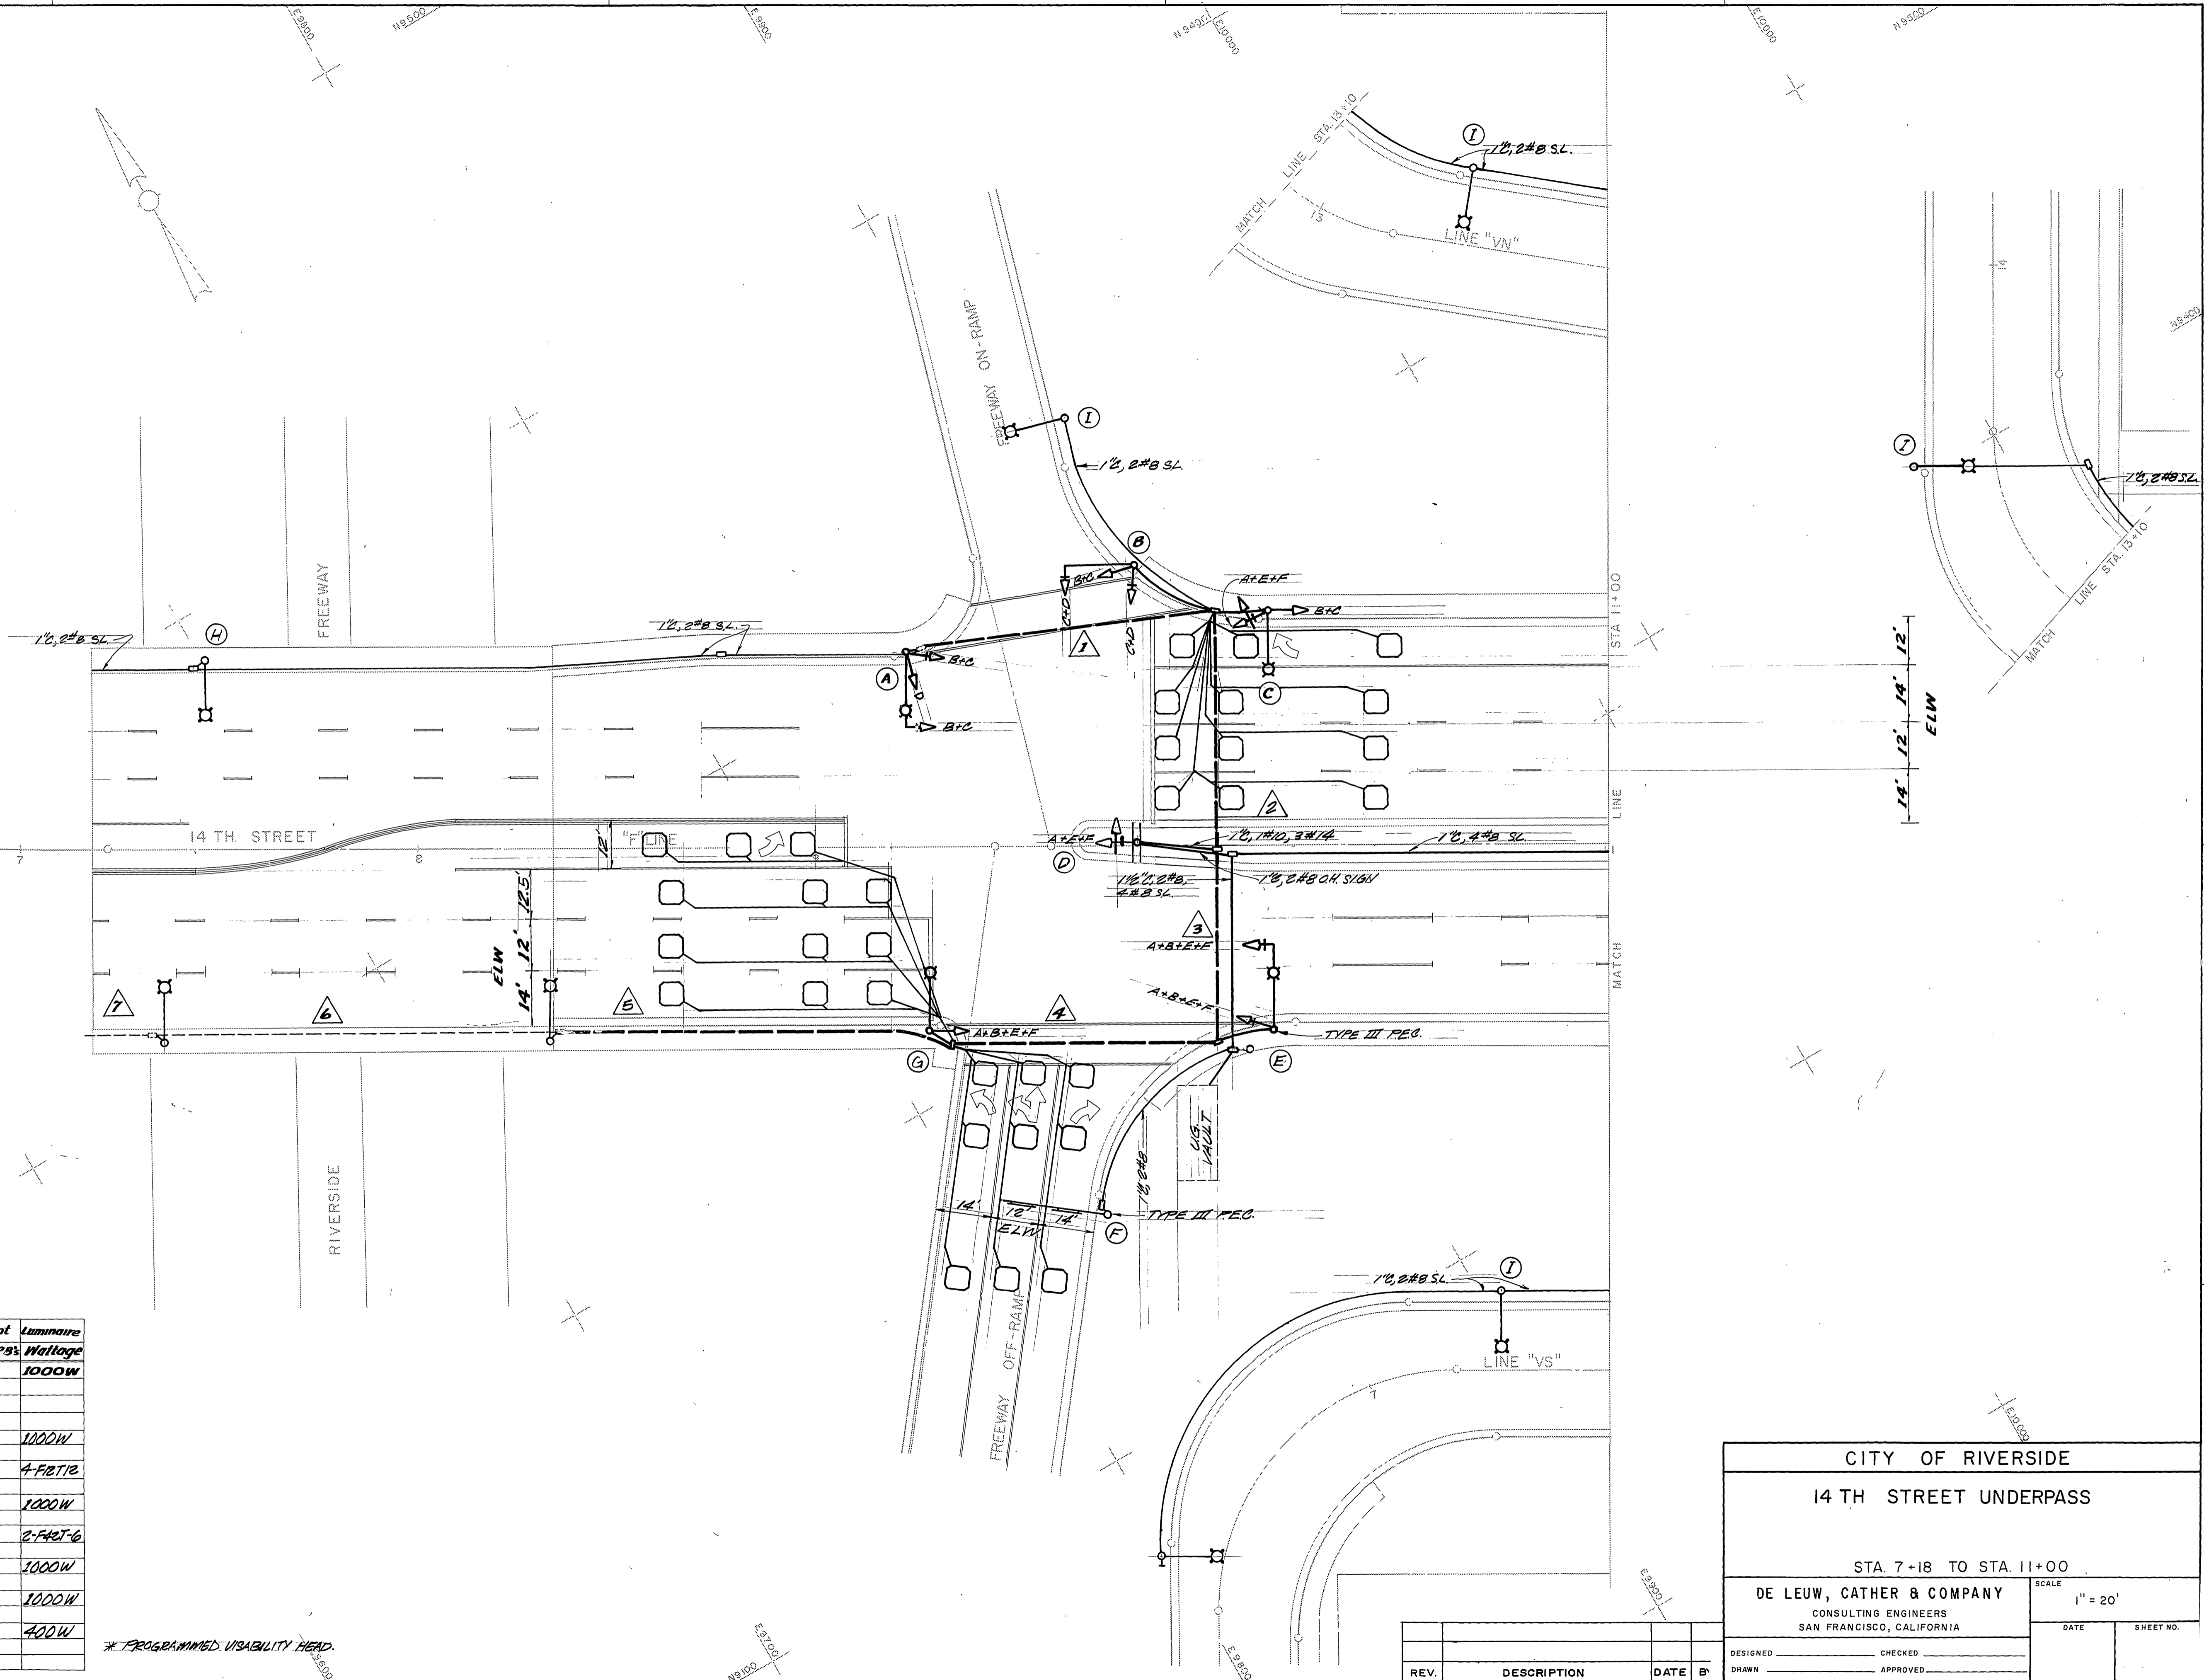

**CITY OF RIVERSIDE**  
14 TH STREET UNDERPASS

STA. 7+18 TO STA. 11+00

**DE LEUW, CATHER & COMPANY**  
CONSULTING ENGINEERS  
SAN FRANCISCO, CALIFORNIA


SCALE: 1" = 20'

DESIGNED _____	CHECKED _____
DRAWN _____	APPROVED _____

DATE \_\_\_\_\_ SHEET NO. \_\_\_\_\_

REV.	DESCRIPTION	DATE	BY



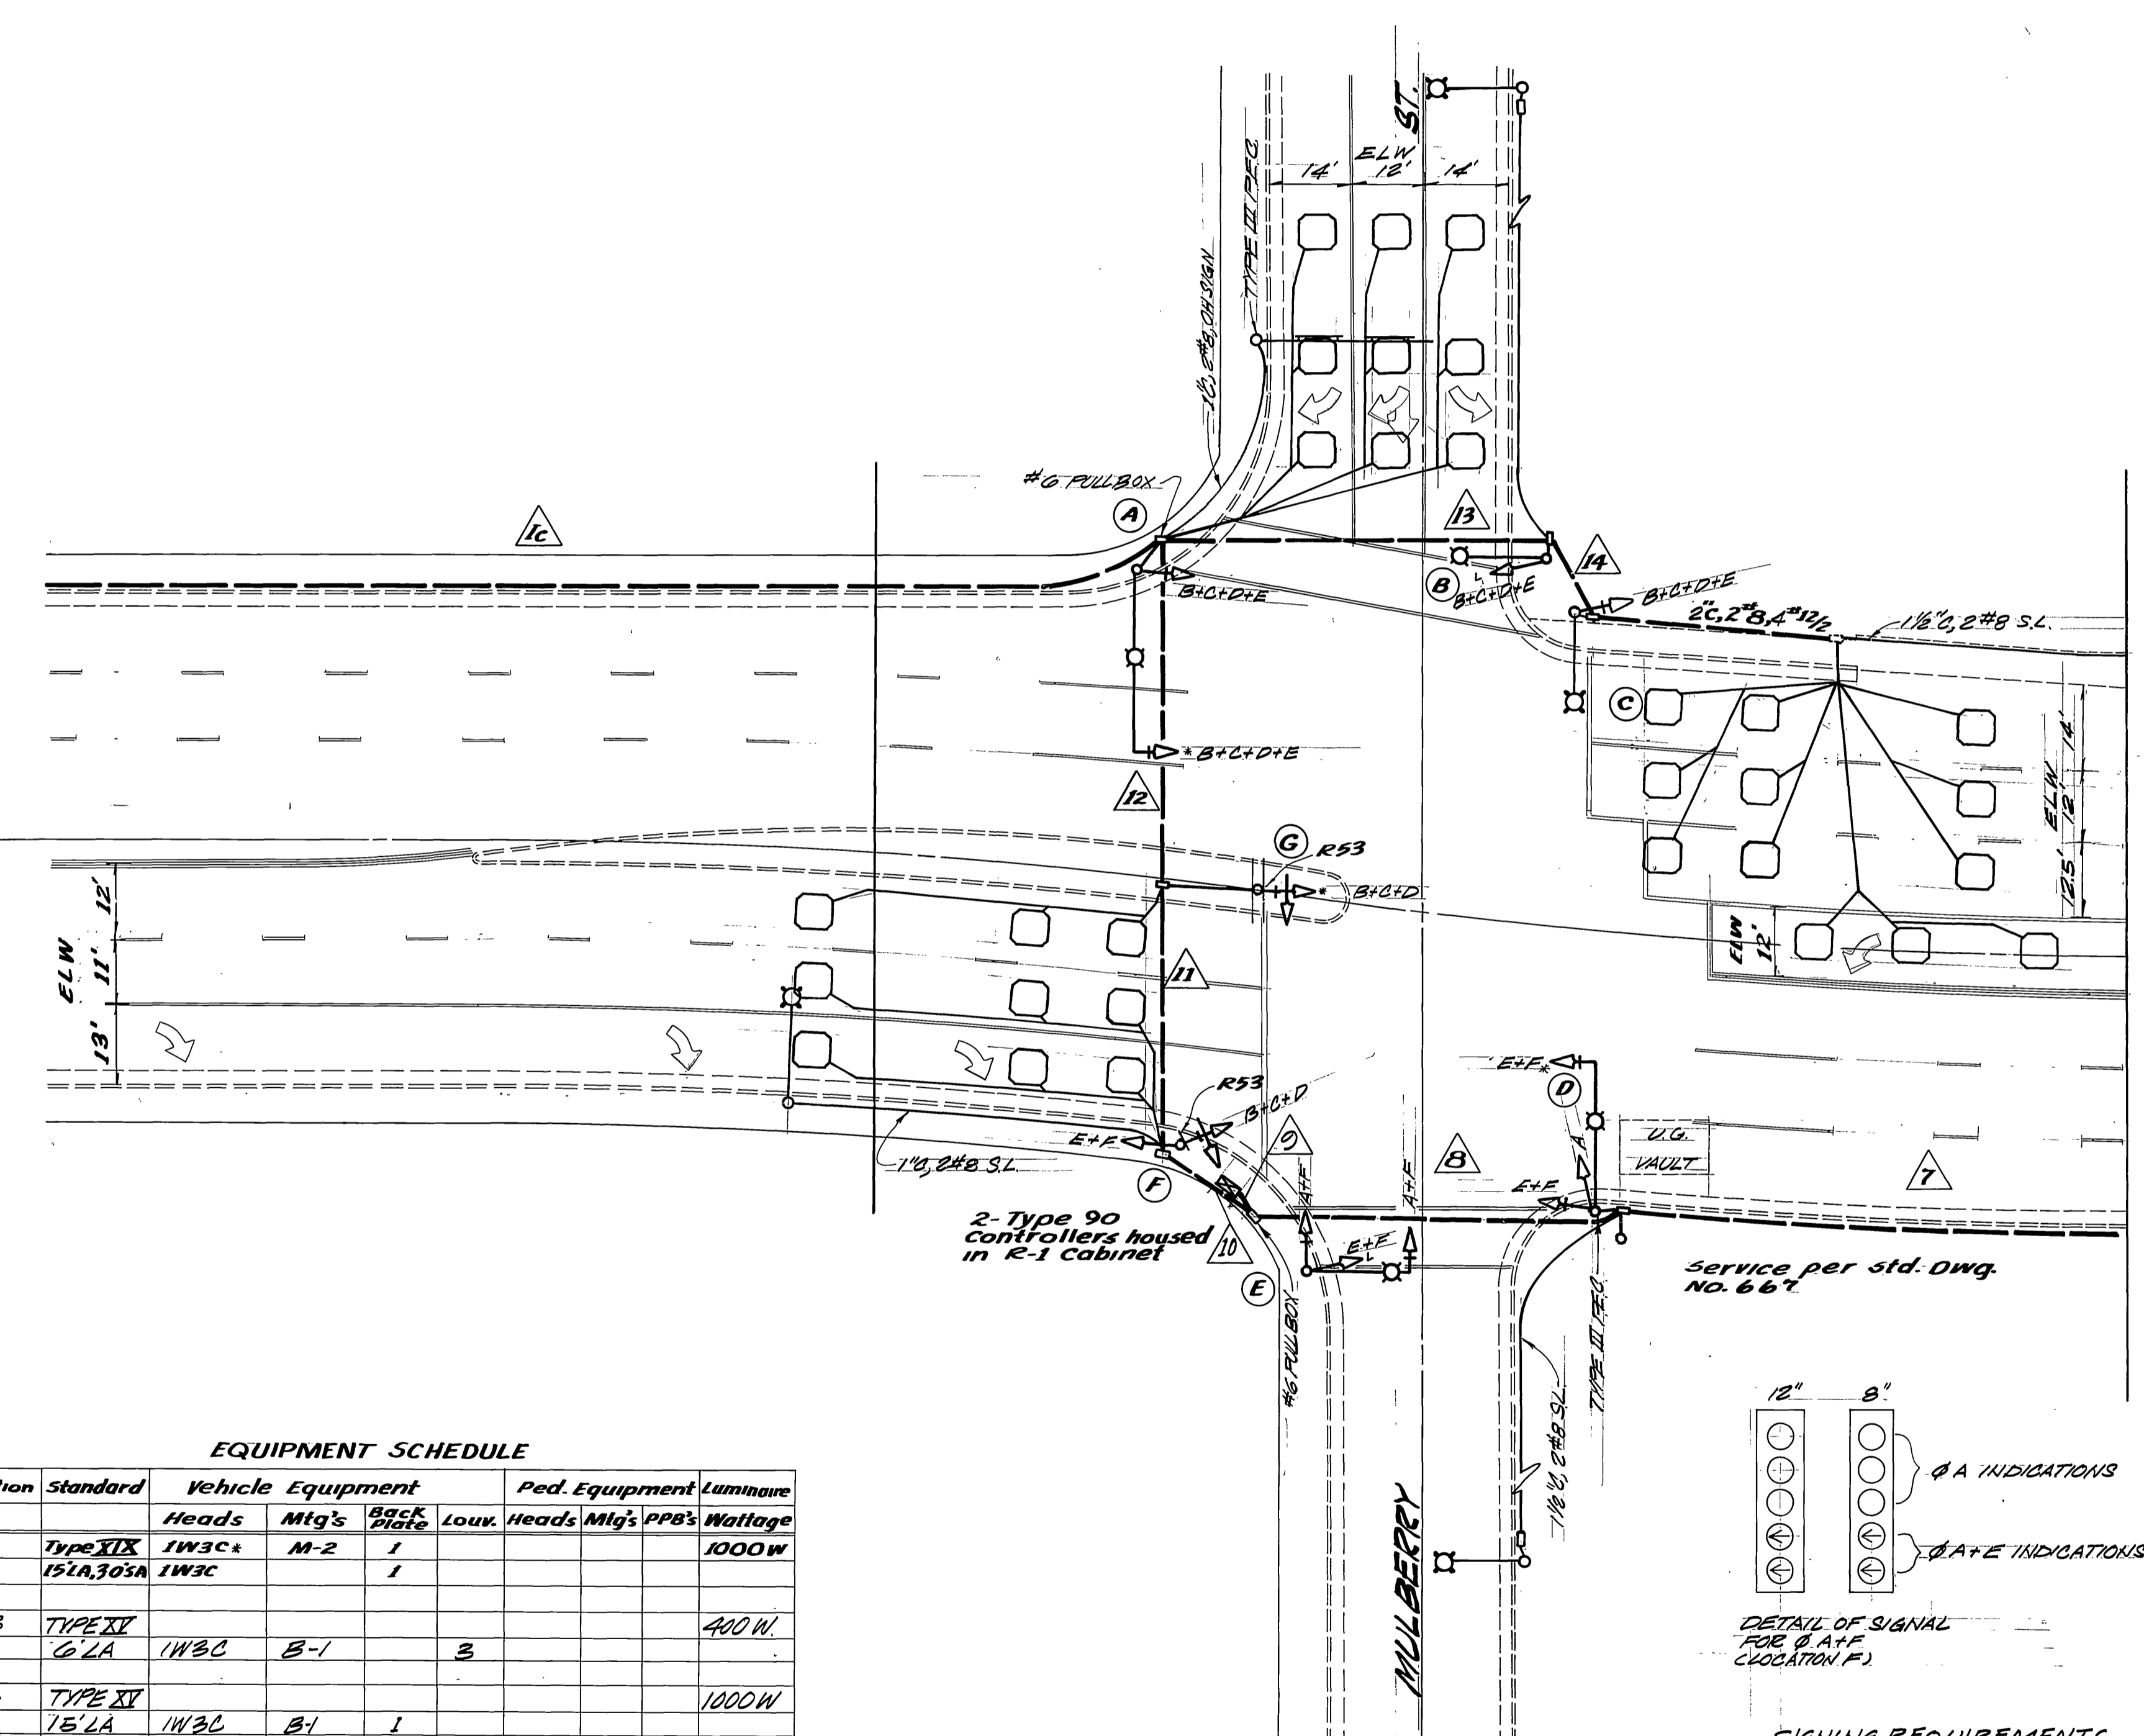


### CONDUCTOR SCHEDULE

CONTROL FUNCTION	CONDUCTORS SIZE INSULATION	CONDUIT RUN																			
		1	2	3	4	5	6	7	8	9	10	11	12	13	14	15	16	17	18	19	20
VEHICLE HEADS #14	TW																				
Ø A+E	#10																				
Ø A+B+E+F	#10																				
Ø A+E+F	#10																				
Ø B+C	#14																				
Ø B+C+D	#14																				
Ø B+C+D+E	#14																				
Ø C	#10																				
Ø E+F	#14																				
SPARES	#10																				
SPARES	#10																				
DET. CABLE #106	PE																				
Ø A																					
Ø B																					
Ø C																					
Ø D																					
Ø E																					
Ø F																					
Ø G																					
Ø H																					
Ø I																					
TOTALS #14	TW																				
#10																					
#14	T.W.																				
#10	PE																				
#14																					
CONDUIT SIZE		Ø"	Ø 1/2"	Ø 3/4"	Ø 1"	Ø 1 1/4"	Ø 1 1/2"	Ø 2"	Ø 2 1/2"	Ø 3"	Ø 3 1/2"	Ø 4"	Ø 4 1/2"	Ø 5"	Ø 5 1/2"	Ø 6"	Ø 6 1/2"	Ø 7"	Ø 7 1/2"	Ø 8"	Ø 8 1/2"

CONDUCTORS FOR LUMINAIRES ARE No. 8 CU. WITH 2/64" THIN INSULATION RATED FOR 600V, EXCEPT AS NOTED. # = No. 6 CU. RUNS 5, 6 & 7.

### EQUIPMENT SCHEDULE

Location	Standard	Vehicle Equipment			Ped. Equipment			Luminaire
		Heads	Mtg's	Back Plate	Louv. Heads	Mtg's	PPB's	
A	TYPE XIX 15LA, 30SA	1W3C*	M-2	1				1000W
B	TYPE IX 6LA	1W3C	B-1		3			400W
C	TYPE IX 15LA	1W3C	B1	1				1000W
D	TYPE XIX 15LA, 25SA	1W3C*	M-2	1				1000W
E	TYPE XIX 6LA, 18SA	2W3C	B-2	1	3			400W
F	TYPE XV 15LA	2W3C	B-2	1				1000W
G	SIGN STD.	1W3C(GA)*	B-1	1				4-FRET12
H	XVIII (SPEL)							2-FRET6
I	68J10							400W

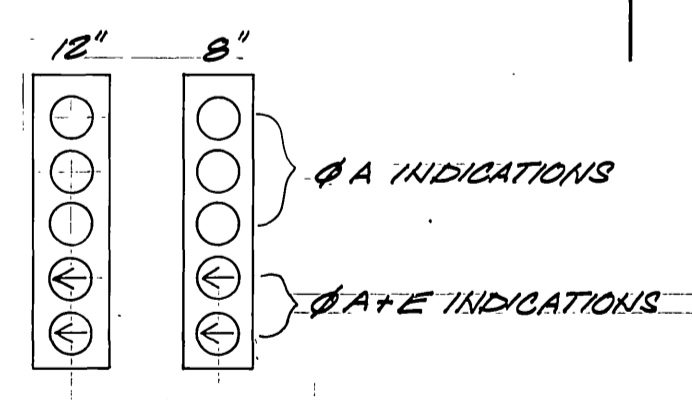


### SIGNING REQUIREMENTS

LOC.	Code#	Size	Mounting	Facing	Remarks
F	R53	24"x24"	Signal Std.	E	Mount above vehicle head
G	R53A	38"x22"	Sign Std.	E	Mount above vehicle head
	Z-677	12"x70"	O.H. Sign Standard	E&W	
H	R61-A (R)	45"x45"	Mast Arm	N	
	R59 (Lt.)	42"x45"	Mast Arm	N	


NOTE: ALL SIGN CODES ARE CALIFORNIA STATE STANDARD.

### PHASE DIAGRAM

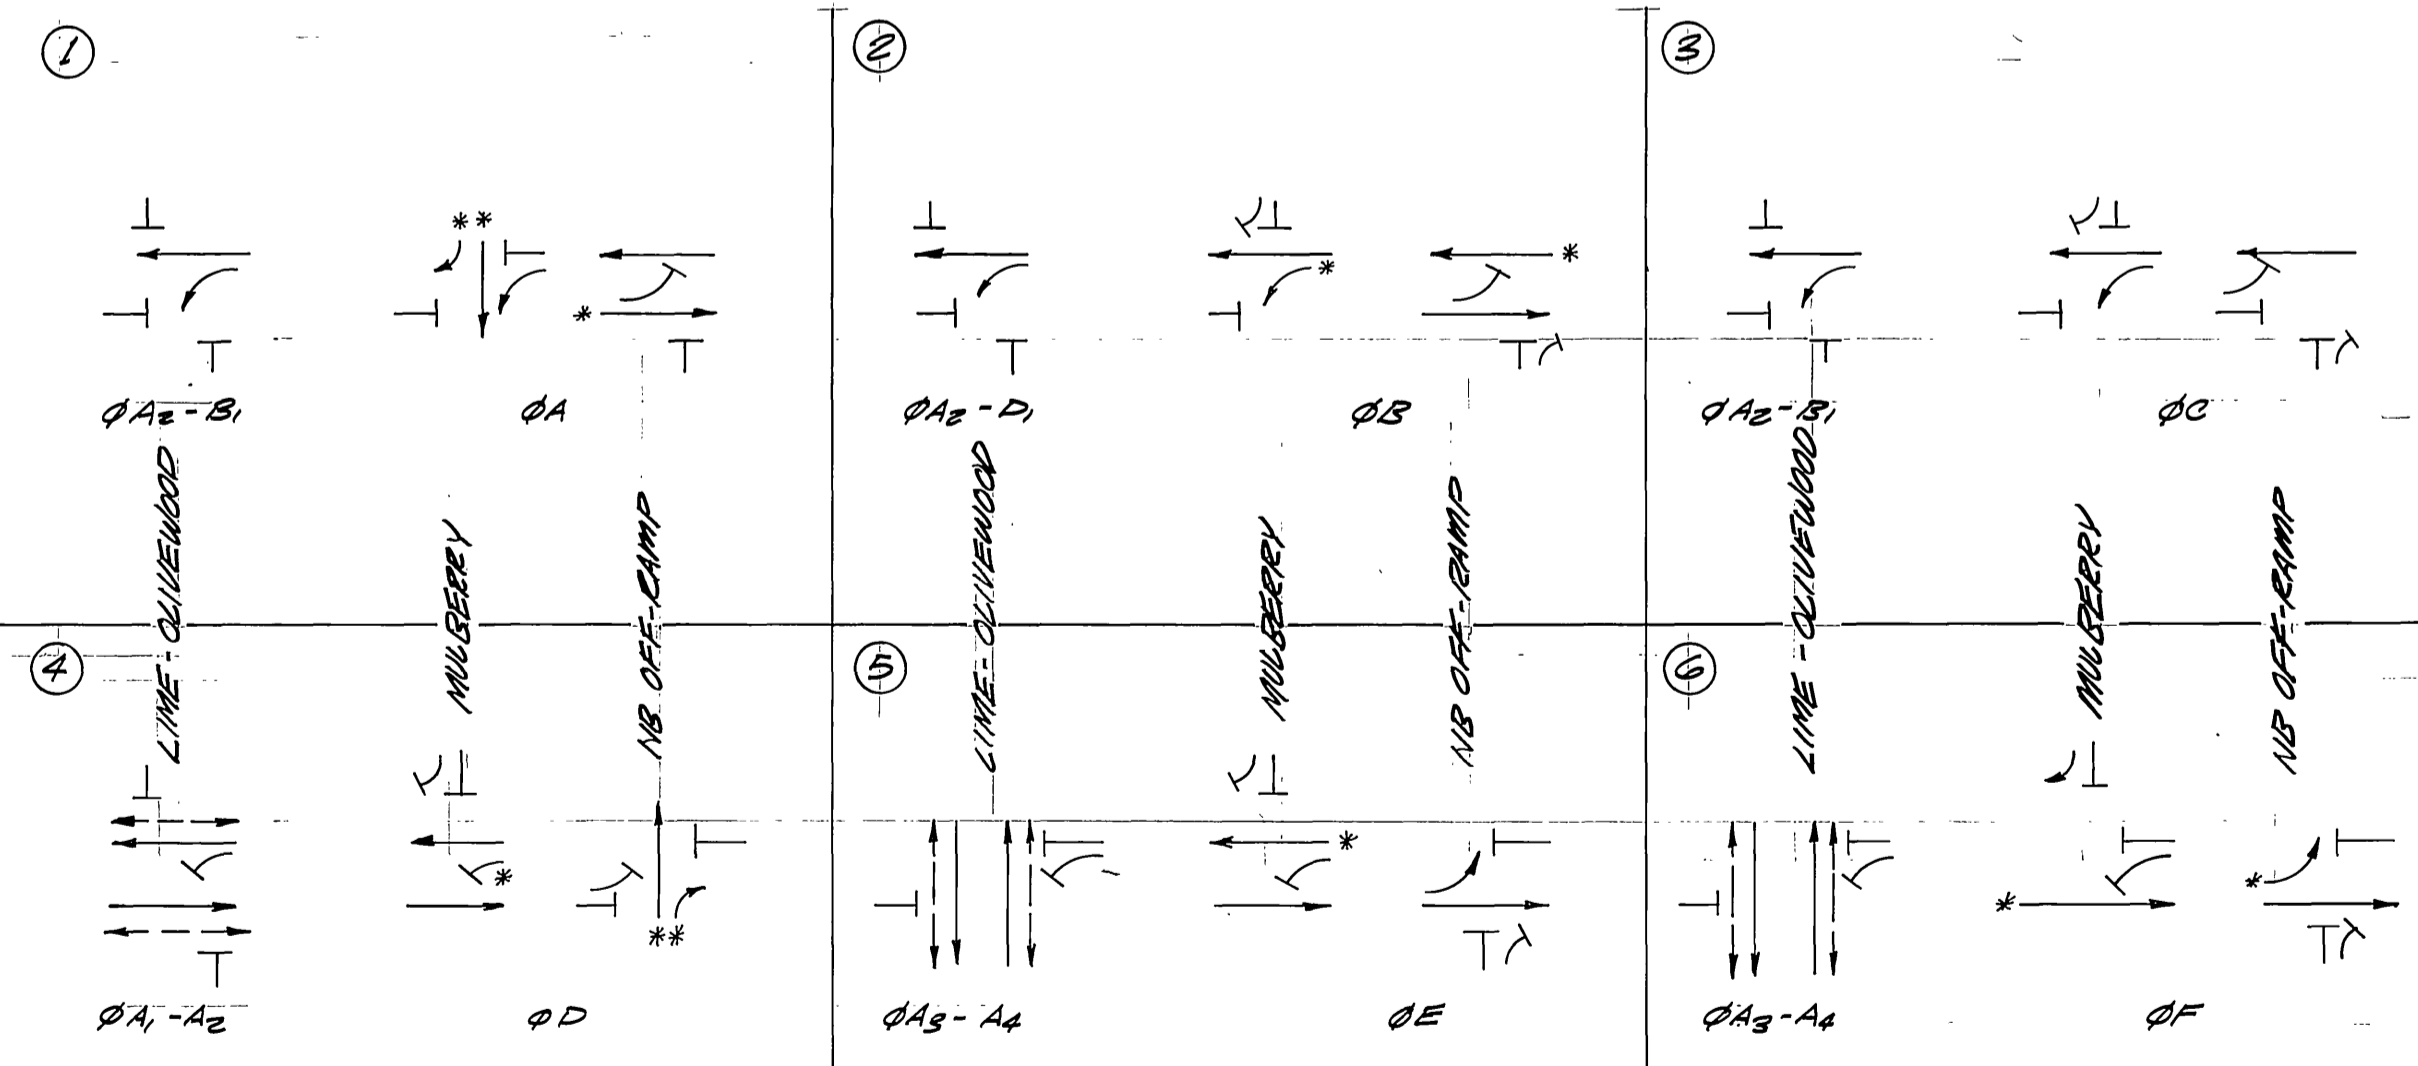


INTERCONNECTION PHASE DIAGRAM VIA TIME SWITCH WITH PHASE C YELLOW (Y) CONTROLLING FORCE-OFF CIRCUIT.

\* DETECTOR CONTROLLING PHASE LENGTH FLASHING INDICATION: ALL RED. ALL MODULES = TYPE "S"

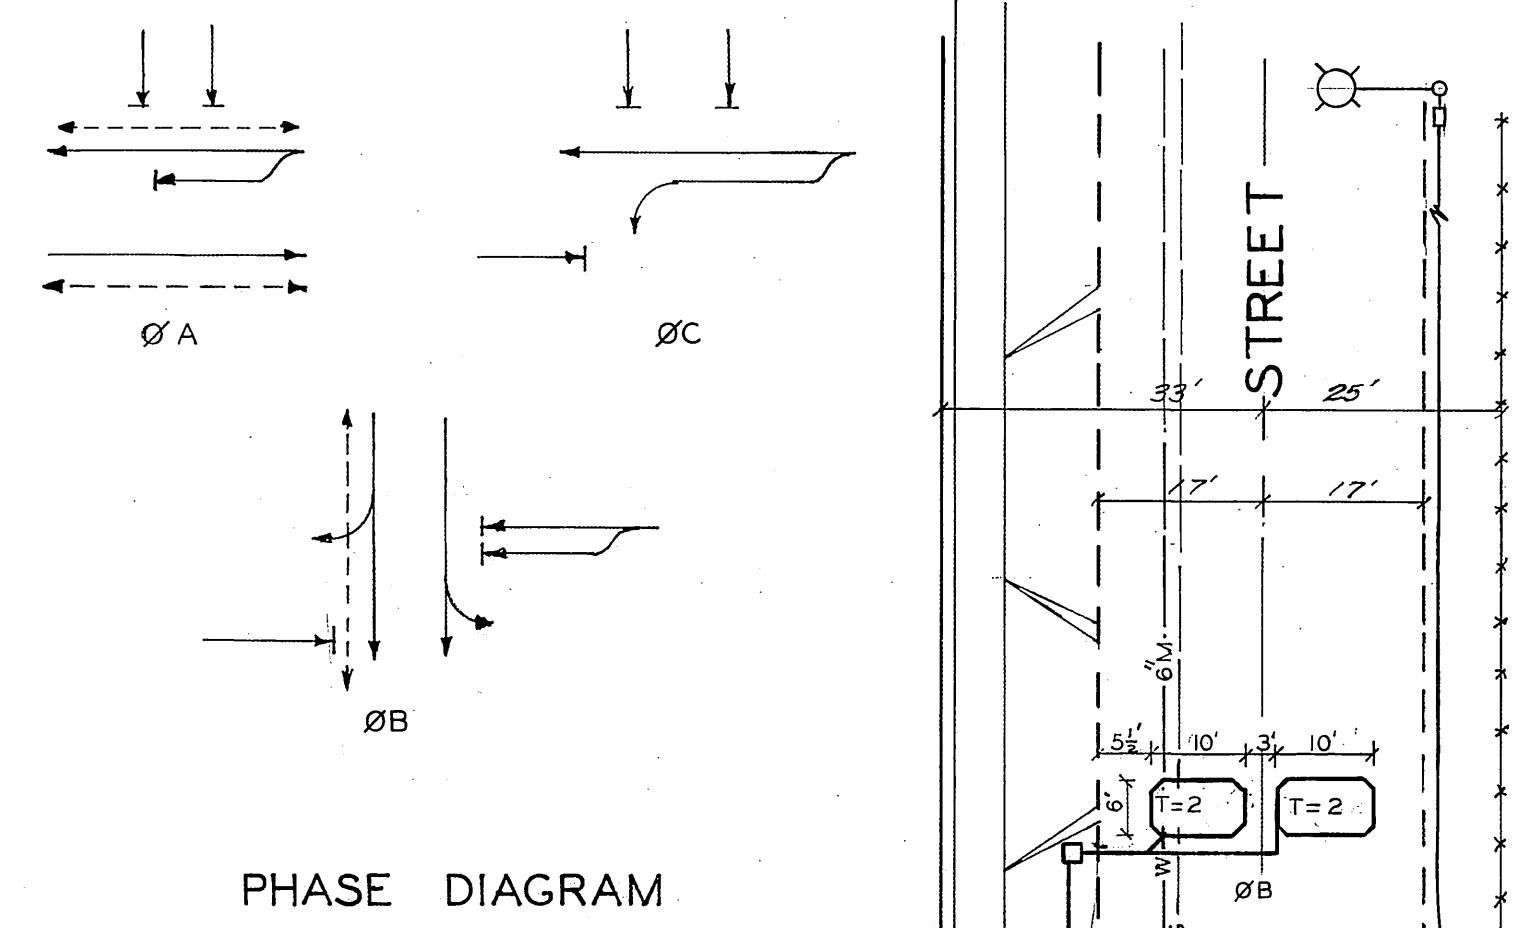


PHASE DIAGRAM

CONDUCTOR RUN	1		2		3		4		5		6		7		8																
CONDUCTORS	8	10	12	14	8	10	12	14	8	10	12	14	8	10	12	14	8	10	12	14											
Ø A																															
Ø A + Ø C																															
Ø C																															
Ø B																															
Ø A W-DW																															
Ø B W-DW																															
120V NEUTRAL																															
Ø A PPB																															
Ø B PPB																															
Ø A CALL DET.																															
Ø A DET.																															
Ø C DET.																															
Ø B DET.																															
Ø B CALL DET.																															
Ø A DET.																															
LUMINAIRES																															
SIGNAL SERVICE																															
12V NEUTRAL																															
INTERCONNECT																															
SPARES																															
TOT. CONDUCTORS	2	1	6	2	1	2	11	2	1	3	11	4	1	8	16	1	2	3	4	1	9	16	1	20	27	1	11	11	1	2	5
CONDUIT SIZE	1 1/2"		1 1/2"		1 1/2"		1 1/2"		2"		2"		1 1/2"		2"		2"		2"		2"		2"		3"		2"		2"		

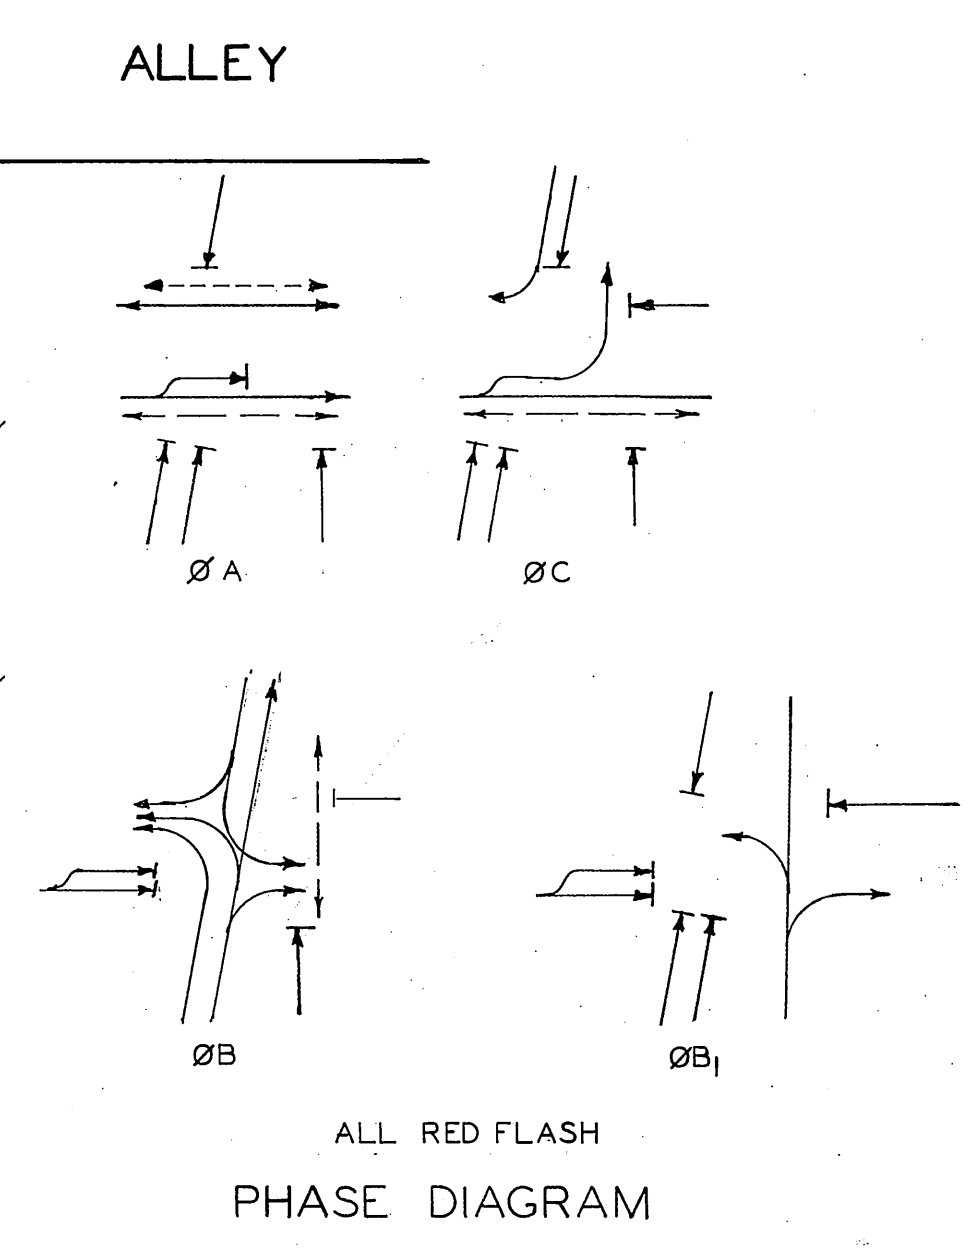


ALL RED FLASH PHASE DIAGRAM

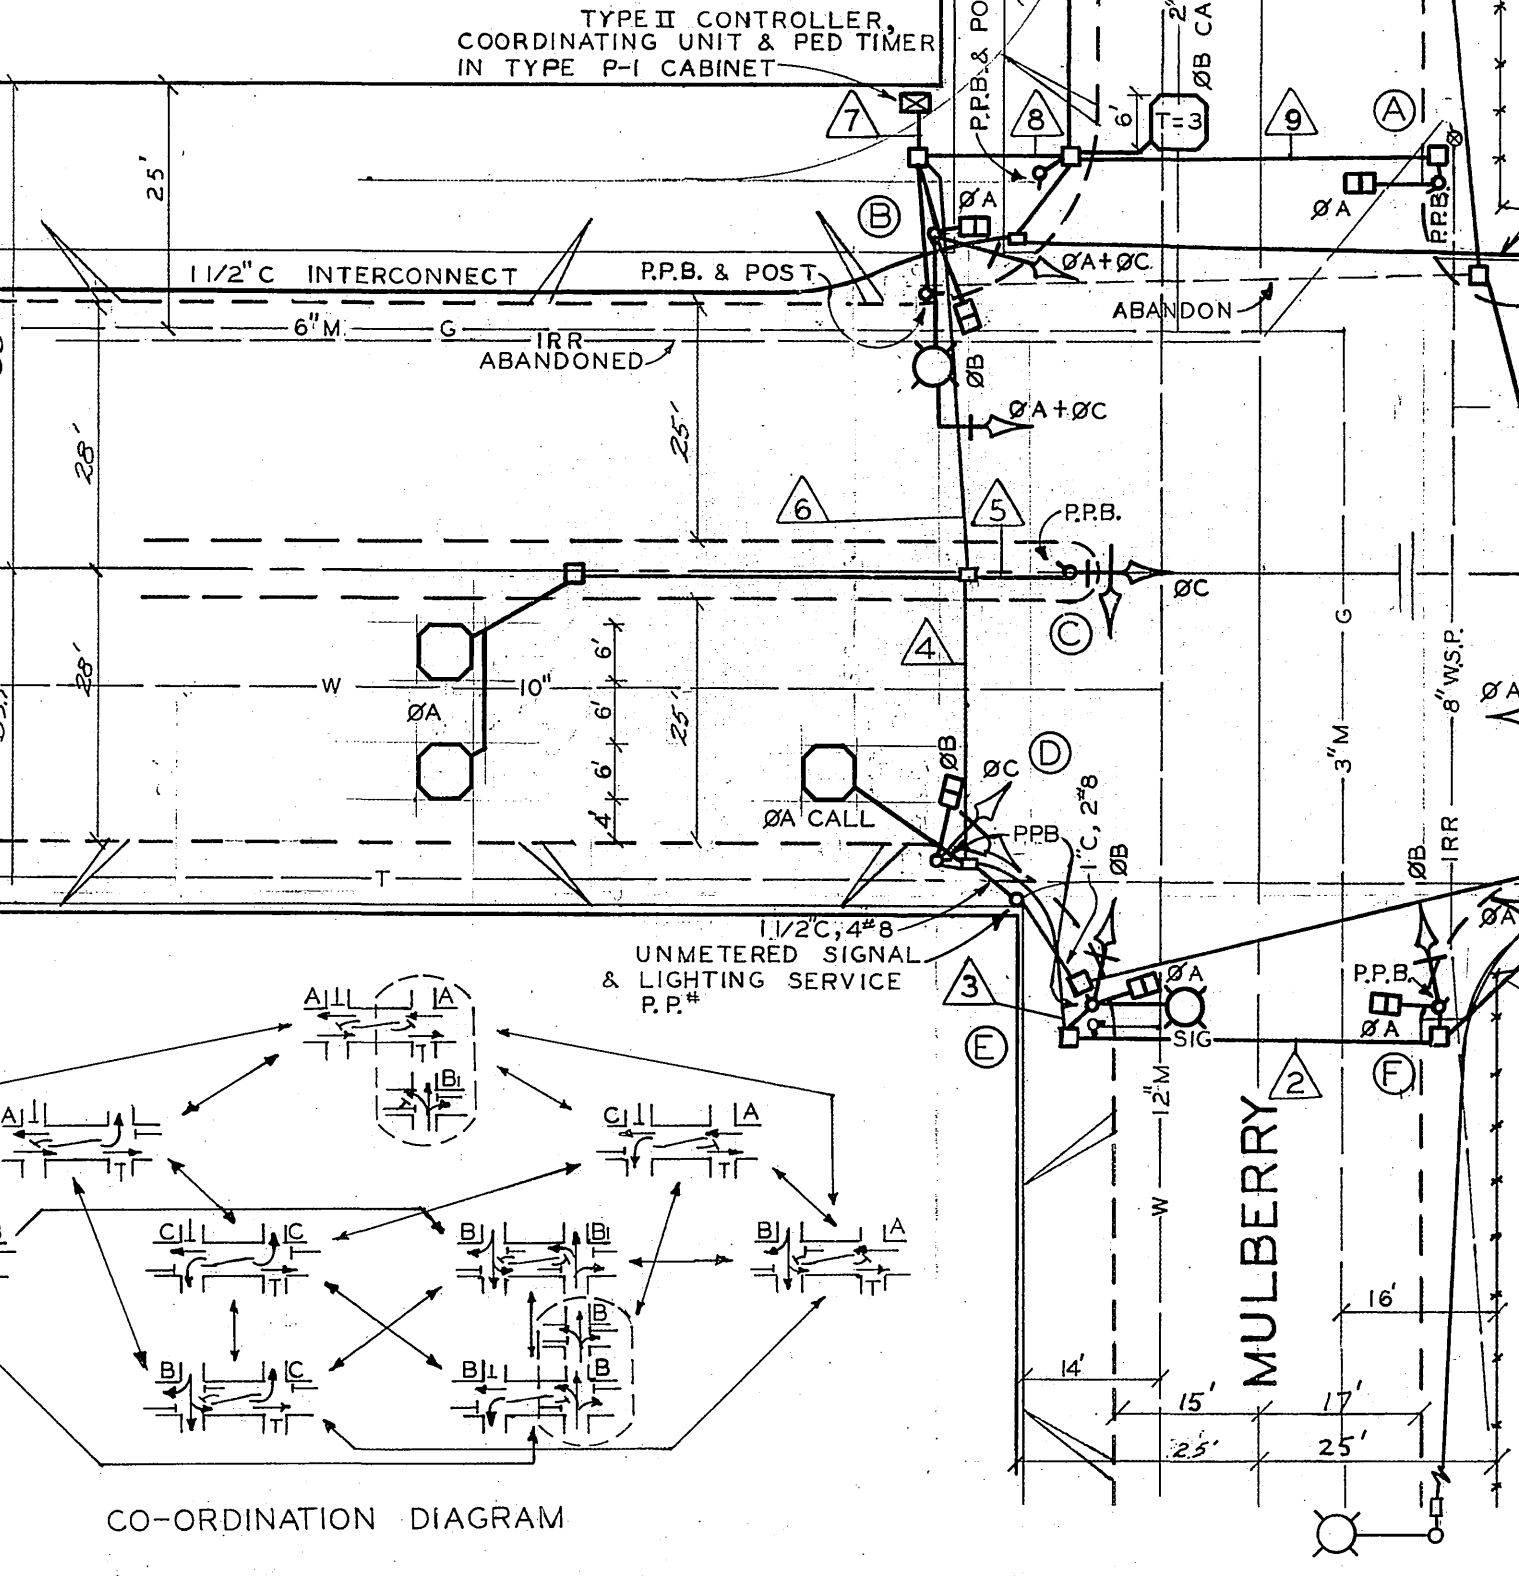

CO-ORDINATION DIAGRAM


LOCATION	STANDARD	LUMINAIRE	SIGNALS			WALK-DON'T WALK	
			TYPE	MTG.	LENS SIZE	TYPE	MTG.
(A)	I-A		I-W3C	B-1	3-8"	I-W2C	W-1
(B)	XVII	20,000MV	I-W3C	M2-20MA	3-12"	2-W2C	W-3
(C)	I-A		I-W3C	A-2	2-8" 1-12"		
(D)	I-A		I-W3C	A-1	2-8" 1-12"	I-W2C	W-0
(E)	XV	20,000MV	I-W3C	B-1	3-8"	I-W2C	W-0
(F)	I-A		I-W3C	A-2	3-8"	I-W2C	W-0
(G)	XVII	20,000MV	I-W3C	B-1	3-8"		
			I-W3C	M2-20MA	3-12"		

CONDUCTOR RUN	1		2		3		4		5		6		7		8													
CONDUCTORS	8	10	12	14	8	10	12	14	8	10	12	14	8	10	12	14	8	10	12	14								
Ø A																												
Ø A + Ø C																												
Ø C																												
Ø B																												
Ø B <sub>1</sub>																												
Ø B OR Ø C YELL.																												
Ø C GRN ARROW																												
Ø A PED.																												
Ø B PED.																												
SPARES																												
120V NEUTRAL																												
Ø B PPB																												
Ø A DET.																												
Ø A CALL DET.																												
Ø C DET.																												
Ø B DET.																												
Ø B <sub>1</sub> DET.																												
12V NEUTRAL																												
SIGNAL SERVICE																												
SIGN BRIDGE LTG.																												
INTERCONNECT																												
TOT. CONDUCTORS	1	6	14	1	1	6	23	2	1	12	23	2	1	7	15	2	1	6	13	3	4	11	3	2	11	1	11	
CONDUIT SIZE	2"		2"		2"		2"		2"		2"		2"		2"		1 1/2"		1 1/2"		1 1/2"		1 1/2"		1 1/2"		1 1/2"	

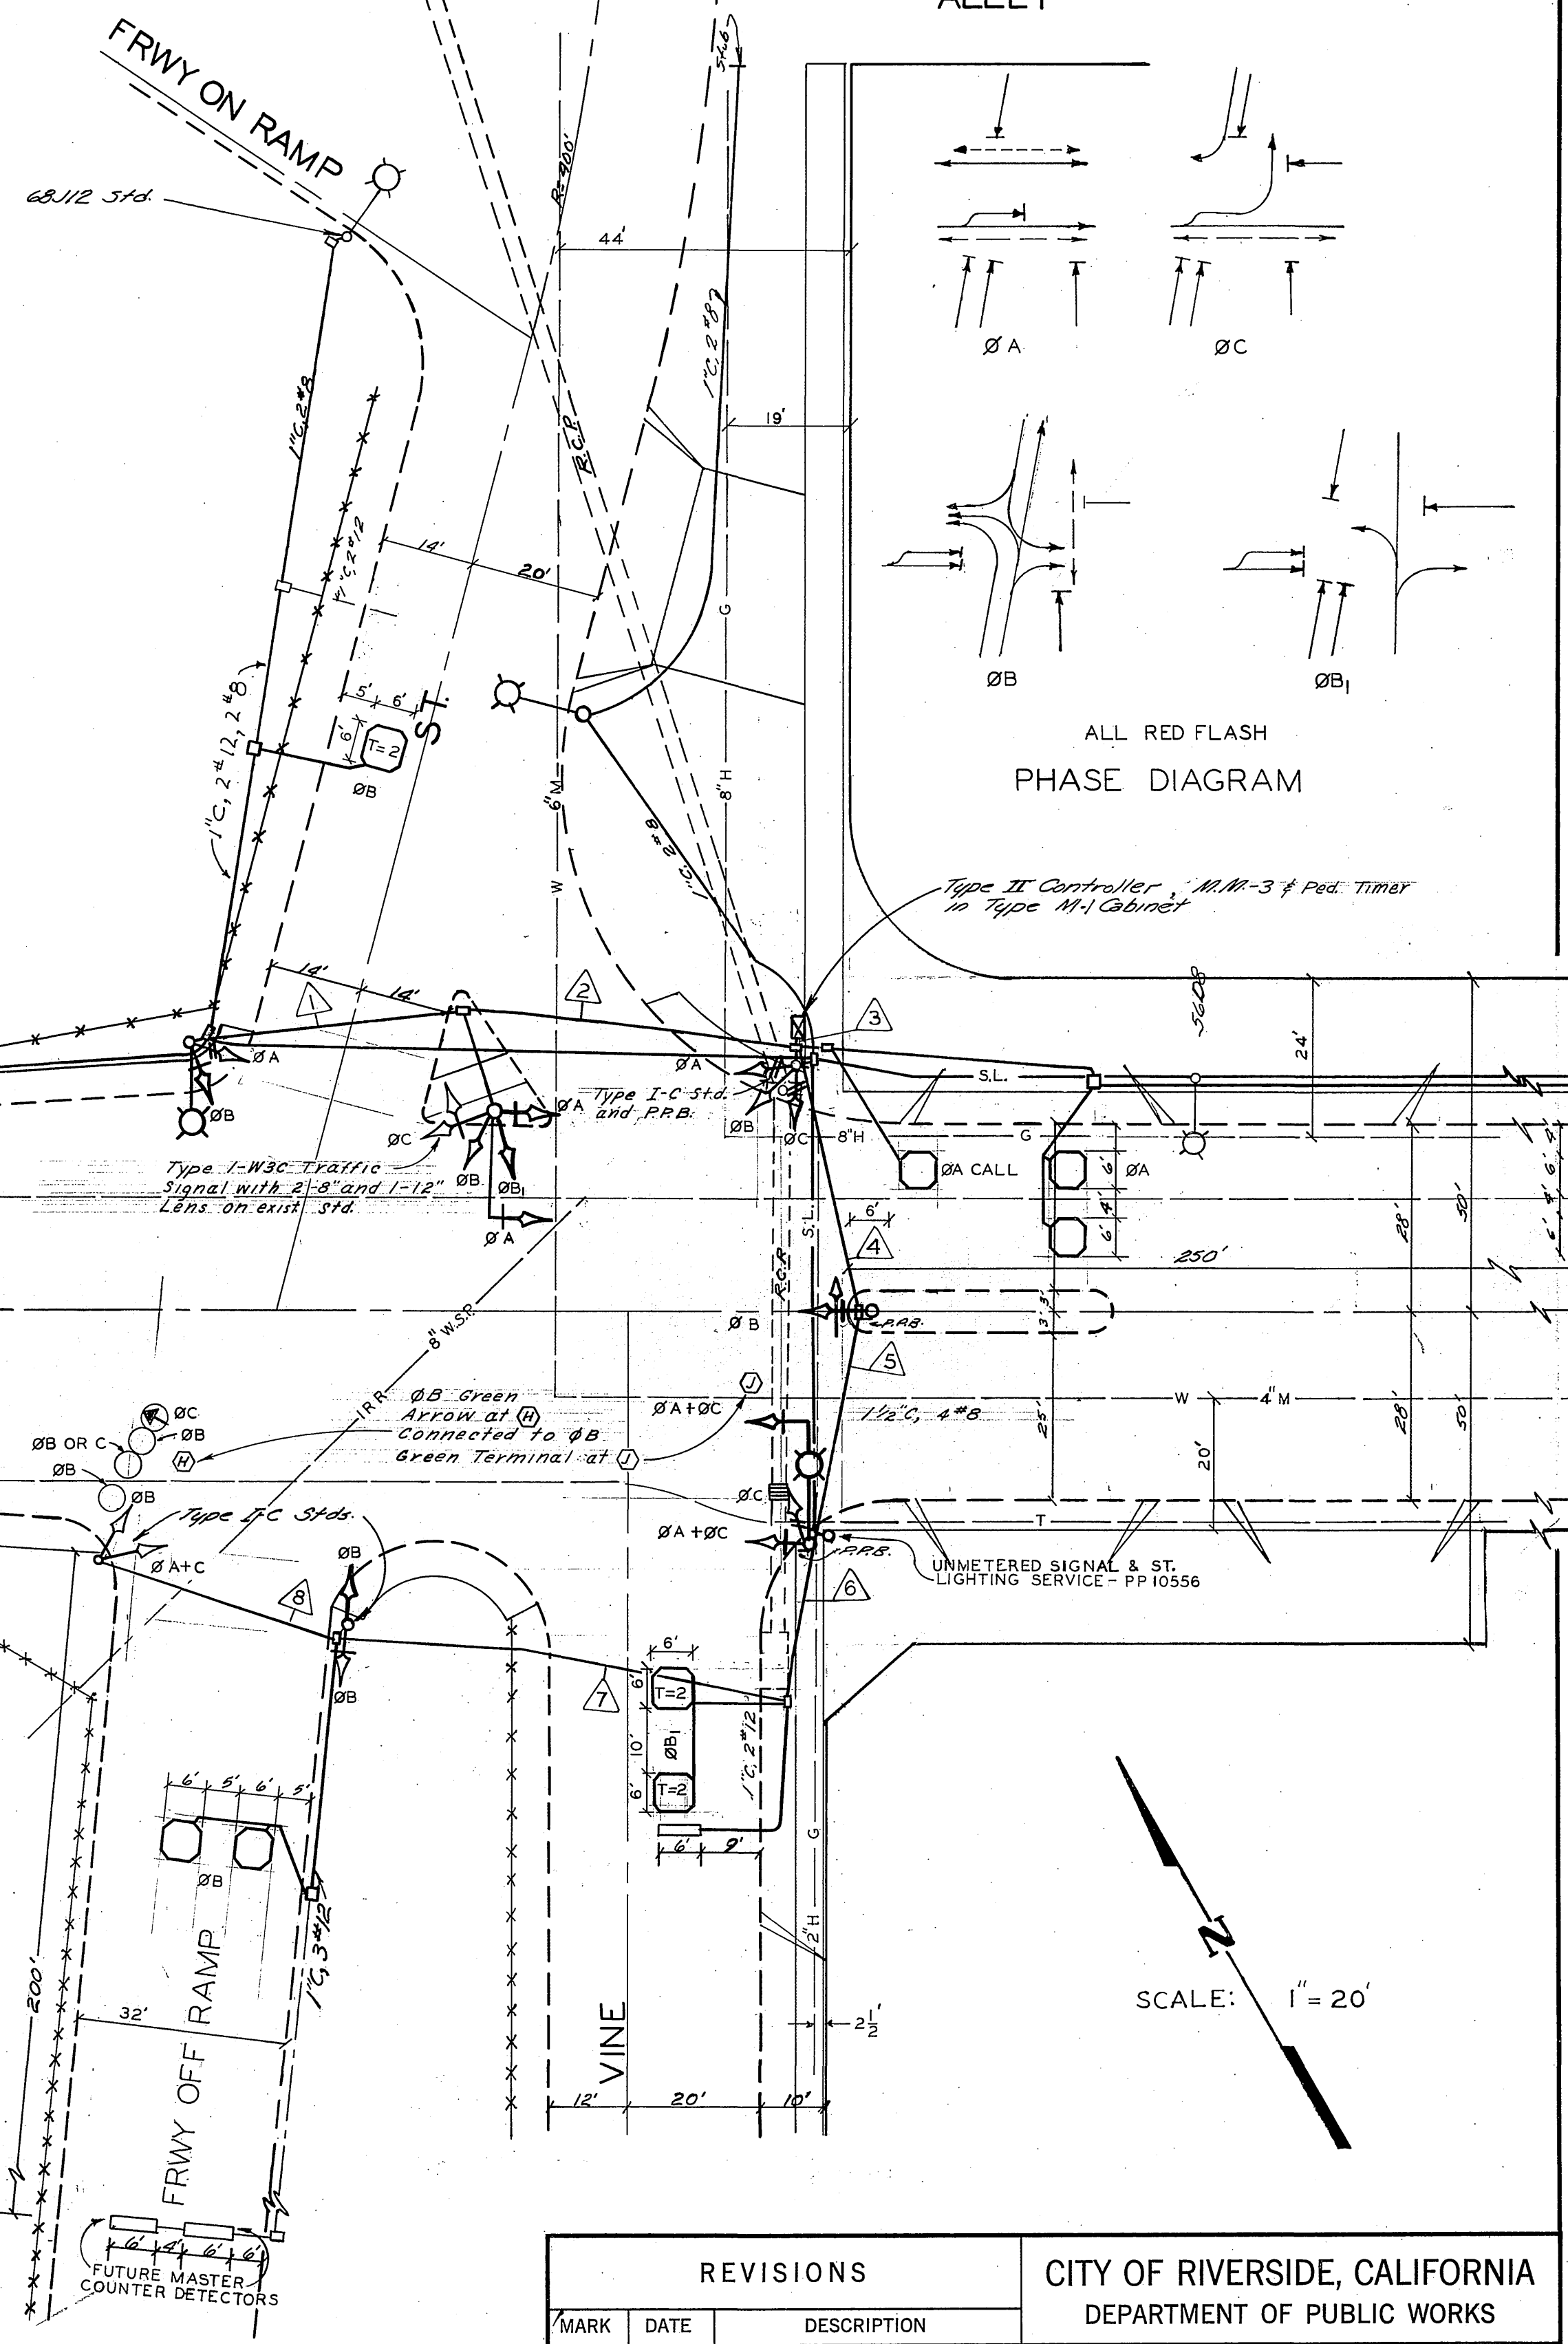


SCALE: 1" = 20'

REVISIONS			CITY OF RIVERSIDE, CALIFORNIA DEPARTMENT OF PUBLIC WORKS	
MARK	DATE	DESCRIPTION	CONTRACT NO. 66-3	
6-8-67		As Built M.W.	FOURTEENTH STREET & FREEWAY RAMPS TRAFFIC SIGNALS	
12-9-70		As Built per Contract 70-7		
6-5-72		Changed Ø's Ø A & C JMW		
DESIGNED BY	SUBMITTED BY	APPROVED BY	PROJ. NO. 7005	
DRAWN BY A.D.D. / M.G.	PARK DEPT. / TRAFFIC DIV.	DIRECTOR OF PUBLIC WORKS	X-104 A	
CHECKED BY	RECOMMENDED BY	DATE	SHEET OF	

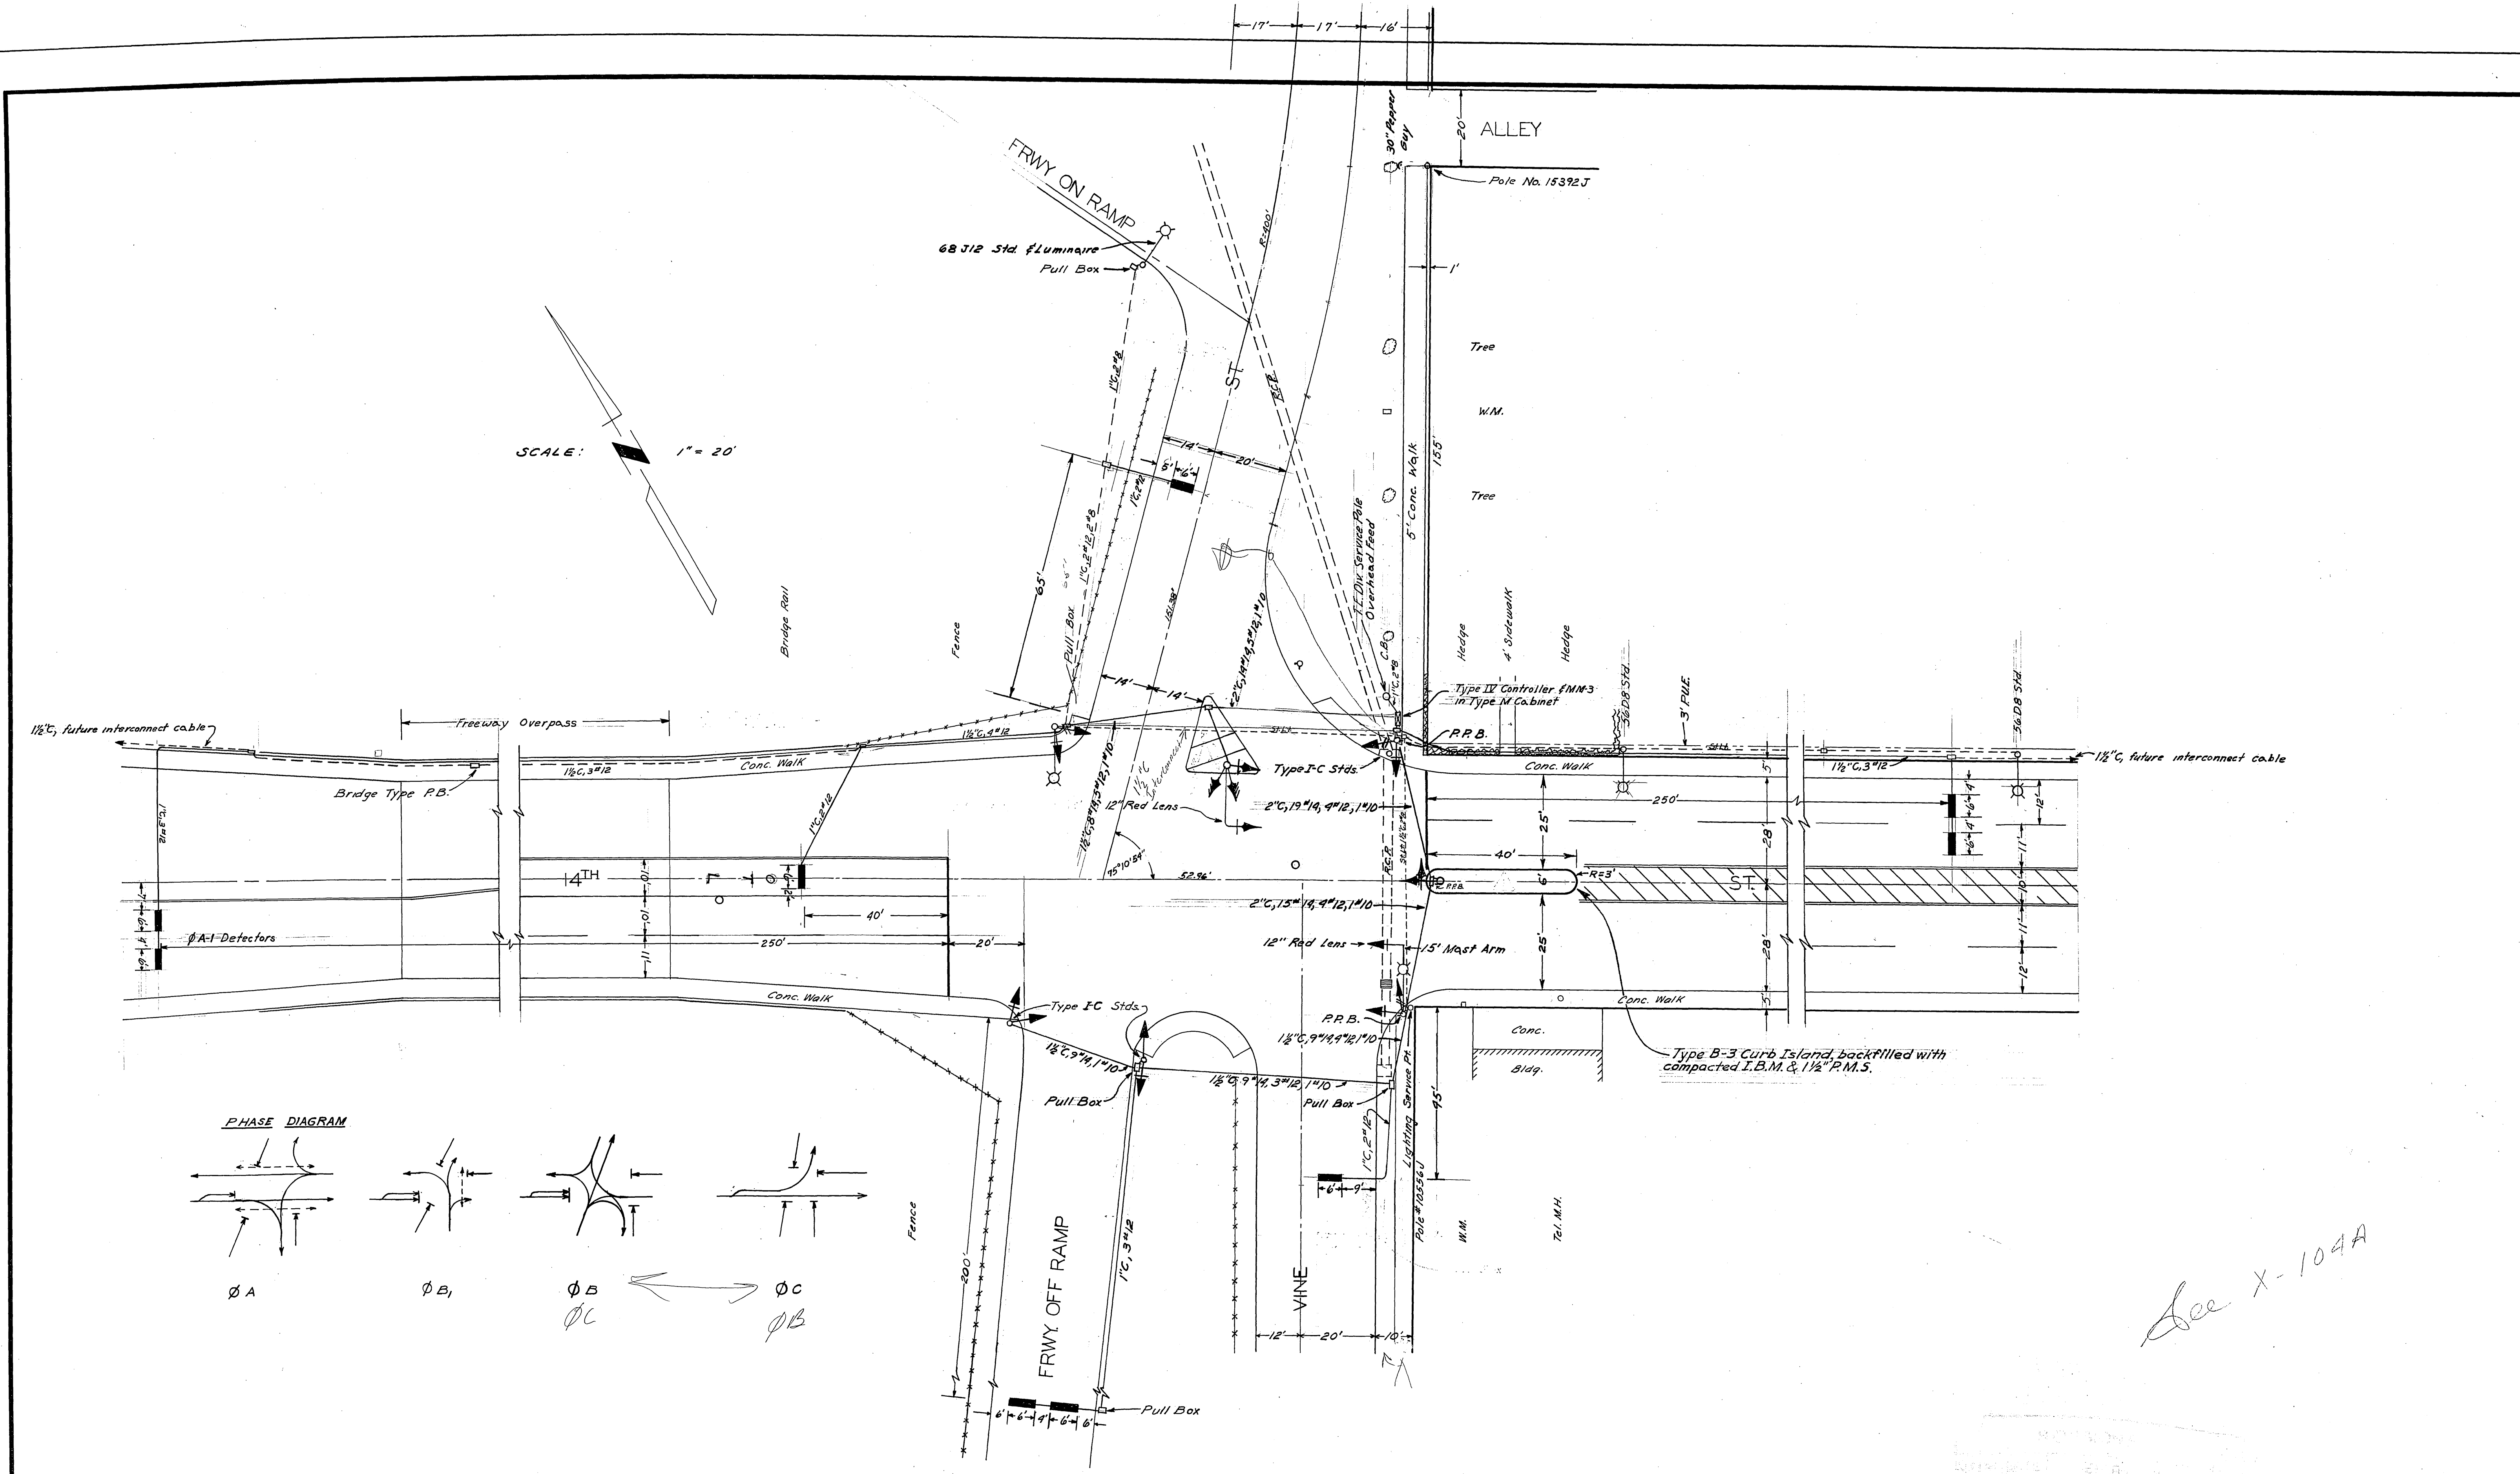

SCALE: 1" = 20'

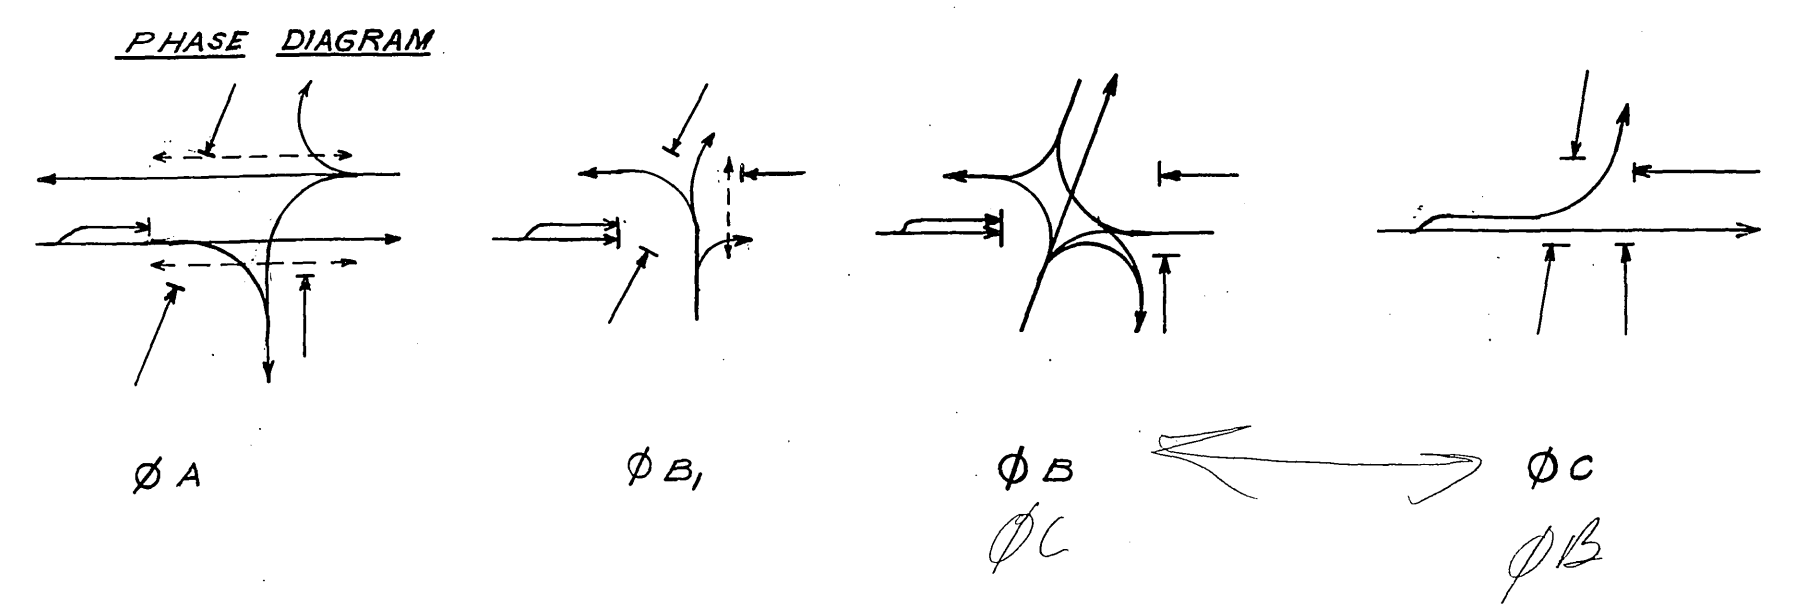

See X-104A

12-15-59 Island As Built, H. Ball  
A.D.D. 4-14-60 As Built

TRAFFIC SIGNALS  
14TH ST. - VINE ST.

A.D.D. *W.D. The*  
*M. J. Hall*  
*J. M. Atland*  
April 15, 1960 X-104