

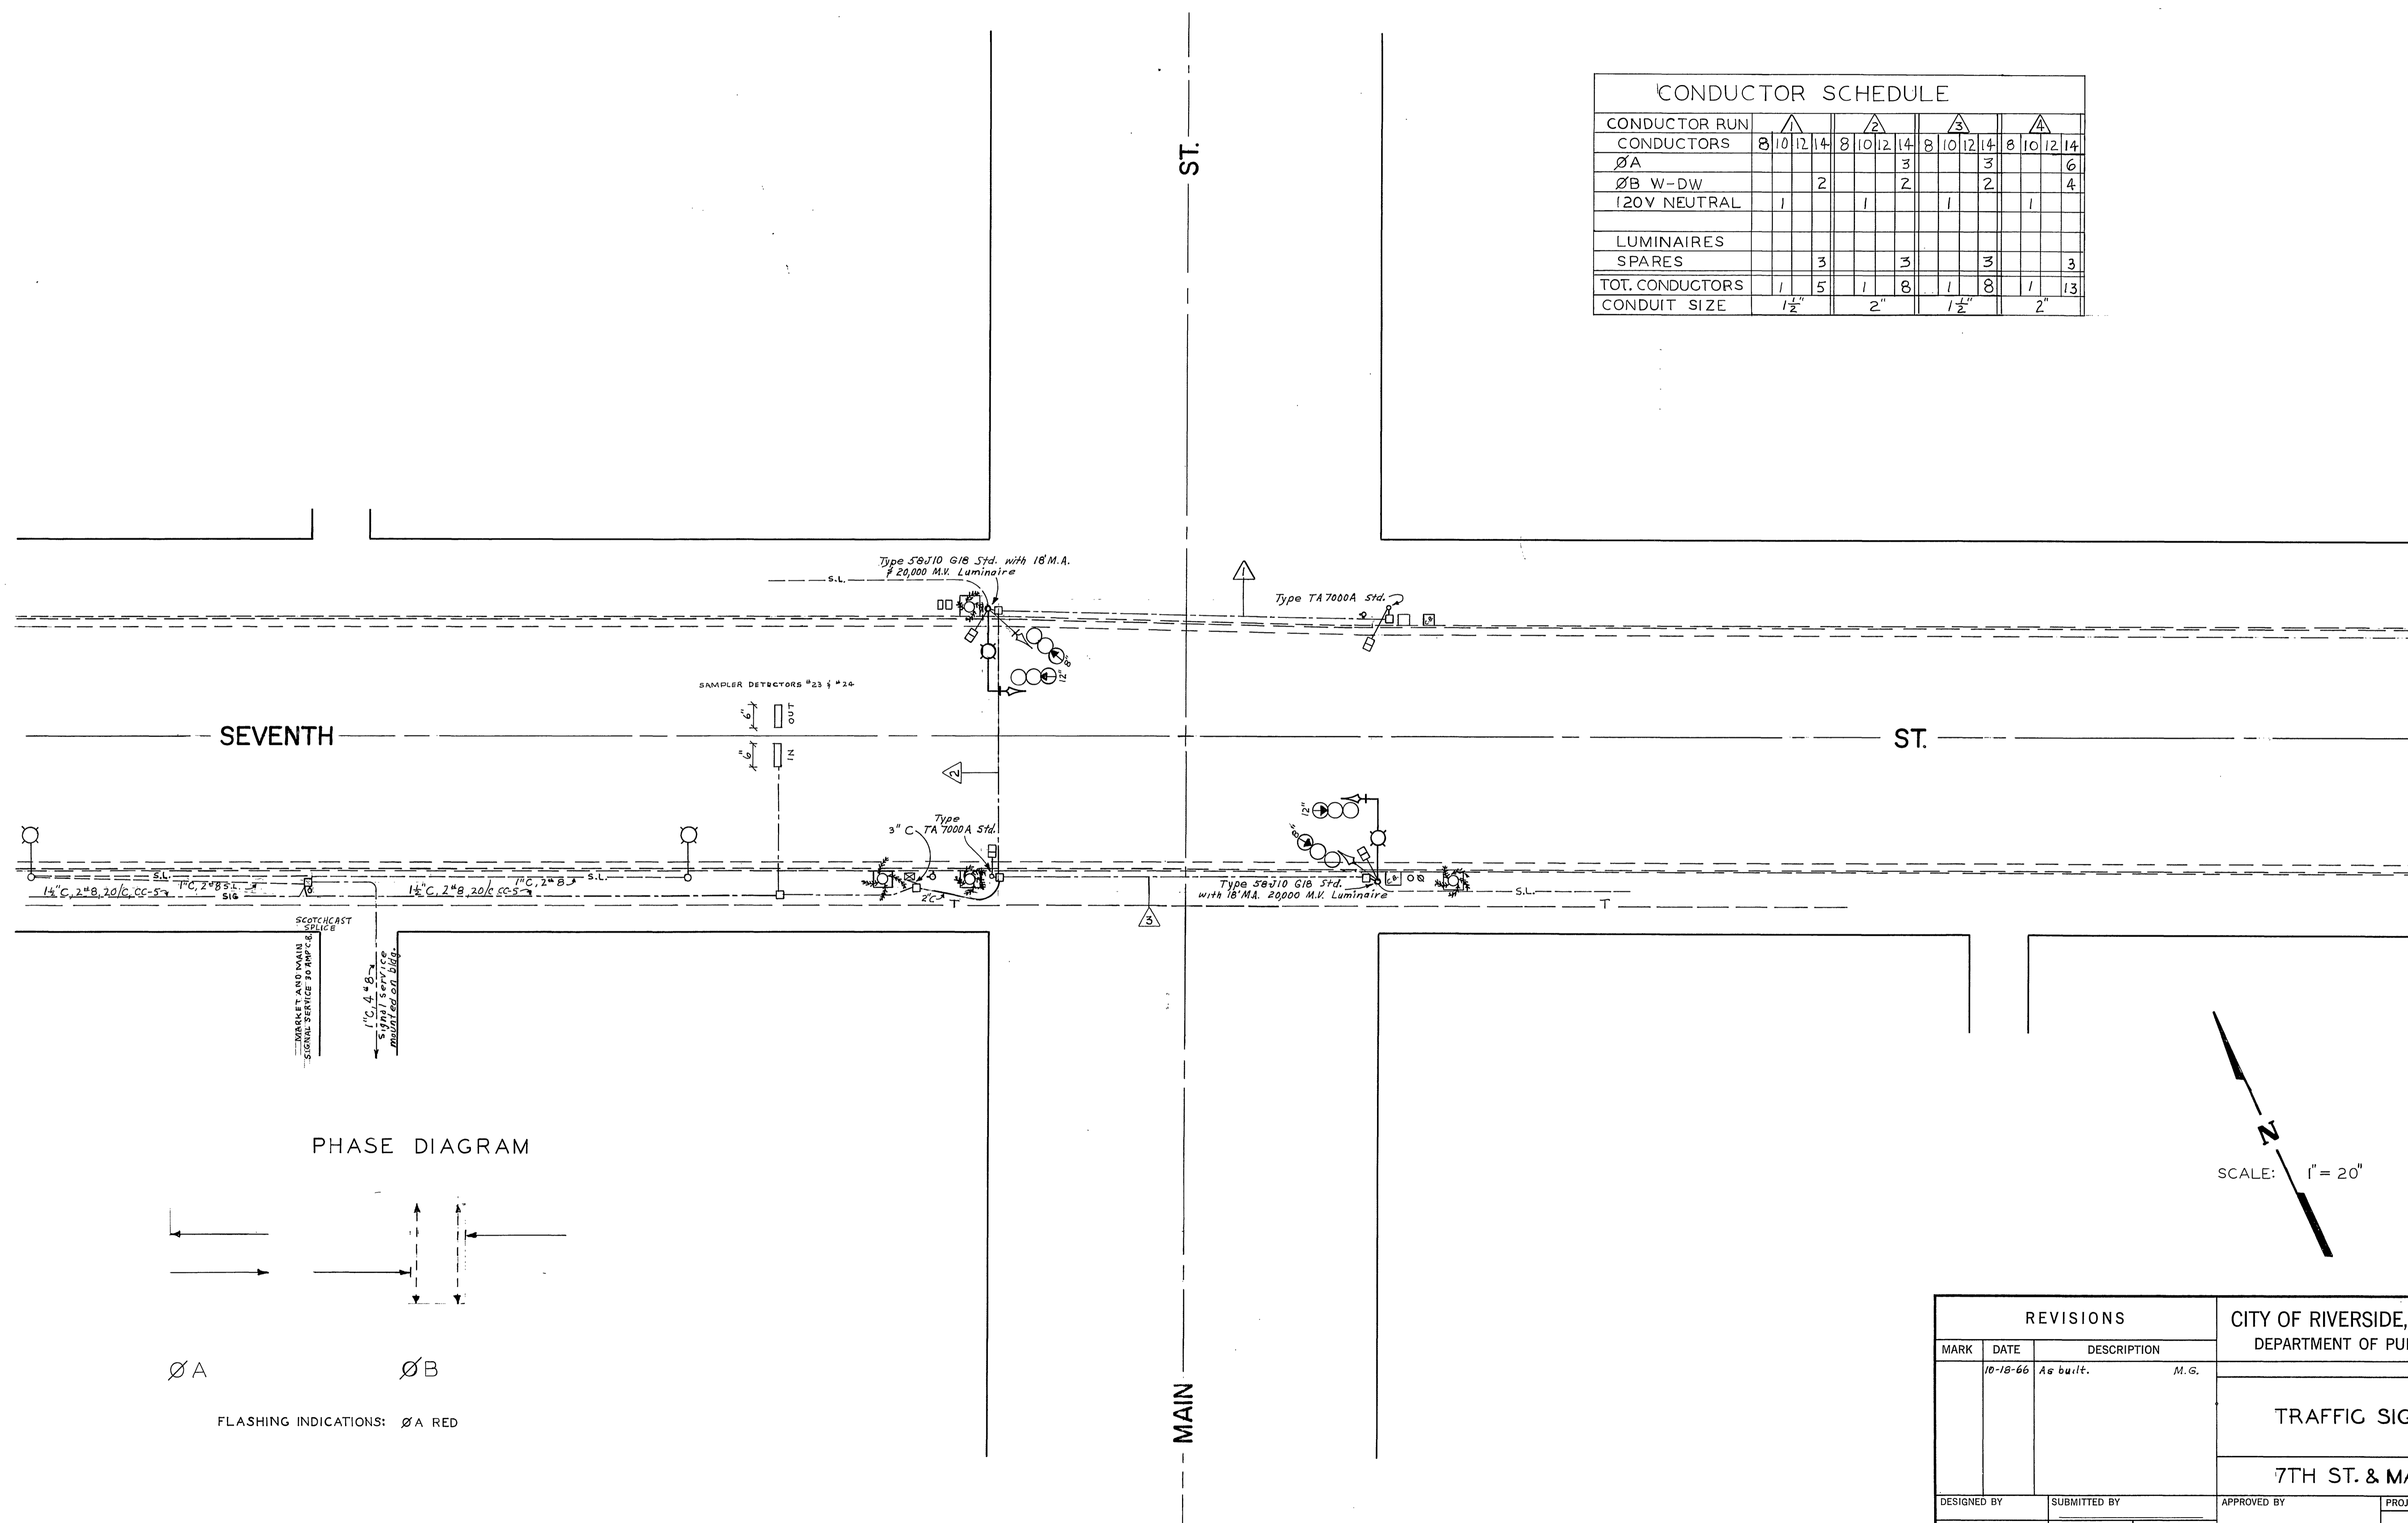





| CONDUCTOR SCHEDULE | | | | | | | | | | | | | |
|--------------------|--------|----|----|----|---|----|--------|----|---|----|----|----|---|
| CONDUCTOR RUN | 1 | | | 2 | | | 3 | | | 4 | | | |
| CONDUCTORS | 8 | 10 | 12 | 14 | 8 | 10 | 12 | 14 | 8 | 10 | 12 | 14 | |
| ØA | | | | | | | 3 | | | 3 | | | 6 |
| ØB W-DW | | | 2 | | | | 2 | | | 2 | | | 4 |
| 120V NEUTRAL | 1 | | | | 1 | | | | 1 | | | 1 | |
| LUMINAIRES | | | | | | | | | | | | | |
| SPARES | | | | 3 | | | | 3 | | | 3 | | 3 |
| TOT. CONDUCTORS | 1 | | 5 | 1 | | 8 | 1 | | 8 | | 1 | 13 | |
| CONDUIT SIZE | 1 1/2" | | | 2" | | | 1 1/2" | | | 2" | | | |

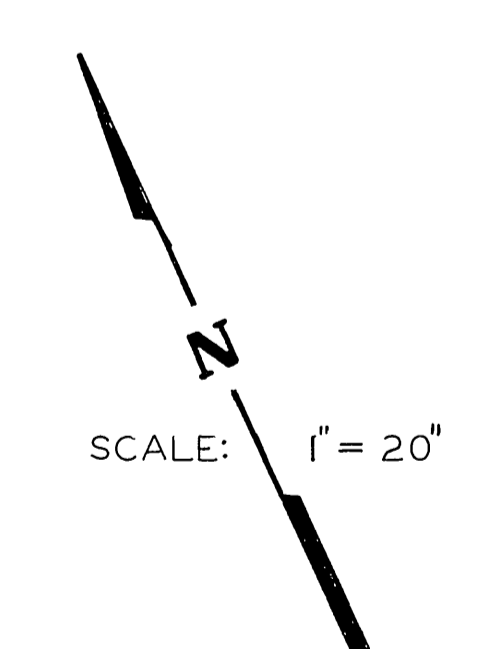

PHASE DIAGRAM

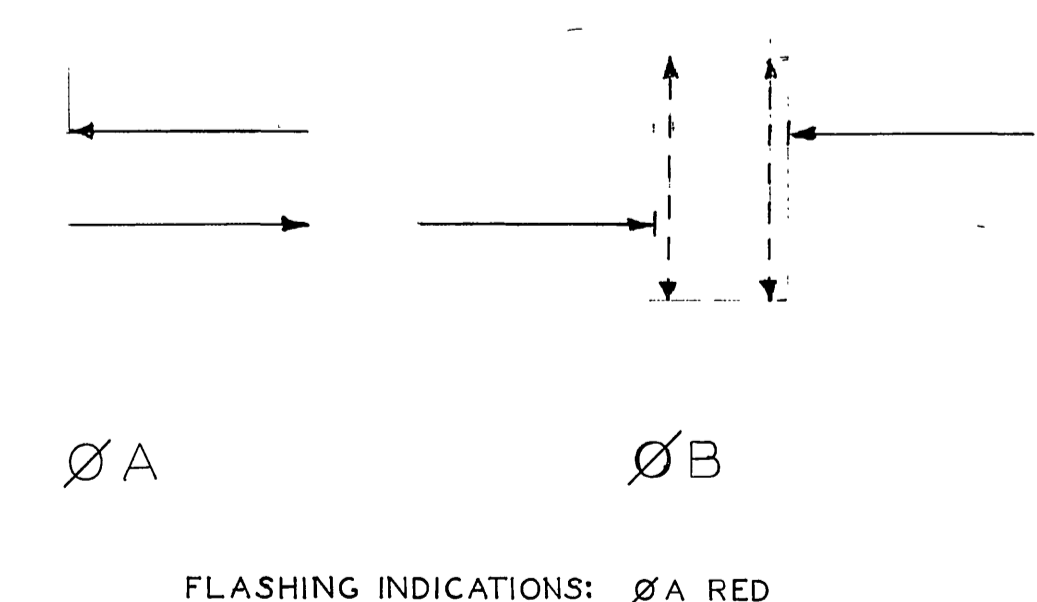

| REVISIONS | | | CITY OF RIVERSIDE, CALIFORNIA DEPARTMENT OF PUBLIC WORKS | |
|-------------|-------------------------|----------------|-------------------------------------------------------------|--|
| MARK | DATE | DESCRIPTION | | |
| | 10-18-66 | As built. M.G. | | |
| | | | TRAFFIC SIGNALS | |
| | | | 7TH ST. & MAIN ST. | |
| DESIGNED BY | SUBMITTED BY | APPROVED BY | PROJ. NO. | |
| DRAWN BY | PARK DEPT. | TRAFFIC DIV. | X-123 | |
| CHECKED BY | RECOMMENDED BY | DATE | SHEET OF | |
| | ASSISTANT CITY ENGINEER | | | |

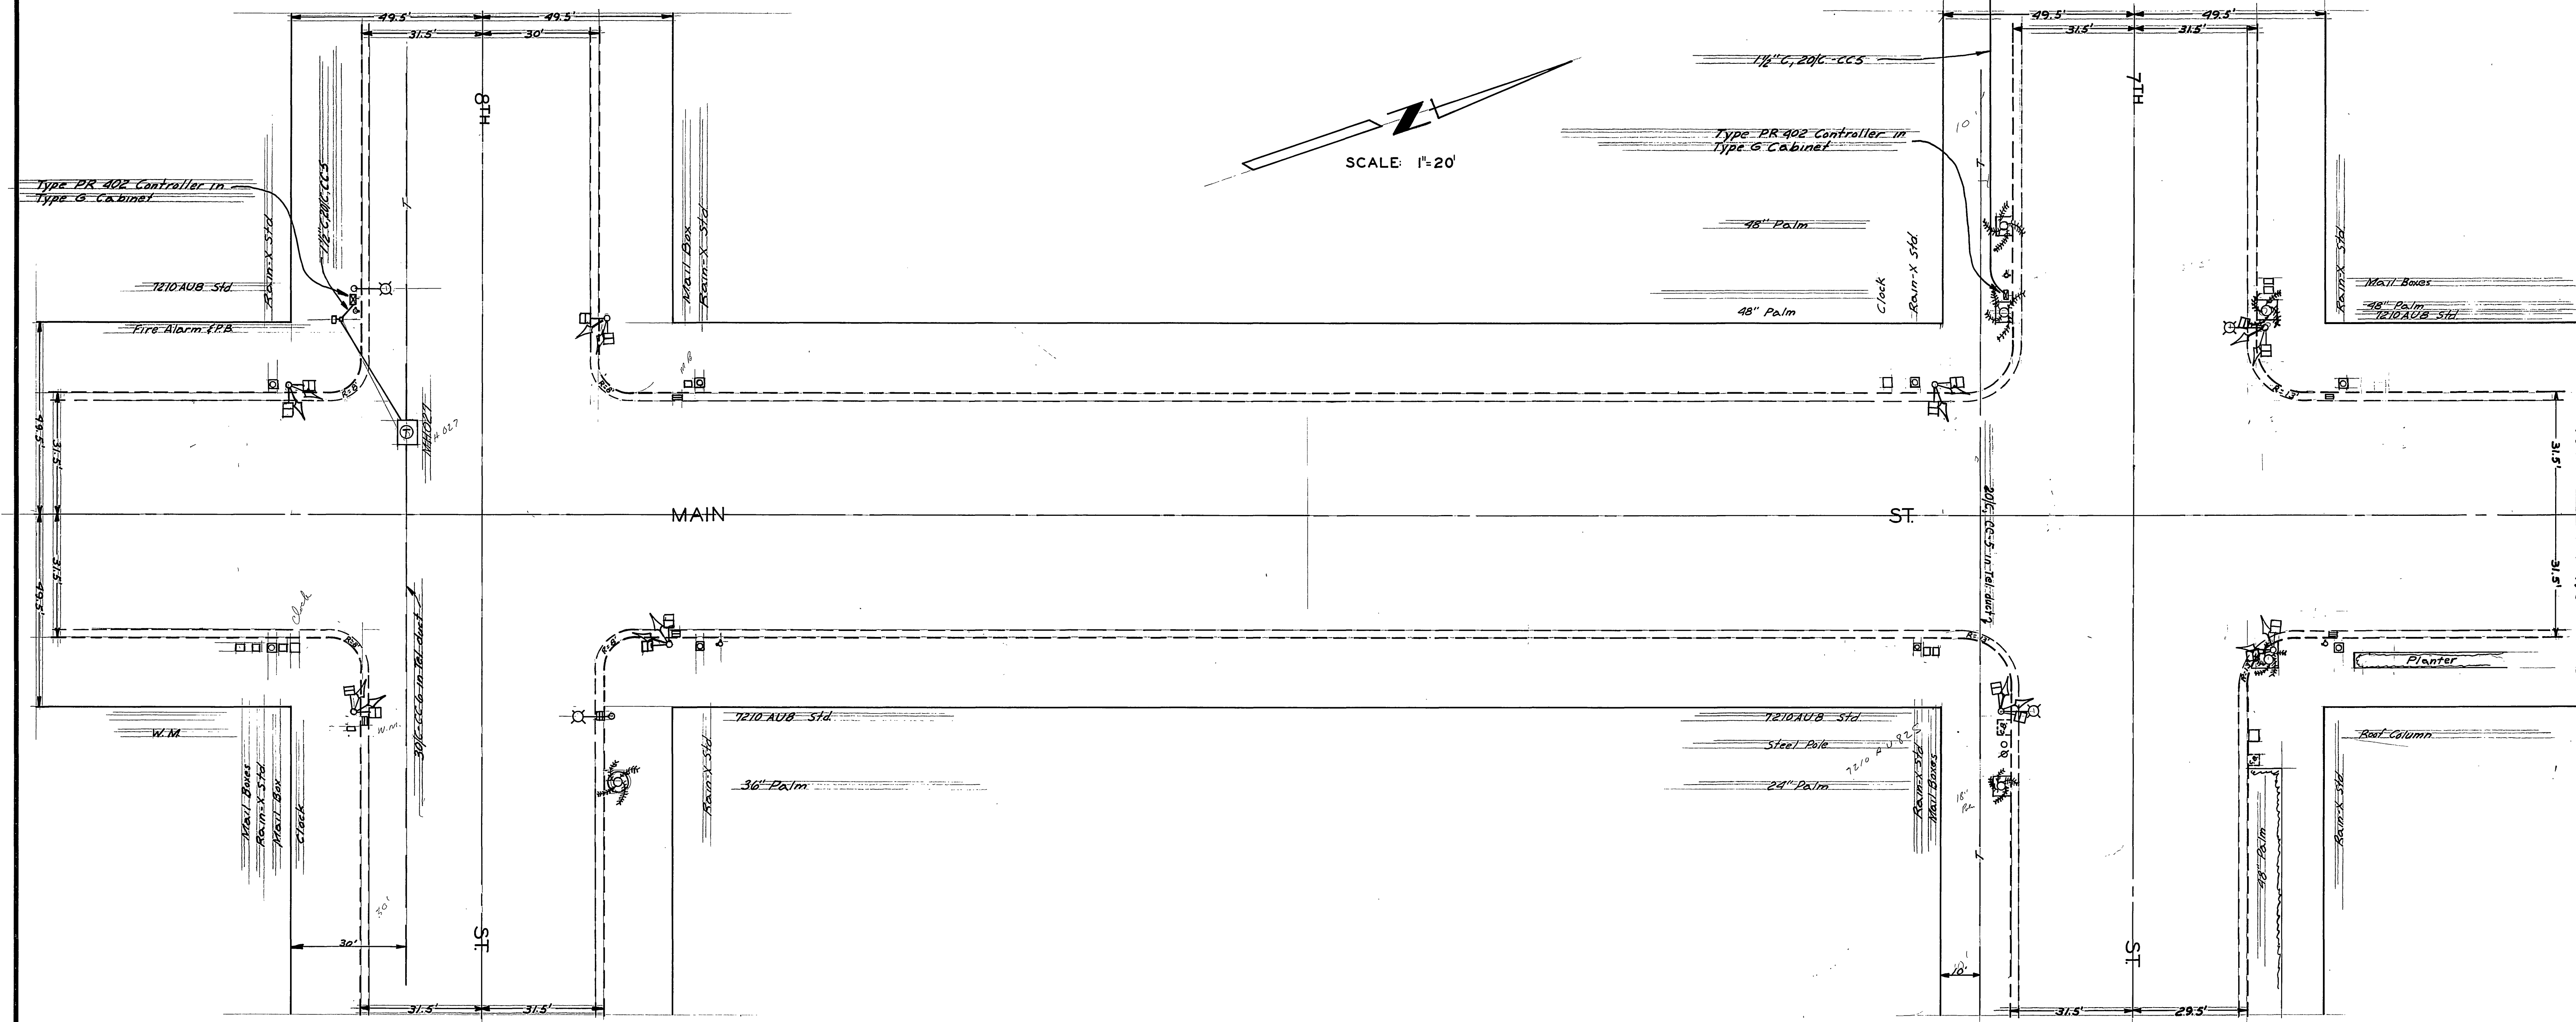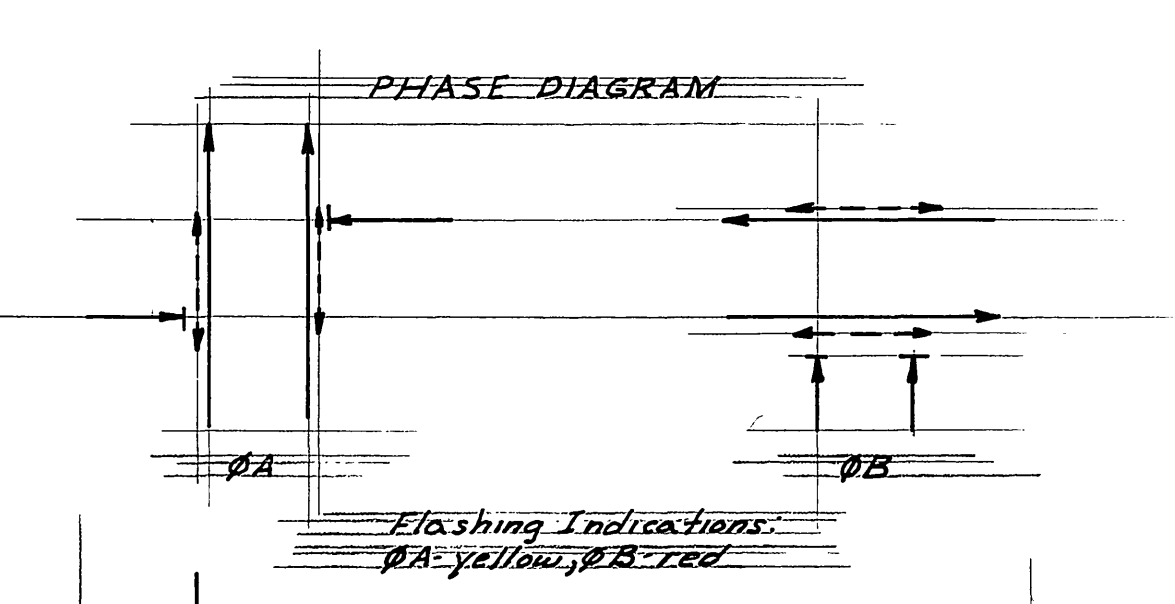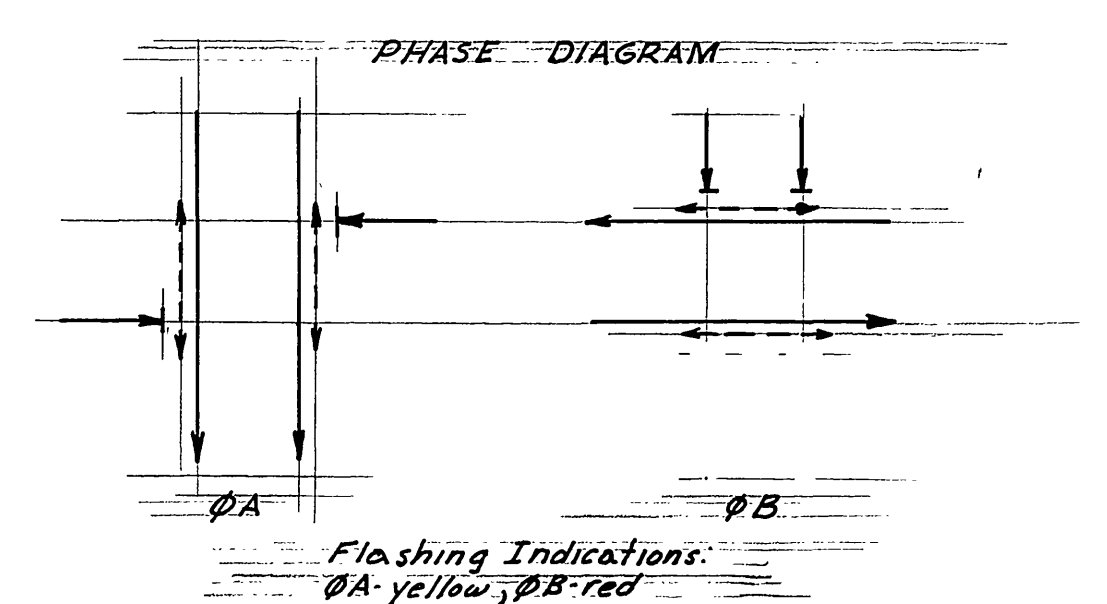

SCALE: 1"=20'

X-122

X-123

| REVISIONS | DATE | DESCRIPTION | BY | CHECKED | APPROVED |
|-----------|------|-------------|----|---------|----------|
| | | | | | |
| | | | | | |
| | | | | | |

1/19/62 Interconnect As Built 100

TRAFFIC SIGNALS
MAIN STREET
7TH & 8TH STREETS

| | | |
|-----|-----|-----|
| ADD | ADD | ADD |
| ADD | ADD | ADD |
| ADD | ADD | ADD |

X-123A