


DETAIL "B"

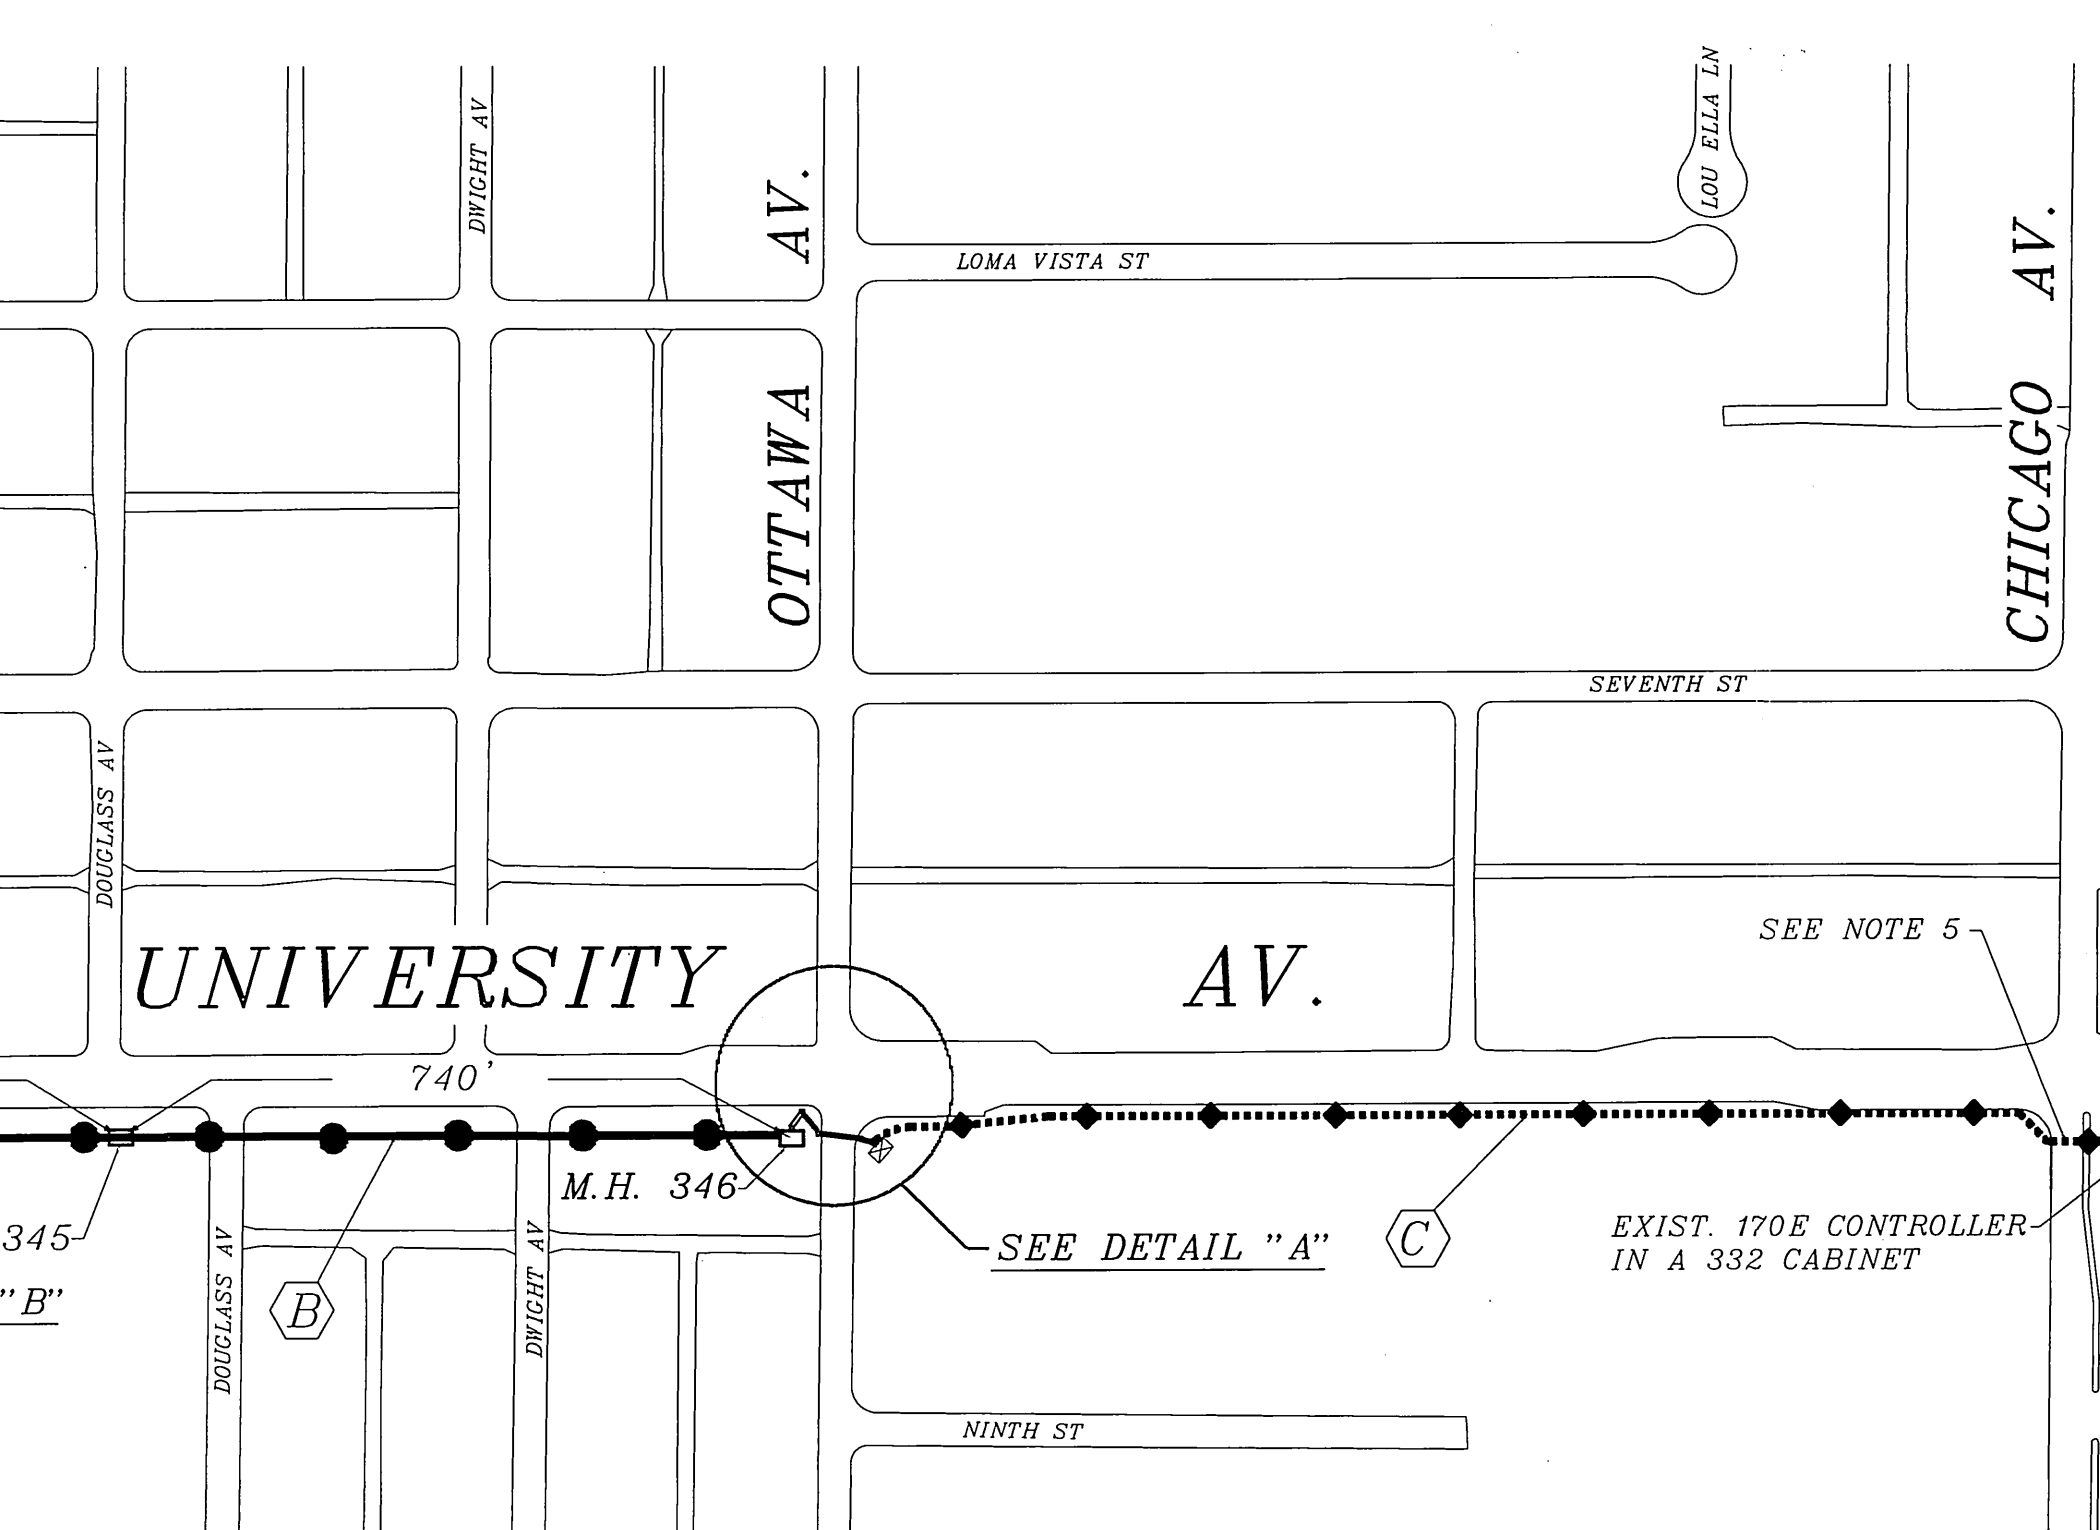

DETAIL "A"


CONSTRUCTION NOTES

- A** (—) - INSTALL 6 PAIR #19 INTERCONNECT CABLE IN EXISTING CONDUIT.
- B** (—●—) - RC EXISTING CABLES AND INSTALL 6 PAIR #19 INTERCONNECT CABLE IN EXISTING TELEPHONE DUCT.
- C** (—●—●—) - EXISTING 6 PAIR #19 INTERCONNECT CABLE IN EXISTING CONDUIT/DUCT.
- D** (==) - INSTALL 1 1/2" CONDUIT, 6 PAIR #19 INTERCONNECT CABLE AND PULL BOXES.
- E** (—●—) - SPLICE 6 PAIR #19 INTERCONNECT CABLE TO EXISTING 6 PAIR #19 INTERCONNECT CABLE.
- F** (—/—/—) - REMOVE EXISTING INTERCONNECT CABLE AND INSTALL 6 PAIR #19 INTERCONNECT CABLE IN EXISTING CONDUIT.
- 1** - REMOVE AND SALVAGE EXISTING TYPE 90 CONTROLLER ASSEMBLY. REMOVE FOUNDATION. INSTALL MODEL 170E/332 CABINET ASSEMBLY ON NEW FOUNDATION.
- 2** - WITHDRAW EXISTING CABLES AND CONDUCTORS FROM EXISTING CONDUIT RUN, AND INSTALL EXISTING CABLES AND CONDUCTORS IN NEW CONDUIT RUN (2-3" CONDUIT), FROM #6(E) PULL BOX TO CONTROLLER CABINET.
- 3** - INSTALL NEW 2" CONDUIT FROM PULL BOX TO TELEPHONE MANHOLE #344, AND INSTALL 6PR #19 INTERCONNECT CABLE.
- 4** - REPLACE EXISTING #6 PULL BOX WITH NEW #6(E) PULL BOX.

NOTES:

1. THE MAP ON THIS SHEET IS GENERALLY DIAGRAMMATIC AND SHOULD BE USED ACCORDINGLY. DISTANCES SHOWN ARE APPROXIMATE.
2. SEE C/R PLAN X-126A FOR INFORMATION ON EXISTING CONDUIT RUN.
3. SEE C/R PLAN X-441A FOR INFORMATION ON EXISTING CONDUIT RUN.
4. SEE C/R PLAN X-129A FOR INFORMATION ON EXISTING CONDUIT RUN.
5. SEE C/R PLAN X-132 FOR INFORMATION ON EXISTING CONDUIT RUN.
6. SEE C/R PLAN X-130 FOR INFORMATION ON EXISTING CONDUIT RUN.

CONTRACT TE-98-4
FEDERAL AID PROJECT NO. CMLN-5058(023)
CONTRACTOR'S LICENSE REQUIREMENTS "A" OR "C-10"

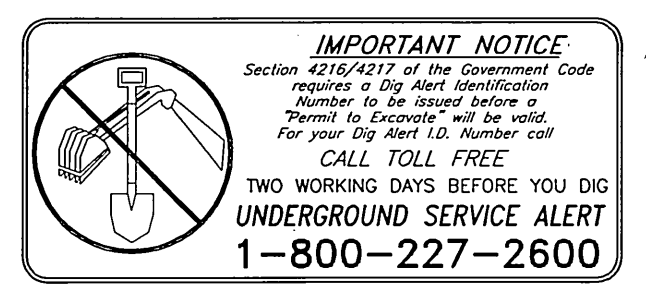

ENGINEER IN RESPONSIBLE CHARGE
Thomas John Boyd
 THOMAS JOHN BOYD
 R.C.E. No. 36170
 DATE 9/21/00

MARK	REVISIONS	APPR	DATE

DESIGNED BY: R.C.C. DRAWN BY: R.C.C. CHECKED BY: *R.C.C.*

CITY OF RIVERSIDE, CALIFORNIA DEPARTMENT OF PUBLIC WORKS			
APPROVED BY	BY	DATE	APPROVED BY
PRINCIPAL ENGINEER	<i>Richard McLaughlin</i>	8/18/00	<i>Richard McLaughlin</i>
P.W. INSPECTION		8/18/00	DIRECTOR OF PUBLIC WORKS
TRAFFIC DIVISION		8/18/00	
CHIEF P.W. ENGR		8/18/00	
PUBLIC UTILITIES			


DATE 9-21-2000

TRAFFIC SIGNAL SYSTEM INTERCONNECT
UNIVERSITY AVENUE
PARK AV. TO
OTTAWA AV.
 SCALE: 1" = 200'

ACCT. NO. 9705532711-44030300
X-130B
 SHEET 7 OF 7
 FILE NAME: X130B-2.DWG

FRANKLIN AVE.

PHASE DIAGRAM

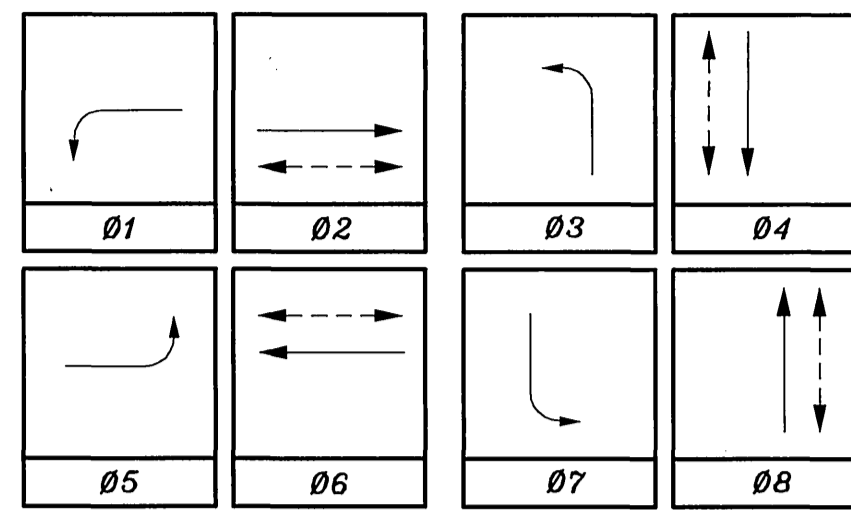

FLASHING OPERATION SHALL BE ALL RED.

PP-9121J
EXISTING SERVICE; INSTALL NEW BREAKER AND ENCLOSURE FOR 120V SIGNAL, 120V SIGN, AND 240V ST. LT. SERVICE PER CITY OF RIVERSIDE STD. DWG. NO. 612.

PP-9121J

RISER DETAIL

INSTALL 2#6, 2#8 & 2#12 IN EX. 2" C.


EXTEND DBL YELLOW STRIPE 50'

CONDUCTOR TABLE

CONTROL FUNCTION	CONDUCTORS	CONDUCTOR RUNS							
		1	2	3	4	5	6	7	8
VEHICLE & PEDESTRIAN HEADS, PEDESTRIAN PUSH BUTTONS, SPARES & COMMONS	12 WIRE IMSA	1	2	3	4	5	6	7	8
	3 WIRE IMSA	1	2	3	4	5	6	7	8
DETECTOR CABLE	#16/2	-	-	-	-	-	-	-	-
PHASE 1		-	-	-	-	1	1	-	-
PHASE 2		2	2	2	2	2	2	-	-
PHASE 3		-	-	1	1	1	1	-	-
PHASE 4		-	-	-	-	-	-	1	1
PHASE 5		1	1	1	1	1	1	-	-
PHASE 6		-	-	-	-	3	3	-	-
PHASE 7		-	-	-	-	-	-	1	1
PHASE 8		-	-	1	1	1	1	-	-
INTERCONNECT CABLE	#19	1	1	1	1	1	1	-	-
I.I.S.N.S.	#12	-	2	2	2	2	-	2	2
LUMINAIRES	#8	-	2	2	2	-	-	2	2
SIGNAL SERVICE	#8	-	-	-	-	-	-	2	-
EMER. PRE-EMPT.	#20	-	-	-	-	-	-	2	1
CONDUIT SIZE		2"	3"	3"	3.5"	3.5"	2-3"	3"	2"

NOTE:

SIGNAL SYSTEM SHALL HAVE NEW CABLES AND CONDUCTORS; SEE CONTRACT SPECIAL PROVISIONS FOR ADDITIONAL INFORMATION ON I.M.S.A. CABLE.

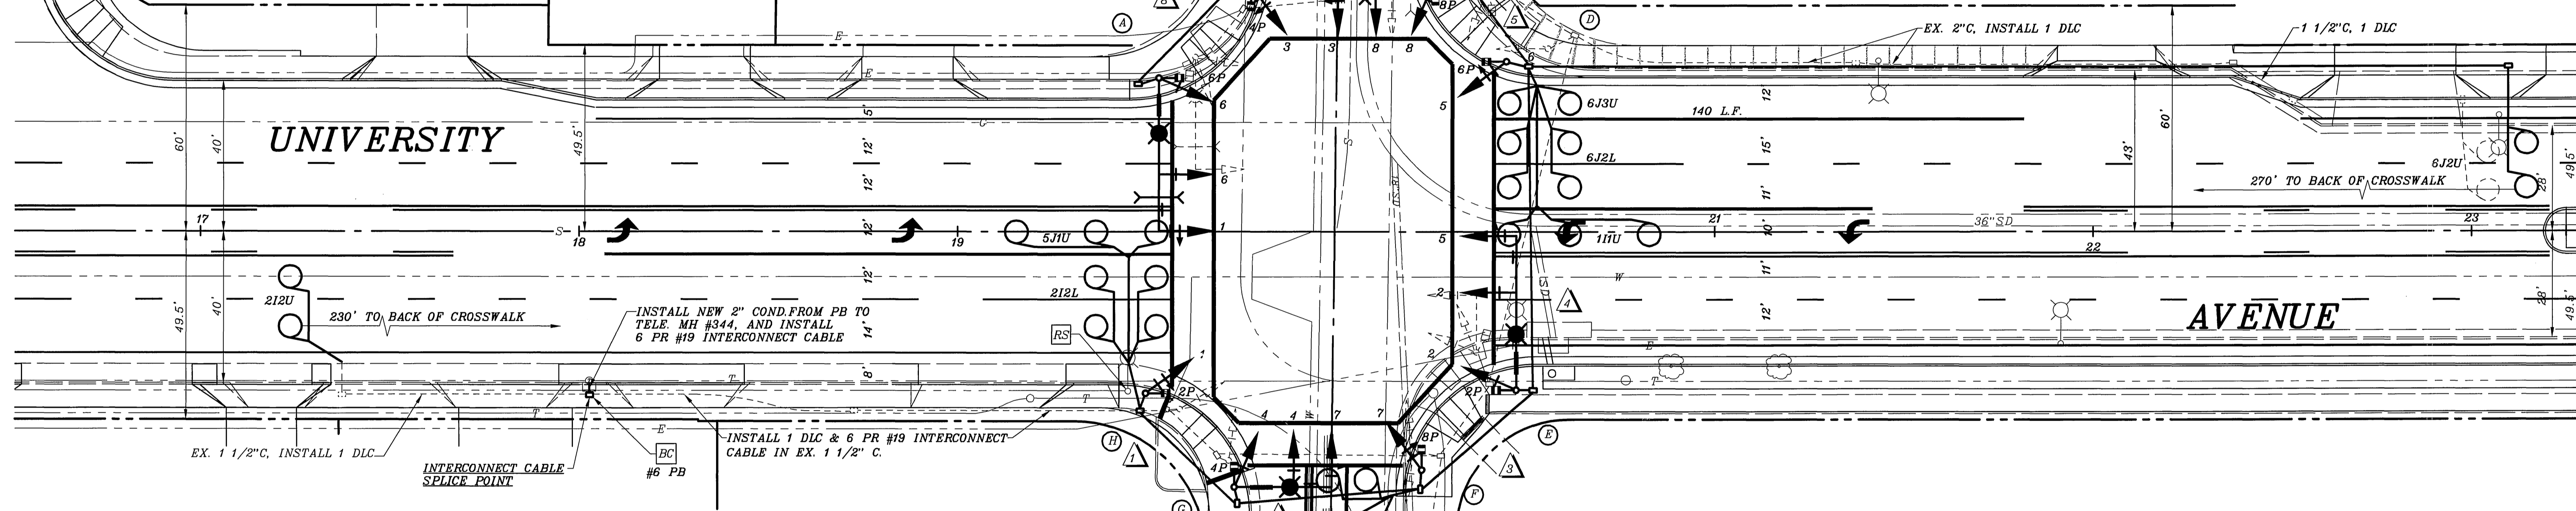

EQUIPMENT SCHEDULE

NO.	SIGNAL STANDARD TYPE	SIGNAL STANDARD HCHT.	LUMINAIRE M.A.	LUMINAIRE H.P.S.V.	I.I.S.N.S. LEGEND	SIGNAL MOUNTINGS VEHICLE PEDESTRIAN AUDIBLE	PPB PHASE	REMARKS
(A)	26-4-129	30'	40'	12'	250W KANSAS	2-MAS SV-1-T	SP-1-T ((IPI))	4
(B)	1A	10'				TV-1-T	SP-1-T ((C))	6
(C)	19-4-129	30'	25'	12'	250W UNIVERSITY	2-MAS SV-1-T	SP-1-T ((C))	6
(D)	1A	10'				TV-1-T	SP-1-T ((IPI))	8
(E)	26-4-129	30'	40'	12'	250W KANSAS	2-MAS SV-1-T	SP-1-T ((IPI))	8
(F)	1A	10'				TV-1-T	SP-1-T ((C))	2
(G)	19-4-129	30'	25'	12'	250W UNIVERSITY	MAS SV-1-T	SP-1-T ((C))	2
(H)	1A	10'				TV-1-T	SP-1-T ((IPI))	4

NOTES:


- REMOVE AND SALVAGE ALL EXISTING POLES AND EQUIPMENT.
- ALL VEHICULAR HEADS SHALL HAVE 12" LENSES.
- ALL LEFT TURN HEADS SHALL HAVE ALL ARROWS.
- LUMINAIRES SHALL BE HIGH PRESSURE SODIUM VAPOR.
- ((C)) OR ((IPI)) - INDICATES AUDITORY PEDESTRIAN SIGNAL TO BE INSTALLED. ((C)) INDICATES CUCKOO SOUND; ((IPI)) INDICATES PEEP-PEEP SOUND.
- PEDESTRIAN PUSH BUTTONS SHALL BE INSTALLED ON THE POLE IN THE QUADRANT NEAREST THE CROSSWALK SERVING THE PHASE.
- FOUNDATIONS NOT TO BE REUSED SHALL BE COMPLETELY REMOVED.

PAVEMENT DELINEATION


- INDICATES PAVEMENT DELINEATION TO BE INSTALLED.
- INDICATES PAVEMENT DELINEATION TO REMAIN.
- INDICATES PAVEMENT DELINEATION TO BE REMOVED.

GENERAL NOTES

- DETECTOR LOOPS SHALL BE INSTALLED IN THE PRESENCE OF THE TRAFFIC ENGINEER OR HIS REPRESENTATIVE.
- ALL PAVEMENT DELINEATION REQUIREMENTS SHALL BE COMPLETED AT LEAST ONE DAY PRIOR TO TURN ON.
- TYPICAL DETECTOR LOOP SPACING: 10' AND 15' (WHERE APPLICABLE).
- SEE PLAN R-3606 FOR STREET IMPROVEMENTS.
- SEE PLAN XL-385A FOR PAVEMENT DELINEATION.

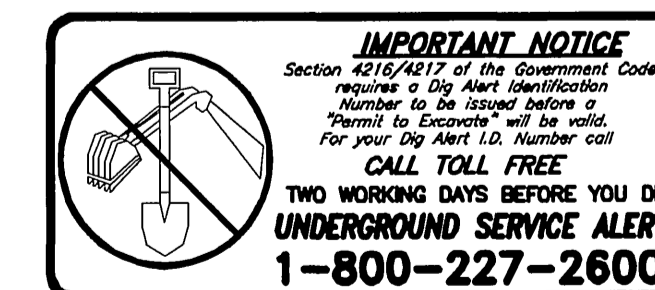

ENGINEER IN RESPONSIBLE CHARGE
THOMAS JOHN BOYD
R.C.E. No. 36170
DATE 6/13/01



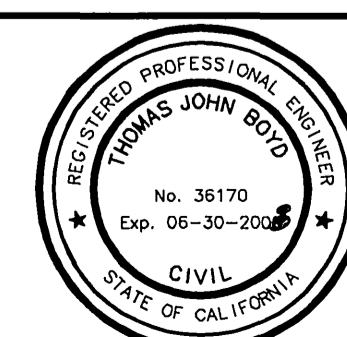


MARK	REVISIONS	APPR.	DATE

CITY OF RIVERSIDE, CALIFORNIA
DEPARTMENT OF PUBLIC WORKS
APPROVED BY: [Signature] 6/13/01
PRINCIPAL ENGINEER
P.W. INSPECTION: [Signature] 6/13/01
TRAFFIC DIVISION
CHIEF P.W. ENGR.
PUBLIC UTILITIES

TRAFFIC SIGNAL MODIFICATION
UNIVERSITY AVE.
@
KANSAS AVE.
SCALE: 1" = 20'

ACCT. NO. X-130A
SHEET 1 OF 1
FILE NAME: X130A.DWG

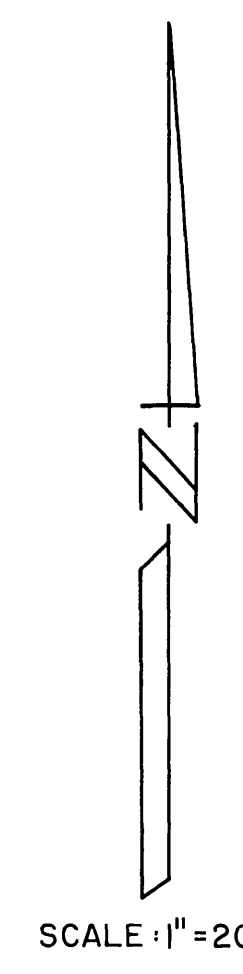
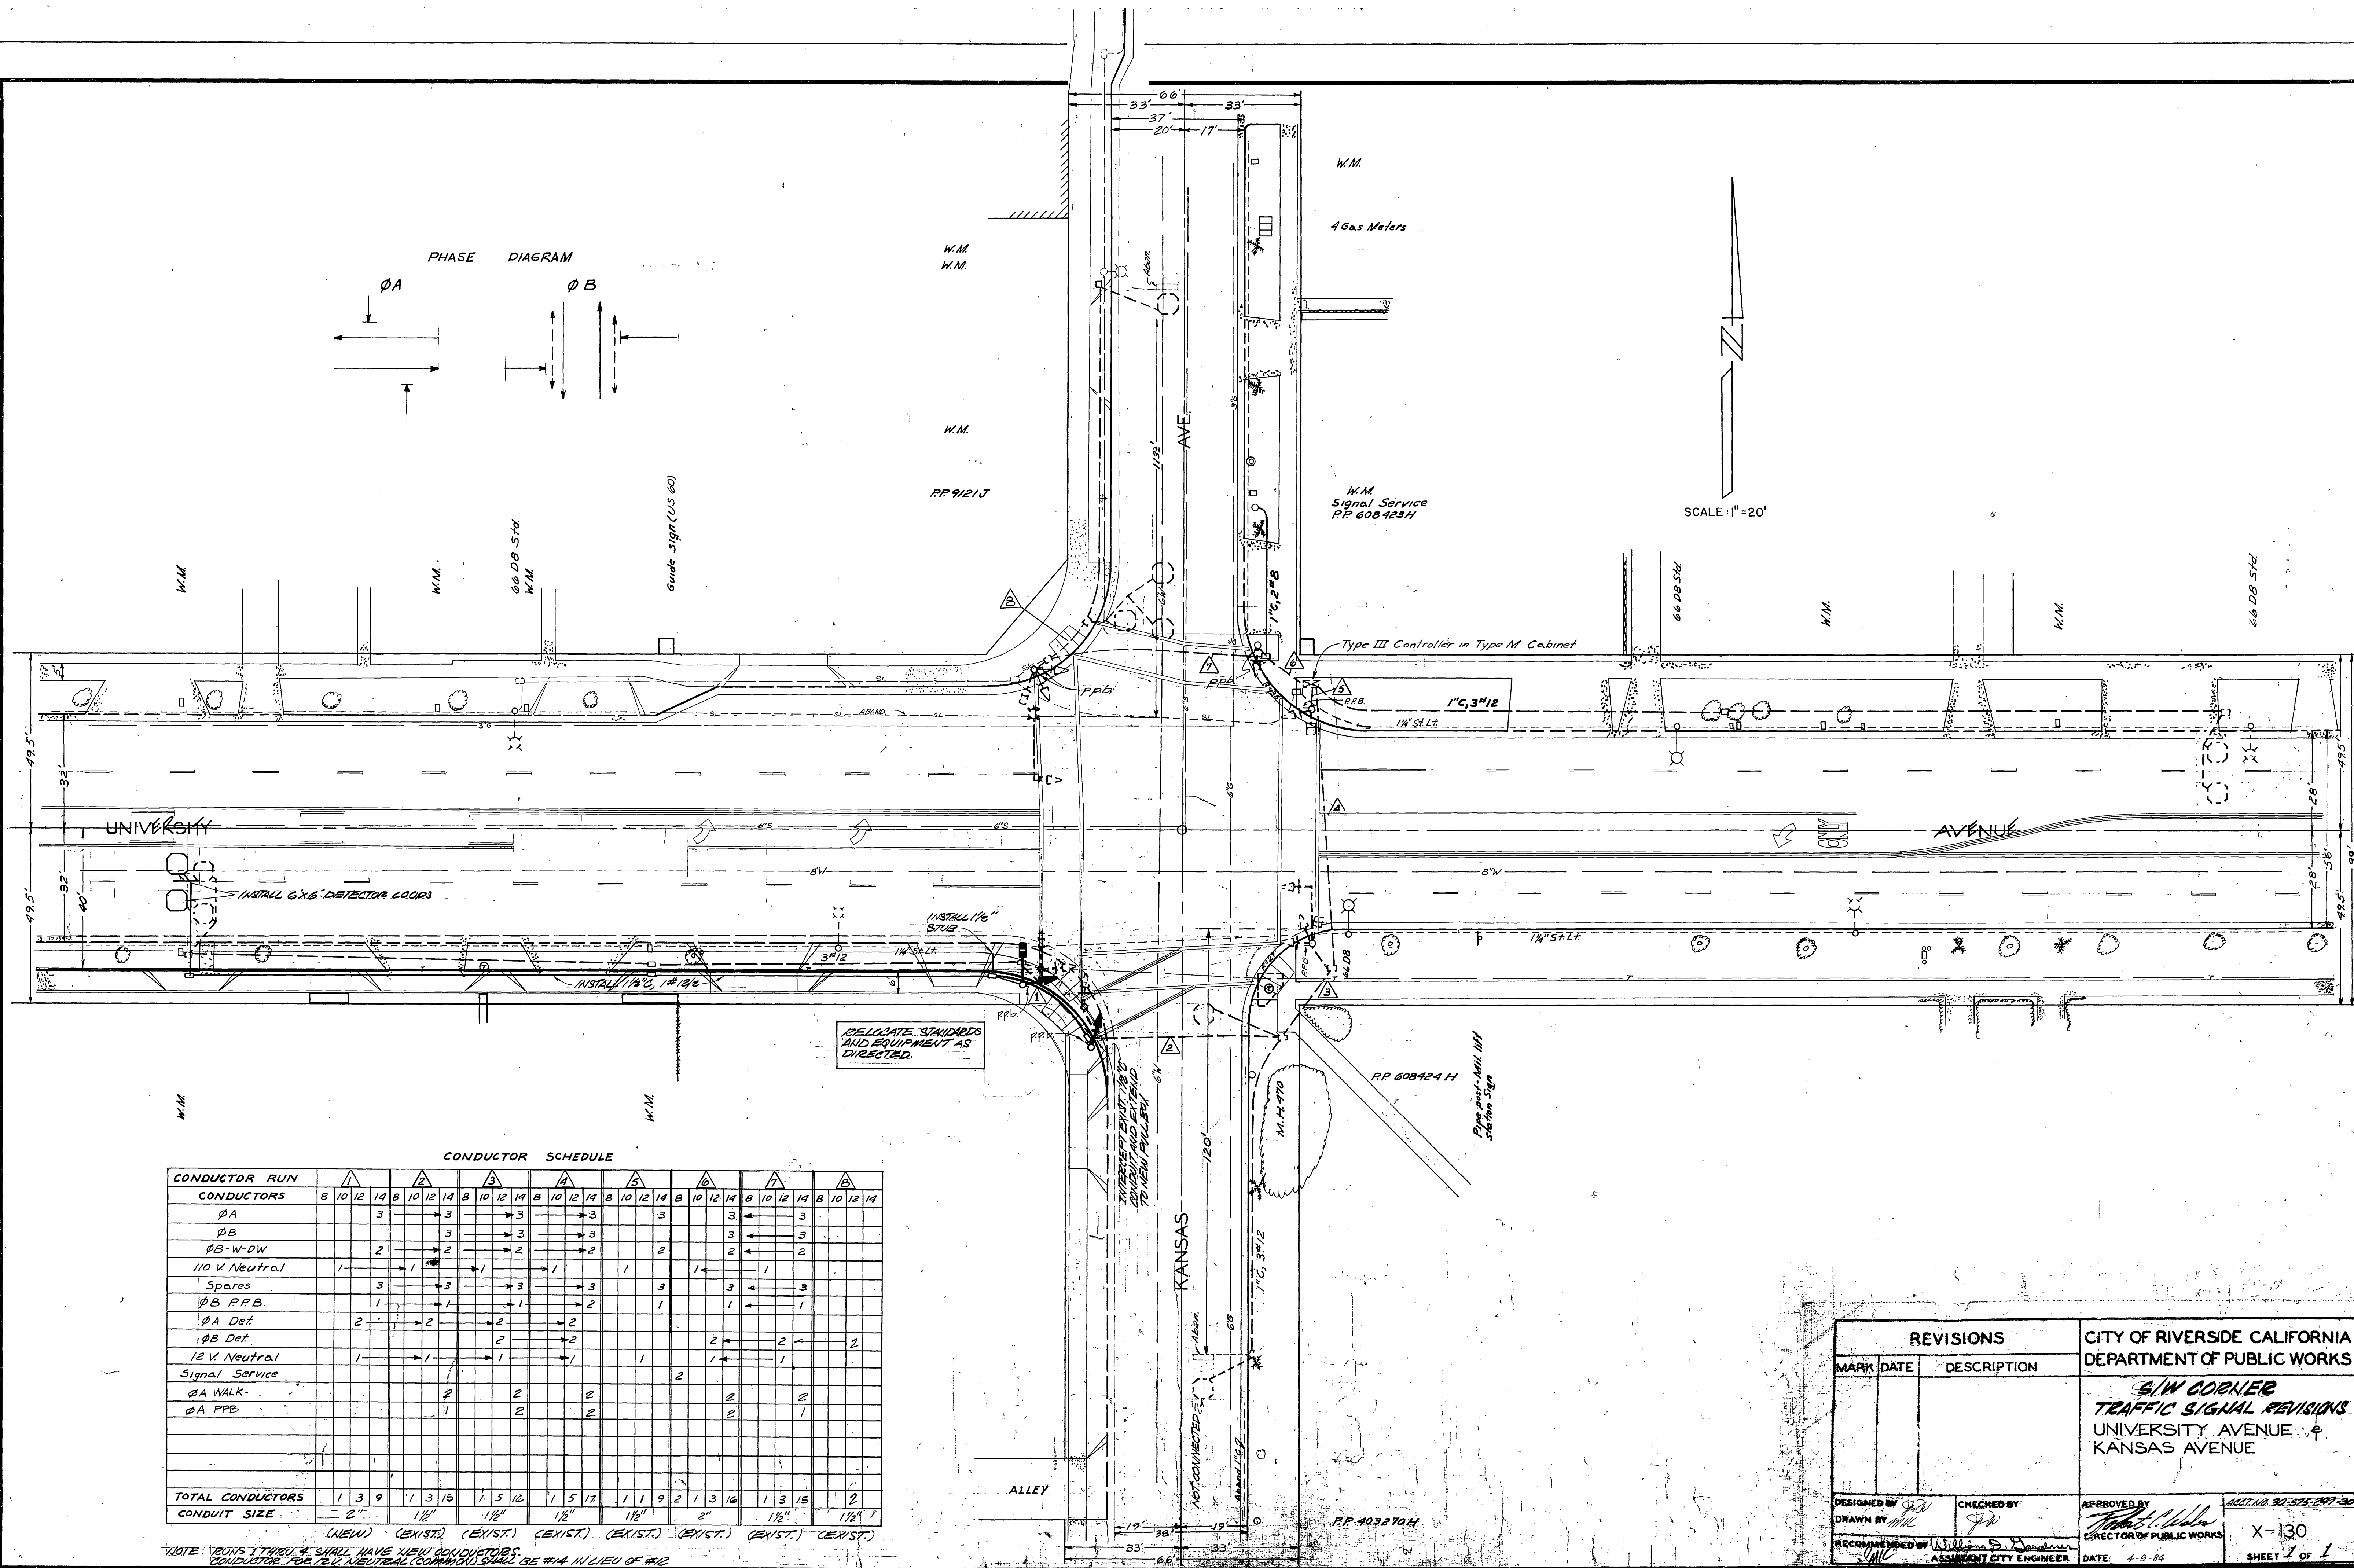
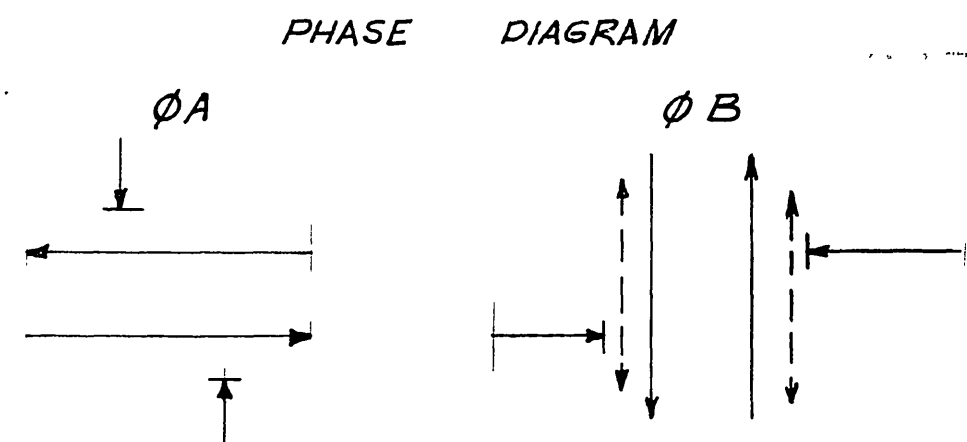


CONDUCTOR SCHEDULE

CONDUCTOR RUN	1		2		3		4		5		6		7		8								
	B	10	12	14	B	10	12	14	B	10	12	14	B	10	12	14							
φA			3	→	3	→	3	→	3	→	3	→	3	→	3	→	3						
φB					3	→	3	→	3	→	3	→	3	→	3	→	3						
φB-W-DW			2	→	2	→	2	→	2	→	2	→	2	→	2	→	2						
110 V Neutral	1	→	1	→	1	→	1	→	1	→	1	→	1	→	1	→	1						
Spares	3	→	3	→	3	→	3	→	3	→	3	→	3	→	3	→	3						
φB P.P.B.	1	→	1	→	1	→	2	→	1	→	1	→	1	→	1	→	1						
φA Det.	2	→	2	→	2	→	2	→		→	2	→	2	→	2	→	2						
φB Det.			2	→	2	→	2	→		→	2	→	2	→	2	→	2						
12 V. Neutral	1	→	1	→	1	→	1	→	1	→	1	→	1	→	1	→	1						
Signal Service									2	→							2						
φA WALK.			2	→	2	→	2	→			2	→	2	→	2	→	2						
φA P.P.B.			1	→	2	→	2	→			2	→	2	→	1	→	1						
TOTAL CONDUCTORS	1	3	9	1	3	15	1	5	16	1	5	17	1	1	9	2	1	3	16	1	3	15	2
CONDUIT SIZE			2"		1 1/2"		1 1/2"		1 1/2"		1 1/2"		2"		1 1/2"		1 1/2"		1 1/2"		1 1/2"		1 1/2"

NOTE: RUNS 1 THRU 4 SHALL HAVE NEW CONDUCTORS. CONDUCTOR FOR 12V. NEUTRAL (COMMON) SHALL BE #14 IN LIEU OF #12

REVISIONS		CITY OF RIVERSIDE CALIFORNIA DEPARTMENT OF PUBLIC WORKS
MARK	DATE	
		S/W CORNER TRAFFIC SIGNAL REVISIONS UNIVERSITY AVENUE & KANSAS AVENUE
DESIGNED BY	CHECKED BY	APPROVED BY
DRAWN BY		 DIRECTOR OF PUBLIC WORKS
RECOMMENDED BY	ASSISTANT CITY ENGINEER	DATE: 4-9-84

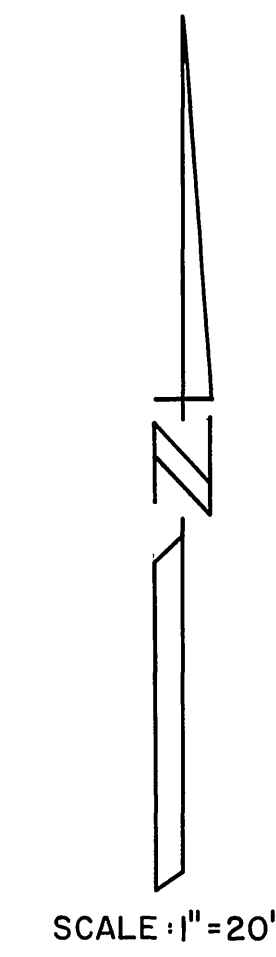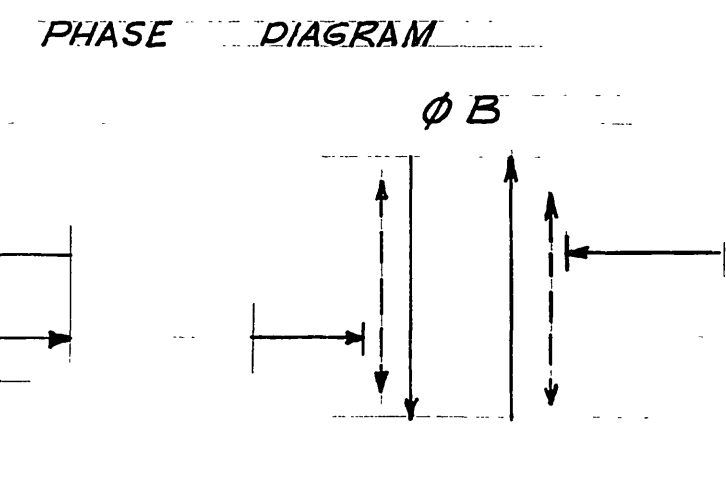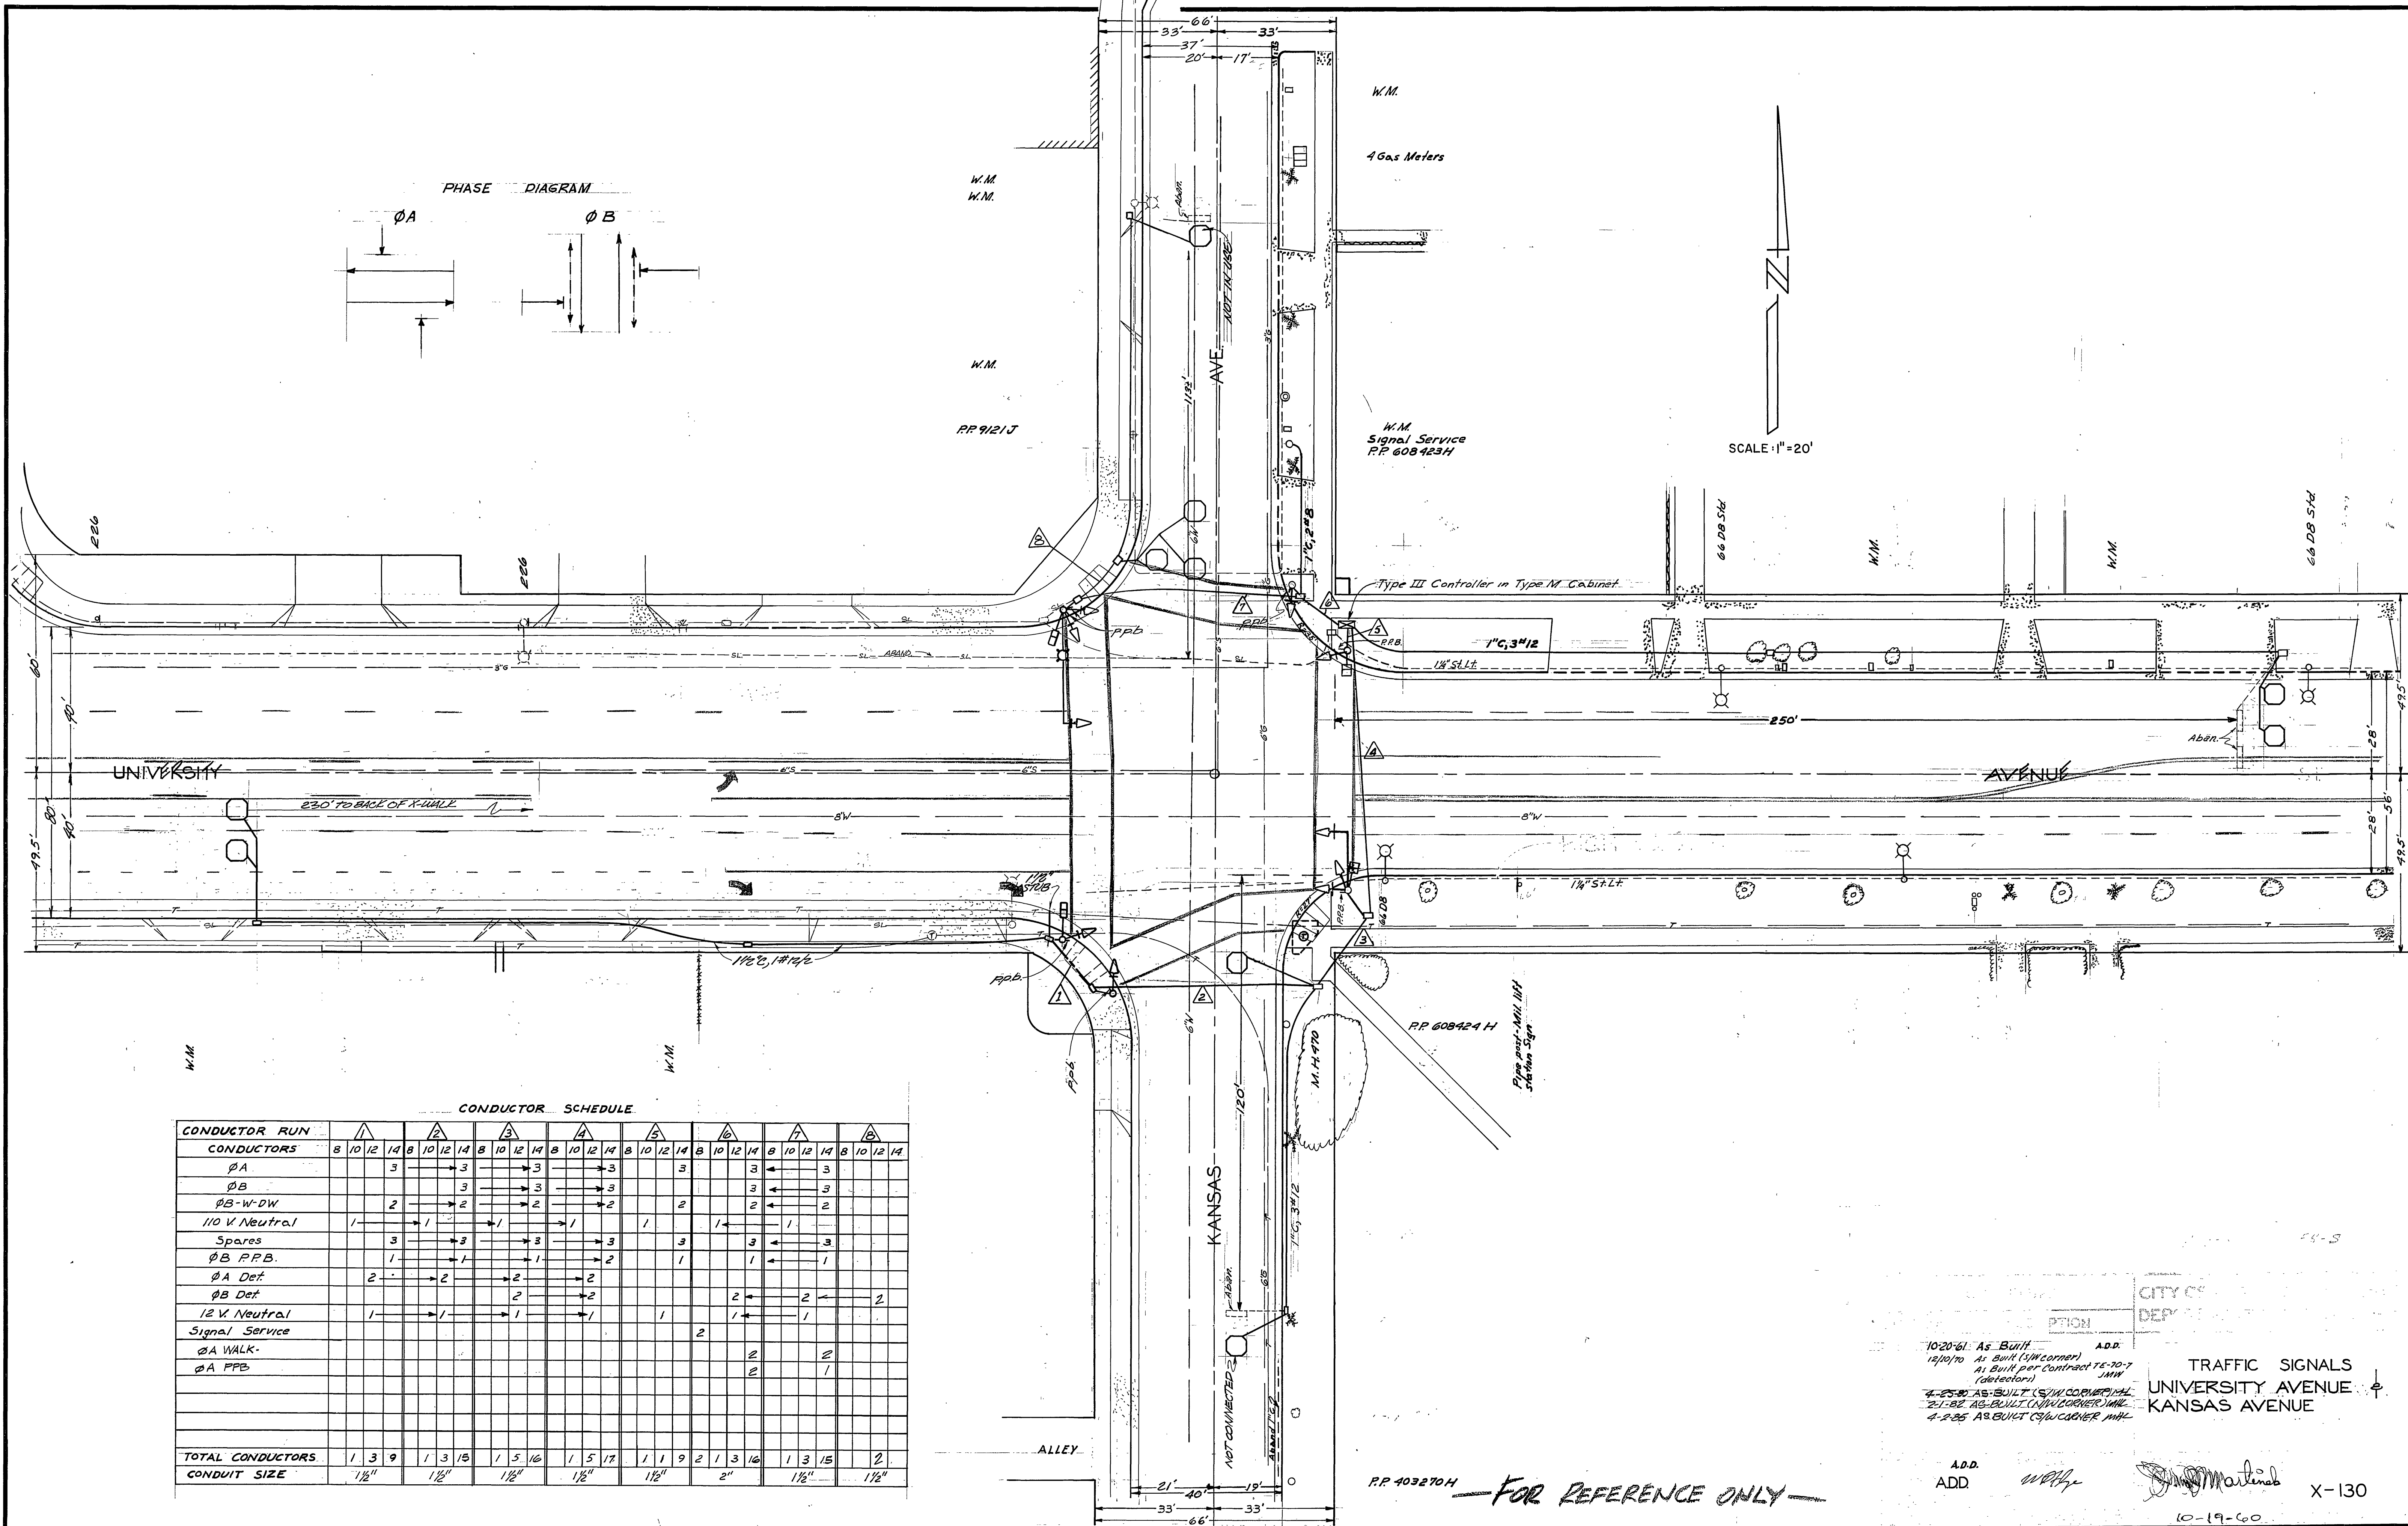

CONDUCTOR SCHEDULE

CONDUCTOR RUN	1			2			3			4			5			6			7			8			
CONDUCTORS	8	10	14	8	10	14	8	10	14	8	10	14	8	10	14	8	10	14	8	10	14	8	10	14	
ØA			3			3			3			3			3			3			3			3	
ØB						3			3			3			3			3			3			3	
ØB-W-DW			2			2			2			2			2			2			2			2	
110 V Neutral	1			1			1			1			1			1			1			1			
Spares			3			3			3			3			3			3			3			3	
ØB P.P.B.			1			1			1			1			1			1			1			1	
ØA Det.			2			2			2			2			2			2			2			2	
ØB Det.						2			2			2			2			2			2			2	
12 V Neutral	1			1			1			1			1			1			1			1			
Signal Service																									
ØA WALK.																									
ØA P.P.B.																									
TOTAL CONDUCTORS	1	3	9	1	3	15	1	5	16	1	5	17	1	1	9	2	1	3	16	1	3	15	2		
CONDUIT SIZE	1 1/2"			1 1/2"			1 1/2"			1 1/2"			1 1/2"			2"			1 1/2"			1 1/2"			

CITY OF KANSAS
DEPARTMENT OF PUBLIC WORKS

TRAFFIC SIGNALS
UNIVERSITY AVENUE &
KANSAS AVENUE



10-20-61 AS BUILT
12/10/70 AS BUILT (SW CORNER)
AS BUILT PER CONTRACT 75-20-7
(detectors)

4-25-80 AS BUILT (SW CORNER) MHC
2-1-82 AS BUILT (NW CORNER) MHC
4-2-85 AS BUILT (SW CORNER) MHC

ADD. W.P.H. [Signature]

10-19-60 X-130

PP 403270H FOR REFERENCE ONLY

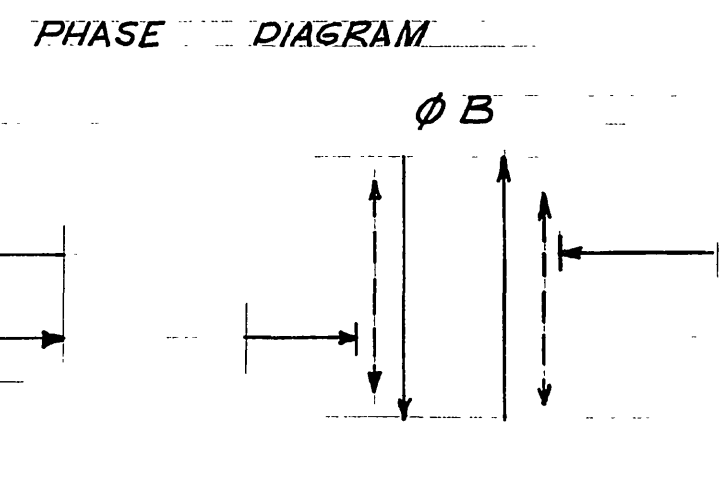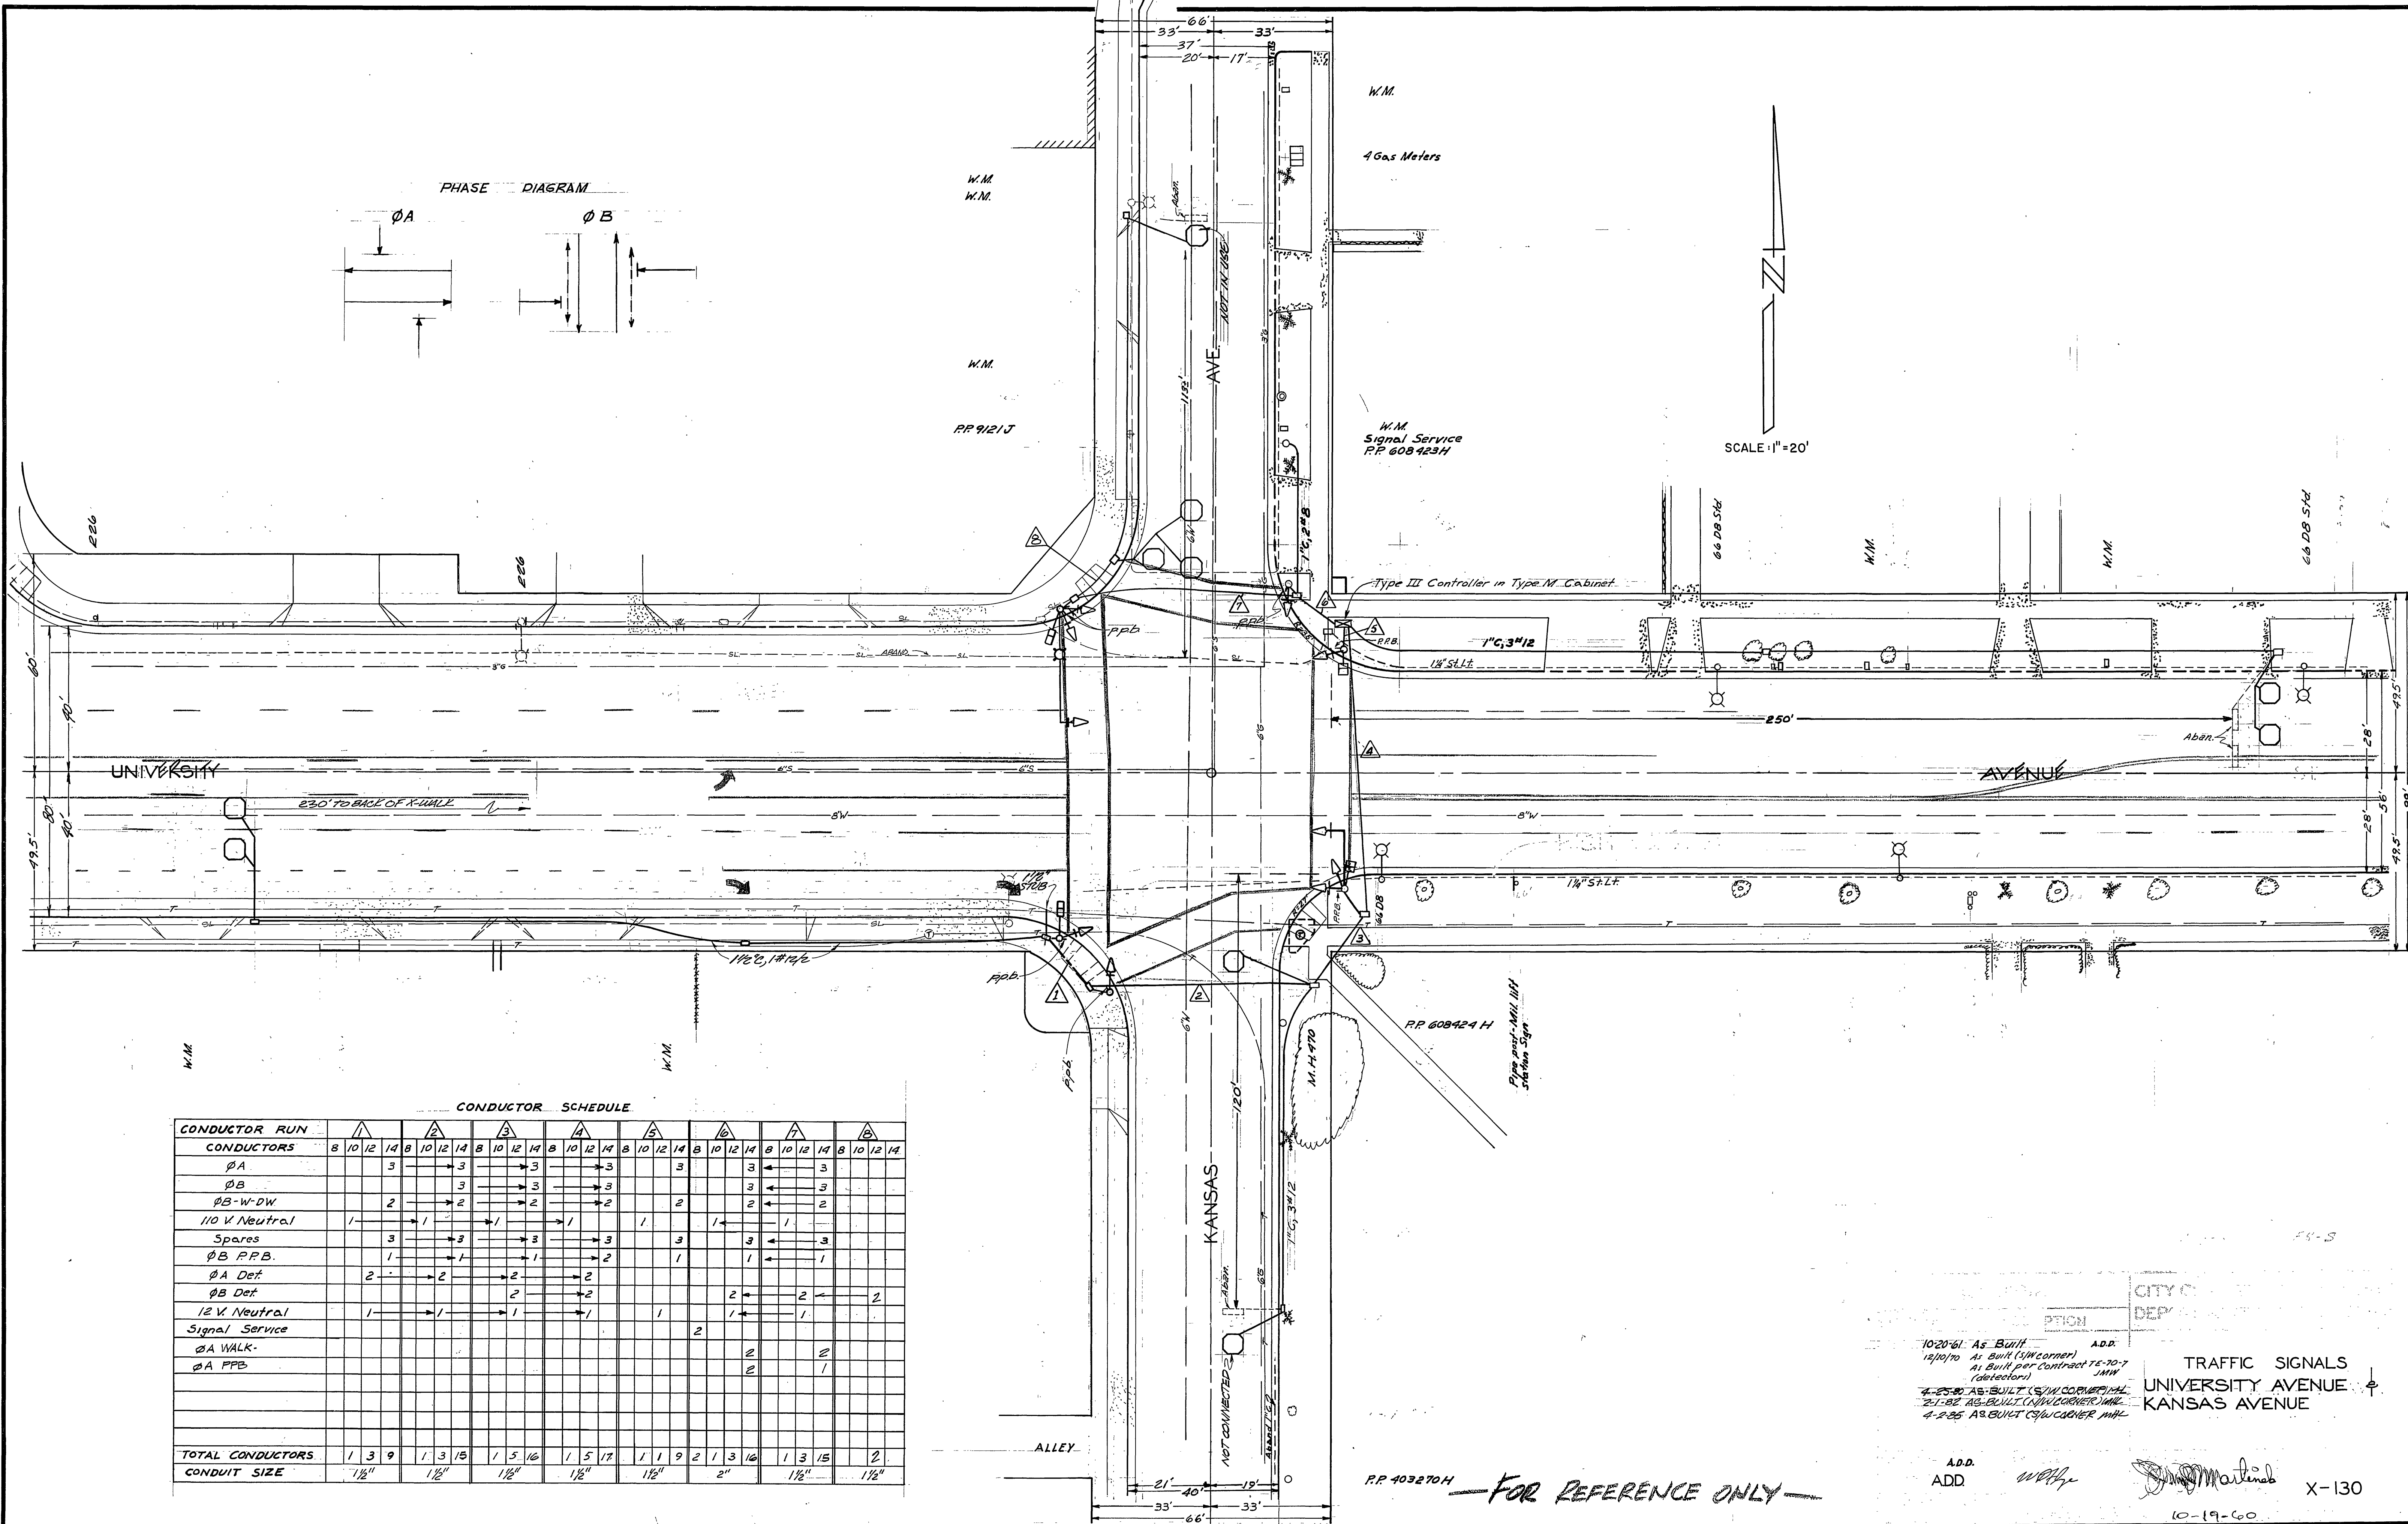

CONDUCTOR SCHEDULE

CONDUCTOR RUN	1			2			3			4			5			6			7			8			
CONDUCTORS	8	10	12	14	8	10	12	14	8	10	12	14	8	10	12	14	8	10	12	14	8	10	12	14	
Φ A			3			3			3			3			3			3			3			3	
Φ B				3			3			3			3			3			3			3			3
Φ B-W-DW			2			2			2			2			2			2			2			2	
110 V Neutral	1			1			1			1			1			1			1			1			1
Spares			3			3			3			3			3			3			3			3	
Φ B P.P.B.			1			1			1			1			1			1			1			1	
Φ A Det			2			2			2			2			2			2			2			2	
Φ B Det				2			2			2			2			2			2			2			2
12 V Neutral	1			1			1			1			1			1			1			1			1
Signal Service																									
Φ A WALK-																									
Φ A P.P.B.																									
TOTAL CONDUCTORS	1	3	9	1	3	15	1	3	16	1	3	17	1	1	9	2	1	3	16	1	3	15	2		
CONDUIT SIZE			1 1/2"			1 1/2"			1 1/2"			1 1/2"			1 1/2"			2"			1 1/2"			1 1/2"	

CITY OF ...
 DEPARTMENT OF ...
 TRAFFIC SIGNALS
 UNIVERSITY AVENUE &
 KANSAS AVENUE

10-20-61. AS BUILT
 12/10/70 As Built (1/4 corner)
 As Built per Contract 75-70-7
 (detector)

4-25-82 AS-BUILT (S/W CORNER) 1/4
 2-1-82 AS-BUILT (N/W CORNER) 1/4
 4-2-85 AS-BUILT (S/W CORNER) 1/4

A.D.D.
 ADD *[Signature]*

FOR REFERENCE ONLY

X-130
 10-19-60

Extend exist. H.D.G. St. Lt. Conduit to Pullbox, replace 2 #8 Cu. 600 V. Cables as required.

Install St. Lt. Pullbox per item PI of U.G.S.-800.
Relocate PP No. 4519 J & P anchor by C/R Public Utilities.
Exist. Embedded Conc. St. Lt. Standard relocate to clear new curb & driveway.

Install 1" H.D.G. St. Lt. Conduit w/2 #8 Cu. 600V. Cables.


Existing H.D.G. St. Lt. Conduit w/2 #8 Cu. 600V. Cables (120V), field determine conduit size, remove Cable B abandon unused portions of Conduit

Relocate PP No. 9121 J (Trench) by C/R Public Utilities.

Salvage exist. Standard, relocate all equip. to new Type 19-2-70 Std. with 30' Signalarm and 15' luminaire arm. Salvage PPB, provide new PPB intercept 1" C. & extend to new pullbox.

Scale 1"=20'

PHASE DIAGRAM

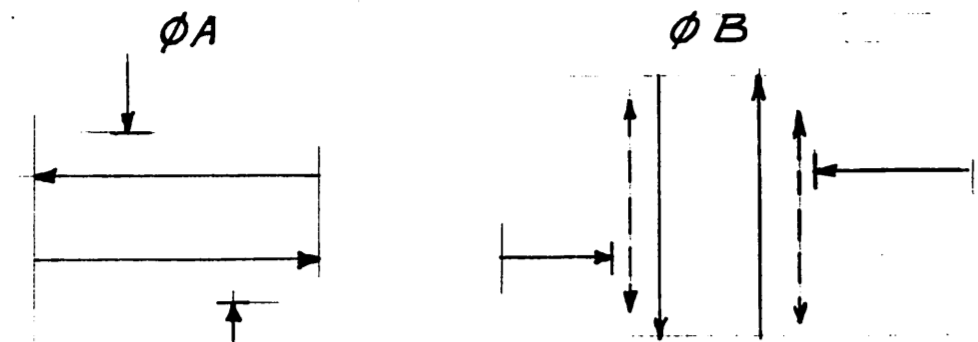


See C/R Street Improvement Plan R-
Street Light Notes

1. Install, relocate, & remove all Street Light Facilities as shown, in conformance with Street Light Spec. # 119 & Standard Drawings.
2. Contact Street Light Inspector at 787-7429 prior to starting work.
3. All Street Light Circuits to remain in operation each night.

Traffic Signal Notes


1. All work shall conform to the most current provisions of Sec. 86 of the State Standard Specifications, the State Standard Plans, applicable C/R Std. Dwg's., and the C/R Public Utilities Specification No. 119.
2. No splicing will be allowed; new conductors shall be installed in all Conduit on the improved corner to the Controller.
3. Detector loops will be installed in the presence of the Traffic Engineer or his representative.
4. See Plan X-130 for additional information.

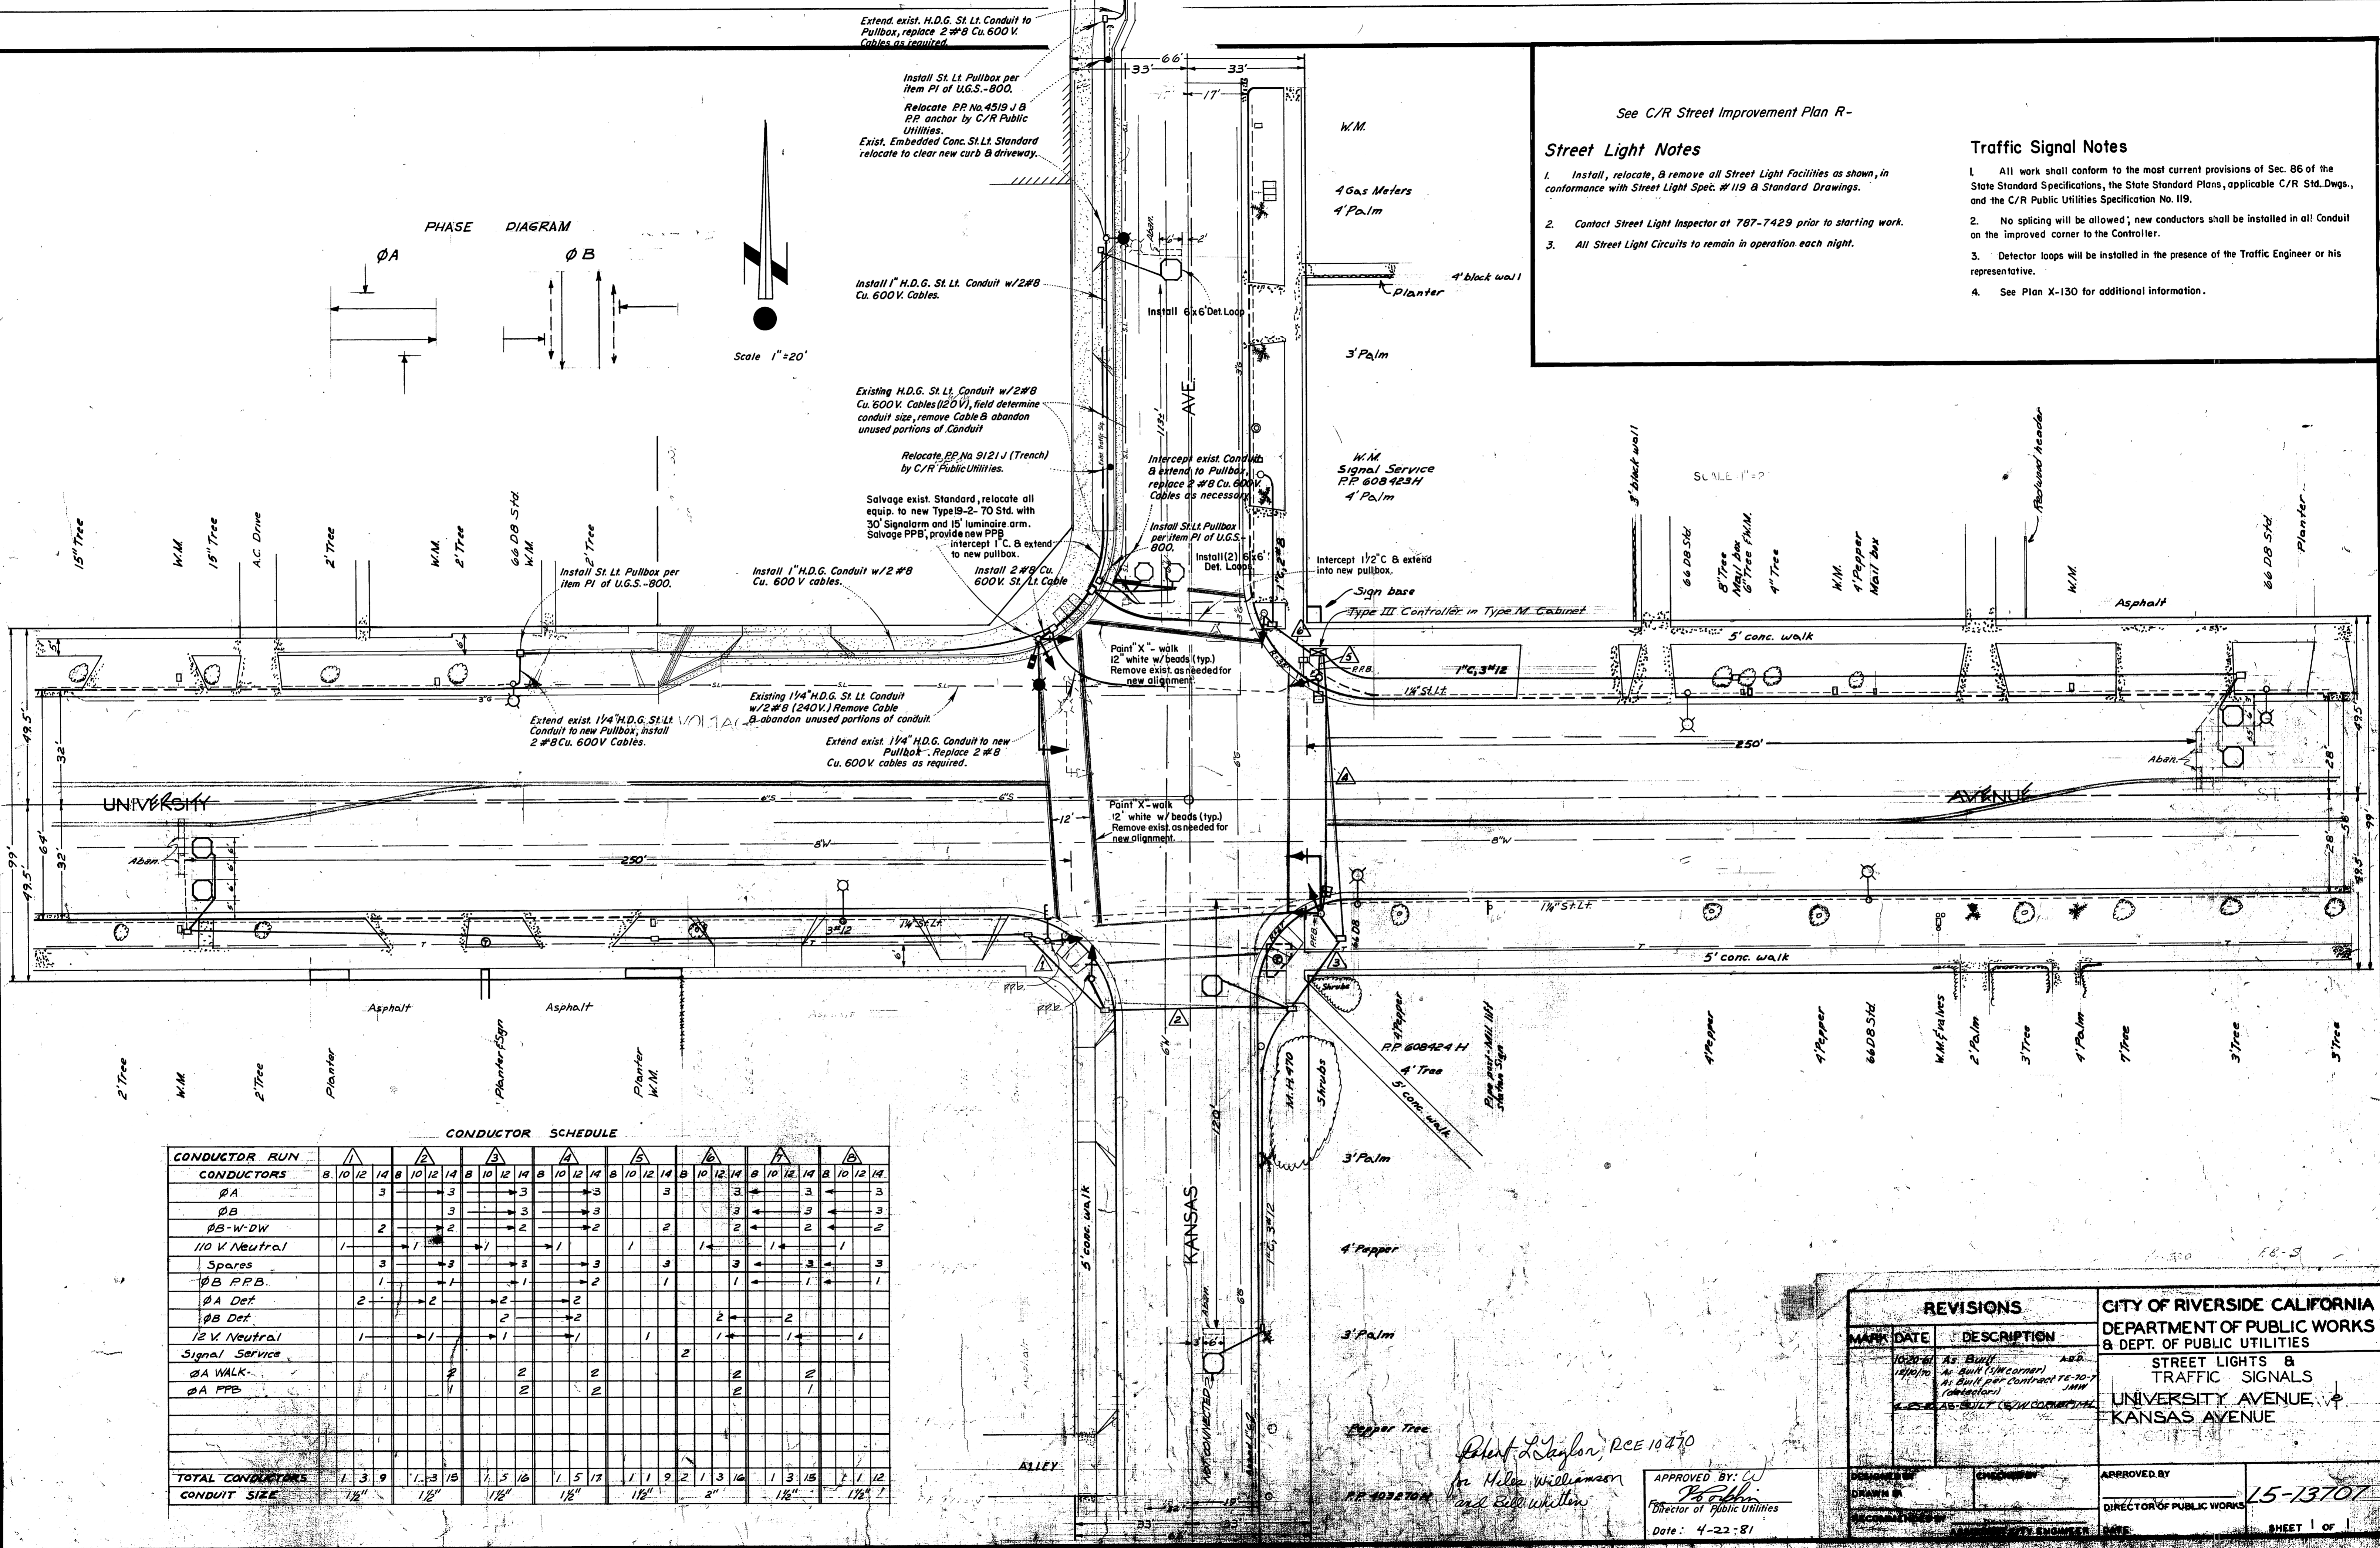

CONDUCTOR SCHEDULE

CONDUCTOR RUN	A			B			C			D			E			F			G									
	8	10	14	8	10	14	8	10	14	8	10	14	8	10	14	8	10	14	8	10	14	8	10	14				
CONDUCTORS																												
ØA																												
ØB																												
ØB-W-DW																												
110 V Neutral	1			1			1			1			1			1			1			1			1			
Spares																												
ØA PPB																												
ØA Def																												
ØB Def																												
12 V. Neutral	1			1			1			1			1			1			1			1			1			
Signal Service																												
ØA WALK																												
ØA PPB																												
TOTAL CONDUCTORS	1	3	9	1	3	13	1	5	10	1	5	13	1	1	9	2	1	3	10	1	3	15	2	1	12			
CONDUIT SIZE			1 1/2"			1 1/2"			1 1/2"			1 1/2"			2"			1 1/2"			1 1/2"			1 1/2"				

REVISIONS		CITY OF RIVERSIDE CALIFORNIA DEPARTMENT OF PUBLIC WORKS & DEPT. OF PUBLIC UTILITIES
MARK	DATE	
	10/20/81	STREET LIGHTS & TRAFFIC SIGNALS UNIVERSITY AVENUE & KANSAS AVENUE
	10/10/81	
	11/25/81	
APPROVED BY:	CHECKED BY:	APPROVED BY:
DATE: 4-22-81		15-13701

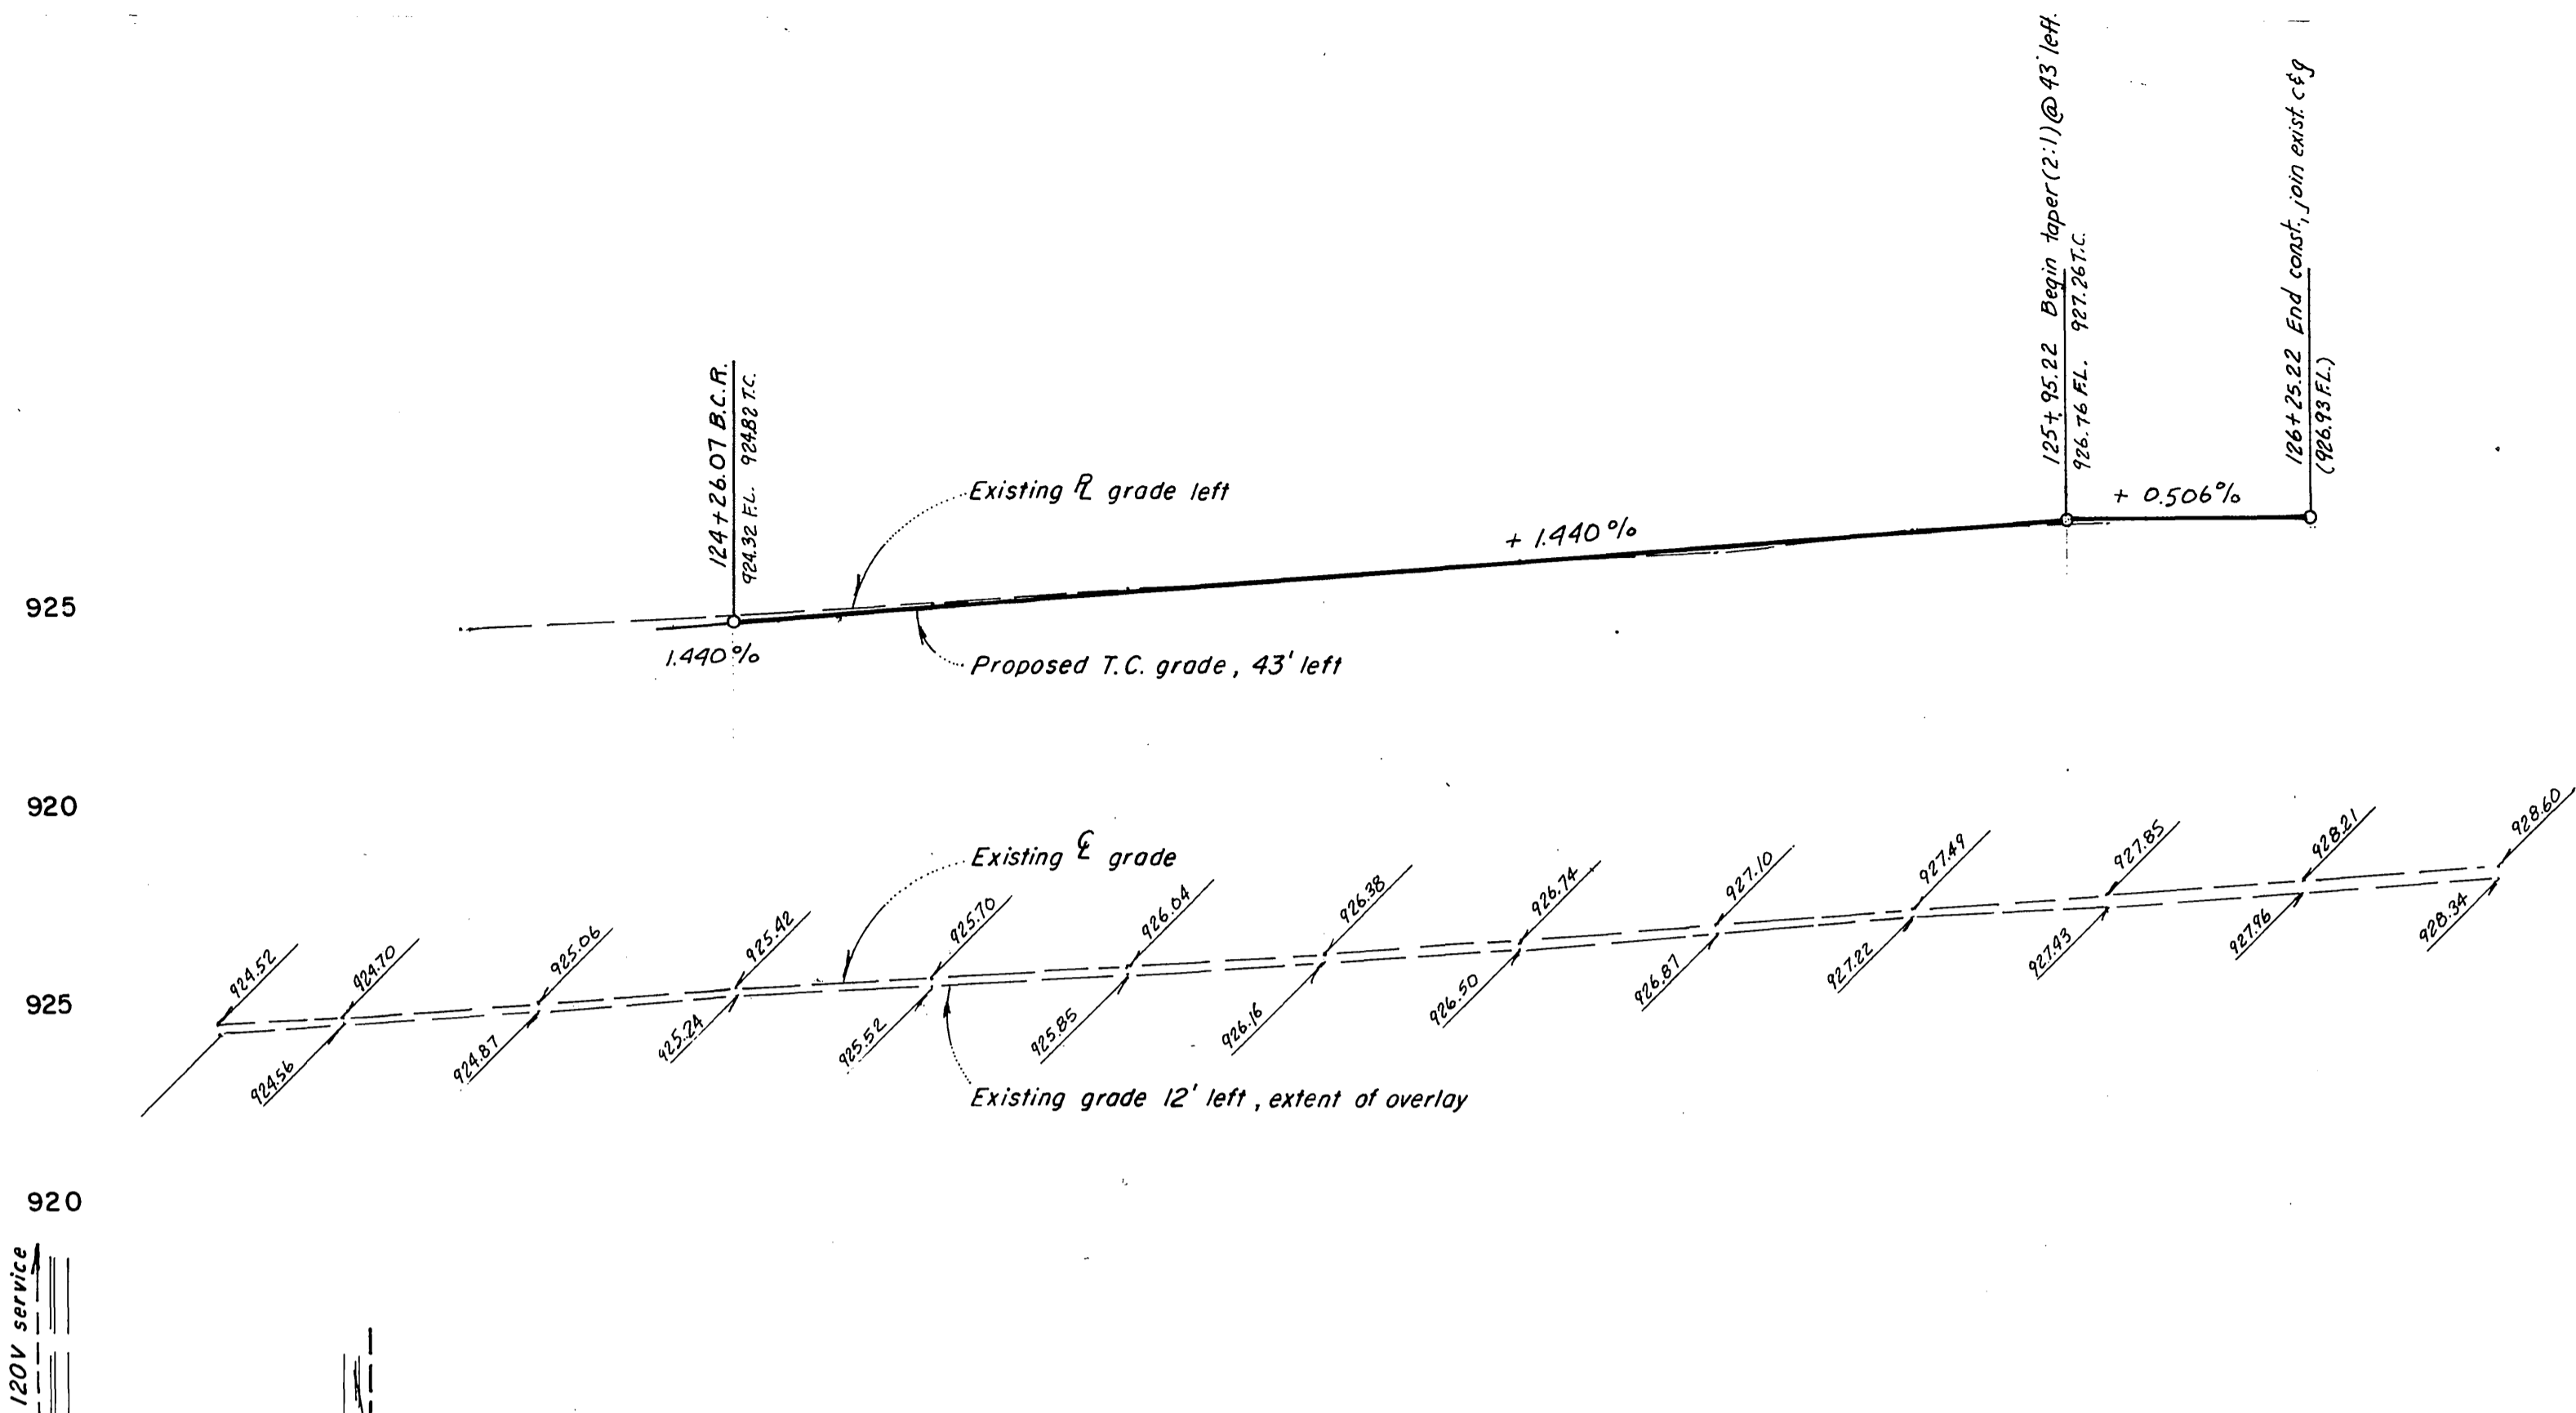

PROFILE.
Scale: Hor. 1"=20'
Vert. 1"=4'


PLAN
Scale: 1"=20'

CONSTRUCTION NOTES:

CONDUCTOR RUN	A		B		C		D		E		F		G		H		I			
	8	10	12	14	8	10	12	14	8	10	12	14	8	10	12	14	8	10	12	14
CONDUCTORS																				
φ A			3				3				3				3				3	
φ B																				
φ B W DW			2				2				2				2				2	
110 V. Neutral	1				1				1				1				1			
Spares			3				3				3				3				3	
φ A P.R.B.			1				1				1				1				1	
φ A Det.	2				2				2				2				2			
φ B Det.																				
12 V. Neutral	1				1				1				1				1			
Signal Service																				
φ A Walk																				
φ A P.P.B.																				
Luminaries																				
Total Conductors	1	3	9		1	3	12		1	5	13		2	1	6	13	2	2	9	28
Conduit Size	1 1/2" (E)				1 1/2" (E)				1 1/2" (E)				2 1/2" (N)				3" (N)			

Conduit Runs A, B, C, D, E, F, G, H, I shall have new conductors.
E = existing conduit
N = new conduit

EXISTING PHASE DIAGRAM

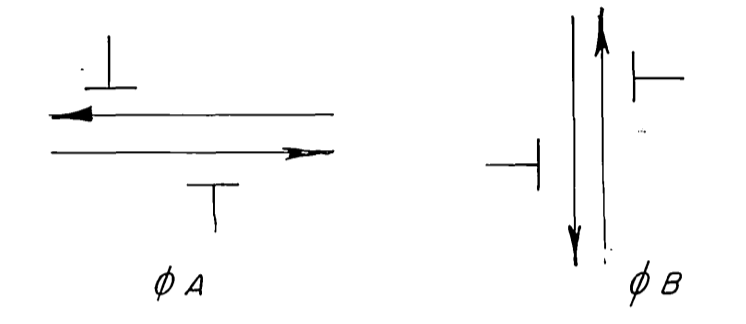

TRAFFIC SIGNAL CONSTRUCTION NOTES:

- All traffic signal work shall conform to the provisions of Section B6 of the most current Standard Specifications and Standard Plans published by the State of California Department of Transportation.
- Splicing of conductors will not be allowed, unless otherwise noted.
- Traffic signal pullbox lids shall be marked "Traffic Signal."
- Contractor to furnish and install Housing and Breaker as specified. Square D Cabinet Loadcenter - SQD # Q06-12RB 40 Amp Breaker (Signals) - 5 P. # SQD QD
- Omission in the "Conductor Schedule" or on the plan will not relieve the Contractor of the responsibility to install the correct number of conductors and cable to operate the traffic signal; this shall also pertain to Street Light circuits



- (A) Provide and install Type 19-2-80 Standard (12" CA, 25" SA), luminaire (250W High Pressure Sodium Vapor), MAS and S.V.-T mounted vehicular heads. Use pedestrian head from Loc. (B); modify framework to SP-1-T.
- (B) Salvage Type 1 Standard and vehicular head.
- (C) Relocate Type 1 Standard as indicated; relocated pedestrian head to Loc. (A)
- (D) Install relocated Type 1 Standard from Loc. (C) P.R.B. to remain

STREET LIGHT CONSTRUCTION & RELOCATION:

- Install, relocate and remove all street lighting facilities as shown and in conformance with St. Light Spec. # 119 and related Standard Drawings. Contact 787-7429 for required inspections.

- NOTE: (1) Street light and signal foundations to be abandon, shall be completely removed. This requirement also includes controller cabinet foundation.
(2) Signal and street lights are to remain operable at all times during construction.

BEFORE YOU DIG
CALL U.S. TOLL FREE
800-422-4133

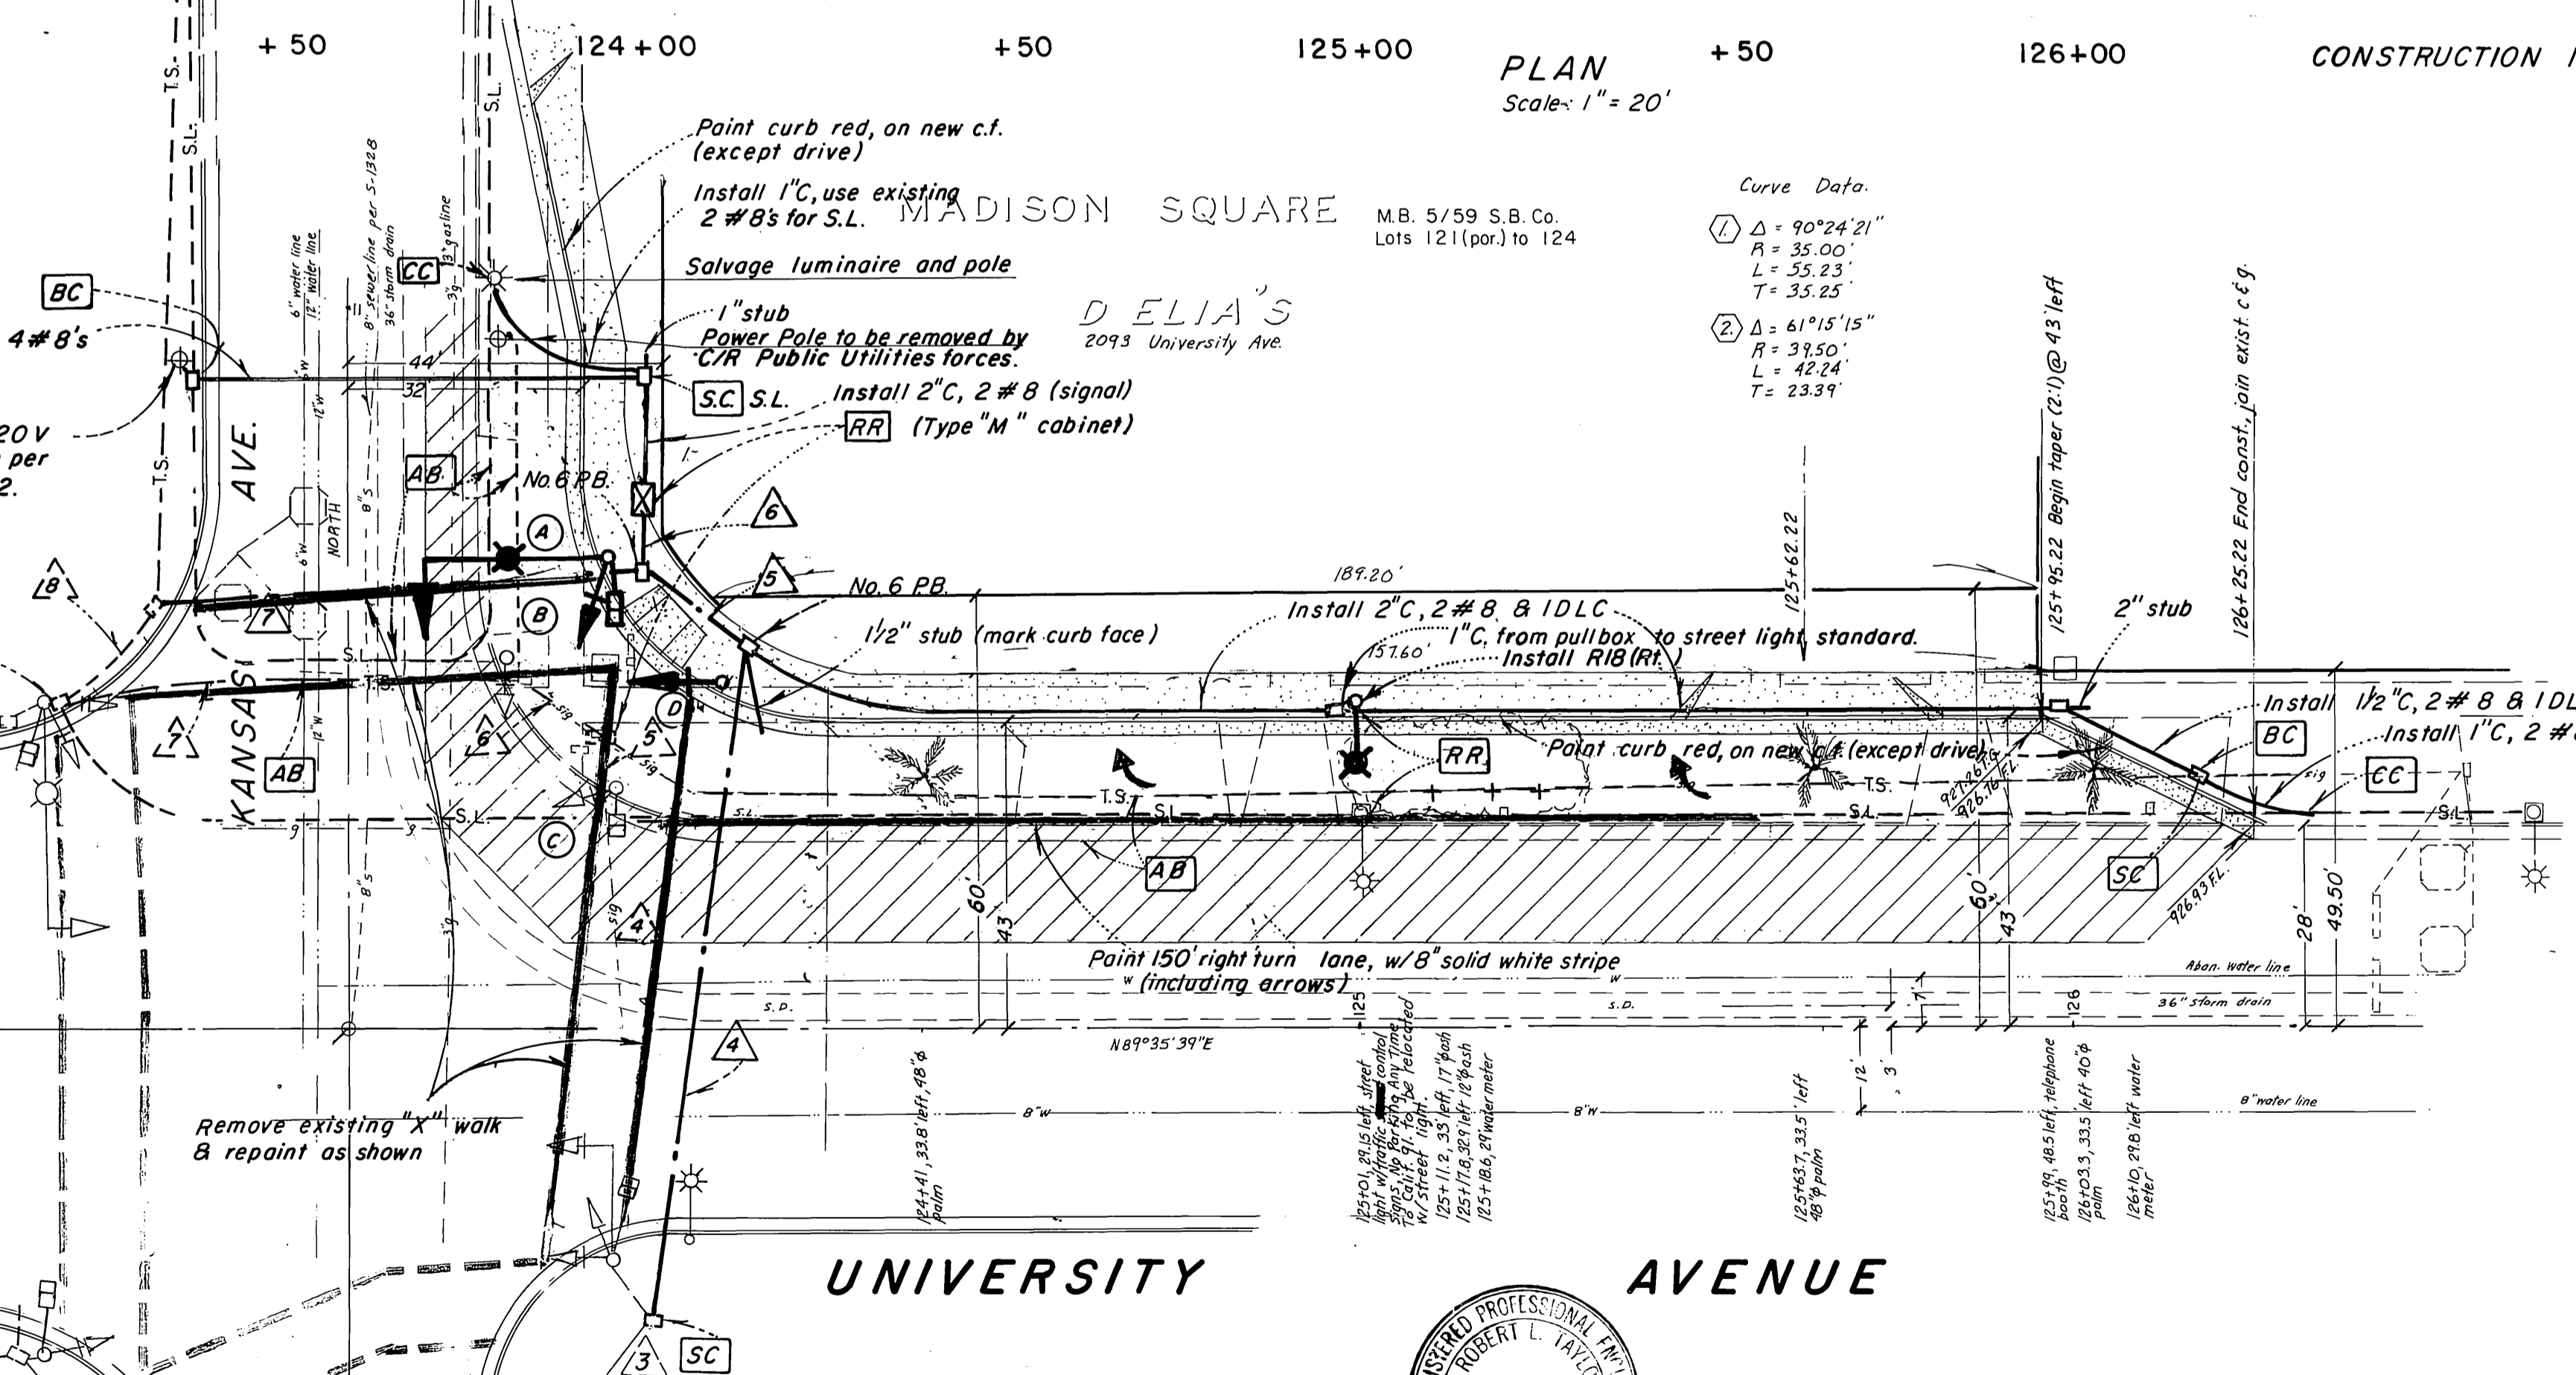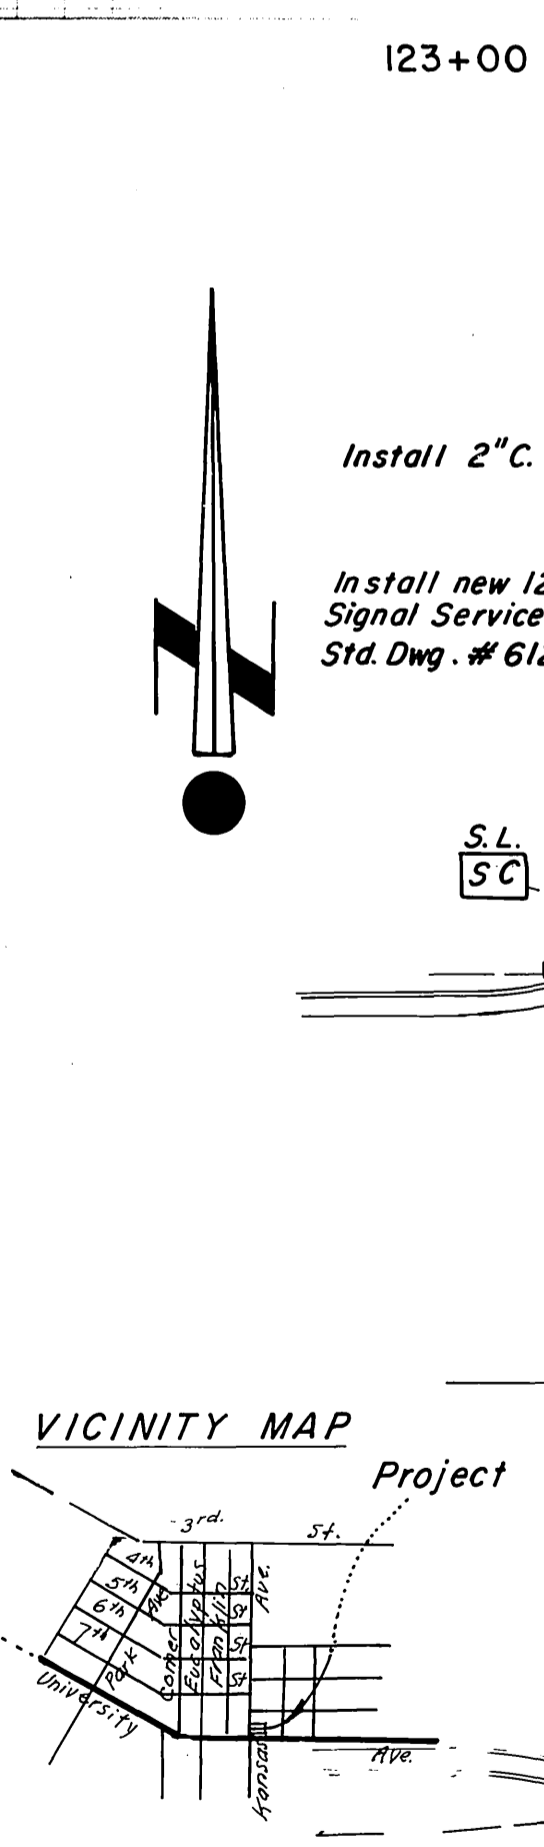

City of Riverside, Electric Appr. by: <i>[Signature]</i>		Robert L. Taylor - Civil Engineer 5830 Magnolia Ave. Riverside, Calif. 714-683-0617		CITY OF RIVERSIDE PUBLIC WORKS DEPARTMENT		Traffic Signal & Street Lt. Relocation Plan UNIVERSITY AVE. & KANSAS AVE.		X-130
BENCHMARK: P.K. nail and City Engineer tag 1' west of the E.C.R. on the N.W. curb return of University Ave and Kansas Ave. B.M. 17-D Elev. = 923.273		Approved by: <i>[Signature]</i> Date 2/26/87 Robert L. Taylor R.C.E. 10470		APPROVED BY: <i>[Signature]</i> DATE: 3-2-87		C-11-857 HORIZ. SCALE: 1"=20' VERT. SCALE: 1"=4'		