
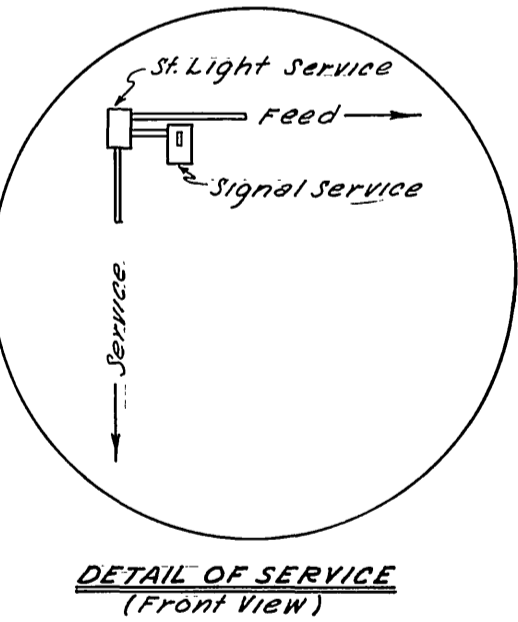


DETAIL AT MASTER CONTROLLER

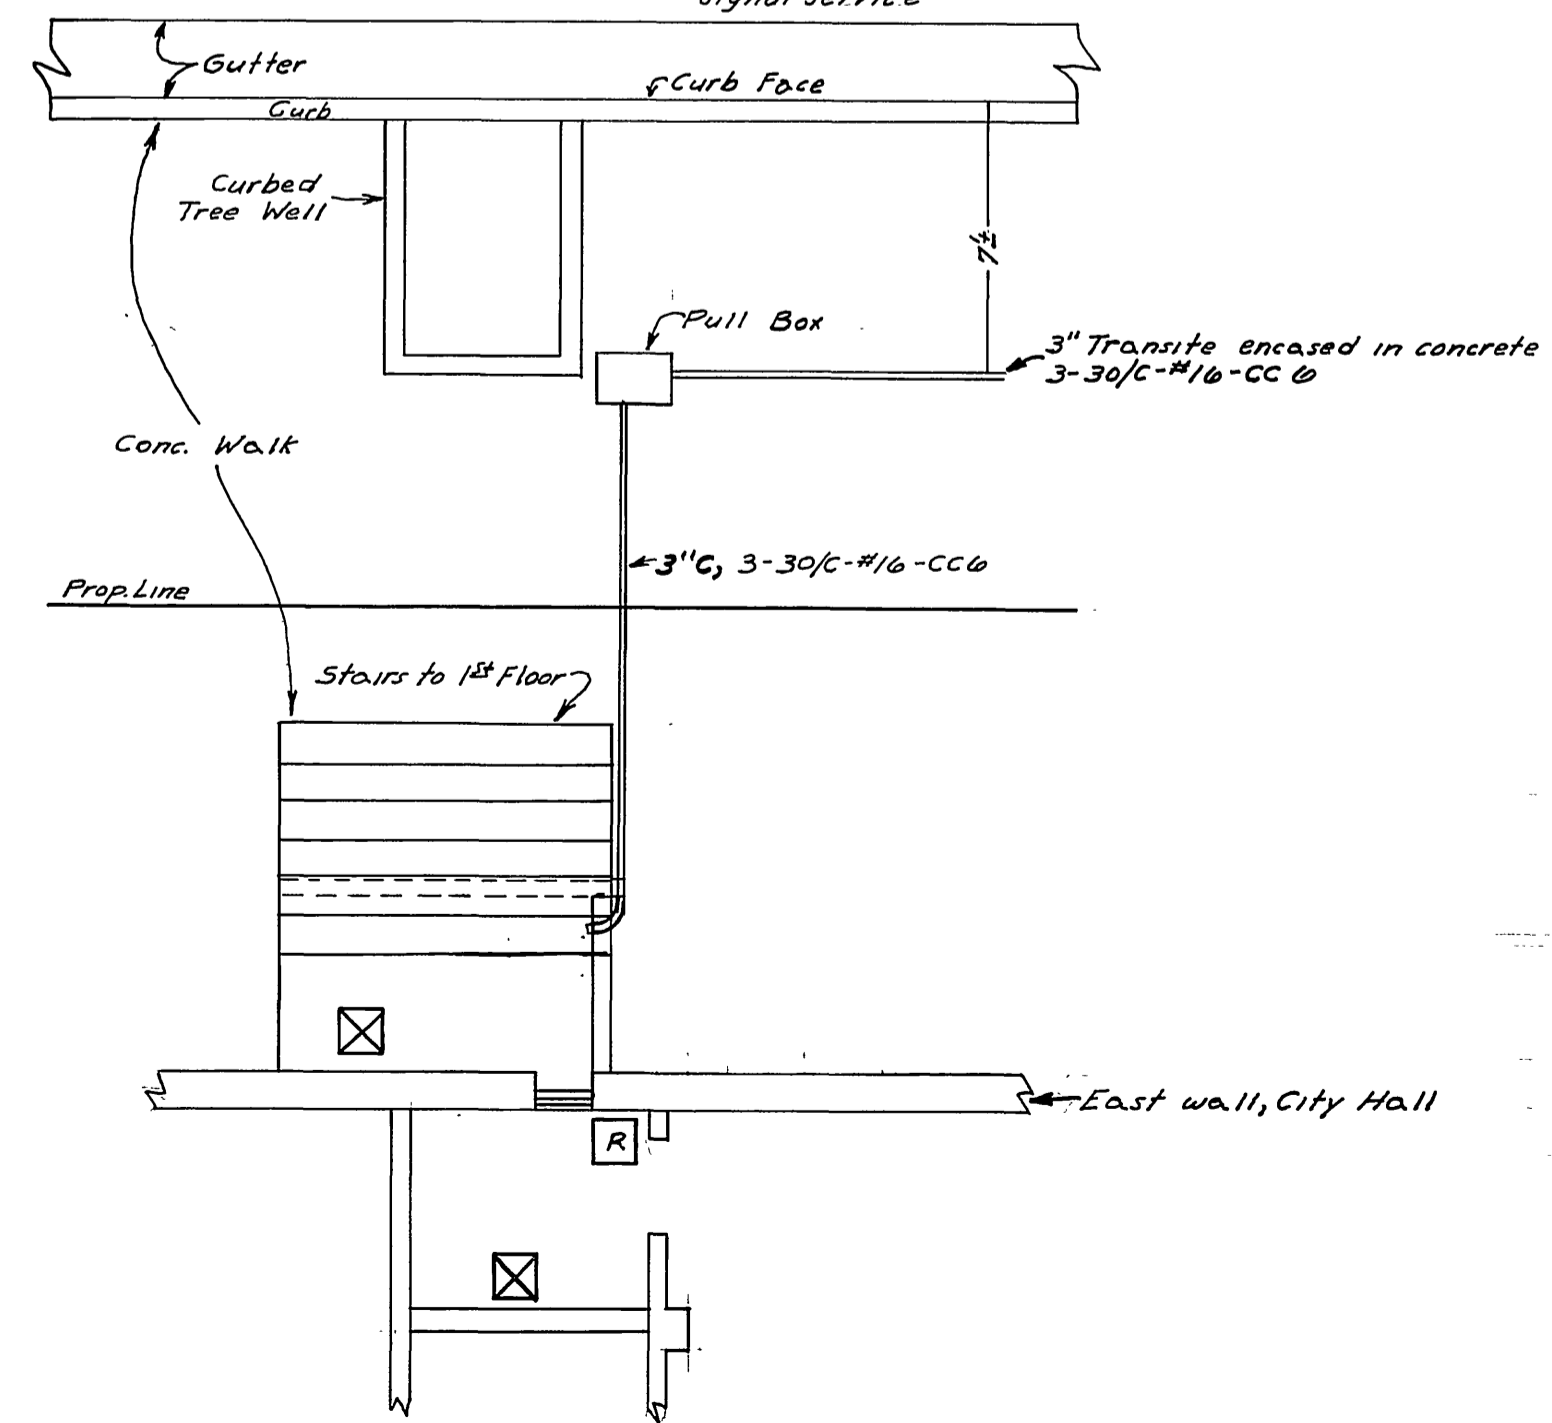

EQUIPMENT SCHEDULE

Location	Standard	Vehicle Equipment				Ped. Equipment			Luminaire
		Heads	Mtg's	Base Plate	Louwer	Heads	Mtg's	RPB's	
A, B & C	TC-7011	1WSCL(12")	M-2	1	2W2C	W-3			
	1B'MA	1W3C	B-1						
D	741AB				2W2C	W-3		250V	

\*\* Exterior mounted, conduit w/ conductors fasten to standard.

1/18/62 As Built  
 5/18/72 As Built (Cont. TE-71-B) JMW

TRAFFIC SIGNALS  
 ORANGE ST.  
 7TH STREET

ADD

X-139