



CONDUCTOR		TABLE							
CONTROL FUNCTION	CONDUCTORS	CONDUCTOR				RUNS			
		1	2	3	4	5	6	7	8
VEHICLE & PEDESTRIAN HEADS, PEDESTRIAN PUSH BUTTONS, SPARES & COMMONS	12 CONDUCTOR IMSA	1	2	3	4	5	8	2	1
	3 CONDUCTOR IMSA	1	2	3	4	5	8	2	1
DETECTOR CABLE	#16/2								
PHASE 1		-	-	-	-	1	1	-	-
PHASE 2		2	2	2	2	2	2	-	-
PHASE 4		-	-	-	-	-	1	1	-
PHASE 5		1	1	1	1	1	1	-	-
PHASE 6		-	-	-	-	2	2	-	-
PHASE 8		-	-	1	1	1	1	-	-
TOTALS		3	3	4	4	7	8	1	-
EXPE CABLE	#20/4	-	1	1	2	-	4	1	1
IISNS	#12	-	2	2	2	2	-	2	2
LUMINAIRES	#8	-	2	2	2	2	-	2	2
SIGNAL SERVICE	#8	-	-	-	-	-	2	2	2
CONDUIT SIZE		2"(E)	2"(E)	2.5"(E)	3"	3"(E)	2-3.5"	2"(E)	2"(E)

ALL CONDUIT AND CONDUCTORS ARE NEW UNLESS OTHERWISE INDICATED AS (E) EXISTING. EXISTING CONDUCTORS SHALL BE REMOVED AND NOT REUSED UNLESS OTHERWISE NOTED.

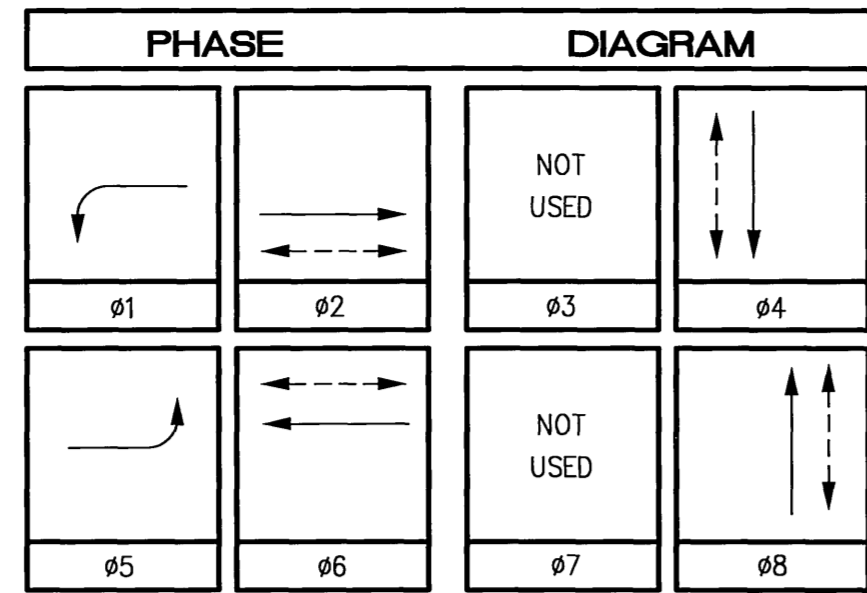

No.	STANDARD TYPE	HGT.	SIG. M.A.	LUM. M.A.	LUMINAIRE HPS	IISNS LEGEND	SIGNAL MOUNTING				PPB PHASE	REMARKS	
							VEHICLE	PED	AUDIBLE				
1	19-4-129(N)	30'	30'(N)	12'(N)	250W(N)	Bandini Ave 4100(N)	MAS(N)	MAS(N)	SV-1-T(N)	SP-1-T(N)	((C))(N)	Ø4(N)	
2	1-A	7'	-	-	-	-	-	-	-	TP-1-T	((P))(N)	Ø6(N)	
3	17-2-80	30'	15'	12'	200W	Brockton Ave 5300	-	MAS	SV-1-T	SP-1-T	((P))(N)	Ø6(N)	
4	1-A	10'	-	-	-	-	-	-	TV-1-T(N)	SP-1-T	((C))(N)	Ø8(N)	
5	19-4-129(N)	30'	30'(N)	12'(N)	250W(N)	Bandini Ave 4000(N)	MAS(N)	MAS(N)	SV-1-T(N)	SP-1-T(N)	((C))(N)	Ø8(N)	
6	1-A	7'	-	-	-	-	-	-	-	TP-1-T	((P))(N)	Ø2(N)	
7	17-2-80	30'	15'	12'	200W	Brockton Ave 5400	-	MAS	SV-1-T	SP-1-T	((P))(N)	Ø2(N)	
8	1-A	10'	-	-	-	-	-	-	TV-1-T(N)	SP-1-T	((C))(N)	Ø4(N)	

ALL EQUIPMENT IS EXISTING UNLESS OTHERWISE INDICATED AS (N) NEW. ((C)) OR ((P)) - INDICATES AUDITORY PEDESTRIAN SIGNAL TO BE INSTALLED; ((C)) INDICATES CUCKOO SOUND; ((P)) INDICATES PEEP-PEEP SOUND.

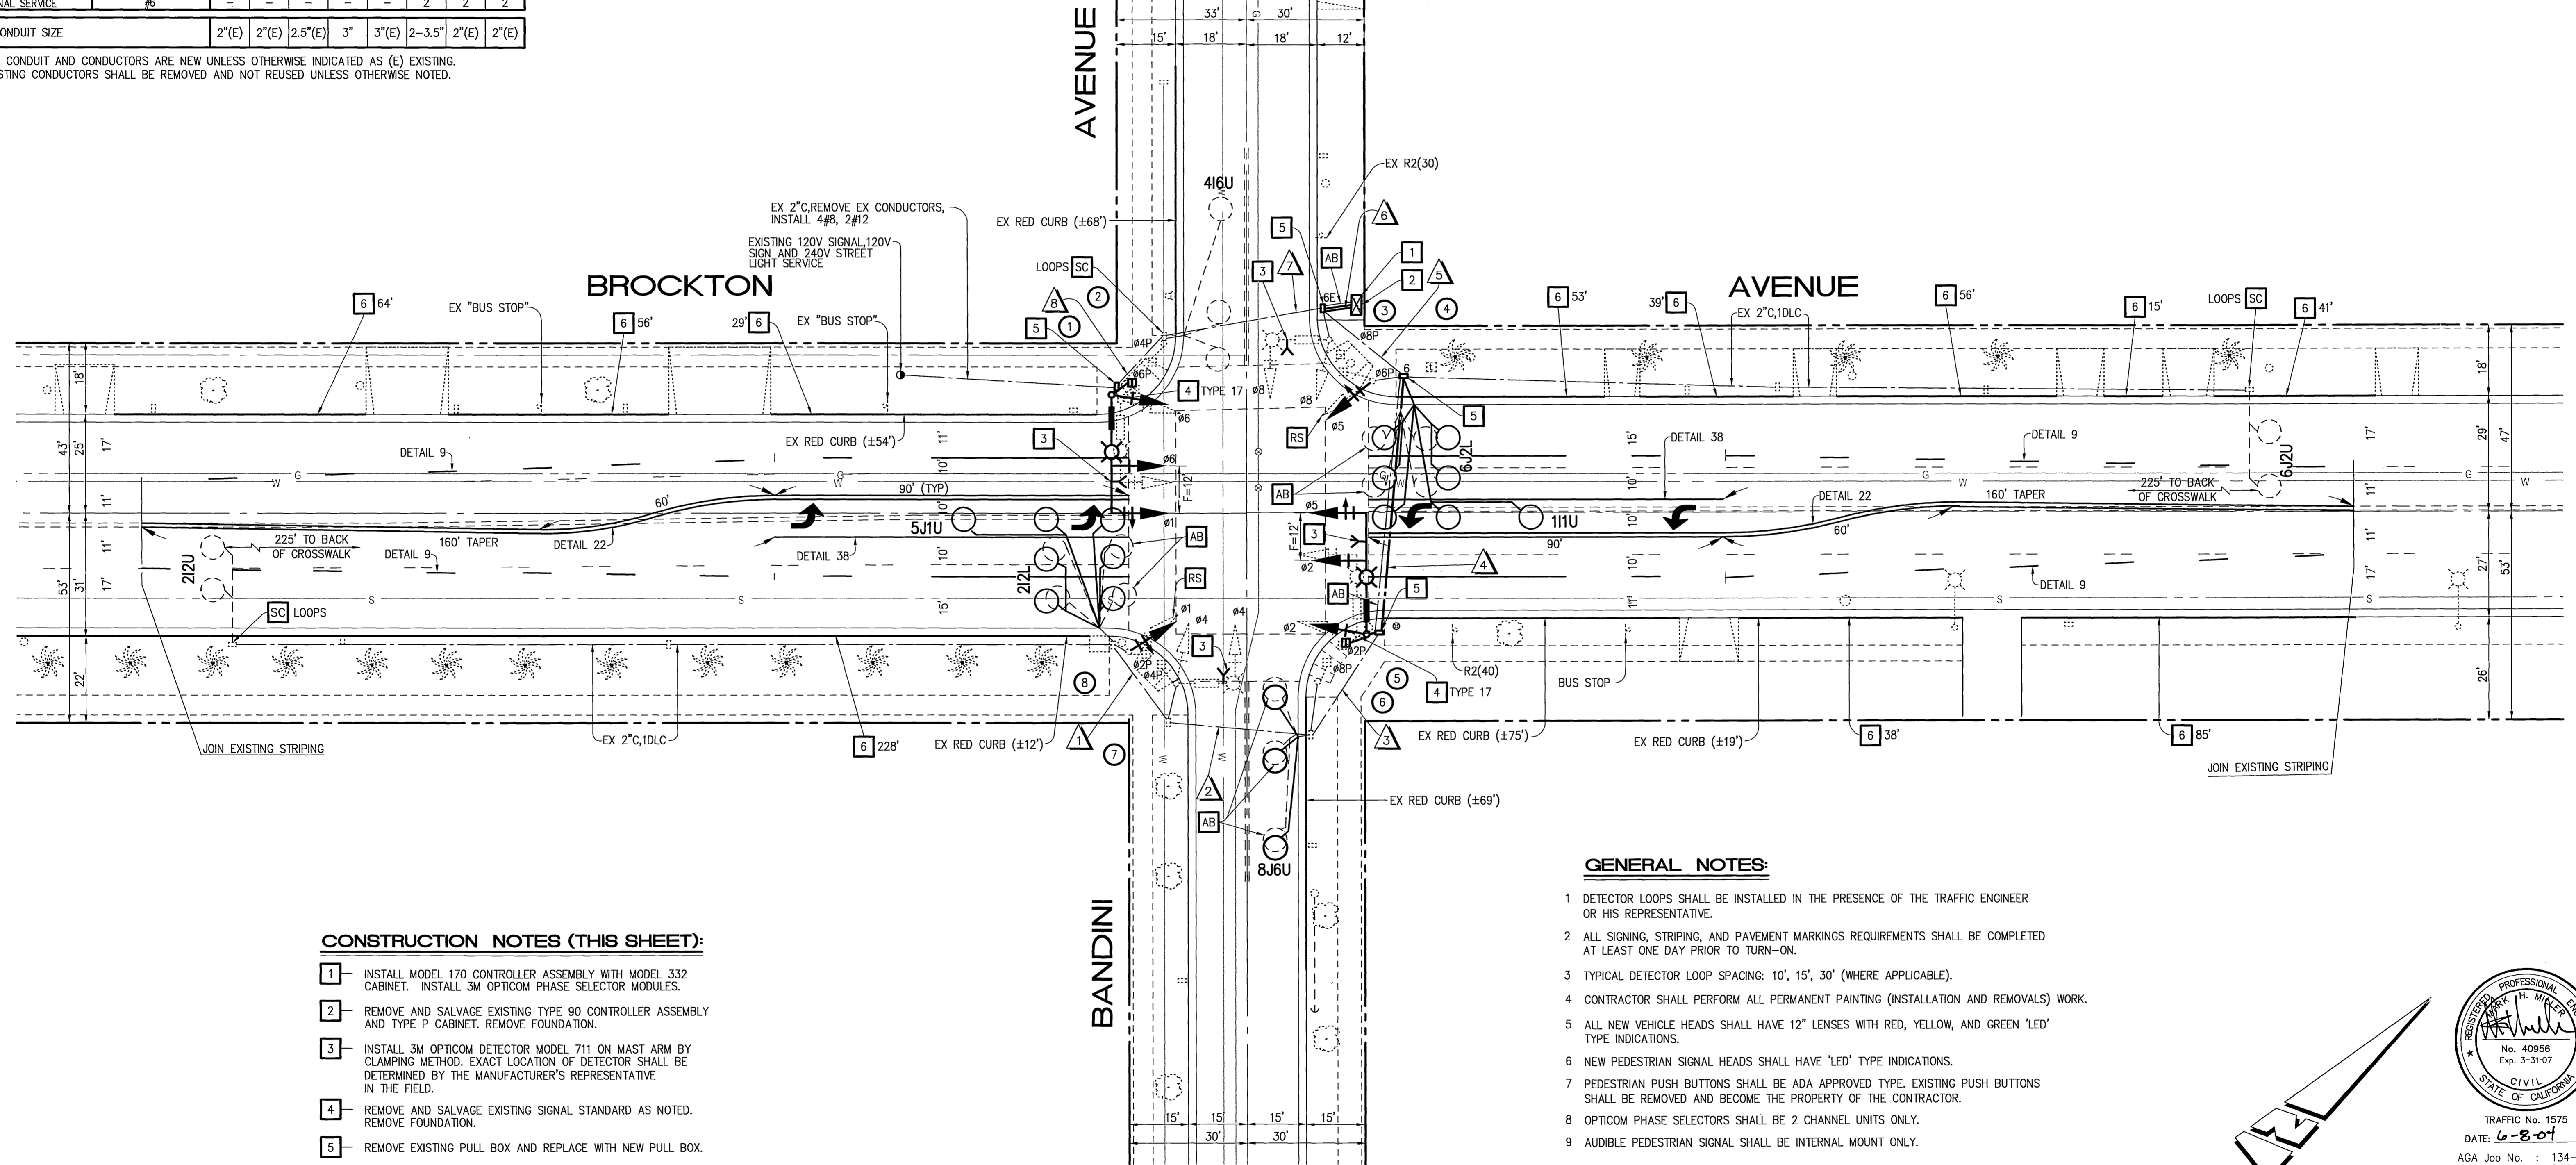

**CONSTRUCTION NOTES (THIS SHEET):**

- 1 - INSTALL MODEL 170 CONTROLLER ASSEMBLY WITH MODEL 332 CABINET. INSTALL 3M OPTICOM PHASE SELECTOR MODULES.
- 2 - REMOVE AND SALVAGE EXISTING TYPE 90 CONTROLLER ASSEMBLY AND TYPE P CABINET. REMOVE FOUNDATION.
- 3 - INSTALL 3M OPTICOM DETECTOR MODEL 711 ON MAST ARM BY CLAMPING METHOD. EXACT LOCATION OF DETECTOR SHALL BE DETERMINED BY THE MANUFACTURER'S REPRESENTATIVE IN THE FIELD.
- 4 - REMOVE AND SALVAGE EXISTING SIGNAL STANDARD AS NOTED. REMOVE FOUNDATION.
- 5 - REMOVE EXISTING PULL BOX AND REPLACE WITH NEW PULL BOX.
- 6 - PAINT RED CURB.

**GENERAL NOTES:**

- 1 DETECTOR LOOPS SHALL BE INSTALLED IN THE PRESENCE OF THE TRAFFIC ENGINEER OR HIS REPRESENTATIVE.
- 2 ALL SIGNING, STRIPING, AND PAVEMENT MARKINGS REQUIREMENTS SHALL BE COMPLETED AT LEAST ONE DAY PRIOR TO TURN-ON.
- 3 TYPICAL DETECTOR LOOP SPACING: 10', 15', 30' (WHERE APPLICABLE).
- 4 CONTRACTOR SHALL PERFORM ALL PERMANENT PAINTING (INSTALLATION AND REMOVALS) WORK.
- 5 ALL NEW VEHICLE HEADS SHALL HAVE 12" LENSES WITH RED, YELLOW, AND GREEN 'LED' TYPE INDICATIONS.
- 6 NEW PEDESTRIAN SIGNAL HEADS SHALL HAVE 'LED' TYPE INDICATIONS.
- 7 PEDESTRIAN PUSH BUTTONS SHALL BE ADA APPROVED TYPE. EXISTING PUSH BUTTONS SHALL BE REMOVED AND BECOME THE PROPERTY OF THE CONTRACTOR.
- 8 OPTICOM PHASE SELECTORS SHALL BE 2 CHANNEL UNITS ONLY.
- 9 AUDIBLE PEDESTRIAN SIGNAL SHALL BE INTERNAL MOUNT ONLY.

TRAFFIC No. 1575  
DATE: 6-8-04  
AGA Job No. : 134-006  
AGA File Name: BROCKBAND  
Print Date : 6/8/04  
Last Revision : 6/3/04

SCALE: 1"=20'


CONTRACT TE-04-03

Underground Service Alert  
Call: TOLL FREE  
1-800-227-2600  
TWO WORKING DAYS BEFORE YOU DIG

CITY OF RIVERSIDE, CALIFORNIA DEPARTMENT OF PUBLIC WORKS		TRAFFIC SIGNAL PLAN		ACCOUNT NO.
APPROVED BY: <i>[Signature]</i> PRINCIPAL ENGINEER DATE: 6/10/04		APPROVED BY: <i>[Signature]</i> CITY ENGINEER DATE: 6/11/04		X-157A
MARK REVISIONS APPR. DATE		HORIZ. SCALE: 1" = 20' VERT. SCALE: 1" = -		SHEET 2 OF 9
DESIGNED BY: JAT DRAWN BY: TRB/DMS CHECKED BY: JAT		ALBERT GROVER & ASSOCIATES TRANSPORTATION CONSULTING ENGINEERS 211 E. Imperial Hwy., Suite 208 Fullerton, CA 92835 (714) 992-2990 FAX 992-2883		

**CONDUCTOR SCHEDULE**


AWC	CIRCUIT	RUNS							
		1	2	3	4	5	6	7	8
	Ø2	-	-	3	3	3	-	-	-
	Ø4	3	3	3	3	3	-	-	-
	Ø6	3	3	3	3	3	6	3	3
	Ø8	-	-	-	-	3	-	-	-
# 14	Ø2 PED	2	2	2	2	2	-	-	-
	Ø4 PED	2	2	2	2	4	2	-	-
	Ø6 PED	-	-	-	2	4	2	2	-
	Ø8 PED	-	2	2	2	4	-	-	-
	Ø2 PPB	1	1	1	1	1	-	-	-
	Ø4 PPB	1	1	1	1	2	1	1	-
Ø6 PPB	-	-	-	-	2	1	-	-	
Ø8 PPB	-	-	1	1	1	-	-	-	
	PPB COMMON	1	1	1	1	2	1	1	-
	SPARES	3	3	3	3	6	3	3	-
	TOTAL	10	16	18	22	24	43	13	10
TYPE C DLC	Ø2 DETECTOR	2	2	2	2	2	-	-	-
	Ø4 DETECTOR	-	-	-	-	1	1	-	-
	Ø6 DETECTOR	-	-	-	2	2	-	-	-
	Ø8 DETECTOR	-	1	1	1	1	-	-	-
	TOTAL	2	2	3	3	5	6	1	-
#12	I.I.S.N.S.	2	2	2	2	-	2	2	-
#10	SIGNAL COMMON	1	1	1	1	1	2	1	1
# 8	LUMINAIRE	2	2	2	2	-	2	2	-
	SIGNAL SERVICE	-	-	-	-	2	2	2	-
	TOTAL	2	2	2	2	2	4	4	-
CONDUIT SIZE		2"	2"	2 1/2"	2 1/2"	3"	2-3"	2"	2"

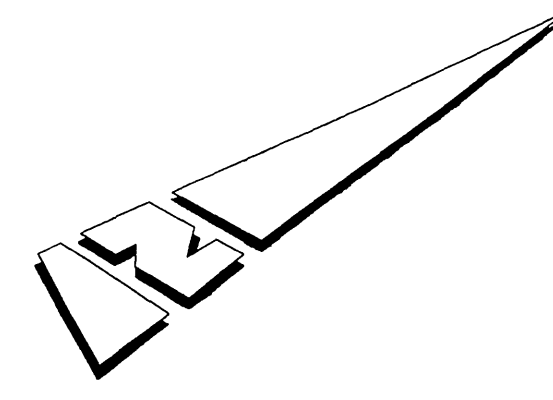


**RISER DETAIL**  
PP-32256J Traffic Signal Service

No.	TYPE	STANDARD			LUMINAIRE HPS	I.I.S.N.S. LEGEND	SIGNAL MOUNTING		PPB PHASE	PLACEMENT		REMARKS
		HGT.	SIG.	M.A.LUM. M.A.			VEHICLE	PED		A	B	
(A)	17-2-80	30'	20'	12'	200W	Bandini Ave 4100	MAS	-	SV-1-T	SP-1-T	Ø4 11' 2.5'	
(B)	1-A	7'	-	-	-	-	-	-	-	TP-1-T	Ø6 5.5' 2.5'	
(C)	17-2-80	30'	15'	12'	200W	Brockton Ave 5300	MAS	-	SV-1-T	SP-1-T	Ø6 2.5' 2.5'	
(D)	1-A	10'	-	-	-	-	-	-	TV-1-T	SP-1-T	Ø8 5' 2.5'	
(E)	17-2-80	30'	20'	12'	200W	Bandini Ave 4000	MAS	-	SV-1-T	SP-1-T	Ø8 7' 2.5'	
(F)	1-A	7'	-	-	-	-	-	-	-	TP-1-T	Ø2 4.5' 2.5'	
(G)	17-2-80	30'	15'	12'	200W	Brockton Ave 5400	MAS	-	SV-1-T	SP-1-T	Ø2 7' 2.5'	
(H)	1-A	10'	-	-	-	-	-	-	TV-1	SP-1-T	Ø4 12' 2.5'	

I.I.S.N.S. = INTERNALLY ILLUMINATED STREET NAME SIGN

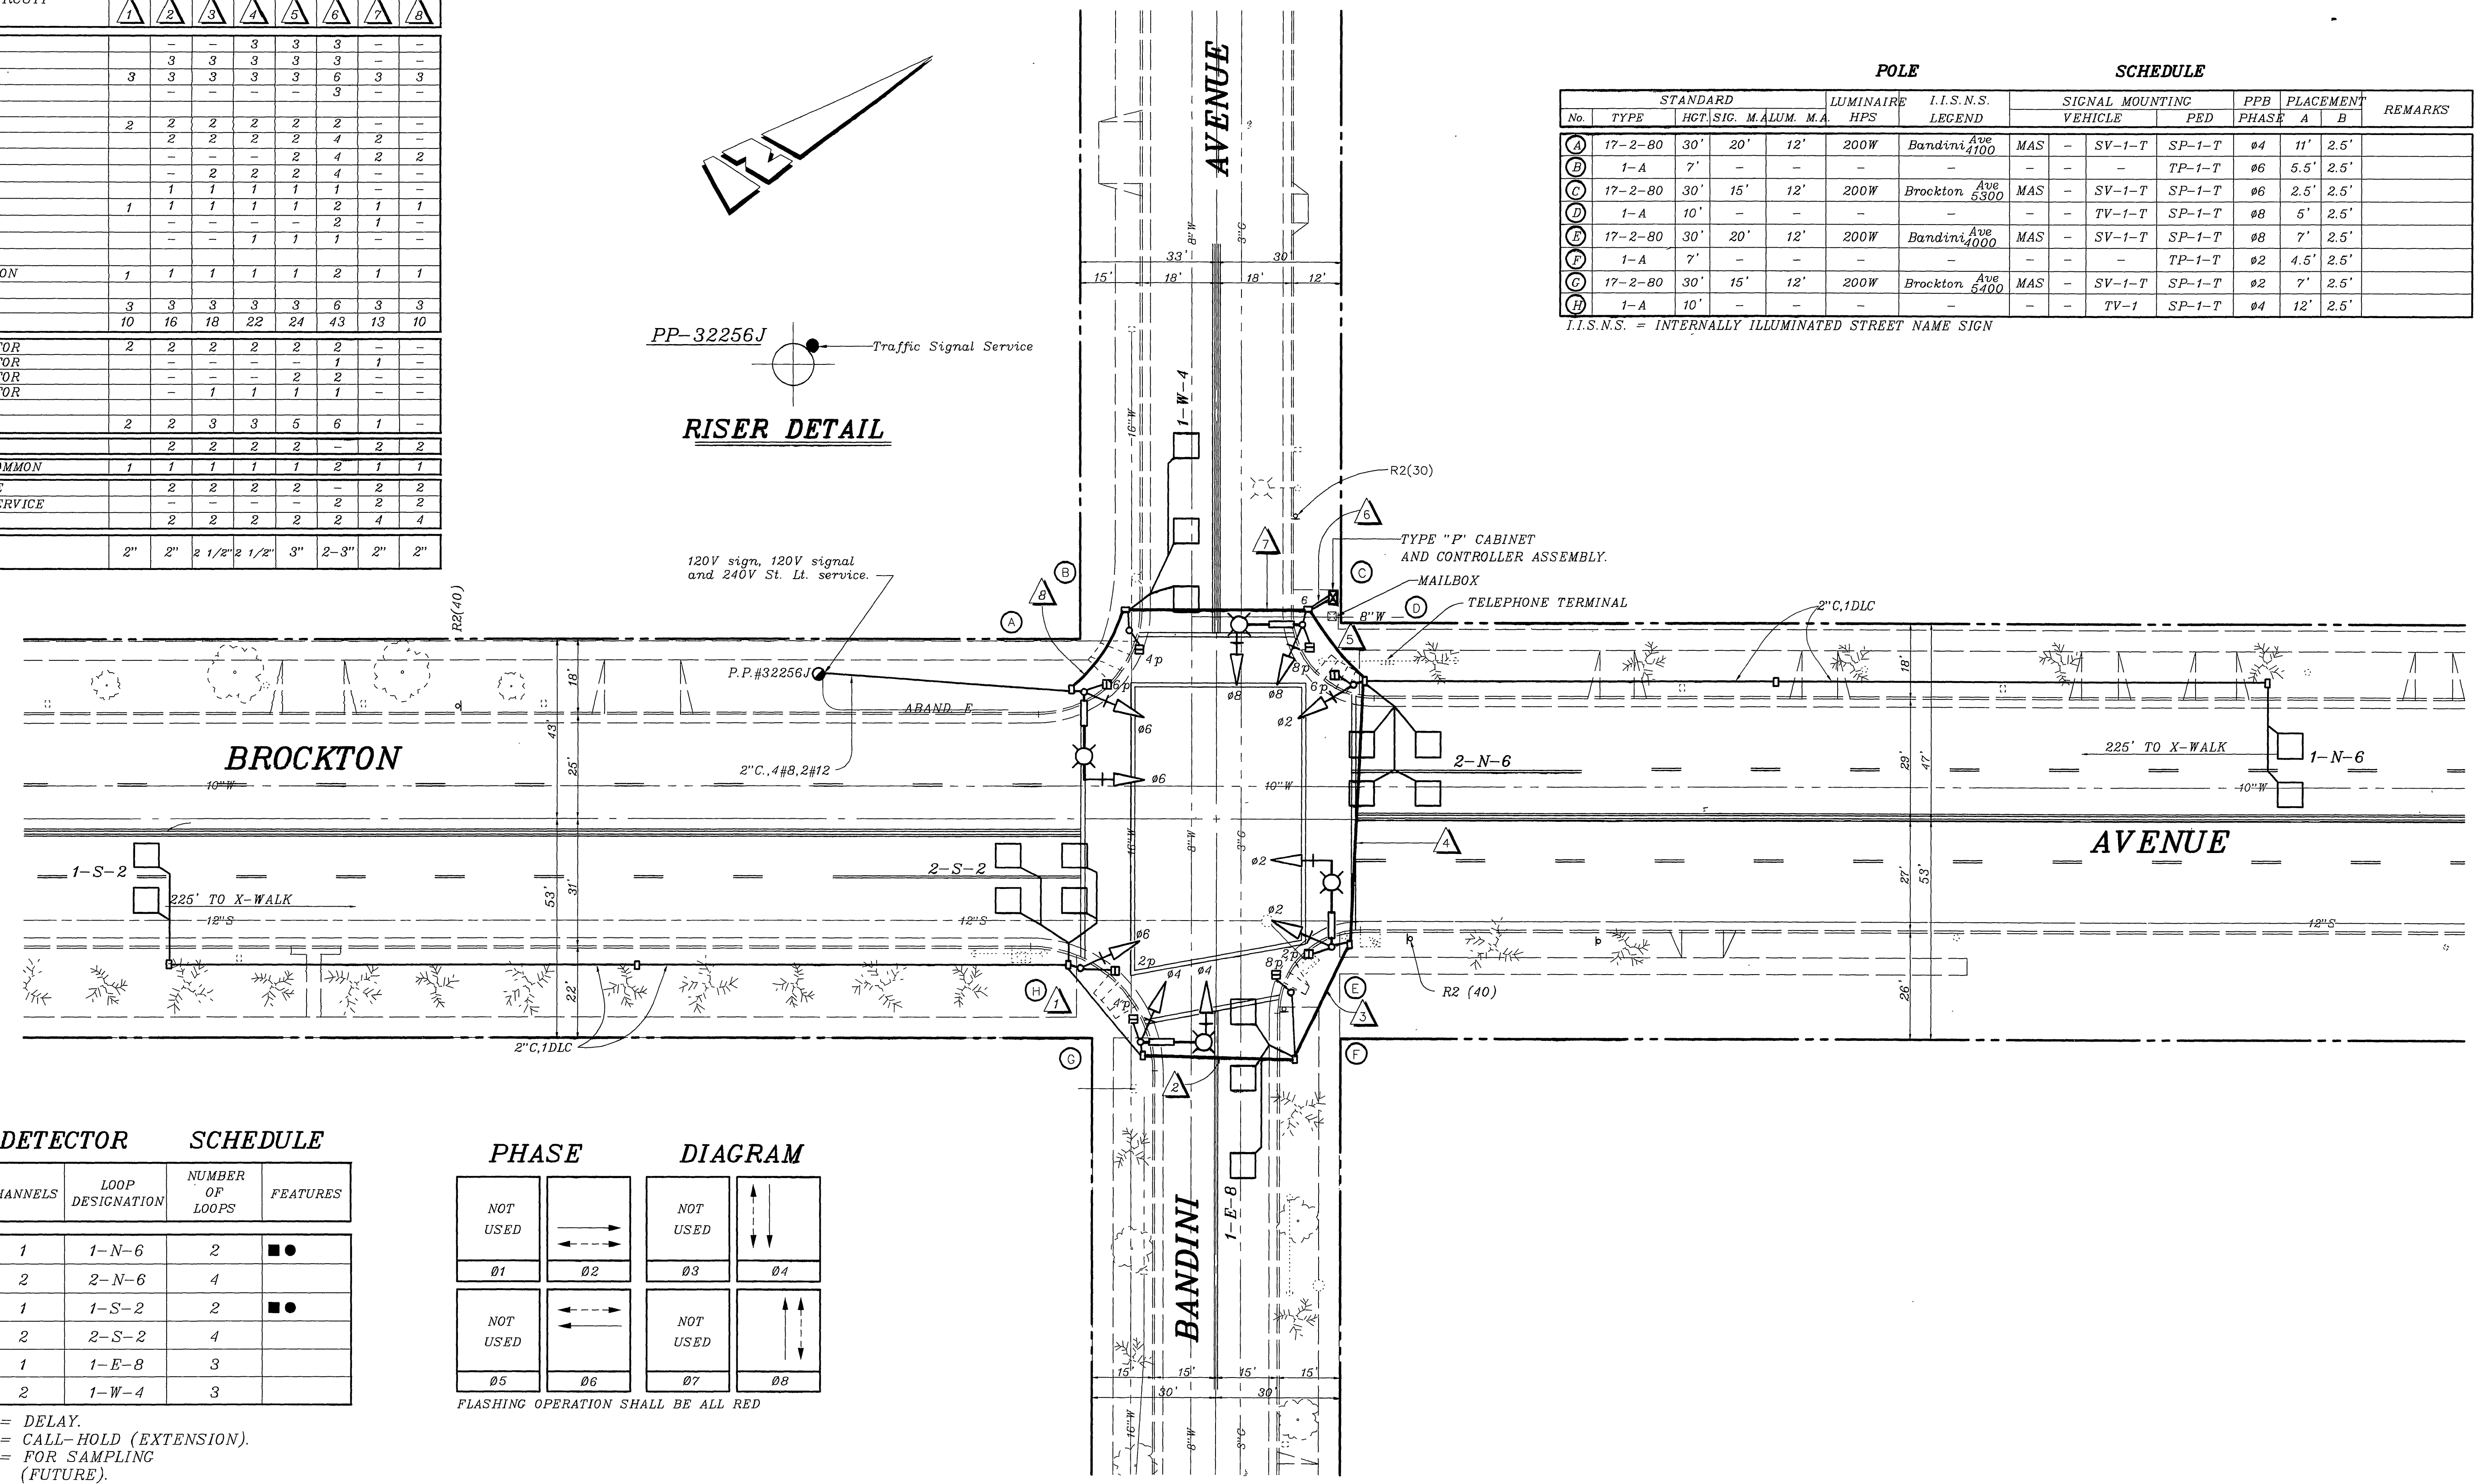

DETECTOR		SCHEDULE	
CHANNELS	LOOP DESIGNATION	NUMBER OF LOOPS	FEATURES
1	1-N-6	2	■ ●
2	2-N-6	4	
1	1-S-2	2	■ ●
2	2-S-2	4	
1	1-E-8	3	
2	1-W-4	3	

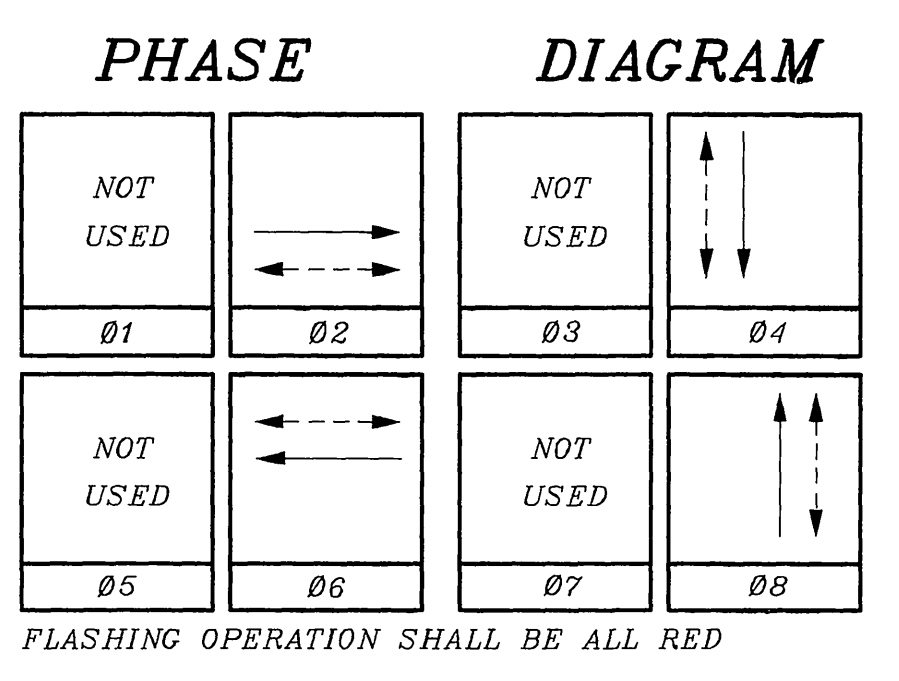


- ▲ = DELAY.
- = CALL-HOLD (EXTENSION).
- = FOR SAMPLING (FUTURE).

CITY OF RIVERSIDE, CALIFORNIA DEPARTMENT OF PUBLIC WORKS				TRAFFIC SIGNAL		ACCT. NO.
APPROVED BY _____ BY _____ DATE _____				APPROVED BY _____		BROCKTON AVE. & BANDINI AVE.
AS-BUILT PER SIGNALIZATION MAC/2/12				DIRECTOR OF PUBLIC WORKS		
MARK	REVISIONS	APPL. DATE	DATE	DATE	DATE	SHEET 1 OF 1
DESIGNED BY _____	DRAWN BY _____	CHECKED BY _____				
				HORIZ. SCALE: 1" = 20'		FILE NO.


**CONDUCTOR SCHEDULE**

AWC	CIRCUIT	RUNS							
		1	2	3	4	5	6	7	8
# 14	Ø2	-	-	3	3	3	-	-	-
	Ø4	3	3	3	3	3	-	-	-
	Ø6	3	3	3	3	3	6	3	3
	Ø8	-	-	-	-	3	-	-	-
	Ø2 PED	2	2	2	2	2	2	-	-
	Ø4 PED	2	2	2	2	2	4	2	-
	Ø6 PED	-	-	-	2	4	2	2	-
	Ø8 PED	-	2	2	2	4	-	-	-
# 14	Ø2 PPB	1	1	1	1	1	1	-	-
	Ø4 PPB	1	1	1	1	2	1	1	-
	Ø6 PPB	-	-	-	-	2	1	-	-
	Ø8 PPB	-	-	1	1	1	-	-	-
PPB COMMON		1	1	1	1	2	1	1	-
SPARES		3	3	3	3	6	3	3	-
TOTAL		10	16	18	22	43	13	10	-
TYPE C DLC	Ø2 DETECTOR	2	2	2	2	2	-	-	-
	Ø4 DETECTOR	-	-	-	-	1	1	-	-
	Ø6 DETECTOR	-	-	-	2	2	-	-	-
	Ø8 DETECTOR	-	1	1	1	1	-	-	-
TOTAL		2	2	3	3	5	6	1	-
#12	I.I.S.N.S.	2	2	2	2	-	2	2	-
#10	SIGNAL COMMON	1	1	1	1	1	2	1	1
# 8	LUMINAIRE	2	2	2	2	-	2	2	-
	SIGNAL SERVICE	-	-	-	-	2	2	2	-
TOTAL		2	2	2	2	2	4	4	-
CONDUIT SIZE		2"	2"	2 1/2"	2 1/2"	3"	2-3"	2"	2"

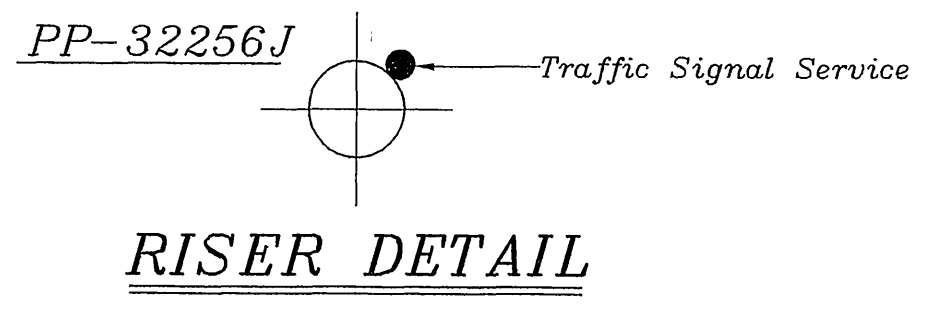


No.	TYPE	STANDARD			LUMINAIRE HPS	I.I.S.N.S. LEGEND	SIGNAL MOUNTING		PPB PHASE	PLACEMENT		REMARKS		
		HGT.	SIG.	M.A.LUM. M.A.			VEHICLE	PED		A	B			
(A)	17-2-80	30'	20'	12'	200W	Bandini Ave 4100	MAS	-	SV-1-T	SP-1-T	Ø4	11'	2.5'	
(B)	1-A	7'	-	-	-	-	-	-	-	TP-1-T	Ø6	5.5'	2.5'	
(C)	17-2-80	30'	15'	12'	200W	Brockton Ave 5300	MAS	-	SV-1-T	SP-1-T	Ø6	2.5'	2.5'	
(D)	1-A	10'	-	-	-	-	-	-	TV-1-T	SP-1-T	Ø8	5'	2.5'	
(E)	17-2-80	30'	20'	12'	200W	Bandini Ave 4000	MAS	-	SV-1-T	SP-1-T	Ø8	7'	2.5'	
(F)	1-A	7'	-	-	-	-	-	-	-	TP-1-T	Ø2	4.5'	2.5'	
(G)	17-2-80	30'	15'	12'	200W	Brockton Ave 5400	MAS	-	SV-1-T	SP-1-T	Ø2	7'	2.5'	
(H)	1-A	10'	-	-	-	-	-	-	TV-1	SP-1-T	Ø4	12'	2.5'	

I.I.S.N.S. = INTERNALLY ILLUMINATED STREET NAME SIGN

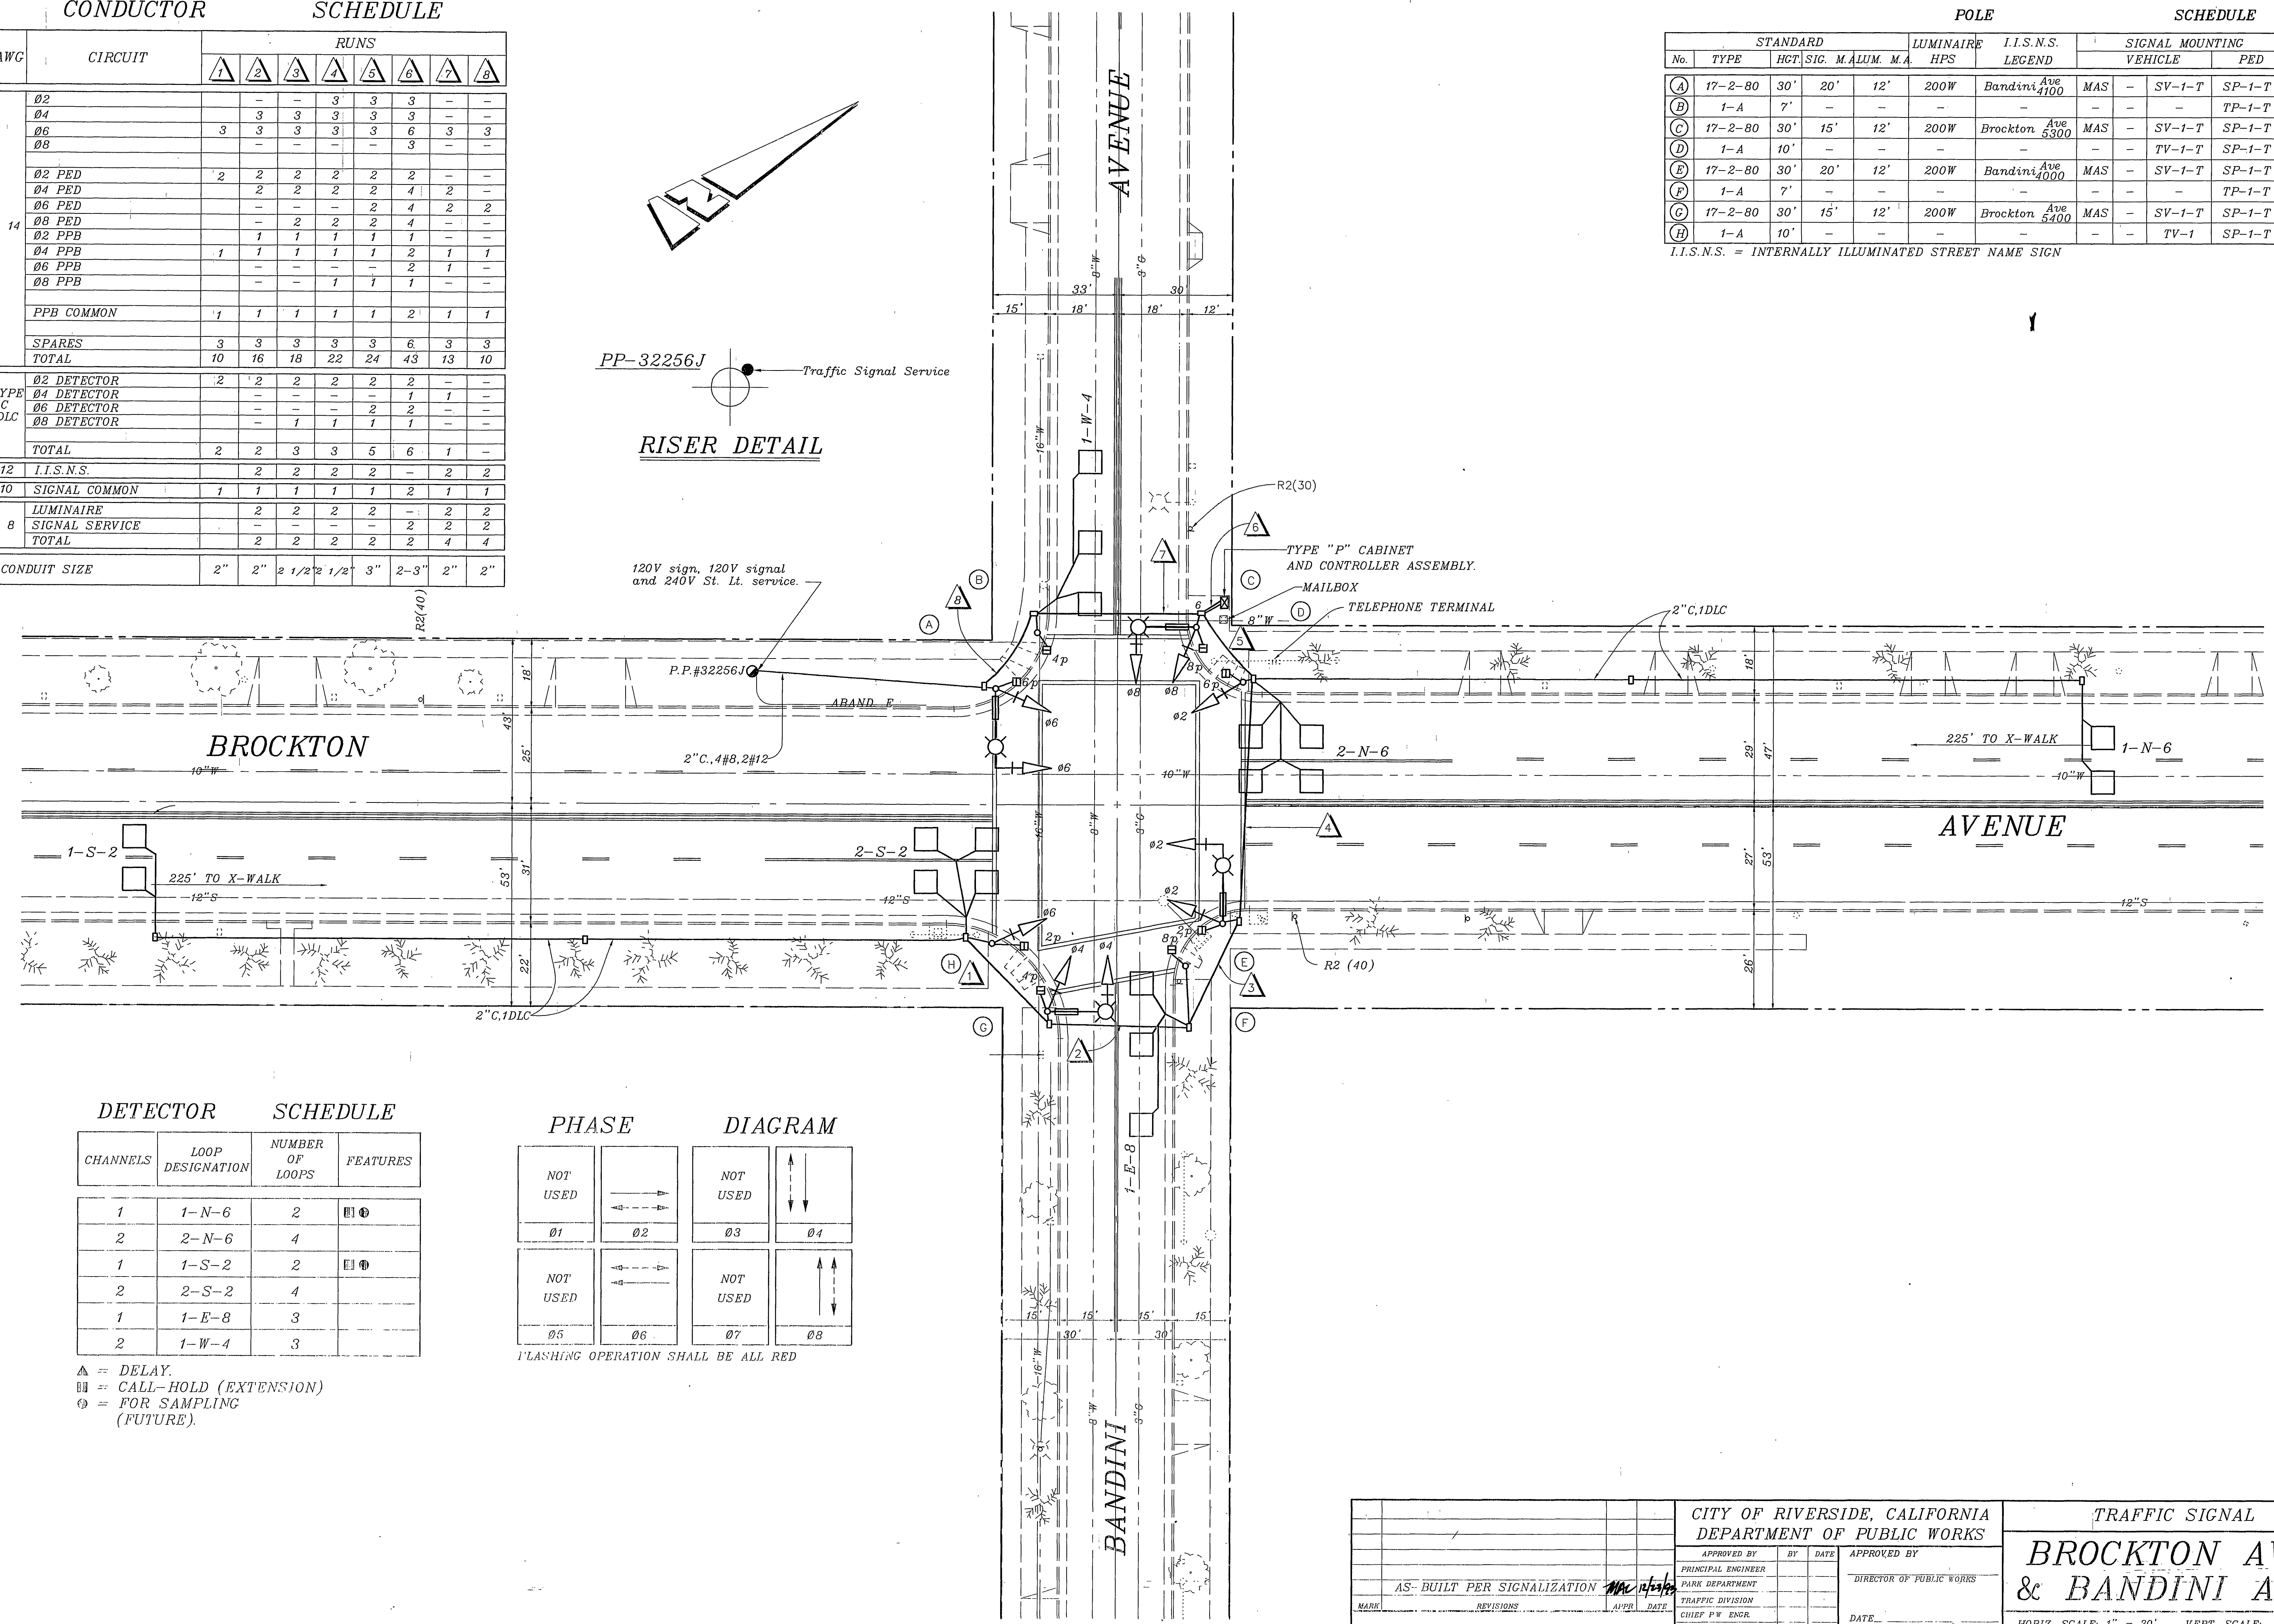

**DETECTOR SCHEDULE**

CHANNELS	LOOP DESIGNATION	NUMBER OF LOOPS	FEATURES
1	1-N-6	2	□ □
2	2-N-6	4	□ □ □ □
1	1-S-2	2	□ □
2	2-S-2	4	□ □ □ □
1	1-E-8	3	□ □ □
2	1-W-4	3	□ □ □

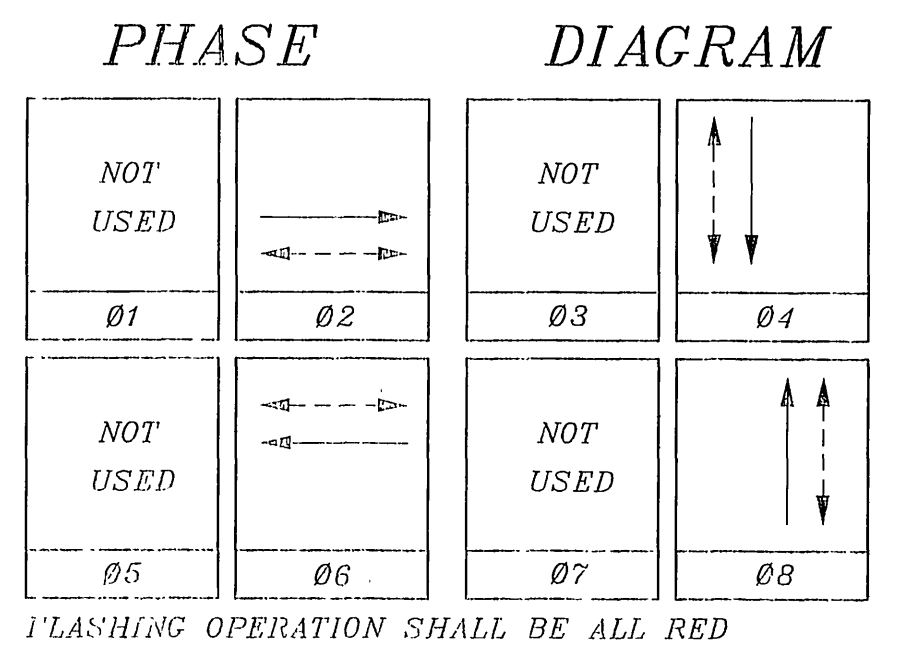

- △ = DELAY.
- = CALL-HOLD (EXTENSION)
- ⊙ = FOR SAMPLING (FUTURE).

CITY OF RIVERSIDE, CALIFORNIA DEPARTMENT OF PUBLIC WORKS				TRAFFIC SIGNAL		ACCT. NO.
APPROVED BY		BY	DATE	APPROVED BY		X-157
PRINCIPAL ENGINEER				DIRECTOR OF PUBLIC WORKS		
AS-BUILT PER SIGNALIZATION		[Signature]		DATE		SHEET 1 OF 1
DESIGNED BY	DRAWN BY	CHECKED BY		DATE		FILE NO.