

| CONDUCTOR | | SCHEDULE | | | | | | | |
|------------------|------------|----------|---|---|---|---|---|---|---|
| CONTROL FUNCTION | CONDUCTORS | RUNS | | | | | | | |
| | | 1 | 2 | 3 | 4 | 5 | 6 | 7 | 8 |
| VEHICLE HEADS | #14 | T.W. | - | - | - | - | - | - | - |
| PHASE 2 | | | 3 | 3 | 3 | 3 | | | |
| PHASE 4 | | | 3 | 3 | 3 | 3 | 3 | 3 | 3 |
| PHASE 6 | | | 3 | 3 | 3 | 3 | 3 | 3 | 3 |
| PHASE 8 | | | 3 | 3 | 3 | 3 | 3 | 3 | 3 |
| PED. HEADS | | | 2 | 2 | 4 | 2 | | | |
| PHASE 2 | | | 2 | 2 | 4 | 2 | 2 | 2 | 2 |
| PHASE 4 | | | 2 | 2 | 4 | 2 | 2 | 2 | 2 |
| PHASE 6 | | | 2 | 2 | 4 | 2 | 2 | 2 | 2 |
| PHASE 8 | | | 2 | 2 | 4 | 2 | 2 | 2 | 2 |
| PED. PUSH BUTTON | | | | | | | | | |
| PHASE 2 | | | 1 | 1 | 2 | | | | |
| PHASE 4 | | | 1 | 1 | 2 | 1 | 1 | 1 | 1 |
| PHASE 6 | | | 1 | 1 | 2 | 1 | 1 | 1 | 1 |
| PHASE 8 | | | 1 | 1 | 2 | 1 | 1 | 1 | 1 |
| SPARES | | | 3 | 3 | 6 | 3 | 3 | 3 | 3 |
| 12V COMMON | | | 1 | 1 | 2 | 1 | 1 | 1 | 1 |

| DETECTOR SCHEDULE | | | |
|-------------------|------------------|-----------------|----------|
| CHANNELS | LOOP DESIGNATION | NUMBER OF LOOPS | FEATURES |
| 1 | 1-W-2 | 2 | ● ■ |
| 2 | 2-W-2 | 4 | ▲ |
| 1 | 3-W-2 | 3 | |
| 2 | 1-N-4 | 3 | |
| 1 | 1-E-6 | 2 | ● ■ |
| 2 | 2-E-6 | 4 | ▲ |
| 1 | 3-E-6 | 3 | |
| 2 | 1-S-8 | 3 | |


- Sampling (future)
 - Call-hold (extension)
 - ▲ Detector disconnect (see Special Provisions)
1. Detectors shall be 2-channel rack-mounted.
 2. Detector timing features shall be accomplished thru internal logic of the controller.
 3. Detector loops with special features shall also detect for normal operation.

| DETECTORS | | #12/2 | P.E. | | | | | | | | |
|-----------|--|-------|------|---|---|---|---|---|---|---|--|
| PHASE 2 | | | | 3 | 3 | 3 | | | | | |
| PHASE 4 | | | | 1 | 1 | 1 | 1 | 1 | 1 | 1 | |
| PHASE 6 | | | | 3 | 3 | 3 | | | | | |
| PHASE 8 | | | | 1 | | | | | | | |

| I.S.N.S. | | #12 | T.W. | 2 | 2 | 2 | 2 | 2 | 2 |
|---------------------|-------|--------|------|---|---|---|---|---|---|
| 120V COMMON | #10 | T.W. | 1 | 1 | 2 | 1 | 1 | 1 | 1 |
| LUMINAIRES | #8 | T.H.W. | 2 | 2 | 2 | 2 | 2 | 2 | 2 |
| SIGNAL SERVICE | #6 | T.H.W. | 2 | | | | | | |
| INTERCONNECT (fut.) | #19/2 | P.E. | | 1 | | | | | |

| TOTAL | | #14 | T.W. | 10 | 16 | 41 | 24 | 22 | 18 | 13 | 10 |
|-------------------------|--------|-----|--------|----|----|--------|----|----|----|----|----|
| #12 | T.W. | 2 | 2 | 2 | 2 | 2 | 2 | 2 | 2 | 2 | 2 |
| #10 | T.W. | 1 | 1 | 2 | 1 | 1 | 1 | 1 | 1 | 1 | 1 |
| #8 | T.H.W. | 2 | 2 | 2 | 2 | 2 | 2 | 2 | 2 | 2 | 2 |
| #6 | T.H.W. | 3 | 3 | 8 | 4 | 4 | 1 | 1 | | | |
| #19/2 | P.E. | | | | | | | | | | |
| #19/2 | P.E. | | | | | | | | | | |
| #14 EQUIV. CONDUIT SIZE | | 21 | 34 | 65 | 45 | 43 | 30 | 25 | 19 | | |
| | | 2" | 2 1/2" | 3" | 3" | 2 1/2" | 2" | 2" | 2" | | |

Interconnect = 3 pairs of #19/2 (FUTURE)

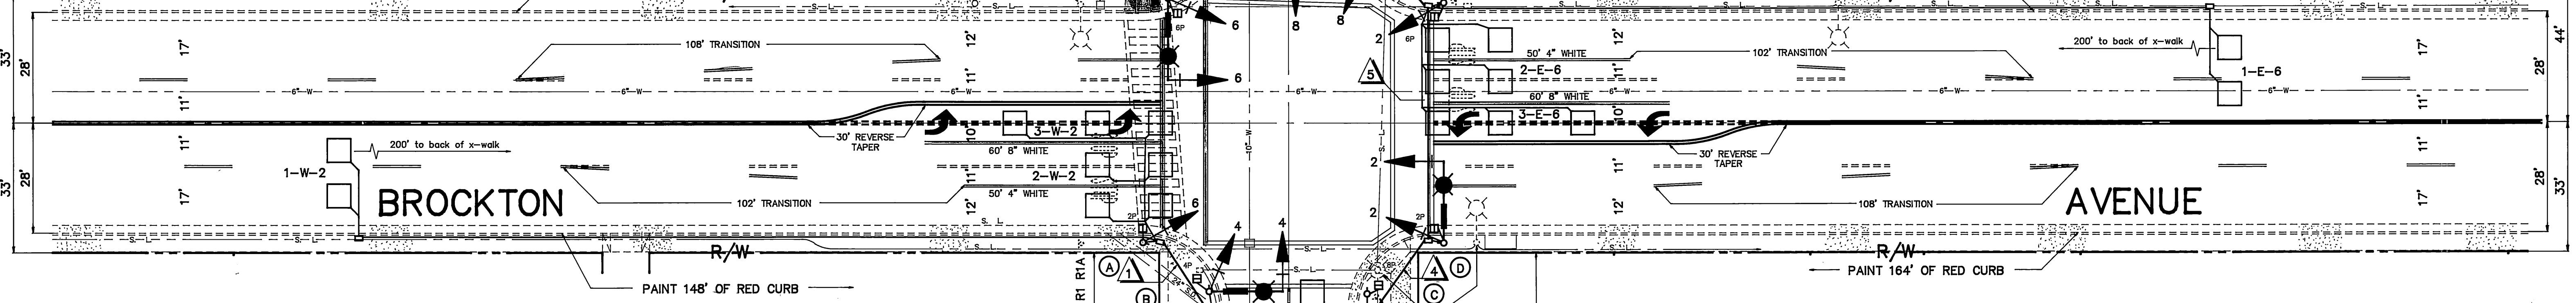

| POLE | | SCHEDULE | | | | | | | | |
|------|---------|----------|-----------|-----------|-----------------|--------------------|-----------------|--------|-----------|---------|
| No. | TYPE | STANDARD | | LUM. HPSV | I.S.N.S. LEGEND | SIGNAL HEAD | SIGNAL MOUNTING | | PPB PHASE | REMARKS |
| | | HGT. | SIG. M.A. | | | | VEHICLE | PED | | |
| (A) | 1-A | 10' | | | | 1W3C | TV-1 | SP-1-T | 4 | |
| (B) | 17-2-80 | 30' | 18' | 10' | 200w | BROCKTON AVE. 4000 | 1W3C | MAS | | |
| | | | | | | | 1W3C | SV-1-T | SP-1-T | 2 |
| (C) | 1-A | 7' | | | | | | TP-1-T | 2 | |
| (D) | 17-2-80 | 30' | 20' | 10' | 250w | TENTH ST. 4000 | 1W3C | MAS | | |
| | | | | | | | 1W3C | SV-1-T | SP-1-T | 8 |
| (E) | 1-A | 10' | | | | | 1W3C | TV-1-T | SP-1-T | 8 |
| (F) | 17-2-80 | 30' | 18' | 10' | 200w | BROCKTON AVE. 3800 | 1W3C | MAS | | |
| | | | | | | | 1W3C | SV-1-T | SP-1-T | 6 |
| (G) | 1-A | 7' | | | | | | TP-1-T | 6 | |
| (H) | 17-2-80 | 30' | 20' | 10' | 250w | TENTH ST. 4100 | 1W3C | MAS | | |
| | | | | | | | 1W3C | SV-1-T | SP-1-T | 4 |


- NOTE:
1. All vehicular heads shall have 12" lenses.
 2. Luminares shall be High Pressure Sodium Vapor.
 3. 1A standards shall be aluminum.

STRIPING LEGEND


- Indicates striping and pavement markings to be installed.
- Indicates striping and pavement markings to remain.
- Indicates striping and pavement markings to be removed.

STRIPING QUANTITIES

- Removals:**
- 245' L.F. 4" White
 - 180' L.F. 4" Double Yellow
 - 510 S.F. Pavement Markings
- Installations:**
- 250' L.F. 4" White
 - 120' L.F. 8" White
 - 180' L.F. 4" Double Yellow
 - 140 S.F. Pavement Markings
 - 627' L.F. Red Curb

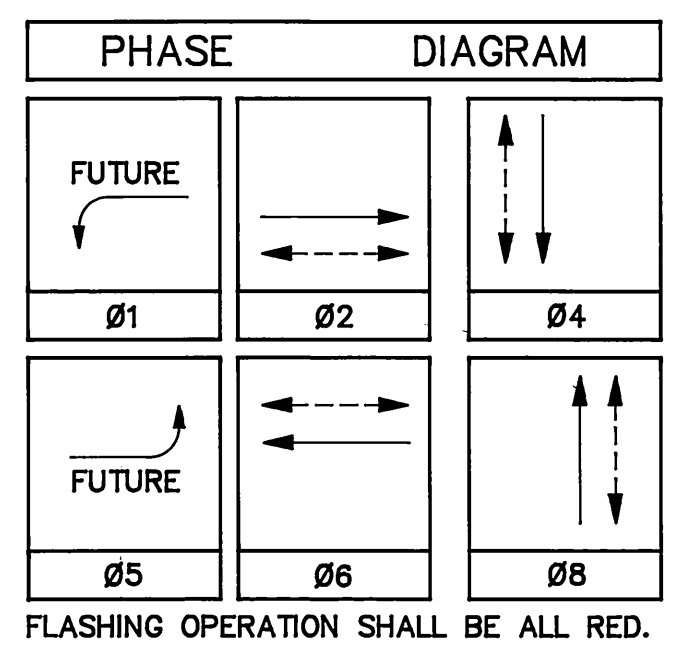

FUTURE INTERCONNECT (NOT PART OF THIS PROJECT)

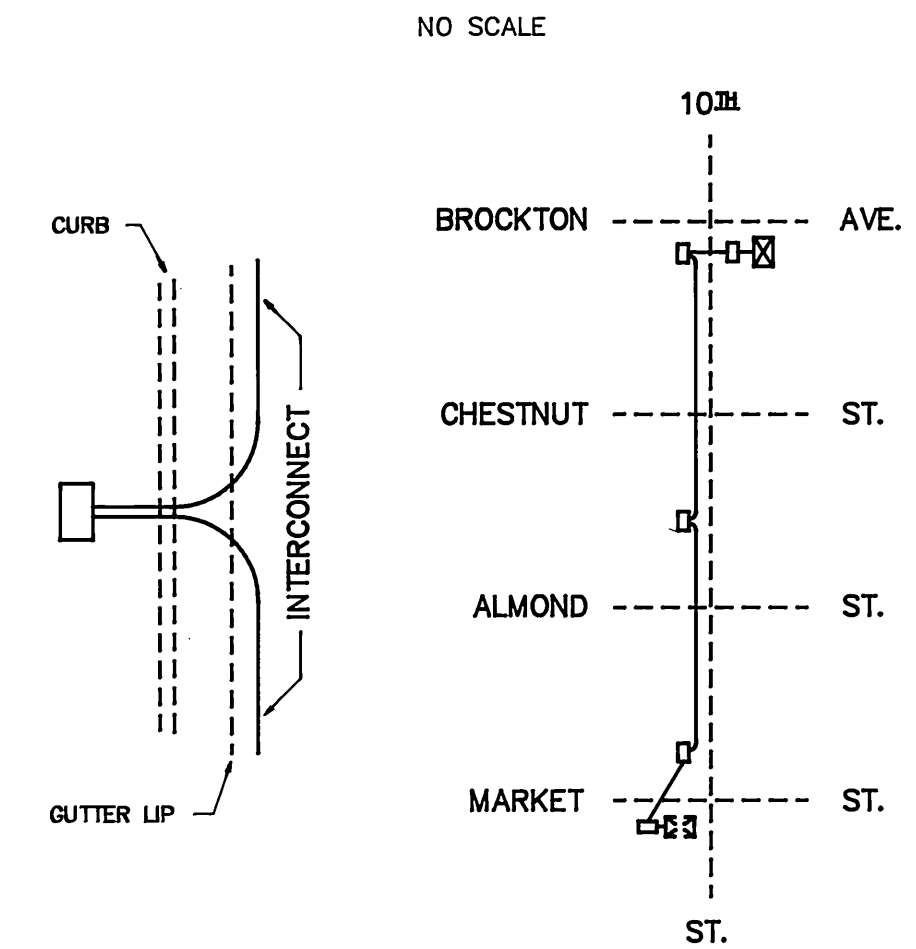

CONSTRUCTION NOTES

1. Detector loops shall be installed in the presence of the Traffic Engineer or his representative.
 2. All signing, striping, and pavement marking requirements shall be completed at least one day prior to turn-on.
 3. Lawn sprinklers exist on all four corners. Protect in place.
 4. At PP-14451J install 120V sign, 120V signal and 240V street light service per Standard Drawing #612.
 5. Install controller unit housed in type M cabinet.
- (304) Construct wheelchair ramp per C/R Standard Drawing #304.
 - (325) Remove existing wheelchair ramp and construct PCC sidewalk per C/R Standard Drawing #325.

RISER DETAIL PP-14451J

| | | | | |
|---|--|--|--|---|
| ENGINEER IN RESPONSIBLE CHARGE BARRY BECK R.C.E. No. 20900 expires 9/30/93 DATE 5/29/90 | | CITY OF RIVERSIDE, CALIFORNIA DEPARTMENT OF PUBLIC WORKS | | TRAFFIC SIGNALS BROCKTON AVE. AND TENTH ST. PROJECT NO. 30-576-380-15 X-159 SHEET 1 OF 1 FILE NO. |
| | | APPROVED BY: PRINCIPAL ENGINEER P.W. INSPECTION: TRAFFIC DIVISION CHIEF P.W. ENGR. DATE 5/29/90 PUBLIC UTILITIES: | APPROVED BY: DIRECTOR OF PUBLIC WORKS | |

CONTRACT TE-90-4

CONDUCTOR SCHEDULE

| CONTROL FUNCTION | CONDUCTORS | | RUNS | | | | | | | |
|------------------|------------|------------|------|---|---|---|---|---|---|---|
| | SIZE | INSULATION | 1 | 2 | 3 | 4 | 5 | 6 | 7 | 8 |
| VEHICLE HEADS | #14 | T.W. | - | - | - | - | - | - | - | - |
| PHASE 2 | | | | | 3 | 3 | | | | |
| PHASE 4 | | | | | 3 | 3 | | | | |
| PHASE 6 | | | 3 | 3 | 6 | 3 | 3 | 3 | 3 | 3 |
| PHASE 8 | | | 3 | 3 | 3 | 3 | | | | |
| PED. HEADS | | | | | | | | | | |
| PHASE 2 | | | 2 | 2 | 4 | 2 | | | | |
| PHASE 4 | | | 2 | 2 | 4 | 2 | 2 | 2 | 2 | 2 |
| PHASE 6 | | | 2 | 2 | 2 | 2 | 2 | 2 | 2 | 2 |
| PHASE 8 | | | 2 | 2 | 2 | 2 | | | | |
| PED. PUSH BUTTON | | | | | | | | | | |
| PHASE 2 | | | 1 | 1 | 2 | 1 | 1 | 1 | 1 | 1 |
| PHASE 4 | | | 1 | 1 | 2 | 1 | 1 | 1 | 1 | 1 |
| PHASE 6 | | | 1 | 1 | 1 | 1 | 1 | 1 | 1 | 1 |
| PHASE 8 | | | 1 | 1 | 1 | 1 | | | | |
| SPARES | | | 3 | 3 | 6 | 3 | 3 | 3 | 3 | 3 |
| 12V COMMON | | | 1 | 1 | 2 | 1 | 1 | 1 | 1 | 1 |

| DETECTORS | #12/2 | P.E. | 1 | 2 | 3 | 4 | 5 | 6 | 7 | 8 |
|-----------|-------|------|---|---|---|---|---|---|---|---|
| PHASE 2 | | | 3 | 3 | 3 | | | | | |
| PHASE 4 | | | 1 | 1 | 1 | 1 | 1 | 1 | 1 | 1 |
| PHASE 6 | | | 3 | 3 | 3 | | | | | |
| PHASE 8 | | | 1 | 1 | 1 | | | | | |

| I.S.N.S. | #12 | T.W. | 2 | 2 | 2 | 2 | 2 | 2 | 2 | 2 |
|-------------------|-------|--------|---|---|---|---|---|---|---|---|
| 120V COMMON | #10 | T.W. | 1 | 1 | 2 | 1 | 1 | 1 | 1 | 1 |
| LUMINAIRES | #8 | T.H.W. | 2 | 2 | 2 | 2 | 2 | 2 | 2 | 2 |
| SIGNAL SERVICE | #6 | T.H.W. | 2 | | | | | | | |
| INTERCONNECT fut. | #19/2 | P.E. | 1 | | | | | | | |



| TOTAL | #14 | T.W. | 10 | 16 | 41 | 24 | 22 | 18 | 13 | 10 |
|-------|-------|--------|----|----|----|----|----|----|----|----|
| | #12 | T.W. | 2 | 2 | 2 | 2 | 2 | 2 | 2 | 2 |
| | #10 | T.W. | 1 | 1 | 2 | 1 | 1 | 1 | 1 | 1 |
| | #8 | T.H.W. | 2 | 2 | 2 | 2 | 2 | 2 | 2 | 2 |
| | #6 | T.H.W. | 3 | 3 | 8 | 4 | 4 | 1 | 1 | 1 |
| | #12/2 | P.E. | 3 | 3 | 8 | 4 | 4 | 1 | 1 | 1 |
| | #10/2 | P.E. | 2 | 2 | 4 | 2 | 2 | 2 | 2 | 2 |

| #14 EQUIV. | CONDUIT SIZE | 21 | 34 | 65 | 45 | 43 | 30 | 25 | 19 |
|------------|--------------|----|--------|----|----|--------|----|----|----|
| | | 2" | 2 1/2" | 3" | 2" | 2 1/2" | 2" | 2" | 2" |

Interconnect = 3 pairs of #19/2 (FUTURE)

POLE SCHEDULE

| No. | TYPE | HGT. | STANDARD | | LUM. HPSV | I.S.N.S. LEGEND | SIGNAL HEAD | SIGNAL MOUNTING VEHICLE | PPB PED | PPB PHASE |
|-----|---------|------|-----------|-----------|-----------|--------------------|-------------|-------------------------|---------|-----------|
| | | | SIG. M.A. | LUM. M.A. | | | | | | |
| (A) | 1-A | 10' | | | | | 1W3C | TV-1 | SP-1-T | 4 |
| (B) | 17-2-80 | 30' | 18' | 10' | 200W | BROCKTON AVE. 4000 | 1W3C | MAS | | |
| (C) | 1-A | 7' | | | | | 1W3C | SV-1-T | SP-1-T | 2 |
| (D) | 17-2-80 | 30' | 20' | 10' | 250W | TENTH ST. 4000 | 1W3C | MAS | | |
| (E) | 1-A | 10' | | | | | 1W3C | TV-1-T | SP-1-T | 8 |
| (F) | 17-2-80 | 30' | 18' | 10' | 200W | BROCKTON AVE. 3800 | 1W3C | MAS | | |
| (G) | 1-A | 7' | | | | | 1W3C | SV-1-T | SP-1-T | 6 |
| (H) | 17-2-80 | 30' | 20' | 10' | 250W | TENTH ST. 4100 | 1W3C | MAS | | |
| | | | | | | | 1W3C | SV-1-T | SP-1-T | 4 |

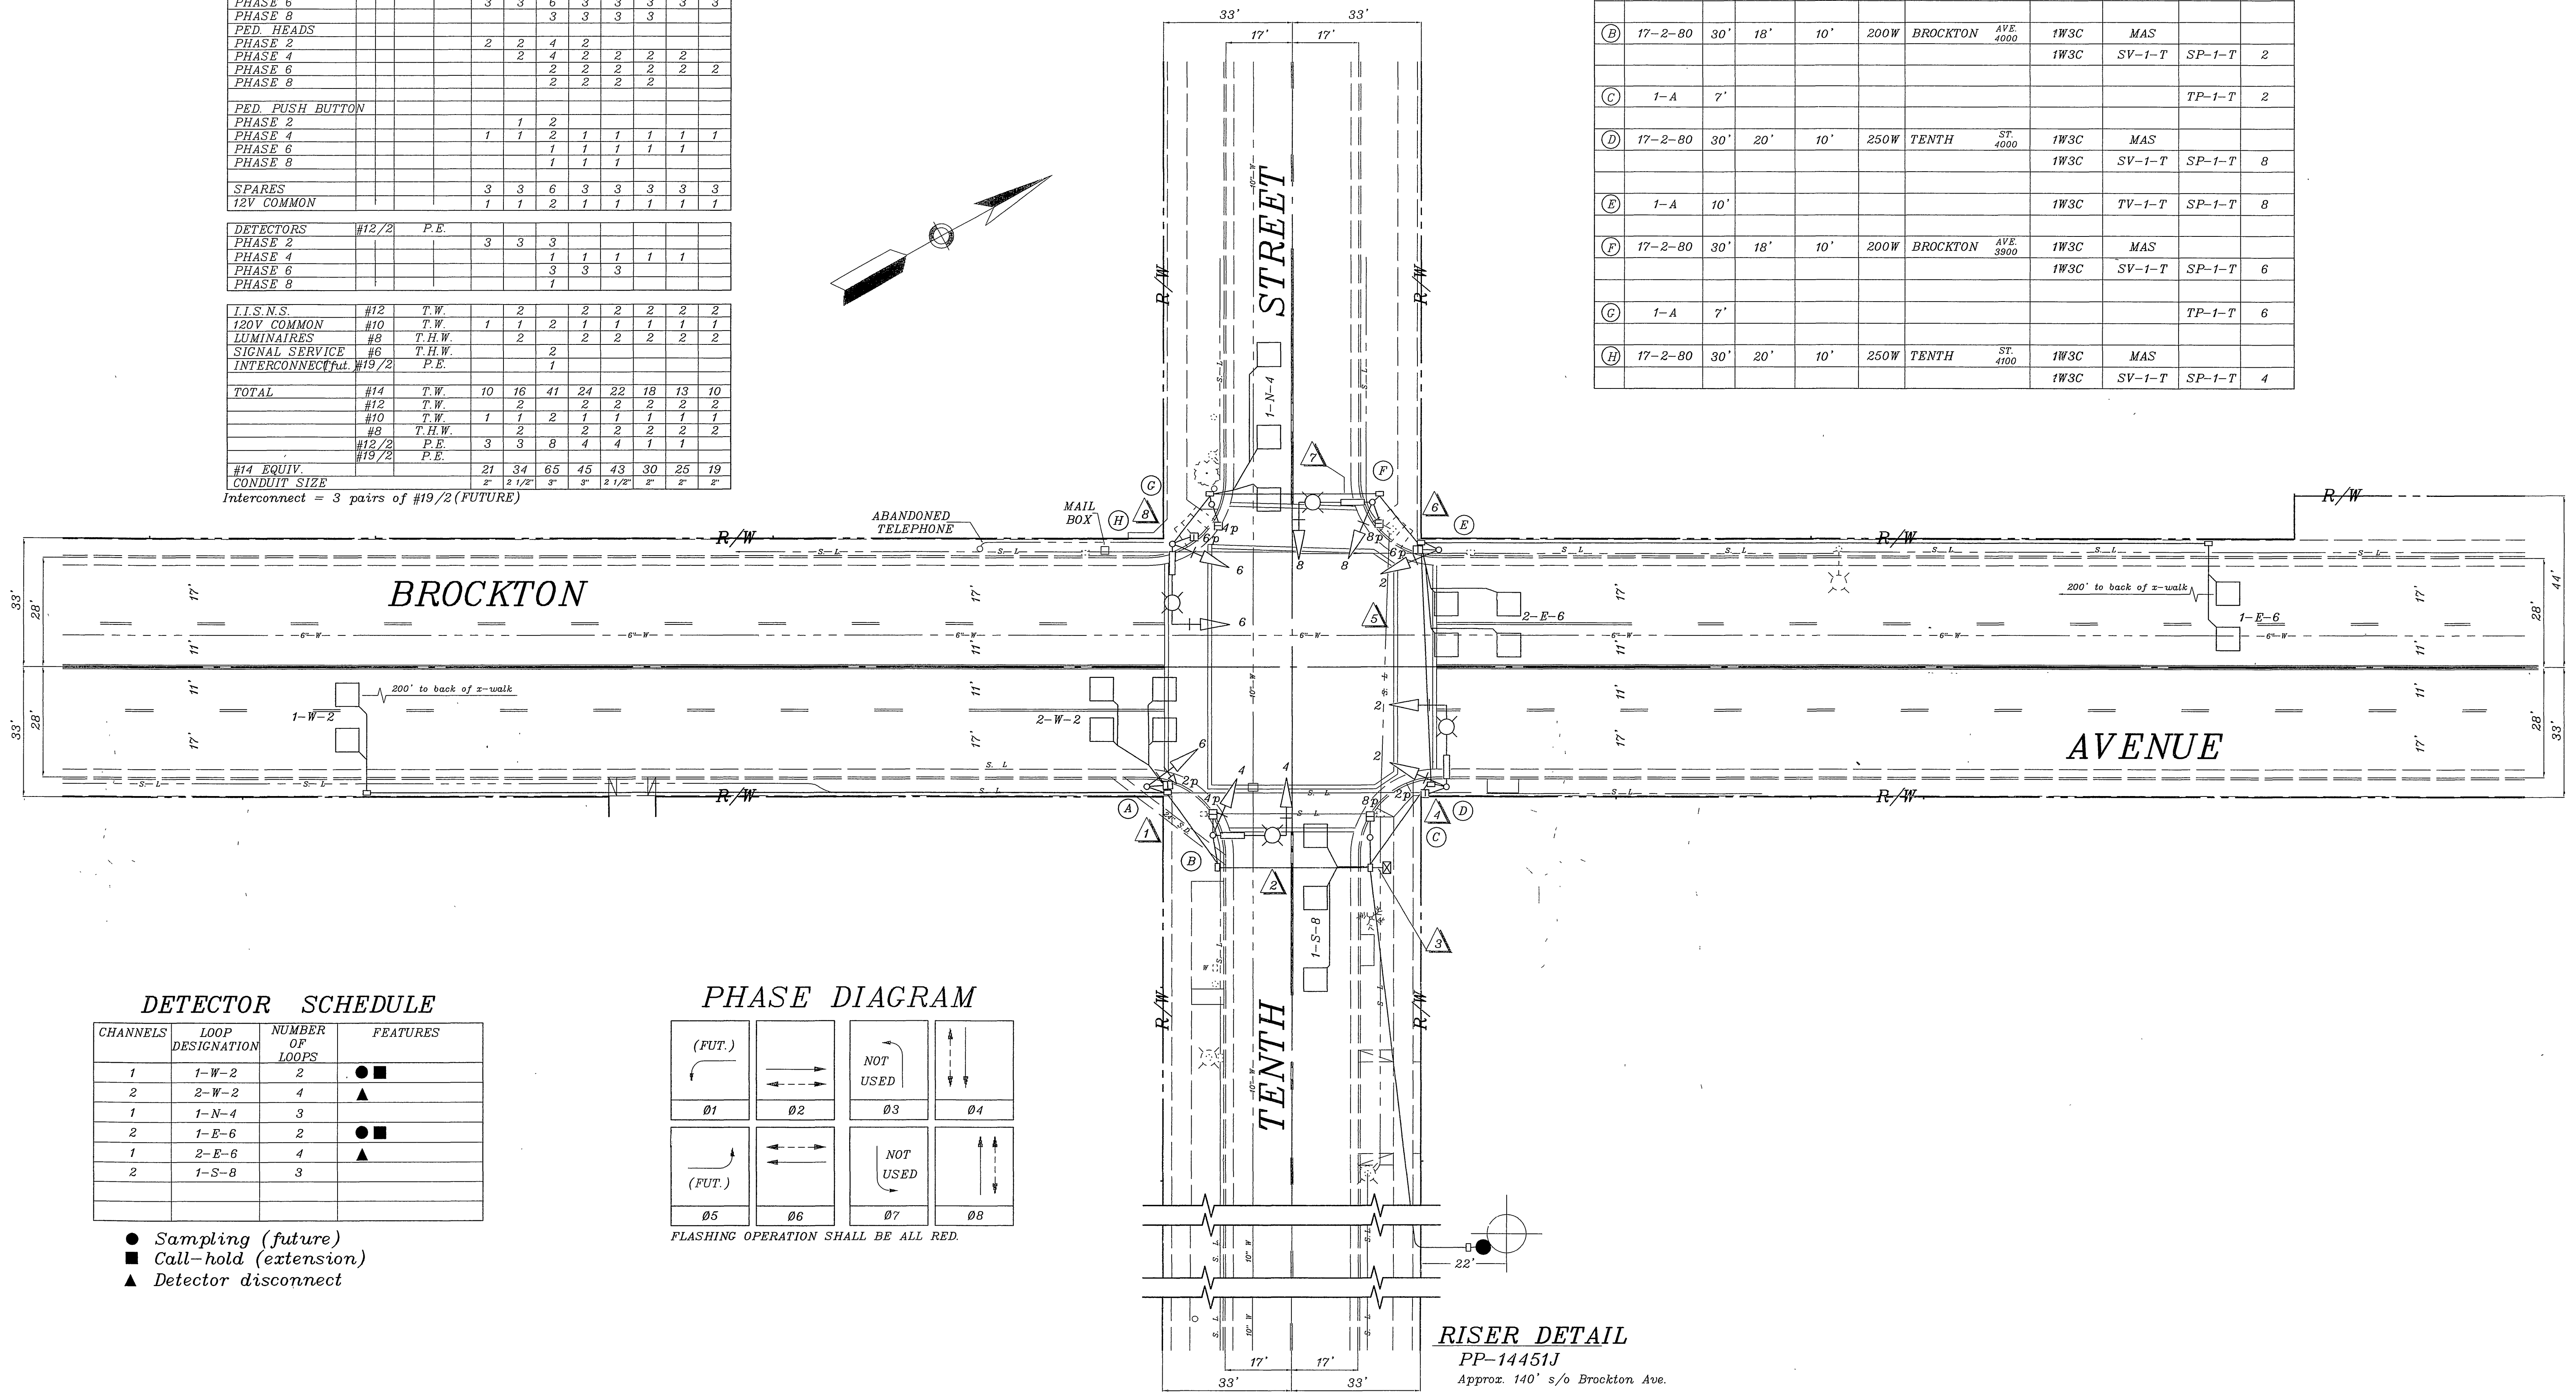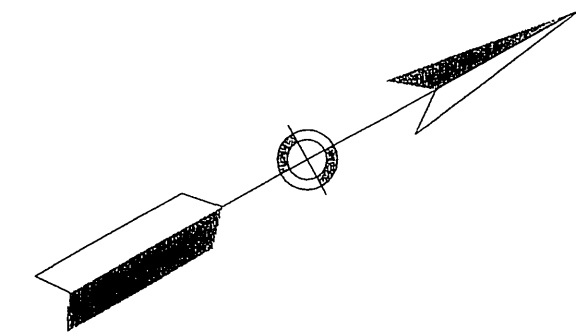


DETECTOR SCHEDULE

| CHANNELS | LOOP DESIGNATION | NUMBER OF LOOPS | FEATURES |
|----------|------------------|-----------------|----------|
| 1 | 1-W-2 | 2 | ● ■ |
| 2 | 2-W-2 | 4 | ▲ |
| 1 | 1-N-4 | 3 | ● ■ |
| 2 | 1-E-6 | 2 | ● ■ |
| 1 | 2-E-6 | 4 | ▲ |
| 2 | 1-S-8 | 3 | |

- Sampling (future)
- Call-hold (extension)
- ▲ Detector disconnect

PHASE DIAGRAM

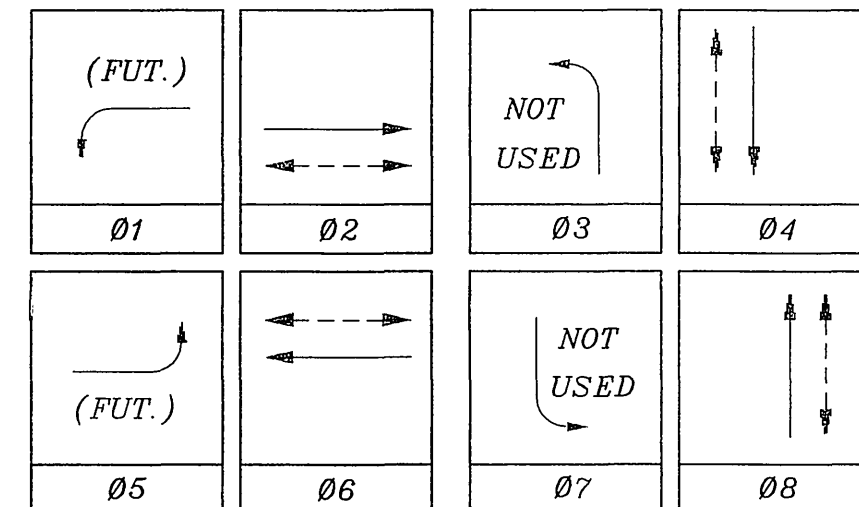

FLASHING OPERATION SHALL BE ALL RED.

RISER DETAIL

PP-14451J
Approx. 140' s/o Brockton Ave.

| | | | | |
|---|---------------|---|--------------------------|---------------------------|
| CITY OF RIVERSIDE, CALIFORNIA DEPARTMENT OF PUBLIC WORKS | | TRAFFIC SIGNAL BROCKTON AVENUE AND TENTH STREET | | ACCT. NO. X-159 |
| DESIGNED BY: MAC | DRAWN BY: MAC | CHECKED BY: | APPROVED BY: [Signature] | SHEET 1 OF 1 |
| AS-BUILT PER TE-90-04 | MAC 2/03 | DATE: | DATE: | FILE NAME: X159AS.DWG |
| SCALE: 1" = 20' | | | | |