


EQUIPMENT SCHEDULE

NO.	SIGNAL STANDARD				LUMINAIRE	I.I.S.N.S. LEGEND	SIGNAL MOUNTINGS			PPB PHASE
	TYPE	H'GHT	M.A.	M.A.			VEHICLE	PEDESTRIAN	AUDIBLE	
(A)	26-4-80	30'	45'	12'	250W		MAS			
							MAS			
							SV-1-T	SP-1-T	((C))	4
(B)	1A	10'					TV-1-T	SP-1-T	((P))	4 Bike, 6
(C)	17-2-80	30'	18'	12'	200W	UNIVERSITY AVE 1100	MAS			
							SV-1-T	SP-1-T	((P))	6
(D)	TYPE 15	30'		12'	250W		SV-1-T	SP-1-T	((C))	6 Bike, 8
(E)	26-4-80	30'	40'	12'	250W		MAS			
							MAS			
							SV-1-T	SP-1-T	((C))	8
(F)	1A	10'					TV-1-T	SP-1-T	((P))	8 Bike, 2
(G)	17-2-80	30'	18'	12'	200W	UNIVERSITY AVE 1200	MAS			
							SV-1-T	SP-1-T	((P))	2
(H)	TYPE 15	30'		12'	250W		SV-1-T	SP-1-T	((C))	2 Bike, 4


NOTES: 1. ALL VEHICULAR HEADS HAVE 12" LENSES.  
2. ALL LEFT TURN HEADS HAVE ALL ARROWS.

CONDUCTOR TABLE

CONTROL FUNCTION	CONDUCTORS	CONDUCTOR RUNS									
		1	2	3	4	5	6	7	8	1c	
VEHICLE & PEDESTRIAN HEADS, PEDESTRIAN PUSH BUTTONS, SPARES & COMMONS	12 WIRE IMSA 9 WIRE IMSA 5 WIRE IMSA 3 WIRE IMSA	1			1	2	2	1	1		
DETECTOR CABLE	#16/2				1	1					
PHASE 1											
PHASE 2			2		2						
PHASE 4					2	2	2				
PHASE 5			1		1						
PHASE 6					2	2					
PHASE 8					2						
I.I.S.N.S.	#12	2		2		2	2	2	2		
LUMINAIRES	#8	2		2		2	2	2	2		
SIGNAL SERVICE	#6				2						
INTERCONNECT	#19		1		2						1
PRE-EMPTION	4-#20				2	1	1	1	1		
CONDUIT SIZE		2"	3"	3"	2-3"	3.5"	3"	3"	2"	1.5"	

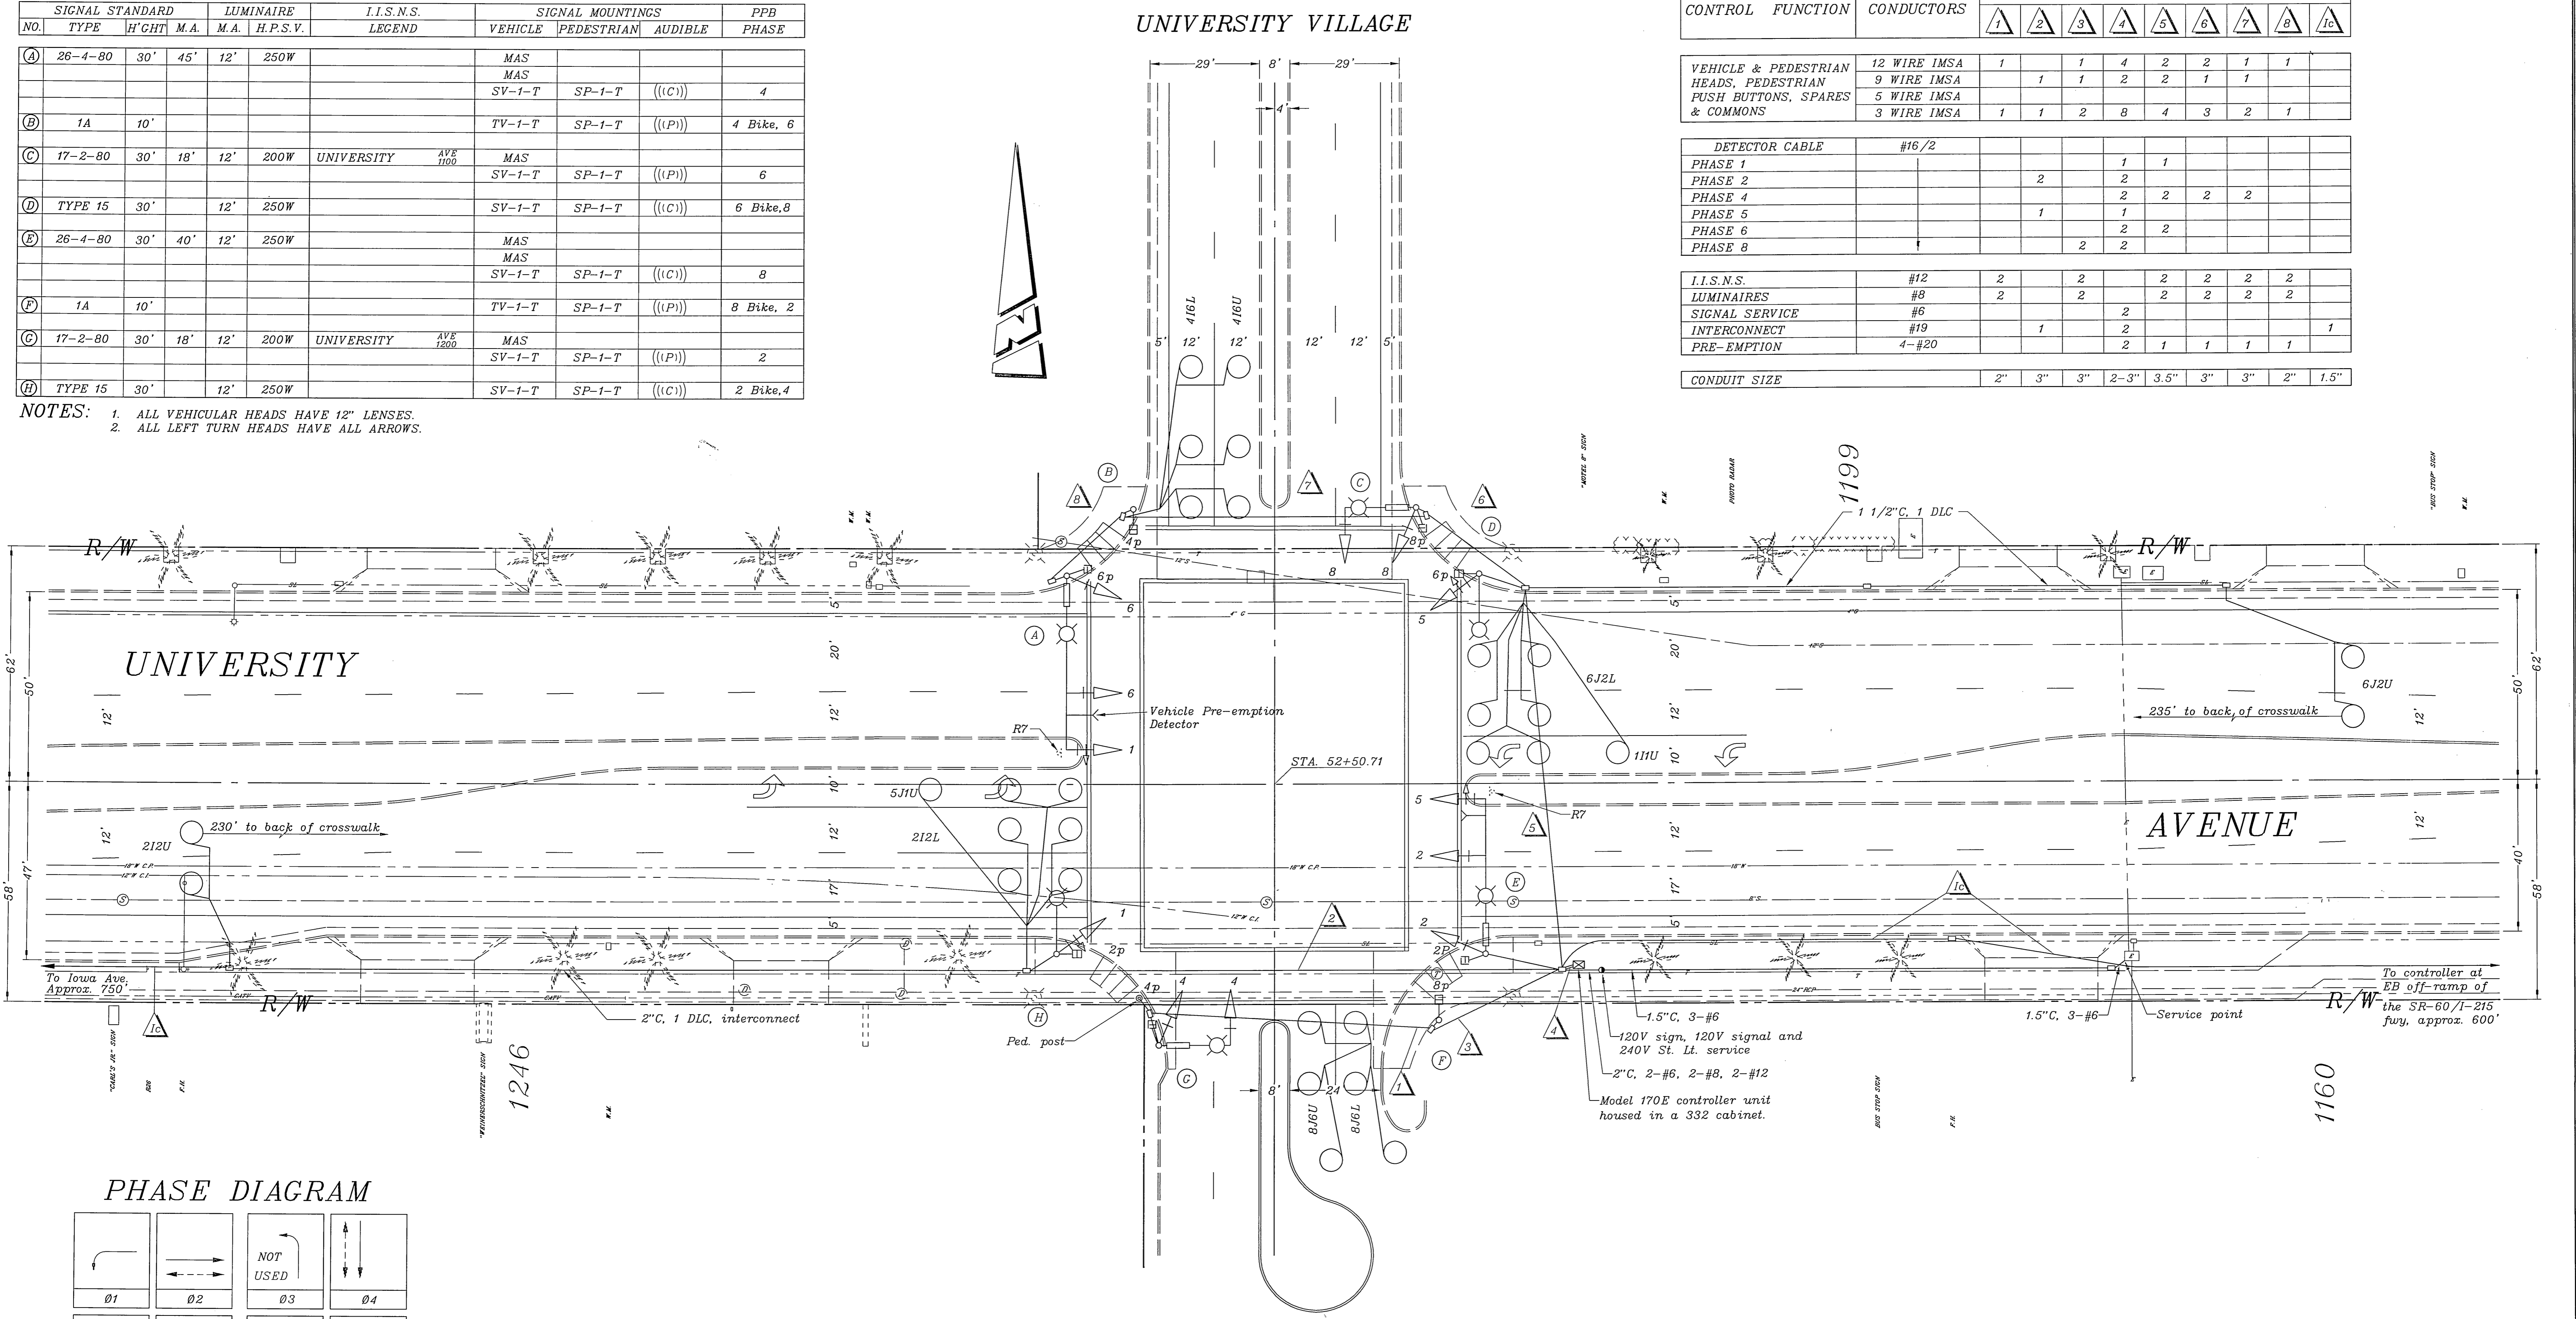

PHASE DIAGRAM

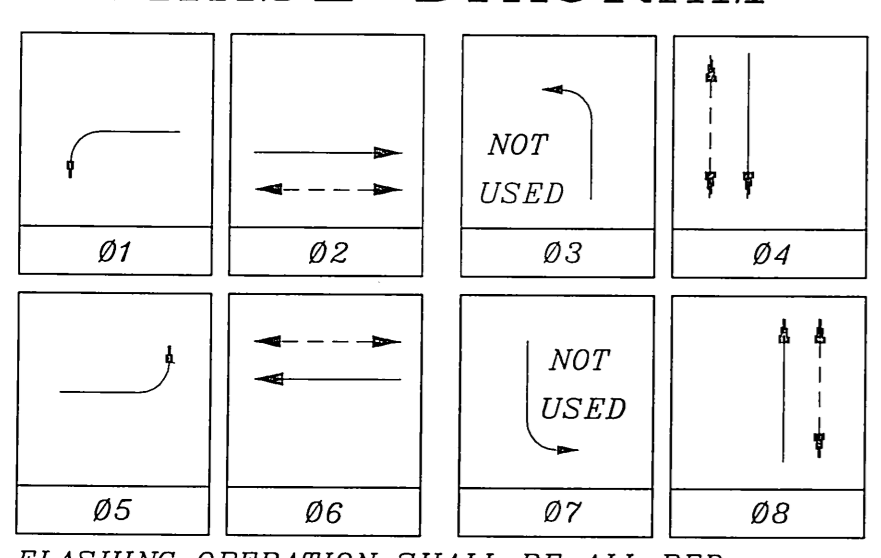

UNIVERSITY OF RIVERSIDE  
EXTENSION CENTER PARKING

CITY OF RIVERSIDE, CALIFORNIA DEPARTMENT OF PUBLIC WORKS		TRAFFIC SIGNAL		ACCT. NO.
APPROVED BY _____ BY _____ DATE _____		UNIVERSITY AVENUE @ UNIVERSITY VILLAGE		X-162
PRINCIPAL ENGINEER		DIRECTOR OF PUBLIC WORKS		SHEET 1 OF 1
P.W. INSPECTION		TRAFFIC DIVISION		FILE NAME: X162AS.DWG
CHIEF P.W. ENGR.		PUBLIC UTILITIES		
DESIGNED BY MAC DRAWN BY MAC CHECKED BY _____		DATE _____		
AS-BUILT PER SIGNALIZATION		MAC 01/01		
REVISIONS		APPR. DATE		
SCALE: 1" = 20'				