


**EQUIPMENT SCHEDULE**

NO.	SIGNAL STANDARD		LUMINAIRE			I.I.S.N.S.		SIGNAL MOUNTINGS			PPB PHASE	
	TYPE	H'GHT	M.A.	L.A.	H.P.S.V.	LECOND	VEHICLE	PEDESTRIAN	AUDIBLE			
(A)	17-2-80	30'	20'	12'	250W	DEWEY	AV 6300	MAS	SV-1-T	SP-1-T	((IC))	4
(B)	1A	10'						TV-1-T	SP-1-T		((IP))	6
(C)	17-2-80	30'	20'	12'	250W	STREETER	AV 6300	MAS	SV-1-T			6
(D)	1A	7'						TP-1-T			((IP))	
(E)	16-2-80	17'	20'			DEWEY	AV 5200	MAS	SV-1-T	SP-1-T	((IC))	2
(F)	19-2-80	30'	25'	12'	250W	STREETER	AV 6300	MAS	SV-1-T			
(G)	1A	10'						TV-1-T	SP-2-T		((IP)) ((IC))	2,4

NOTES: 1. ALL VEHICULAR HEADS HAVE 12" LENSES.  
 2. ((IC)) OR ((IP)) - INDICATES AUDITORY PEDESTRIAN SIGNAL.  
 ((IC)) INDICATES CUCKOO SOUND; ((IP)) INDICATES PEEP-PEEP SOUND.

JUANRO WAY


DEWEY AVE.

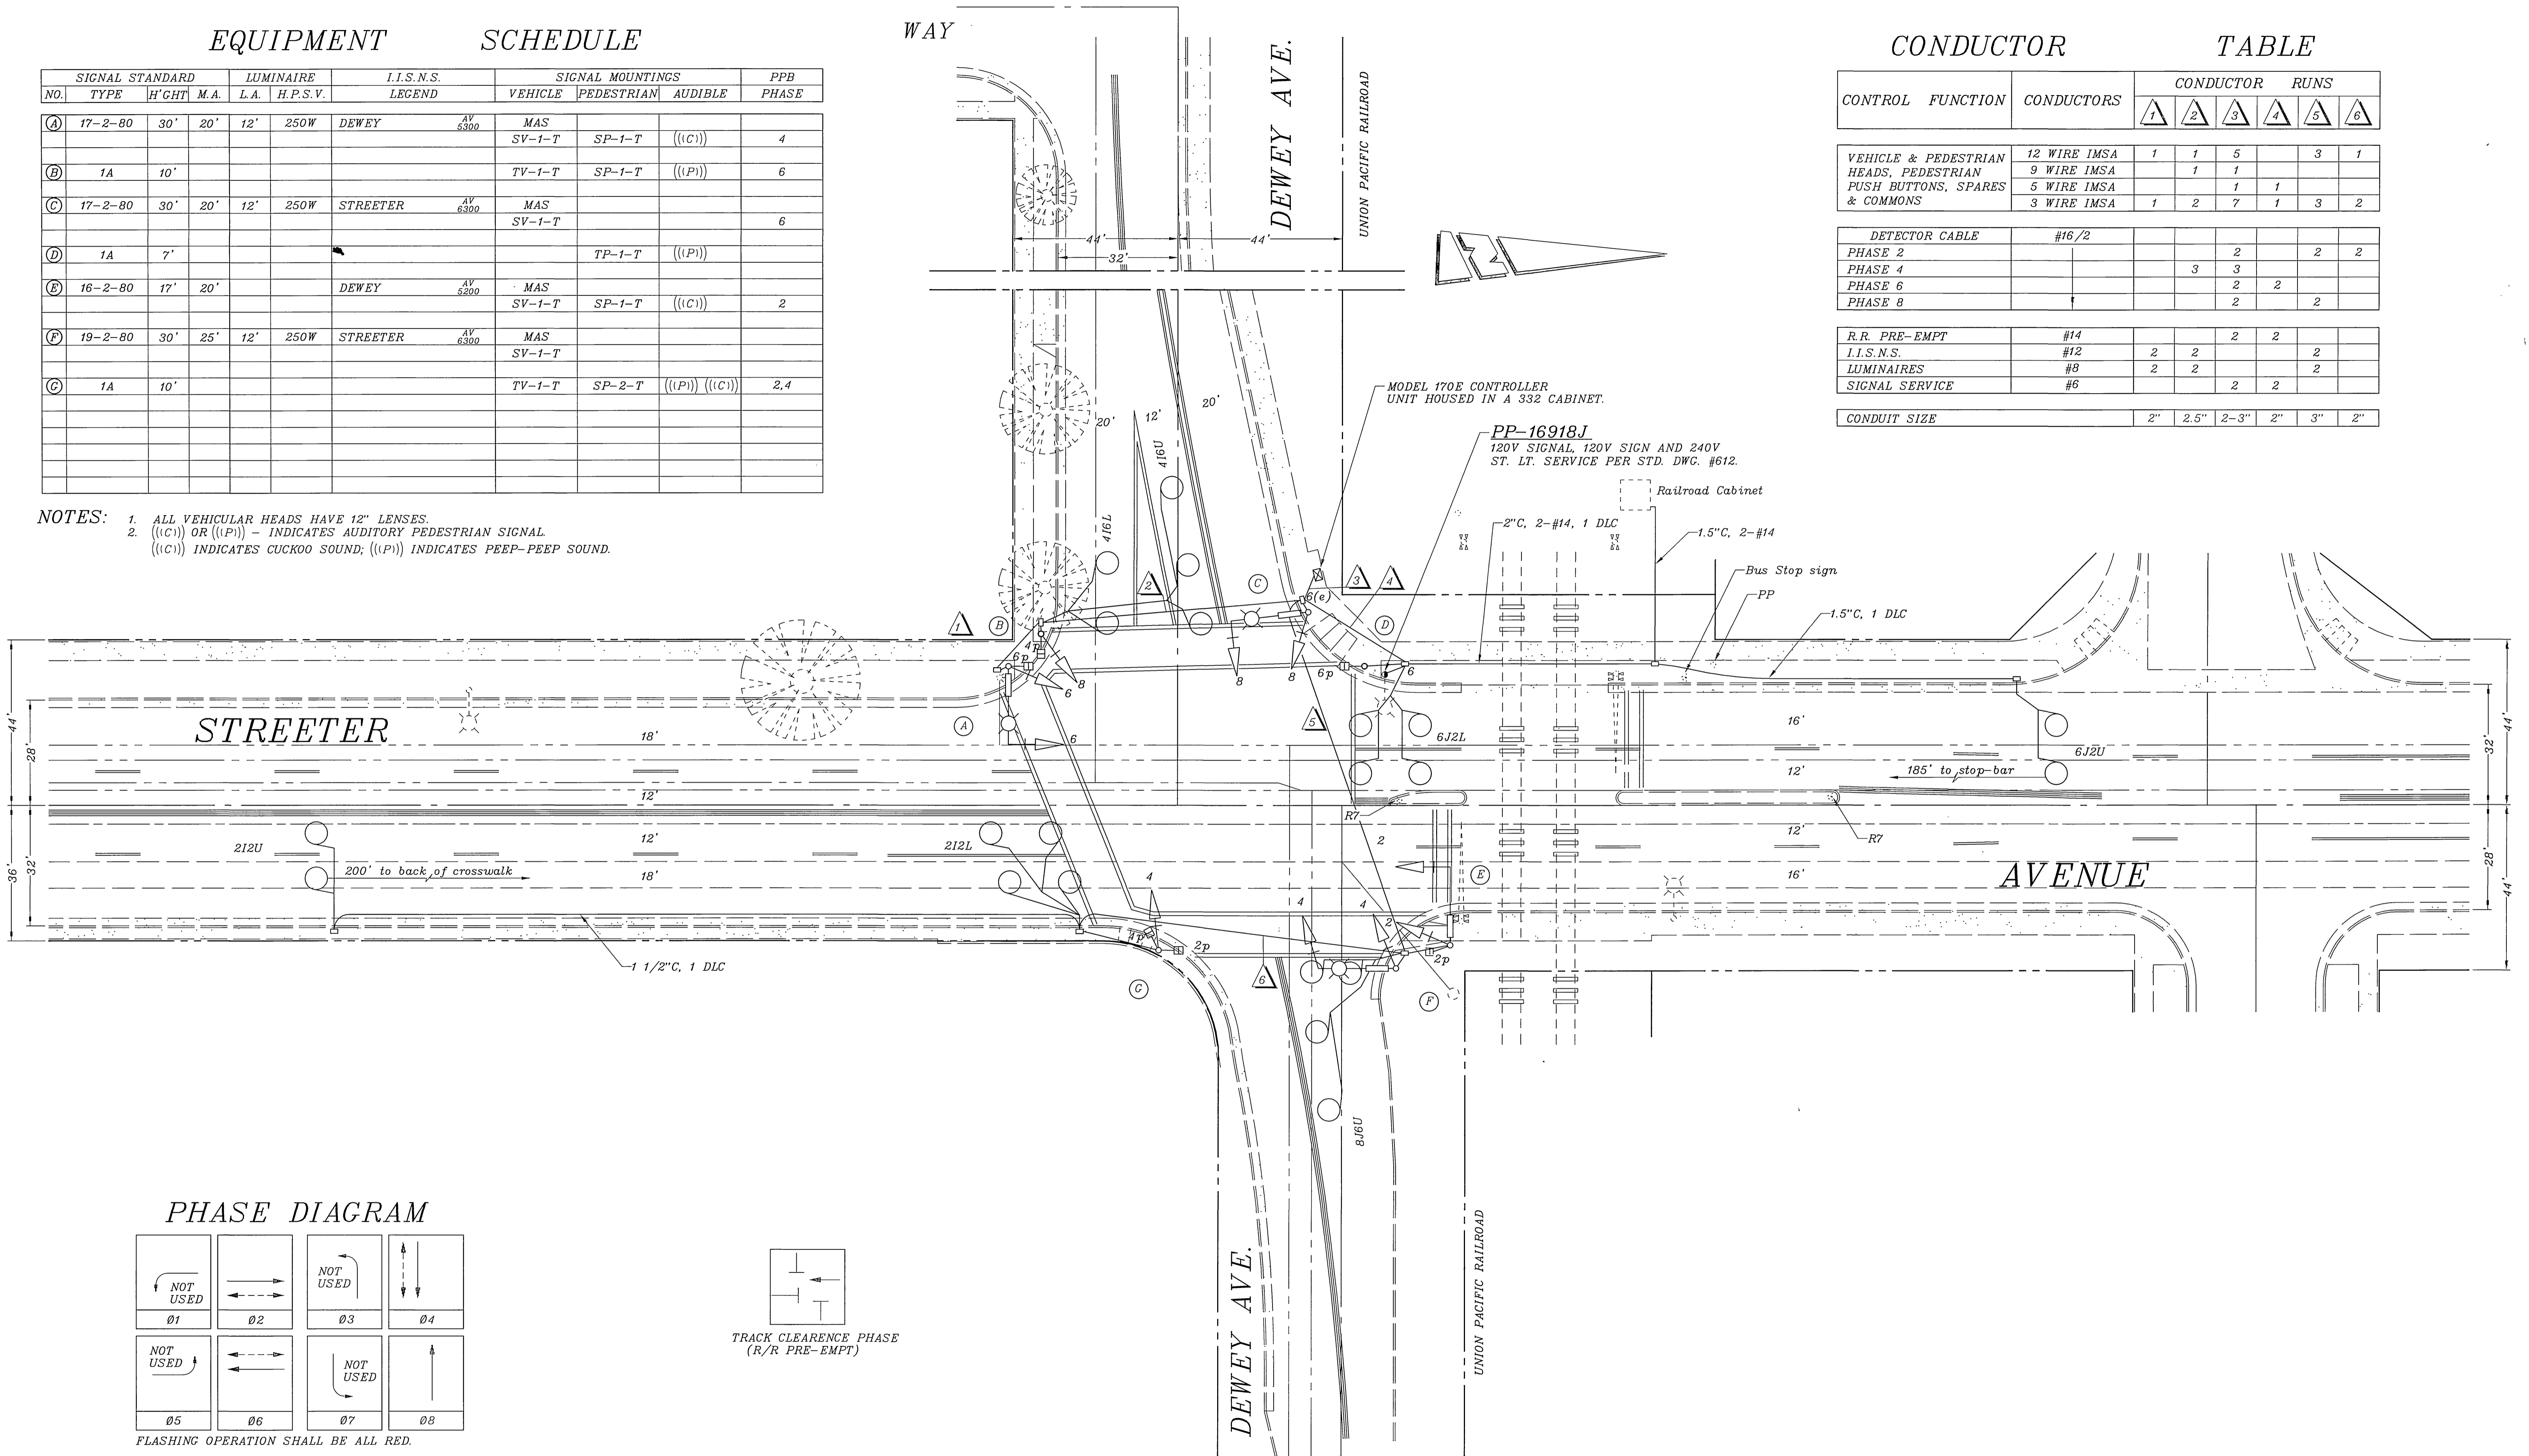

**CONDUCTOR TABLE**

CONTROL FUNCTION	CONDUCTORS	CONDUCTOR RUNS					
		1	2	3	4	5	6
VEHICLE & PEDESTRIAN HEADS, PEDESTRIAN PUSH BUTTONS, SPARES & COMMONS	12 WIRE IMSA 9 WIRE IMSA 5 WIRE IMSA 3 WIRE IMSA	1 1 1 1	1 1 1 1	5 1 1 1		3 1 1 1	1 1 1 2
DETECTOR CABLE	#16/2			2		2	2
PHASE 2				3		3	
PHASE 4				2		2	
PHASE 6				2		2	
PHASE 8				2		2	
R.R. PRE-EMPT	#14			2		2	
I.I.S.N.S.	#12	2	2				2
LUMINAIRES	#8	2	2				2
SIGNAL SERVICE	#6			2	2		
CONDUIT SIZE		2"	2.5"	2-3"	2"	3"	2"

**PHASE DIAGRAM**

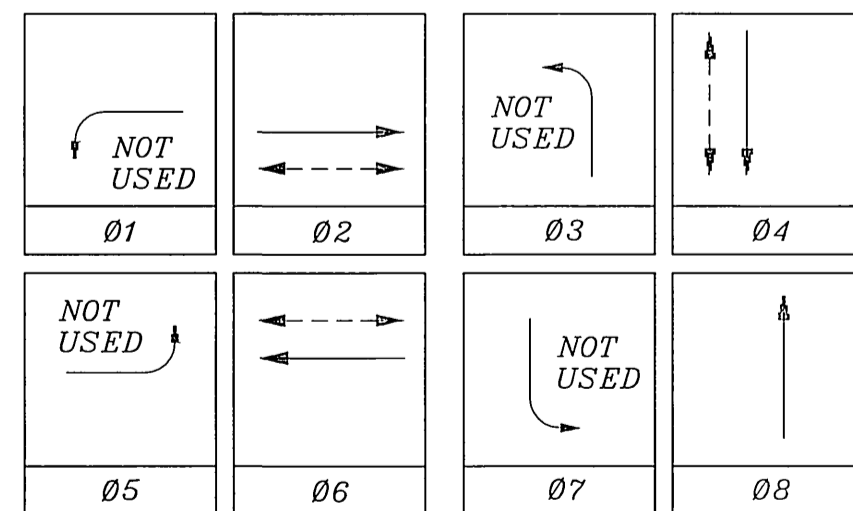

FLASHING OPERATION SHALL BE ALL RED.

CITY OF RIVERSIDE, CALIFORNIA DEPARTMENT OF PUBLIC WORKS				TRAFFIC SIGNAL		ACCT. NO.
APPROVED BY _____ BY _____ DATE _____				APPROVED BY _____		X-164
AS-BUILT PER TE-98-1				DIRECTOR OF PUBLIC WORKS		
MARK	REVISIONS	APPR. DATE	DESIGNED BY	TRAFFIC DIVISION	DATE	SHEET 1 OF 1
			MAC			FILE NAME: X164as.DWC

SCALE: 1" = 20'