




PHASE DIAGRAM

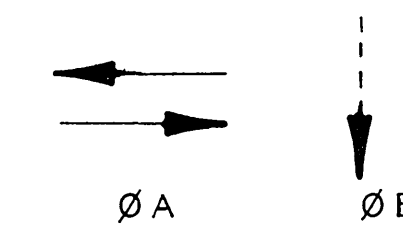

UNDERGROUND UTILITIES NOT SHOWN ON THIS SHEET.

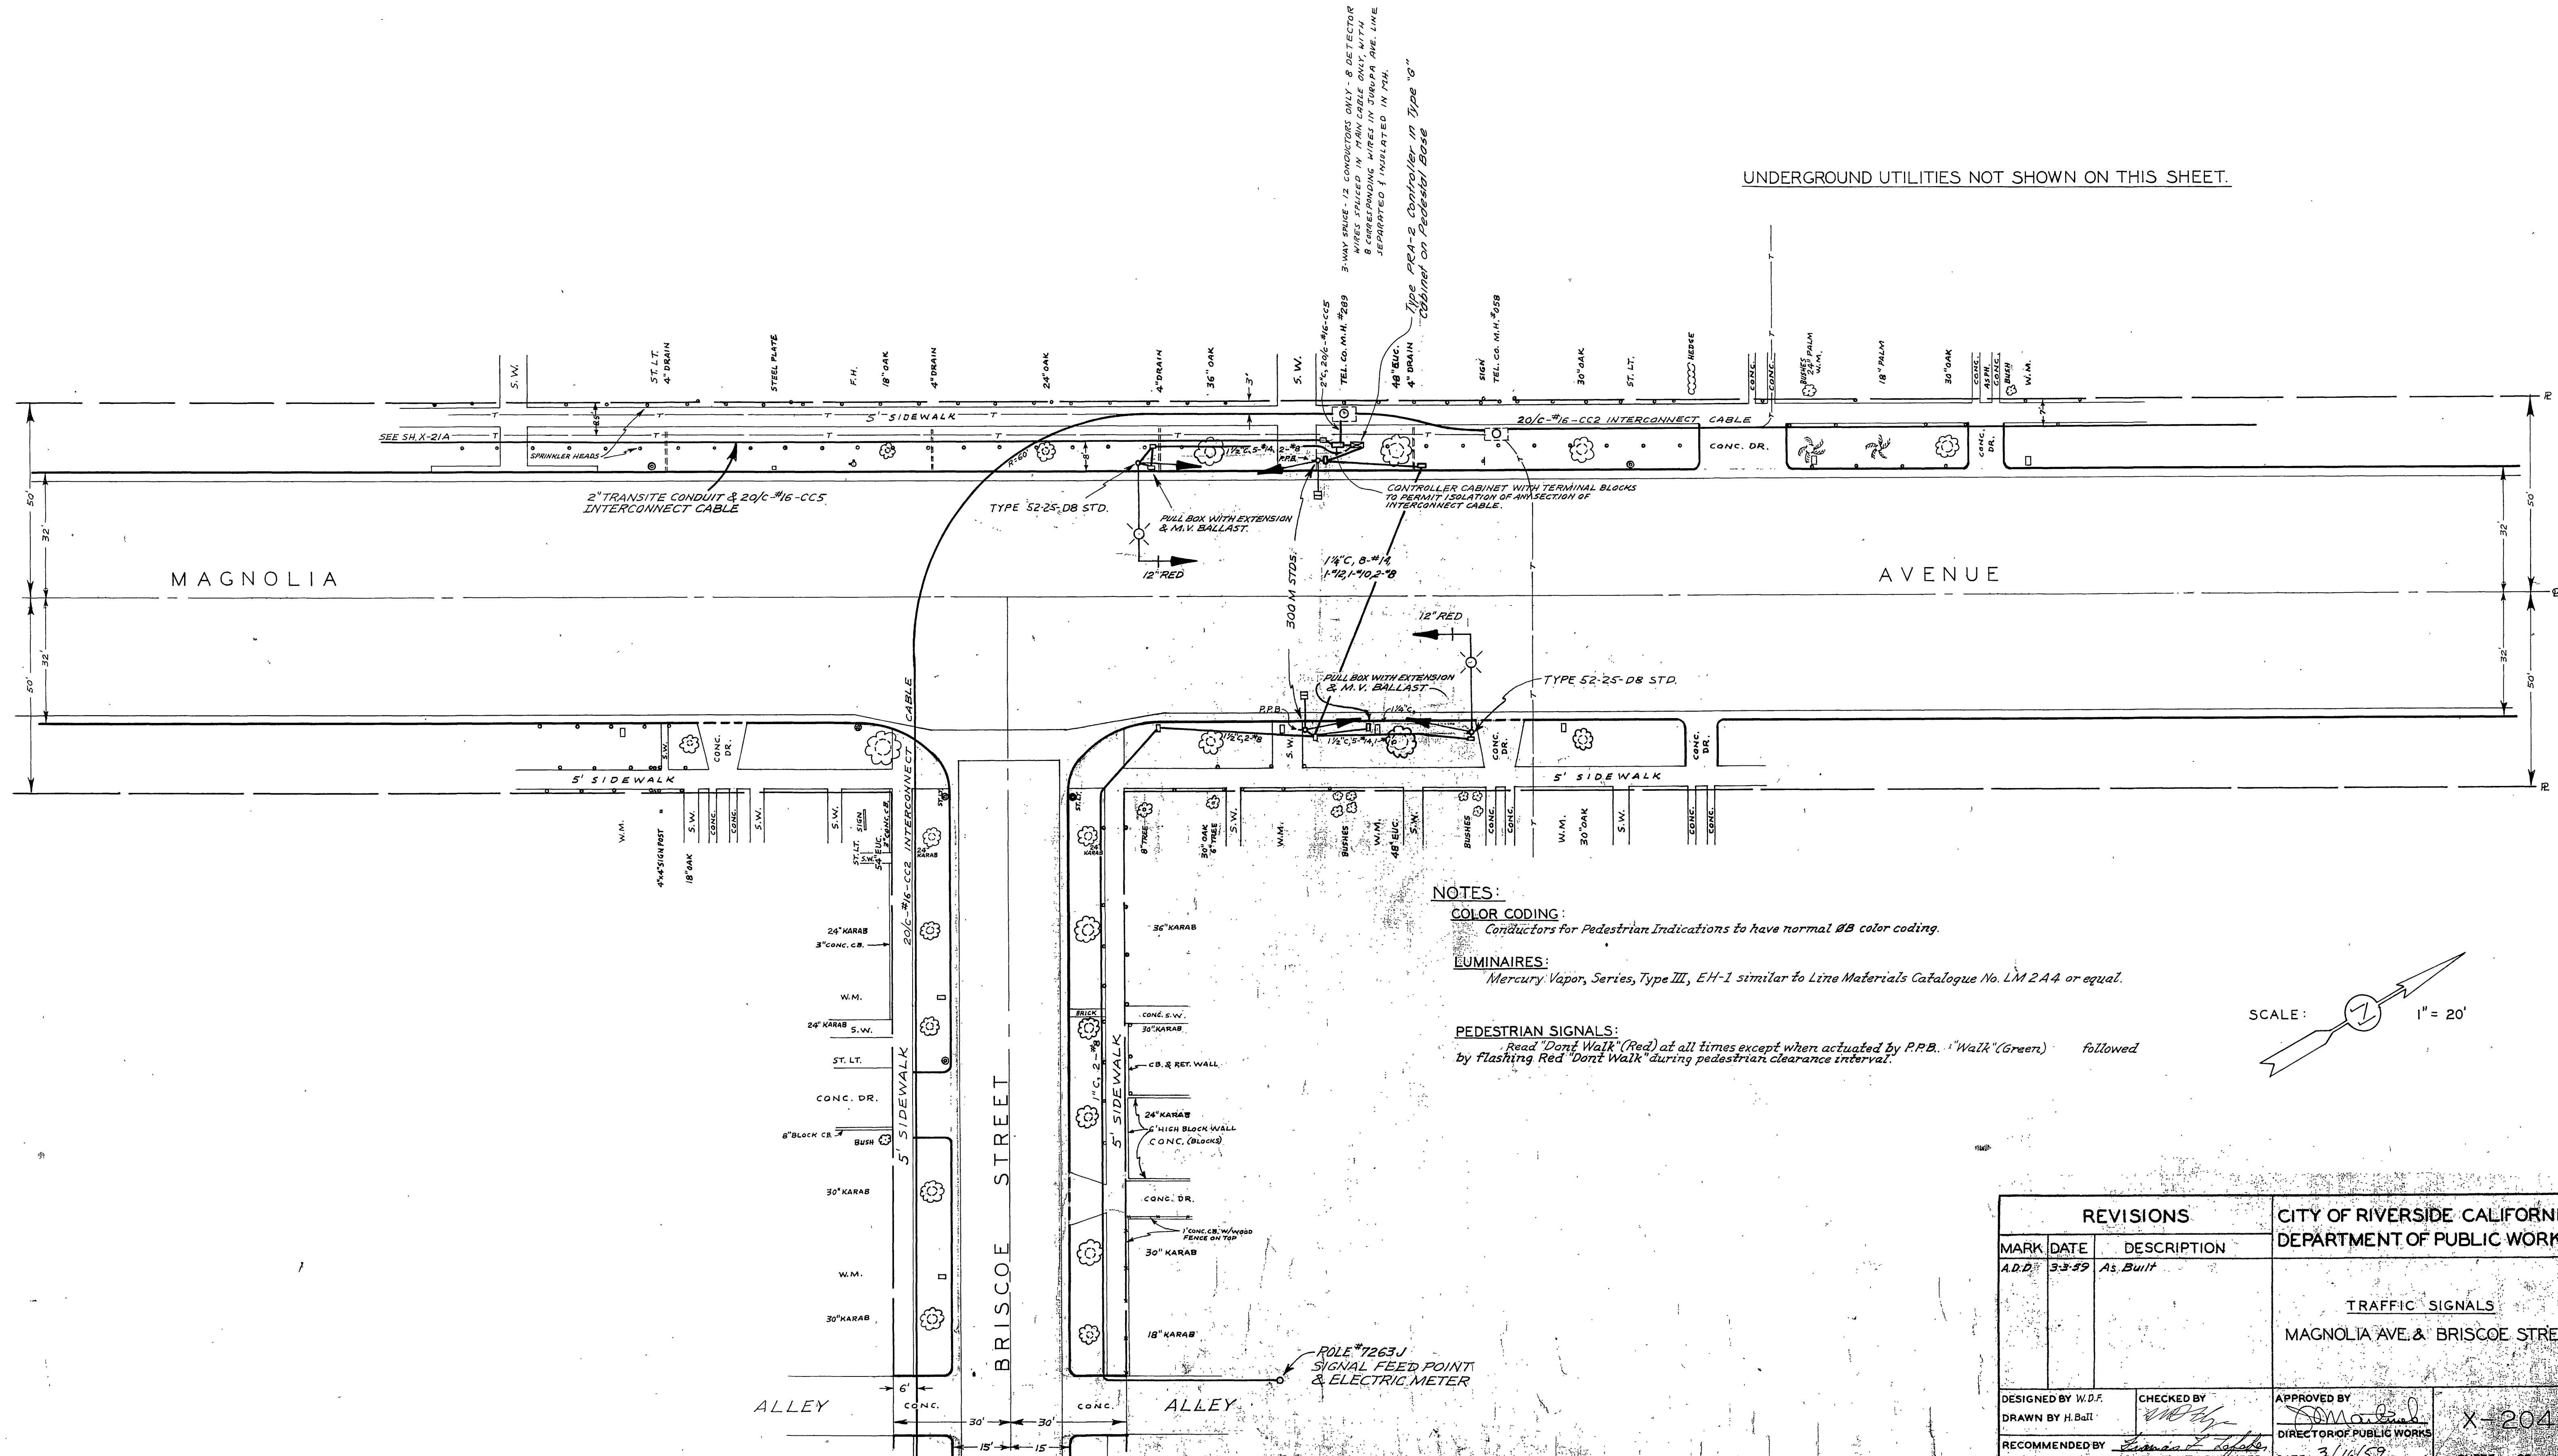

- NOTES:**
- COLOR CODING:**
Conductors for Pedestrian Indications to have normal #B color coding.
 - LUMINAIRES:**
Mercury Vapor, Series, Type III, EH-1 similar to Line Materials Catalogue No. LM 2A4 or equal.
 - PEDESTRIAN SIGNALS:**
Read "Don't Walk" (Red) at all times except when actuated by P.P.B. "Walk" (Green) followed by flashing Red "Don't Walk" during pedestrian clearance interval.

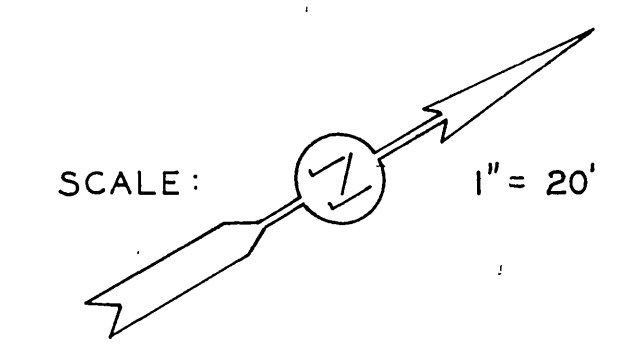

REVISIONS			CITY OF RIVERSIDE CALIFORNIA DEPARTMENT OF PUBLIC WORKS
MARK	DATE	DESCRIPTION	
A.D.D.	3-3-59	As Built	

TRAFFIC SIGNALS MAGNOLIA AVE. & BRISCOE STREET	
DESIGNED BY W.D.F. DRAWN BY H.B.J.	CHECKED BY <i>[Signature]</i> DIRECTOR OF PUBLIC WORKS
RECOMMENDED BY <i>[Signature]</i> ASSISTANT CITY ENGINEER	APPROVED BY <i>[Signature]</i> DATE 3/16/59

X-204
SHEET OF