

CONDUCTOR TABLE


CONTROL FUNCTION	CONDUCTORS		CONDUIT RUNS										
	I.M.S.A. SIZE	INSULATION	1	2	3	4	5	6	7	8	9		
VEHICLE & PED HEADS, PED PUSH BUTTONS, SPARES & COMMONS	12	P.E.			1	1	1			1	1	1	1
	9		1	2	2	3	2	1	1	1	1	1	1
	5												
	3		1	2	3	4	2	1	1	2	1		
DETECTOR CABLE	#16/2	P.E.											
PHASE 1					1	1	1						
PHASE 2								2		2			
PHASE 4								3		3	3		
PHASE 5								1		1			
PHASE 6			2	2	2								
PHASE 8						3							
TOTALS					3	3	6	6		3	3		
LUMINAIRES	#8	T.H.W.	2	2	2	2		2		2			
SIGNAL SERVICE	#6	T.W.					2			2			
CONDUIT SIZE			2"	2"	2.5"	2.5"	2-2.5"	1.5"	2"	3"	2"		

POLE SCHEDULE


No.	TYPE	STANDARD				LUM. HPSV	SIGNAL MOUNTING			PPB
		HGT.	SIG.	M.A.	LUM. M.A.		VEHICLE	PED	AUDIBLE PHASE	
(A)	26-4-80	30'	40'	12'	250W	MAS				
						MAS				
						SV-1-T	SP-1-T	((P))	4	
(B)	1A	10'				TV-1-T	SP-1-T	((C))	6	
(C)	17-2-80	30'	20'	12'	250W	MAS				
						SV-1-T	SP-1-T	((C))	6	
(D)	1A	10'				TV-1-T	SP-1-T	((P))	8	
(E)	19-4-80	30'	30'	12'	250W	MAS				
						MAS				
						SV-1-T	SP-1-T	((P))	8	
(F)	1A	10'				TV-1-T	SP-1-T	((C))	2	
(G)	66/10	28'	18'	10'	250W	MAS				
						TV-1-T	SP-1-T	((C))	2	
(H)	1A	10'				TV-1-T	SP-1-T	((P))	4	

Notes:

- All 1A poles are Aluminum.
- New vehicular heads have 12" lens; left turn heads have all arrows.
- ((C)) or ((P)) - Indicates Auditory Pedestrian signal. C: Indicates Cuckoo sound. P: Indicates Peep-Peep sound.

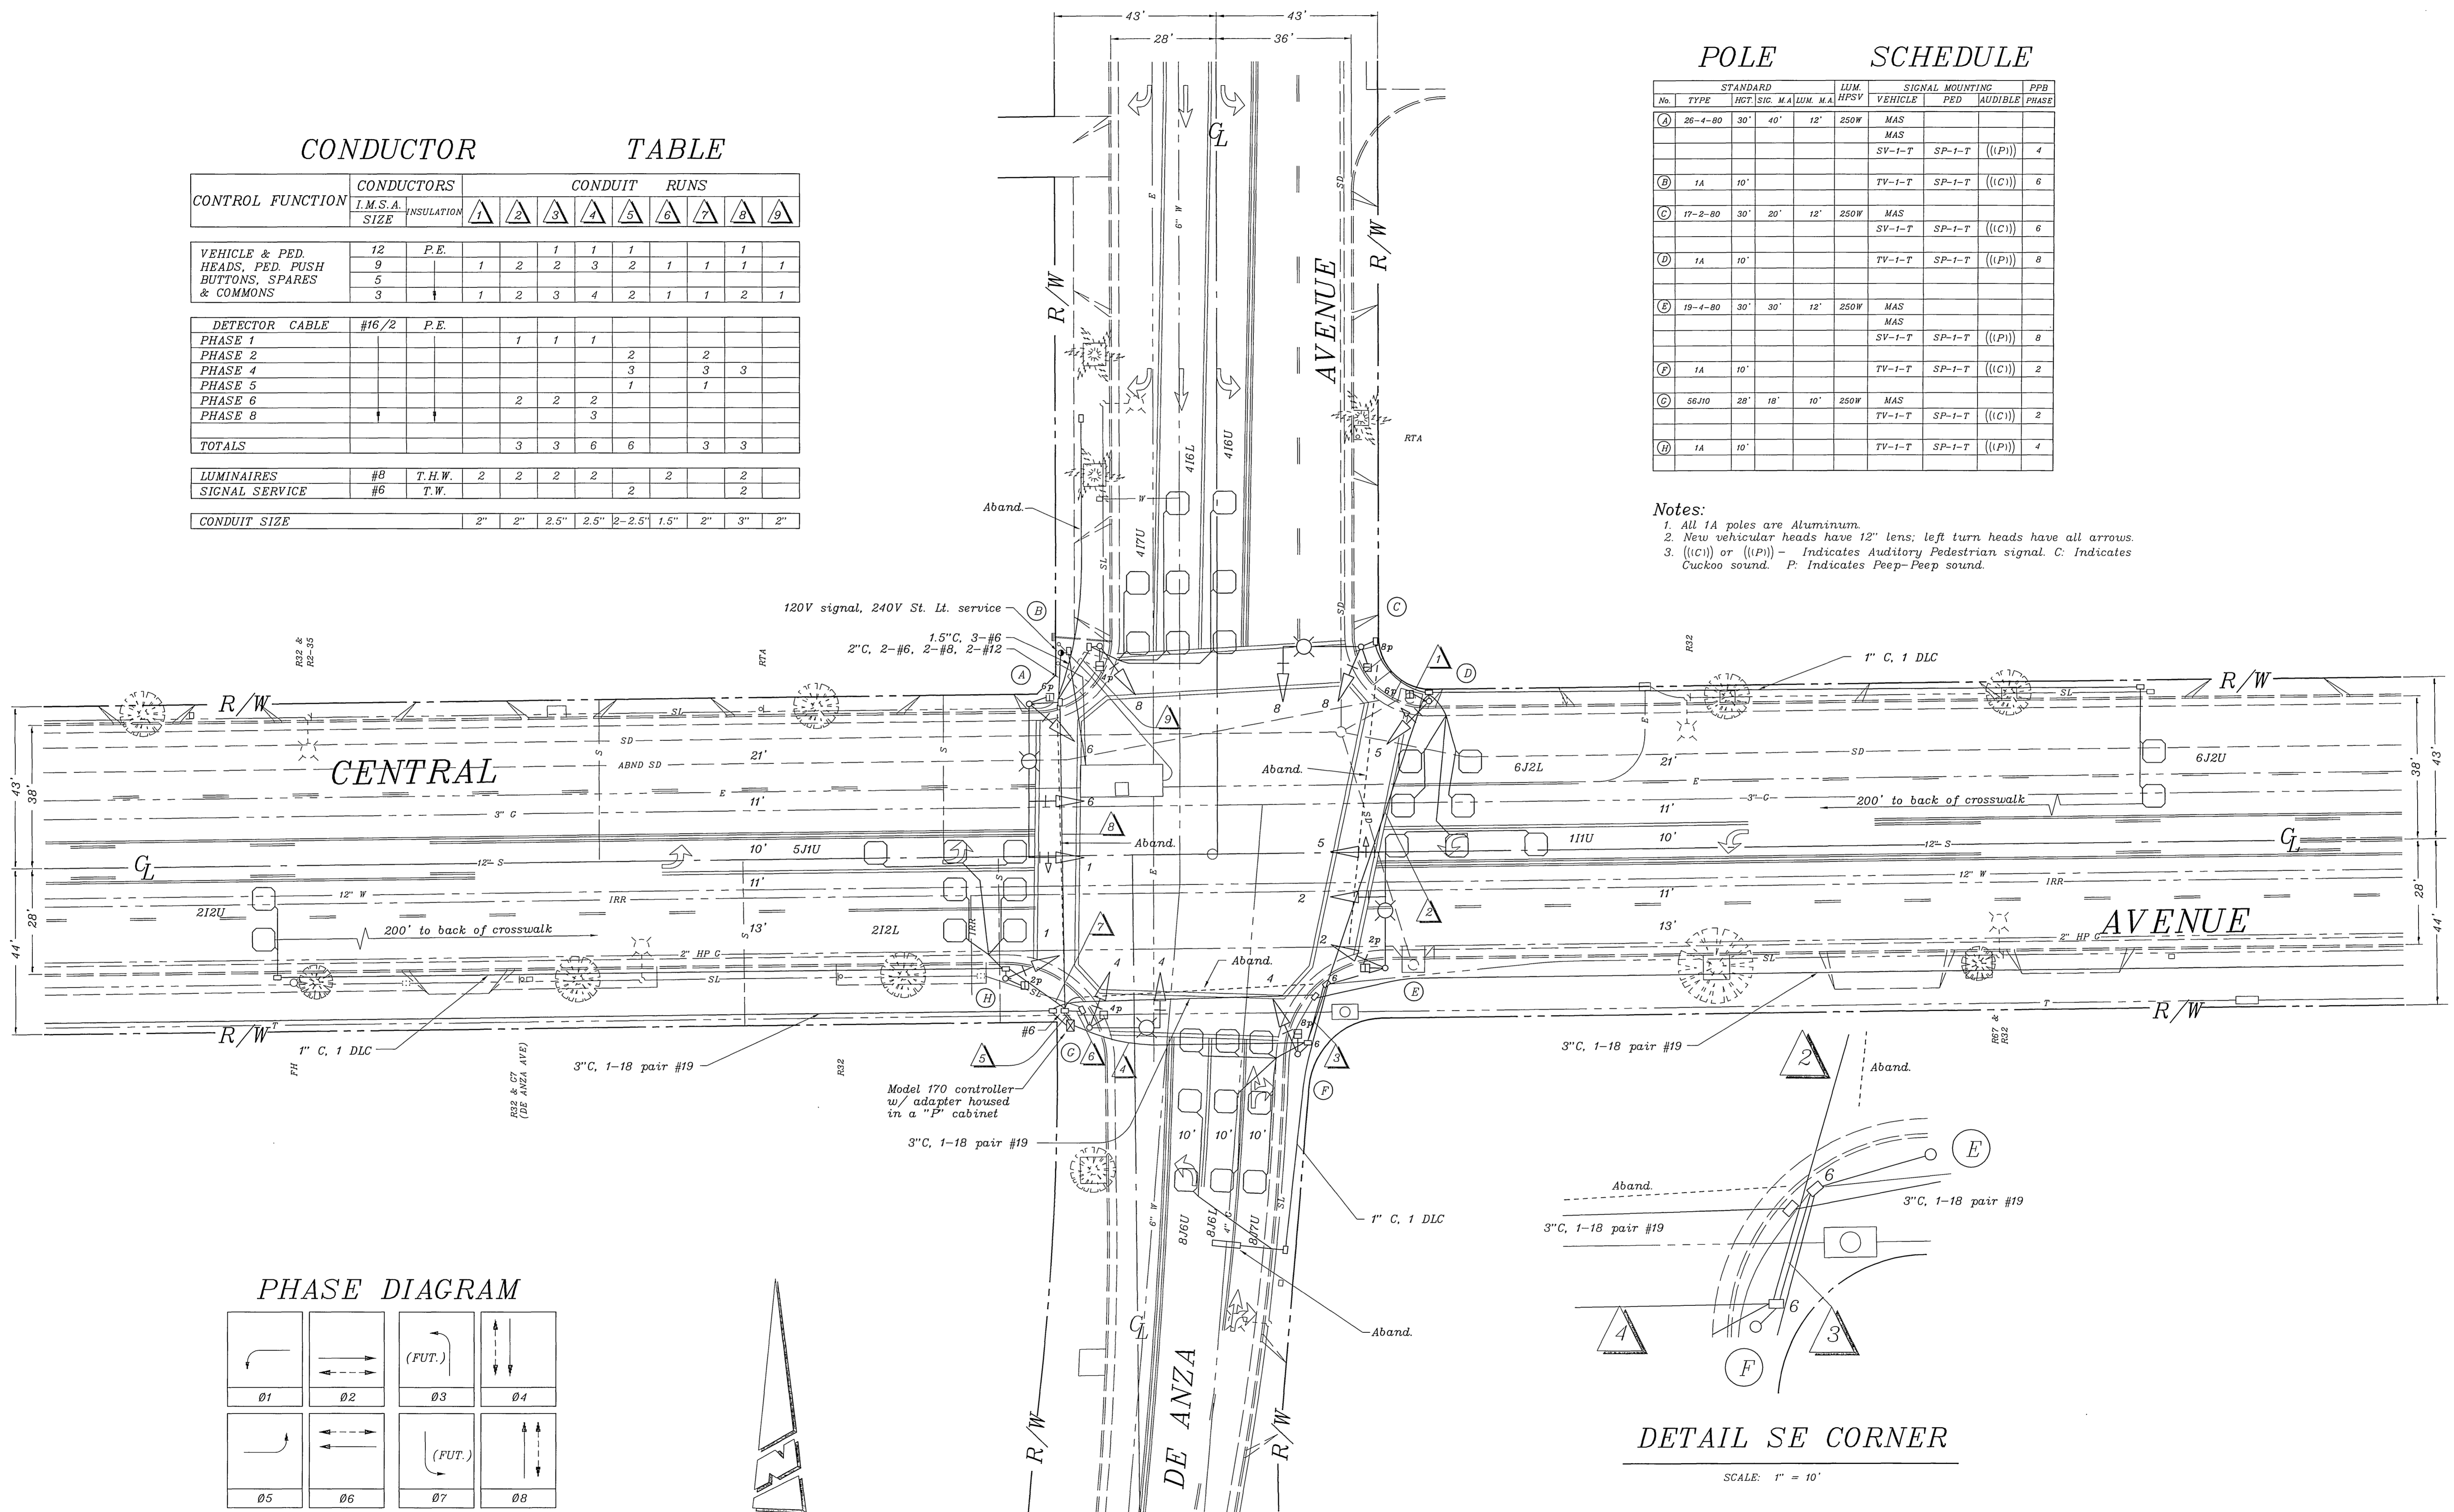

PHASE DIAGRAM

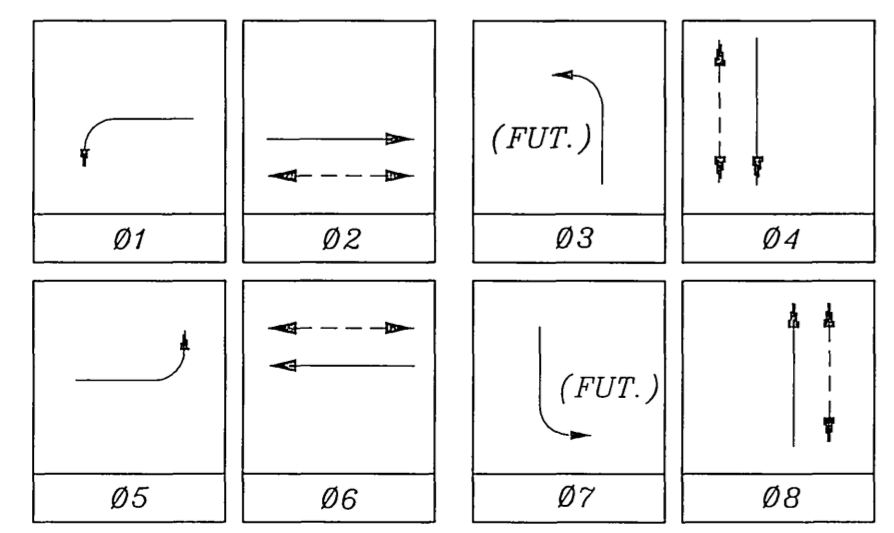

DETAIL SE CORNER

SCALE: 1" = 10'


CITY OF RIVERSIDE, CALIFORNIA DEPARTMENT OF PUBLIC WORKS				TRAFFIC SIGNAL		ACCT. NO.
AS-BUILT PER TE-94-3 MAC 11/00				CENTRAL AVENUE		X-220
AS-BUILT PER BETTERMENT MAC 11/00				@		
AS-BUILT PER ST. WIDENING JMW 8/87				DE ANZA AVENUE		SHEET 1 OF 1
AS-BUILT PER SIGNALIZATION ADD 3/82				SCALE: 1" = 20'		FILE NAME: X220AS.DWG
DESIGNED BY: MAC	DRAWN BY: MAC	CHECKED BY:	APPROVED BY:	DATE:	DATE:	

SCALE:
1"=20'

POLE AND SIGNAL SCHEDULE								
LOCATION	STANDARD	LUMINAIRE	SIGNALS			WALK-DON'T WALK		PPB PHASE
			TYPE	MTG.	LENS SIZE	TYPE	MTG.	
A (E)	56J10G18	20000 MV	2-W3C 1-W3C	B-2 18" MA	3-8" 1-12" 2-8"	-	-	4 (E)
B (E)	TYPE I-10'	SIGNAL DISCONNECT				C(N) 2-W2C	SP-2-T (N)	2 (N)
C (E)	56J10G18	20000 MV	2-W3C(M) 1-W3C	B-2 (M) 18" MA	3-8" 1-12" 2-8"	-	-	2 (E)
D (E)	56J10G18	20000 MV	2-W3C(M) 1-W3C	B-2 (M) 18" MA	3-8" 1-12" 2-8"	-	-	4 (E)
E (E)	56J10G18	20000 MV	2-W3C(M) 1-W3C	B-2 (M) 18" MA	3-8" 1-12" 2-8"	-	-	2 (E)
F (N)	1-A 10'	-	1-W-3C(E) FROM POLE E	TV-1(N)	3-8"	C(N) 2-W2C	SP-2-T (N)	4 (N)
G (N)	1-A 10'	-	1-W-3C(E) FROM POLE C	TV-1(N)	3-8"	C(N) 2-W2C	SP-2-T (N)	4 (N)
H (N)	1-A 10'	-	1-W-3C(E) FROM POLE D	TV-1(N)	3-8"	C(N) 2-W2C	SP-2-T (N)	2 (N)


(E) = EXISTING EQUIPMENT
(N) = NEW EQUIPMENT
(M) = MODIFY

PHASE DIAGRAM

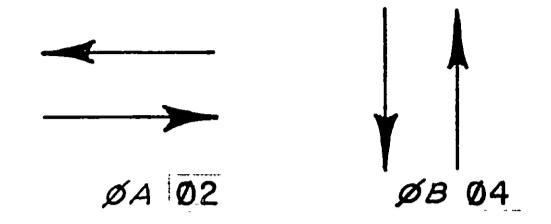

Flashing indications shall be ØA Yellow & ØB Red.

- NOTES-MODIFICATION
1. INSTALL ALL 6'X6' LOOP DETECTORS SHOWN.
 2. PRESSURE PAD DETECTORS SHOWN ARE ABANDONED.
 3. KEEP EXISTING CONDUIT AND CIRCUITS. NEW RUNS ARE A SUPPLEMENT TO THE EXISTING.
 4. REPLACE ALL MAST-ARM SIGNALS WITH ALL 12" HEADS ON MAS MOUNTINGS.
 5. INSTALL BACK PLATES FOR 3-8" HEADS.
 6. FOR ADDITIONAL INFORMATION SEE PLAN No. X-220.
 7. USE EXISTING SERVICE POLE (B). USE EXIST. PB FOR RUN (A). PROTECT SERVICE CONDUCTORS.
 8. INSTALL 6' X 45' TYPE C LOOPS.
 9. REPLACE INTERCONNECT CABLE
 10. X USE 2-CHANNEL SENSOR WITH INTEGRAL ADJUSTABLE EXTENSION TIMER. ONE INPUT TO CONTROLLER AND ONE INPUT FOR SAMPLING.

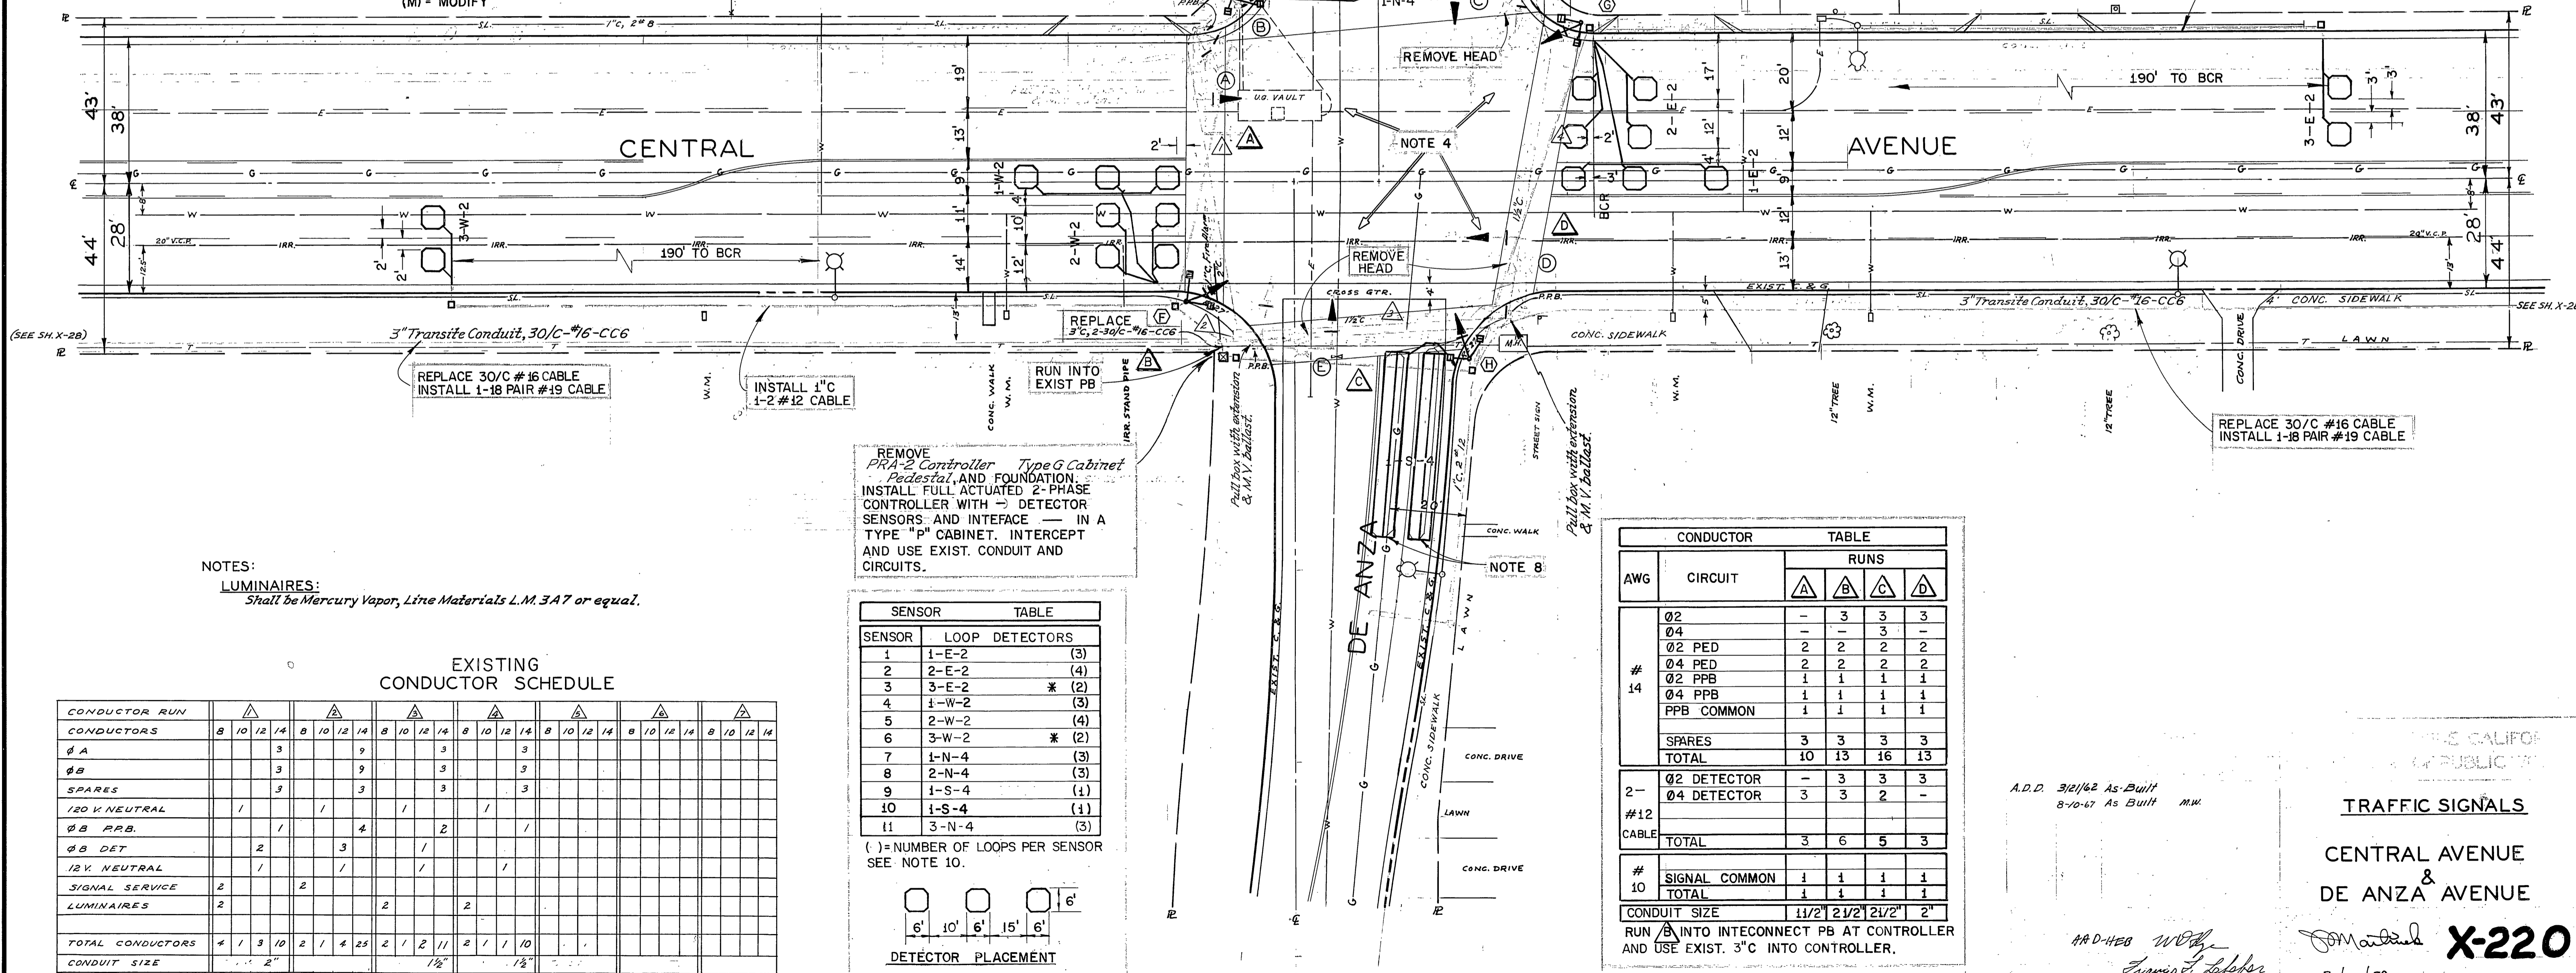

NOTES:
LUMINAIRES:
Shall be Mercury Vapor, Line Materials L.M. 3A7 or equal.


EXISTING CONDUCTOR SCHEDULE

CONDUCTOR RUN	ØA				ØB				ØC				ØD			
	8	10	12	14	8	10	12	14	8	10	12	14	8	10	12	14
CONDUCTORS			3				9				3				3	
SPARES			3				3				3				3	
120 V NEUTRAL	1				1				1				1			
ØB R.R.B.			1				4				2				1	
ØB DET		2				3				1				1		
12V NEUTRAL		1				1				1				1		
SIGNAL SERVICE	2				2											
LUMINAIRES	2								2							
TOTAL CONDUCTORS	4	1	3	10	2	1	4	25	2	1	2	11	2	1	1	10
CONDUIT SIZE	2"				1 1/2"				1 1/2"							

SENSOR TABLE

SENSOR	LOOP DETECTORS	
1	1-E-2	(3)
2	2-E-2	(4)
3	3-E-2	* (2)
4	1-W-2	(3)
5	2-W-2	(4)
6	3-W-2	* (2)
7	1-N-4	(3)
8	2-N-4	(3)
9	1-S-4	(1)
10	1-S-4	(1)
11	3-N-4	(3)

() = NUMBER OF LOOPS PER SENSOR
SEE NOTE 10.

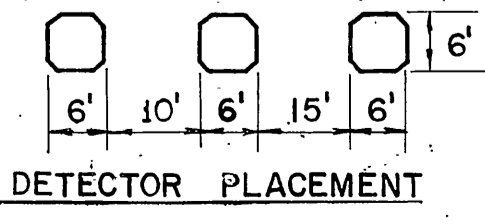

CONDUCTOR	TABLE	RUNS			
		A	B	C	D
# 14	Ø2	-	3	3	3
	Ø4	-	1	3	-
	Ø2 PED	2	2	2	2
	Ø4 PED	2	2	2	2
	Ø2 PPB	1	1	1	1
	Ø4 PPB	1	1	1	1
	PPB COMMON	1	1	1	1
SPARES	3	3	3	3	
TOTAL	10	13	16	13	
# 2	Ø2 DETECTOR	-	3	3	3
	Ø4 DETECTOR	3	3	2	-
	TOTAL	3	6	5	3
# 10	SIGNAL COMMON	1	1	1	1
	TOTAL	1	1	1	1
CONDUIT SIZE		1 1/2"	2 1/2"	2 1/2"	2"

RUN (A) INTO INTERCONNECT PB AT CONTROLLER AND USE EXIST. 3" INTO CONTROLLER.

TRAFFIC SIGNALS

CENTRAL AVENUE & DE ANZA AVENUE

X-220

A.D.D. 3/21/62 As-Built
8-10-67 As-Built M.W.

Handwritten signature and date: 3/10/59

SCALE:
1"=20'

LOCATION	STANDARD	LUMINAIRE	SIGNALS			WALK-DONT WALK		PPB PHASE
			TYPE	MTG.	LENS SIZE	TYPE	MTG.	
A(E)	56J10G18	20000 MV	2-W3C 1-W3C	B-2 18 MA	3-8" 1-12" 2-8"	-	-	4(E) 2(H)
B(E)	TYPE 1-10'	SIGNAL DISCONNECT				C(N) 2-W2C	SP-2-T (N)	2(N)
C(E)	56J10G18	20000 MV	2-W3C(M) 1-W3C	B-2(M) 18 MA	3-8" 1-12" 2-8"	-	-	2(E)
D(E)	56J10G18	20000 MV	2-W3C(M) 1-W3C	B-2(M) 18 MA	3-8" 1-12" 2-8"	-	-	4(E)
E(E)	56J10G18	20000 MV	2-W3C(M) 1-W3C	B-2(M) 18 MA	3-8" 1-12" 2-8"	-	-	2(E)
F(N)	1-A 10'	-	1-W-3C(E) FROM POLE	TV-1(N)	3-8"	C(N) 2-W2C	SP-2-T (N)	4(N)
G(N)	1-A 10'	-	1-W-3C(E) FROM POLE	TV-1(N)	3-8"	C(N) 2-W2C	SP-2-T (N)	4(N)
H(N)	1-A 10'	-	1-W-3C(E) FROM POLE	TV-1(N)	3-8"	C(N) 2-W2C	SP-2-T (N)	2(N)

(E) = EXISTING EQUIPMENT
(N) = NEW EQUIPMENT
(M) = MODIFY


SEE NOTE
Pedestrian Push Buttons & Pedestrian Indications to be installed on Pole @ Loc. @

Delete installation of Run A conductors to be installed in exist. conduit

REMOVE PRA-2 Controller Type G Cabinet Pedestal and FOUNDATION. INSTALL FULL ACTUATED 2-PHASE CONTROLLER WITH - DETECTOR SENSORS AND INTERFACE - IN A TYPE "P" CABINET. INTERCEPT AND USE EXIST. CONDUIT AND CIRCUITS.



SENSOR	LOOP DETECTORS
1	1-E-2 (3)
2	2-E-2 (4)
3	3-E-2 * (2)
4	1-W-2 (3)
5	2-W-2 (4)
6	3-W-2 * (2)
7	1-N-4 (3)
8	2-N-4 (3)
9	1-S-4 (1)
10	1-S-4 (1)
11	3-N-4 (3)

() = NUMBER OF LOOPS PER SENSOR
SEE NOTE 10.

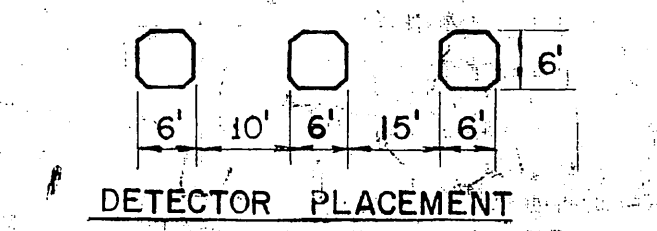

NOTES-MODIFICATION

- INSTALL ALL 6'X6' LOOP DETECTORS SHOWN.
- PRESSURE PAD DETECTORS SHOWN ARE ABANDONED.
- KEEP EXISTING CONDUIT AND CIRCUITS. NEW RUNS ARE A SUPPLEMENT TO THE EXISTING.
- REPLACE ALL MAST-ARM SIGNALS WITH ALL 12" HEADS ON MAS MOUNTINGS.
- INSTALL BACK PLATES FOR 3-8" HEADS.
- FOR ADDITIONAL INFORMATION SEE PLAN No. X-220.
- USE EXISTING SERVICE POLE - USE EXIST. PB FOR RUN - PROTECT SERVICE CONDUCTORS.
- INSTALL 6' X 45' TYPE C LOOPS.
- REPLACE INTERCONNECT CABLE
- * USE 2-CHANNEL SENSOR WITH INTEGRAL ADJUSTABLE EXTENSION TIMER ONE INPUT TO CONTROLLER AND ONE INPUT FOR SAMPLING.

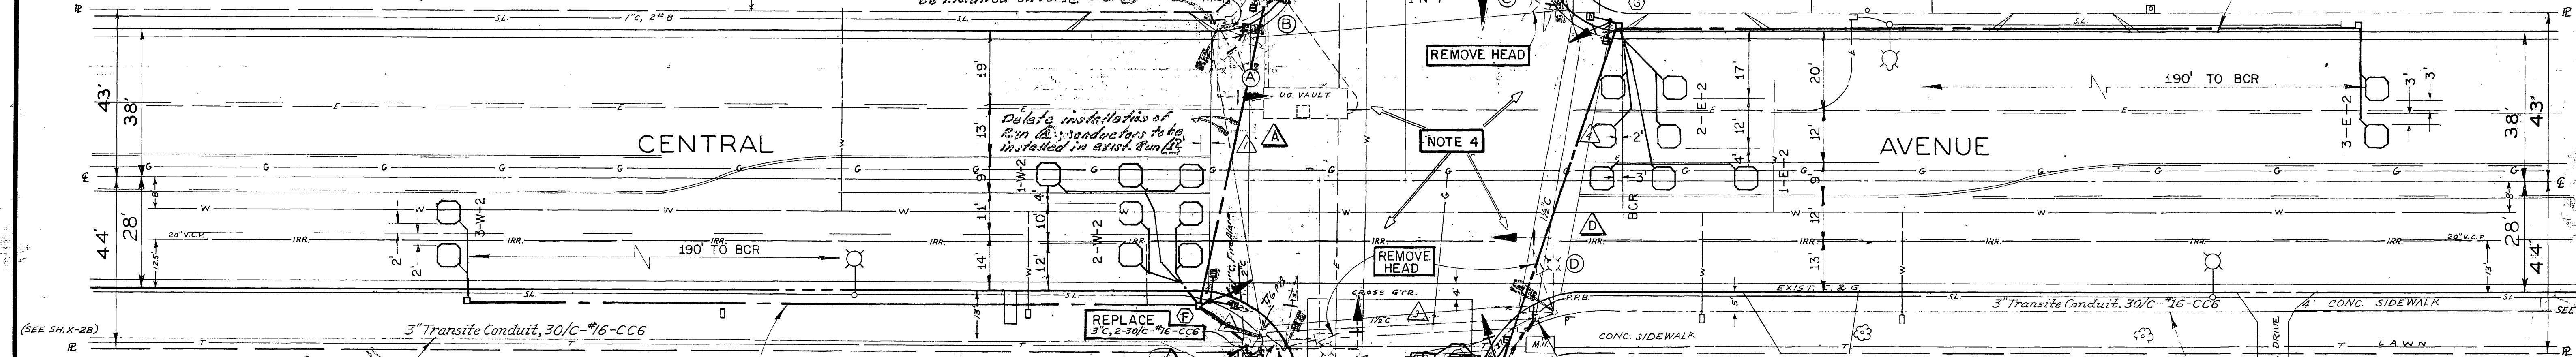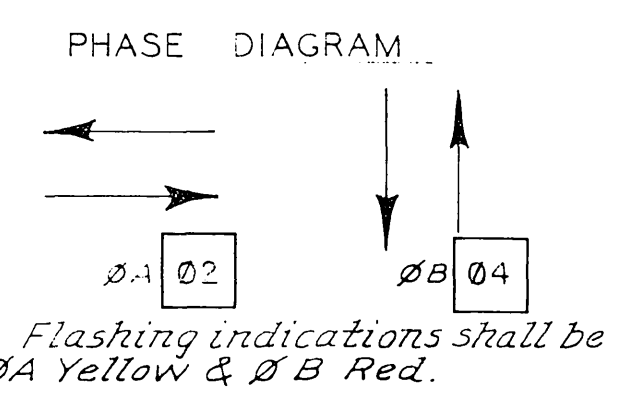

Mike
KEEP FOR
"AS BUILTS"

NOTES:
LUMINAIRES:
Shall be Mercury Vapor, Line Materials L.M. 347 or equal.

EXISTING CONDUCTOR SCHEDULE

CONDUCTOR RUN	A				B				C				D			
	8	10	12	14	8	10	12	14	8	10	12	14	8	10	12	14
CONDUCTORS																
Ø A			3				9				3				3	
Ø B				3			9				3				3	
SPARES			3				3				3				3	
120 V NEUTRAL		1				1				1				1		
Ø B P.B.			1				4				2				1	
Ø B DET			2				3				1				1	
12 V NEUTRAL				1				1				1				1
SIGNAL SERVICE	2				2											
LUMINAIRES	2					2				2						
TOTAL CONDUCTORS	4	1	3	10	2	1	4	25	2	1	2	11	2	1	1	10
CONDUIT SIZE			2"				1 1/2"				1 1/2"				1 1/2"	

NEW CONDUCTOR	CIRCUIT	RUNS			
		A	B	C	D
# 14	Ø2	-	3	3	3
	Ø4	-	-	3	-
	Ø2 PED	2	2	2	2
	Ø4 PED	2	2	2	2
	Ø2 PPB	1	1	1	1
	Ø4 PPB	1	1	1	1
PPB COMMON		1	1	1	1
SPARES		3	3	3	3
TOTAL		10	13	16	13
# 2	Ø2 DETECTOR	-	3	3	3
	Ø4 DETECTOR	3	3	2	-
TOTAL		3	6	5	3
# 10	SIGNAL COMMON	1	1	1	1
	TOTAL	1	1	1	1
CONDUIT SIZE		1 1/2"	2 1/2"	2 1/2"	2"

RUN A INTO INTERCONNECT PB AT CONTROLLER AND USE EXIST. 3"C INTO CONTROLLER.

PREPARED BY:
M.P.A.
MOHLE, PERRY & ASSOC.
DESIGN ENGR. R.C.E. 10692 DATE

REVISIONS		CITY OF RIVERSIDE CALIFORNIA DEPARTMENT OF PUBLIC WORKS
MARK	DATE	
		TRAFFIC SIGNALS
		CENTRAL AVENUE & DE ANZA AVENUE
DESIGNED BY	CHECKED BY	APPROVED BY
DRAWN BY		DIRECTOR OF PUBLIC WORKS
RECOMMENDED BY	ASSISTANT CITY ENGINEER	DATE

X-220
SHEET 47 OF 50

Contractor's Field Copy
JWD 12/10/84