


EQUIPMENT SCHEDULE

NO.	SIGNAL STANDARD		LUMINAIRE		I.I.S.N.S.		SIGNAL MOUNTINGS			PPB PHASE	
	TYPE	H'GHT	M.A.	L.A.	H.P.S.V.	LEGEND	VEHICLE	PEDESTRIAN	AUDIBLE		
(A)	24-4-80	30'	35'	12'	200W	ADAMS	SY 2800	MAS			
								MAS			
								SV-1-T	SP-1-T	((C1))	6
(B)	1A	10'						TV-1-T	SP-1-T	((P1))	8
(C)	26-4-80	30'	45'	12'	250W	LINCOLN	AV 5300	MAS			
								MAS			
								SV-1-T	SP-1-T	((P1))	8
(D)	1A	10'						TV-1-T	SP-1-T	((C1))	2
(E)	24-4-80	30'	35'	12'	200W	ADAMS	SY 2800	MAS			
								MAS			
								SV-1-T	SP-1-T	((C1))	2
(F)	1A	10'						TV-1-T	SP-1-T	((P1))	4
(G)	26-4-80	30'	45'	12'	250W	LINCOLN	AV 5300	MAS			
								MAS			
								SV-1-T	SP-1-T	((P1))	4
(H)	1A	10'						TV-1-T	SP-1-T	((C1))	6

NOTES: 1. ALL VEHICULAR HEADS HAVE 12" LENSES.
2. ALL LEFT TURN HEADS HAVE ALL ARROWS.

CONDUCTOR TABLE


CONTROL FUNCTION	CONDUCTORS	CONDUCTOR RUNS							
		1	2	3	4	5	6	7	8
VEHICLE & PEDESTRIAN HEADS, PEDESTRIAN PUSH BUTTONS, SPARES & COMMONS	12 WIRE IMSA 9 WIRE IMSA 5 WIRE IMSA 3 WIRE IMSA	1	1	2	2	4	1	1	
DETECTOR CABLE	#16/2					1	1		
PHASE 1						3	3	3	3
PHASE 2 BIKE (FUT.)						1	1	1	1
PHASE 3						1	1		
PHASE 4			2	2	2	2			
PHASE 5						1	1	1	1
PHASE 6						2	2		
PHASE 6 BIKE (FUT.)						1	1		
PHASE 7			1	1	1	1			
PHASE 8						2	2		
I.I.S.N.S.	#12	2	2	2	2			2	2
LUMINAIRES	#8	2	2	2	2			2	2
SIGNAL SERVICE	#6							2	
CONDUIT SIZE		2"	2.5"	3"	3"	2-3"	3"	3"	2"

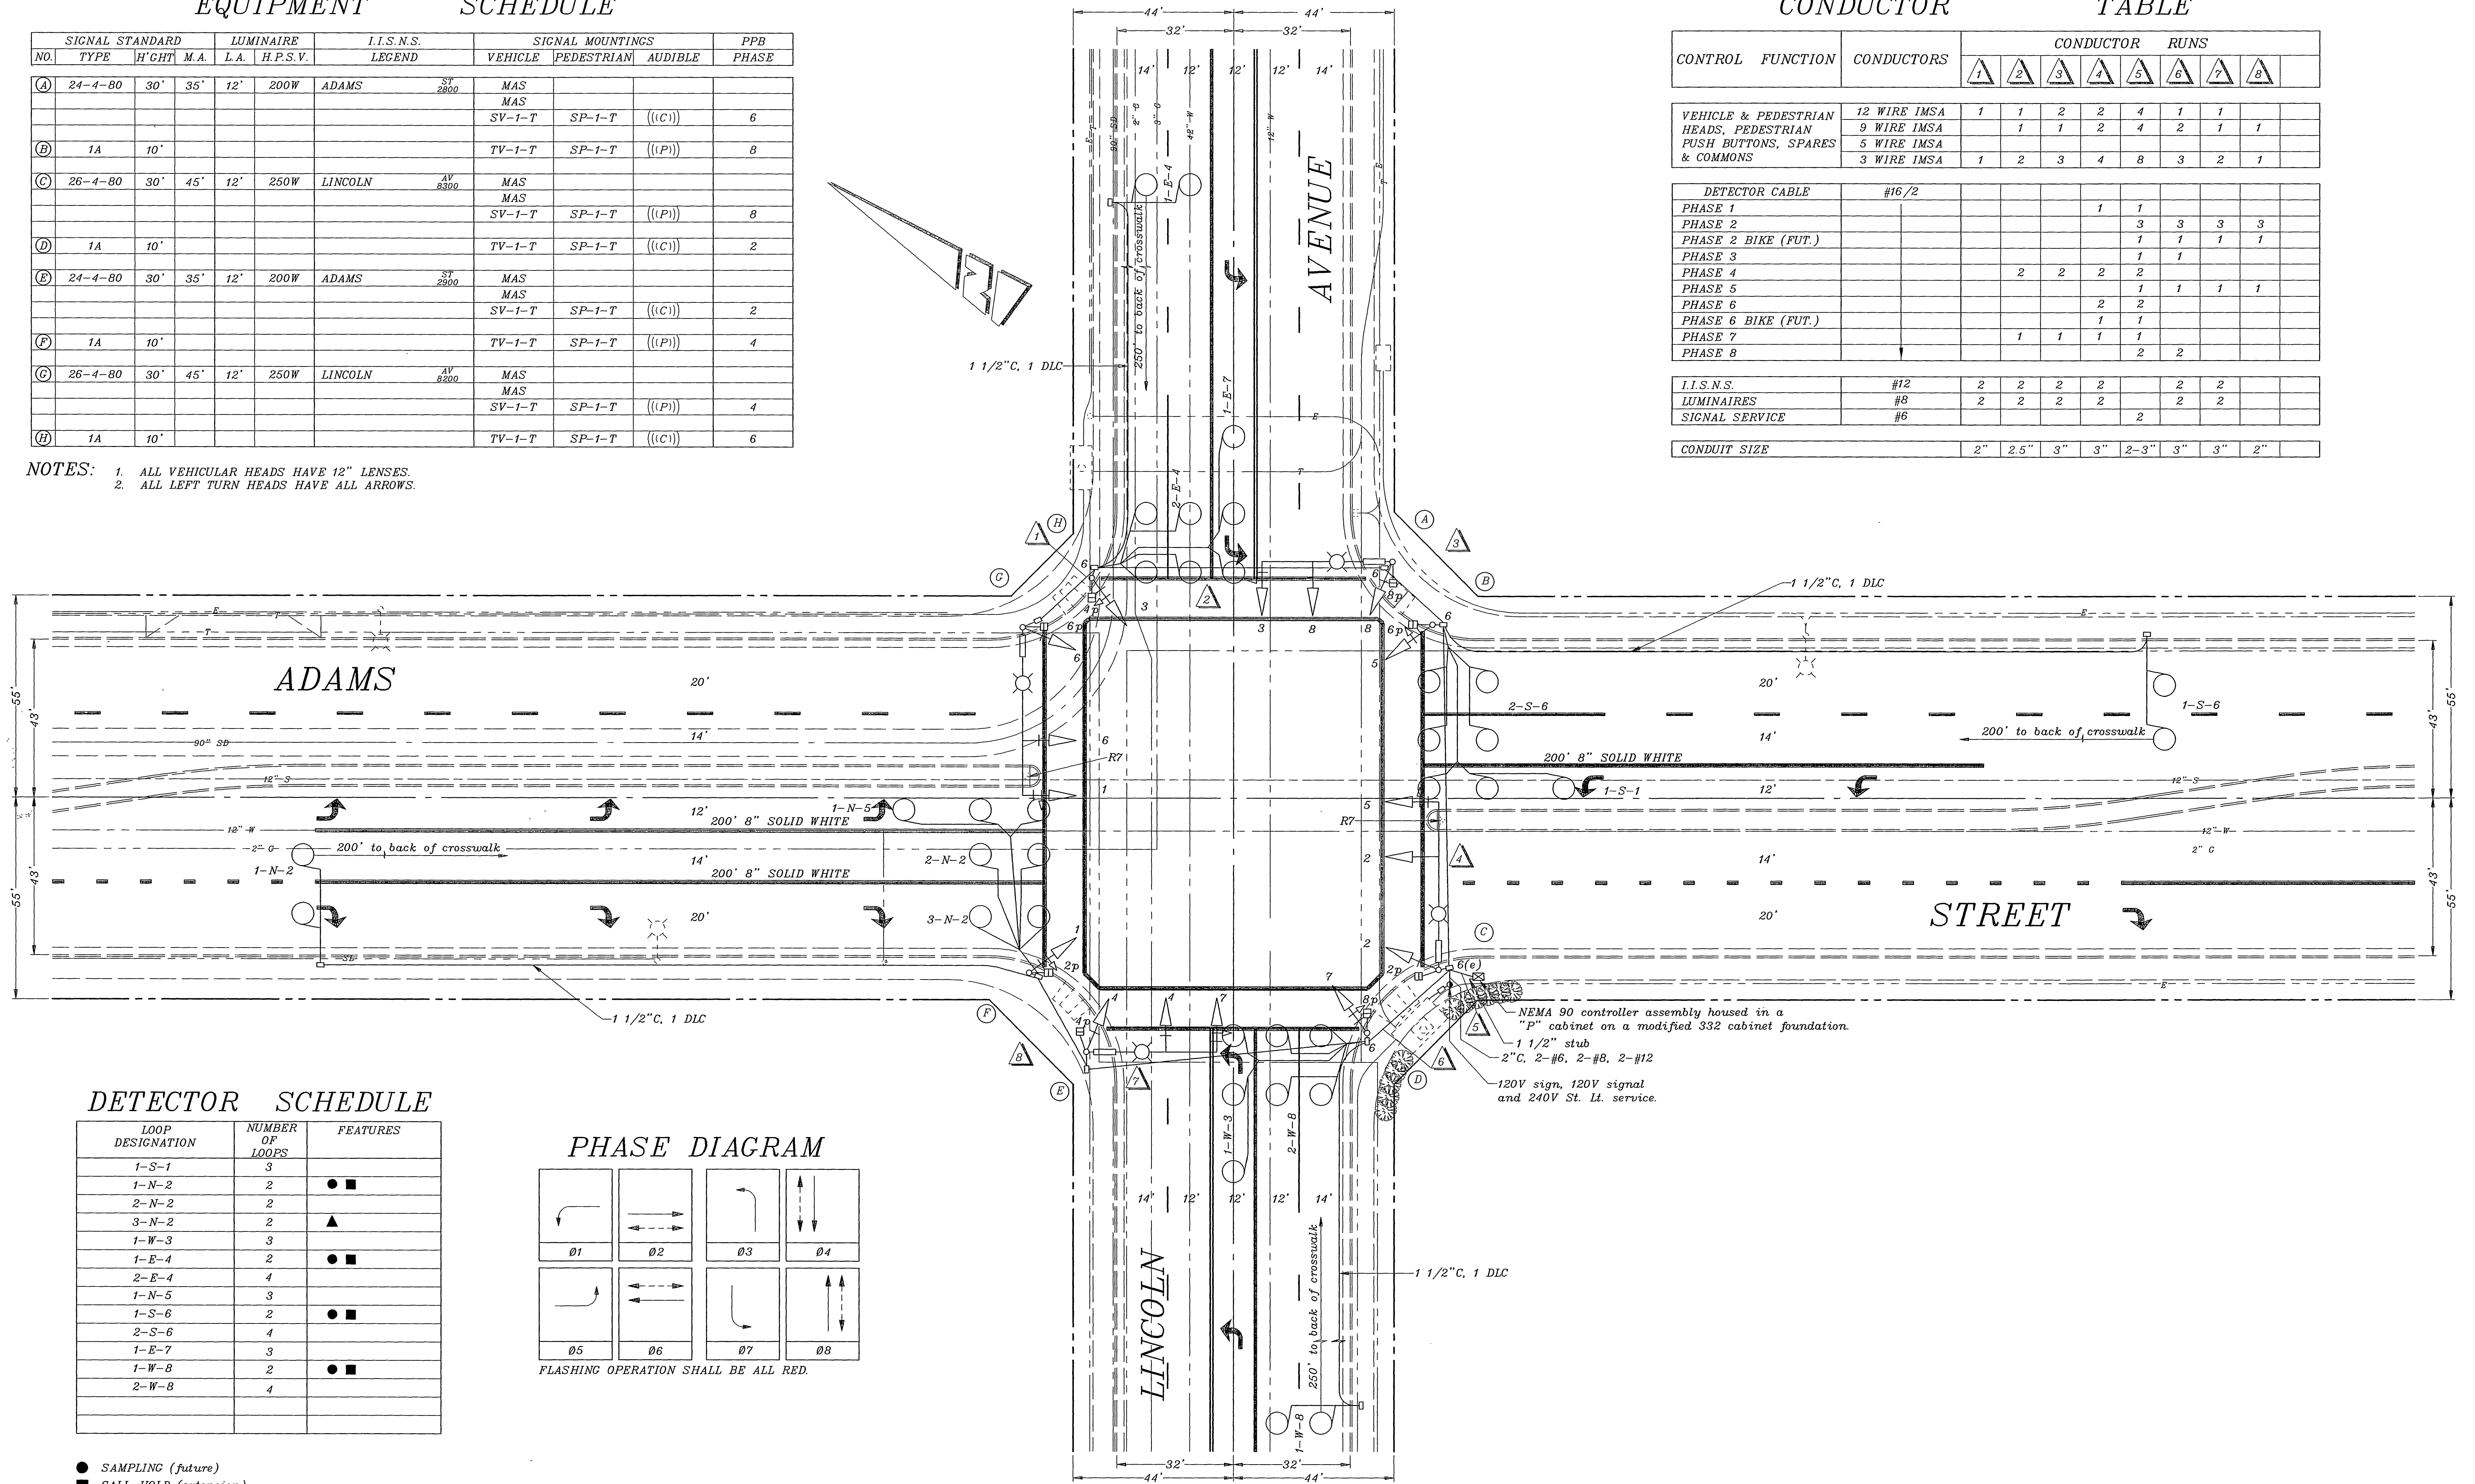

DETECTOR SCHEDULE


LOOP DESIGNATION	NUMBER OF LOOPS	FEATURES
1-S-1	3	
1-N-2	2	● ■
2-N-2	2	
3-N-2	2	▲
1-W-3	3	
1-E-4	2	● ■
2-E-4	4	
1-N-5	3	
1-S-6	2	● ■
2-S-6	4	
1-E-7	3	
1-W-8	2	● ■
2-W-8	4	

PHASE DIAGRAM

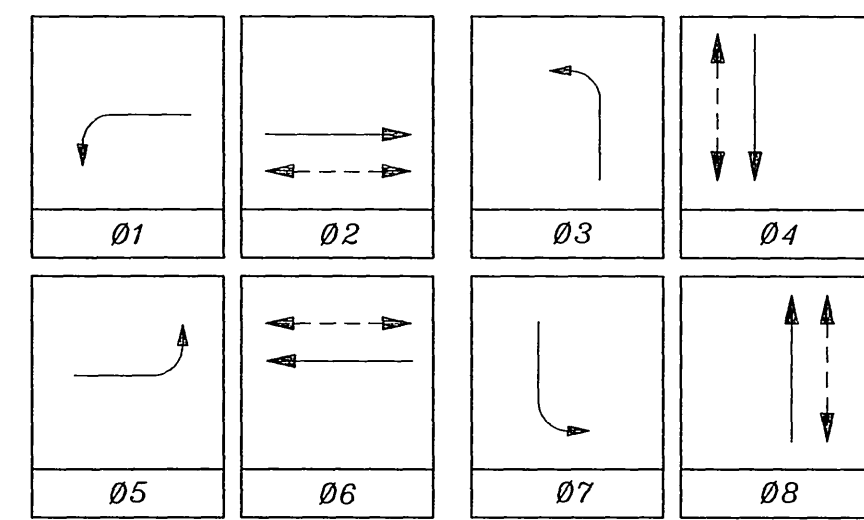

FLASHING OPERATION SHALL BE ALL RED.

● SAMPLING (future)
■ CALL-HOLD (extension)
▲ DELAY
Detectors shall be 2-channel rack-mounted.

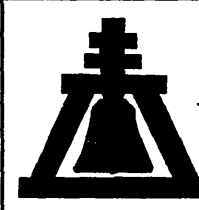

ENGINEER IN RESPONSIBLE CHARGE

RICHARD D. McGRATH
R.C.E. No. 31952 expires _____

DATE _____

APPROVED BY	BY	DATE	APPROVED BY
AS-BUILT PER SIGNALIZATION	MAC	1/96	P.W. INSPECTION
MARK	REVISIONS	APPR. DATE	TRAFFIC DIVISION
DESIGNED BY	DRAWN BY	MAC	CHIEF P.W. ENGR.
	CHECKED BY		PUBLIC UTILITIES

CITY OF RIVERSIDE, CALIFORNIA
DEPARTMENT OF PUBLIC WORKS

PRINCIPAL ENGINEER	BY	DATE	DIRECTOR OF PUBLIC WORKS

TRAFFIC SIGNAL
ADAMS STREET
@
LINCOLN AVENUE

SCALE: 1" = 20'

ACCT. NO.

X-239

SHEET 1 OF 1

FILE NAME: X239.DWG