
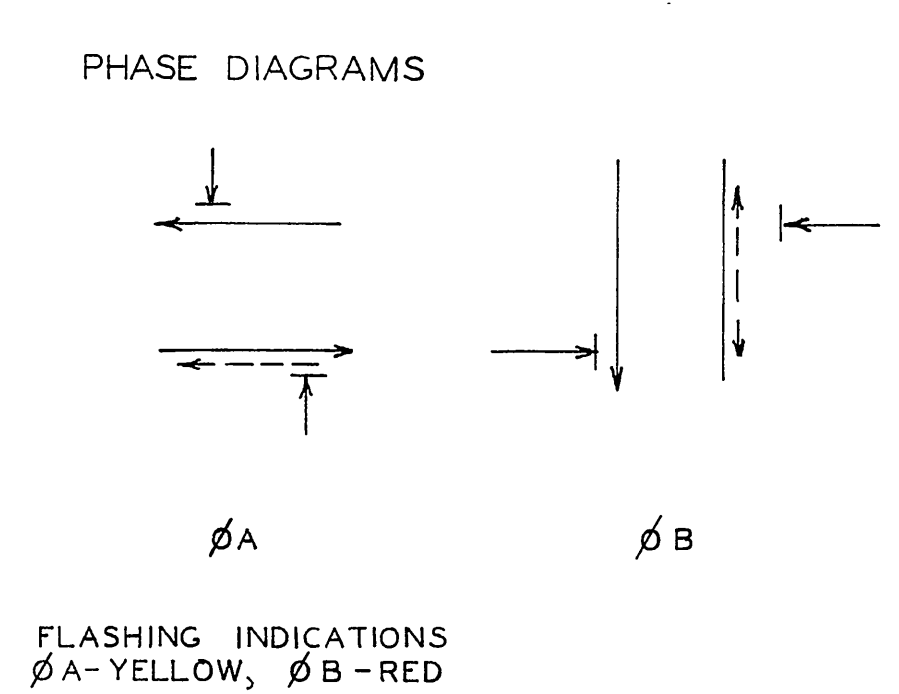


CONDUCTOR SCHEDULE

CONDUCTOR RUN	1				2				3				4				5				6				7				8				9							
CONDUCTORS	8	10	12	14	8	10	12	14	8	10	12	14	8	10	12	14	8	10	12	14	8	10	12	14	8	10	12	14	8	10	12	14	8	10	12	14				
Ø A																																								
Ø A, W-DW																																								
Ø B																																								
Ø B, W-DW																																								
SPARES																																								
120 V. NEUTRAL																																								
Ø B P.P.B.																																								
Ø B DET.																																								
12 V. NEUTRAL																																								
LUMINAIRES																																								
TOTAL CONDUCTORS	2	1	5	25	2	1	3	19	2	1	3	18	2	1	3	14	2	1	2	8	2	1	2	8	2	1	2	8	2	1	2	8	2	1	2	8	2	1	2	8
CONDUIT SIZE	2 1/2" C				2 1/2" C				2 1/2" C				2" C				1 1/2" C				1 1/2" C				1 1/2" C				1 1/2" C											

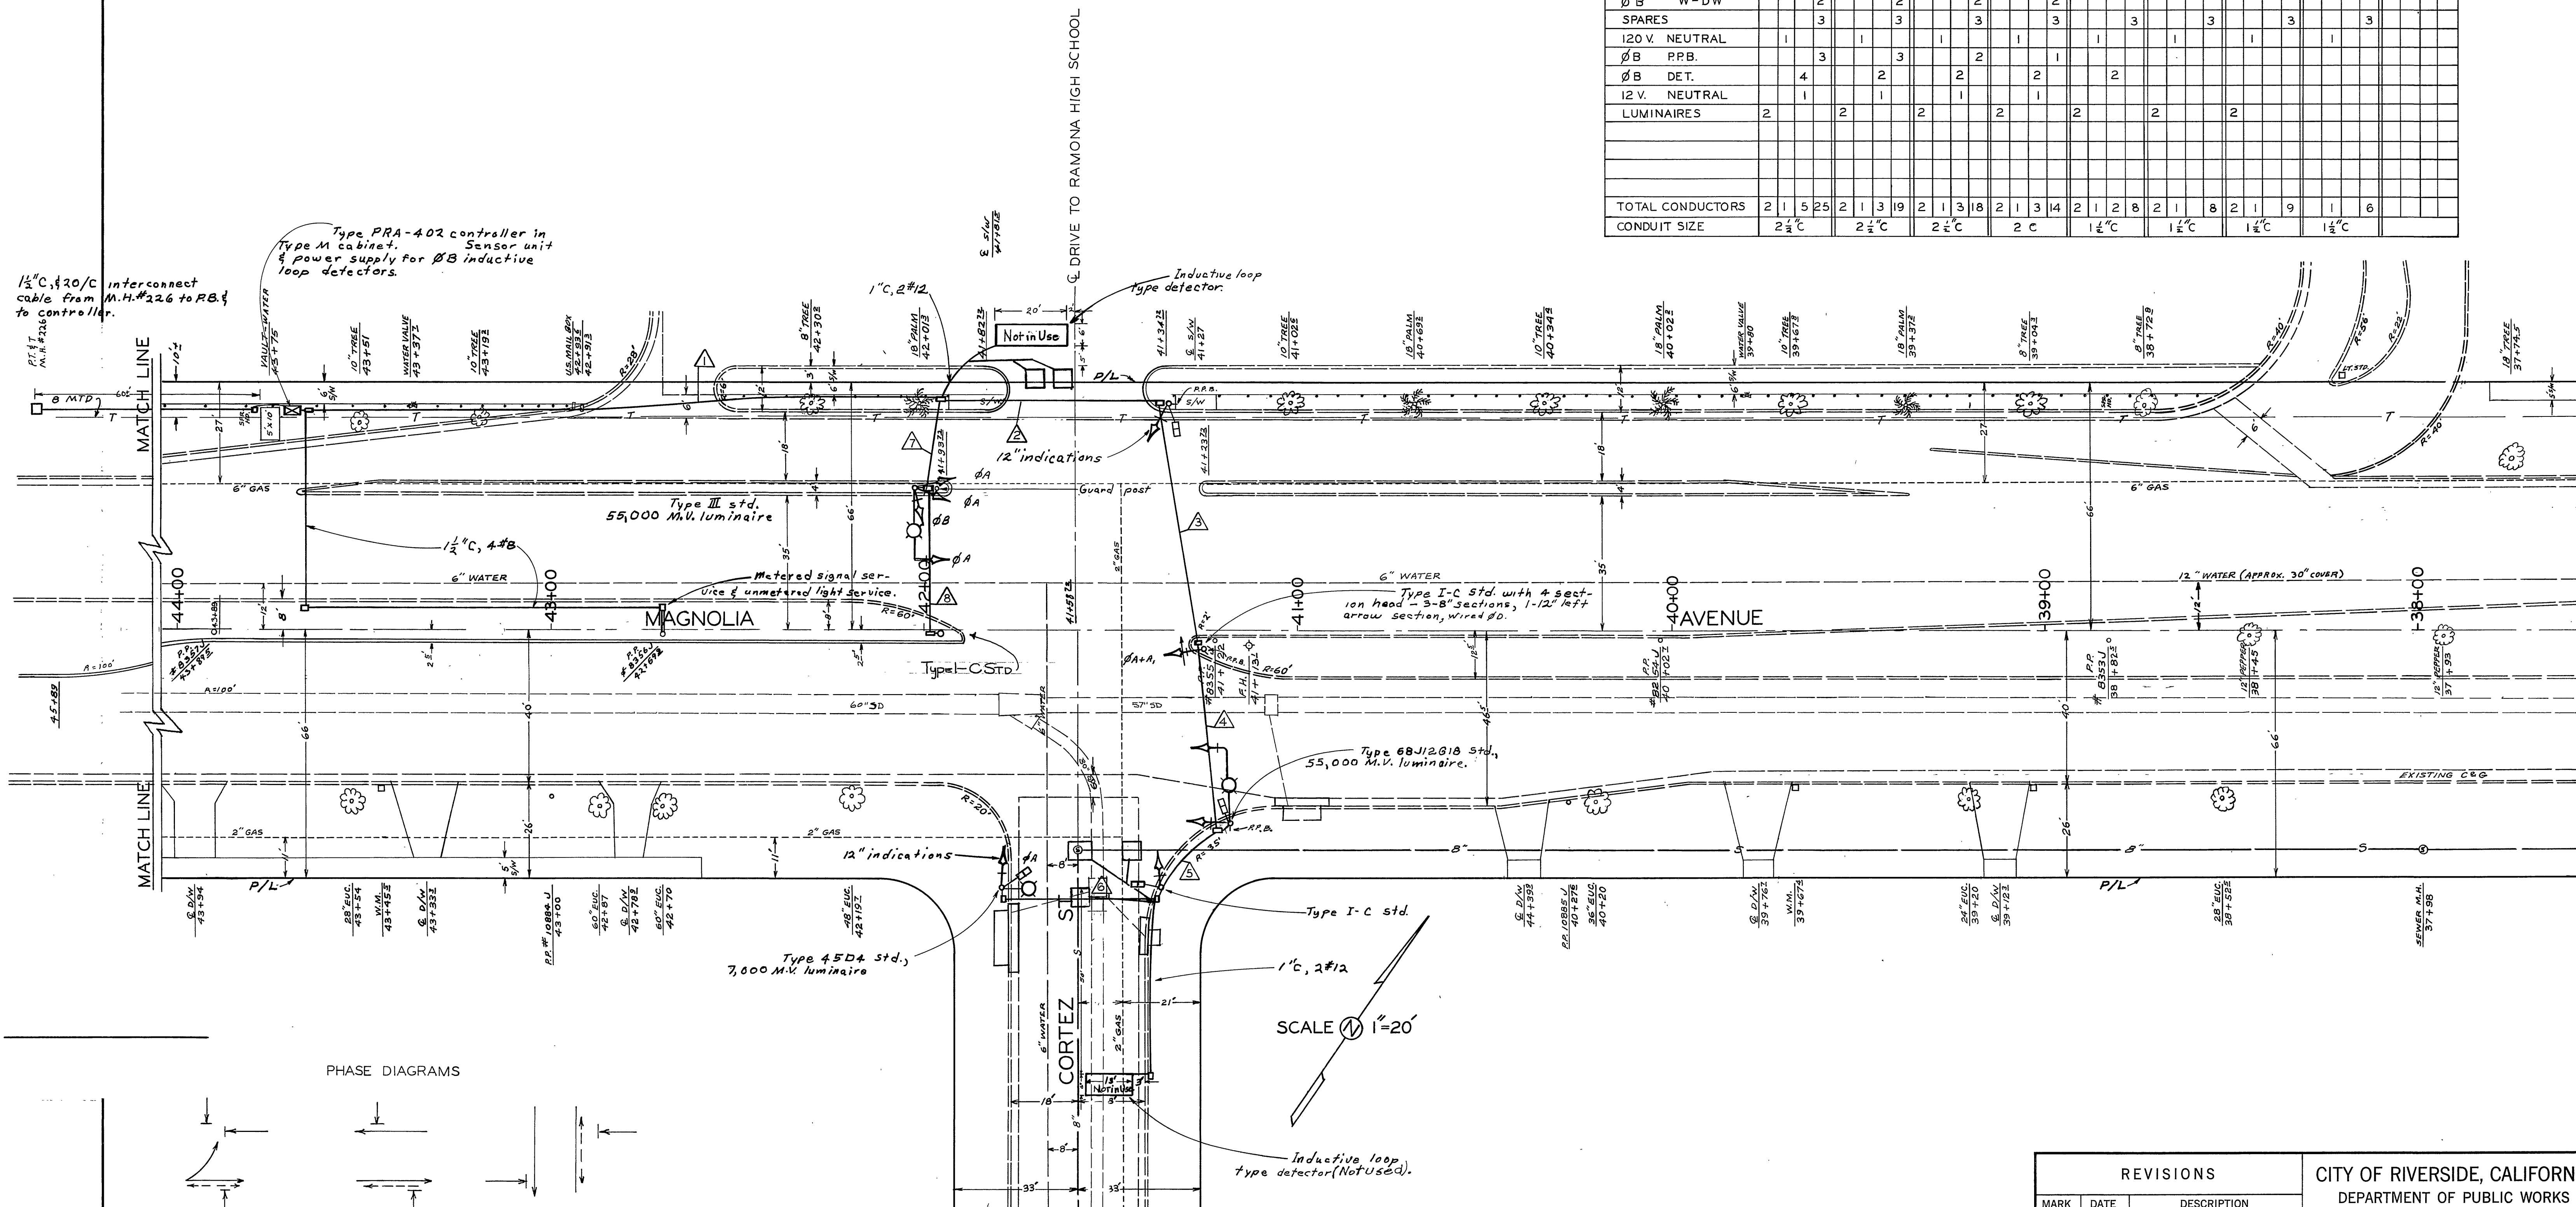

REVISIONS			CITY OF RIVERSIDE, CALIFORNIA DEPARTMENT OF PUBLIC WORKS	
MARK	DATE	DESCRIPTION		
	2/18/65	As Built	A.B.D.	
	6/20/72	Remove w/s median	J.M.W.	
	7/1/74	Loop modification	P.L.B.	
	3/7/77	As Built - STORM DRAIN		
DESIGNED BY	SUBMITTED BY		APPROVED BY	PROJ. NO.
DRAWN BY <i>RK</i>	PARK DEPT.	TRAFFIC DIV.	DIRECTOR OF PUBLIC WORKS	<b>X-301A</b>
CHECKED BY	RECOMMENDED BY		DATE	SHEET OF
	ASSISTANT CITY ENGINEER			