
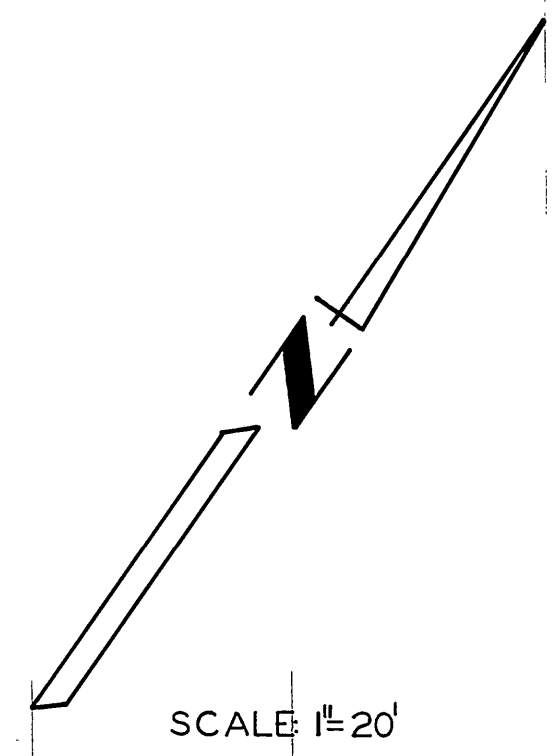


RIVERSIDE COUNTY HOSPITAL

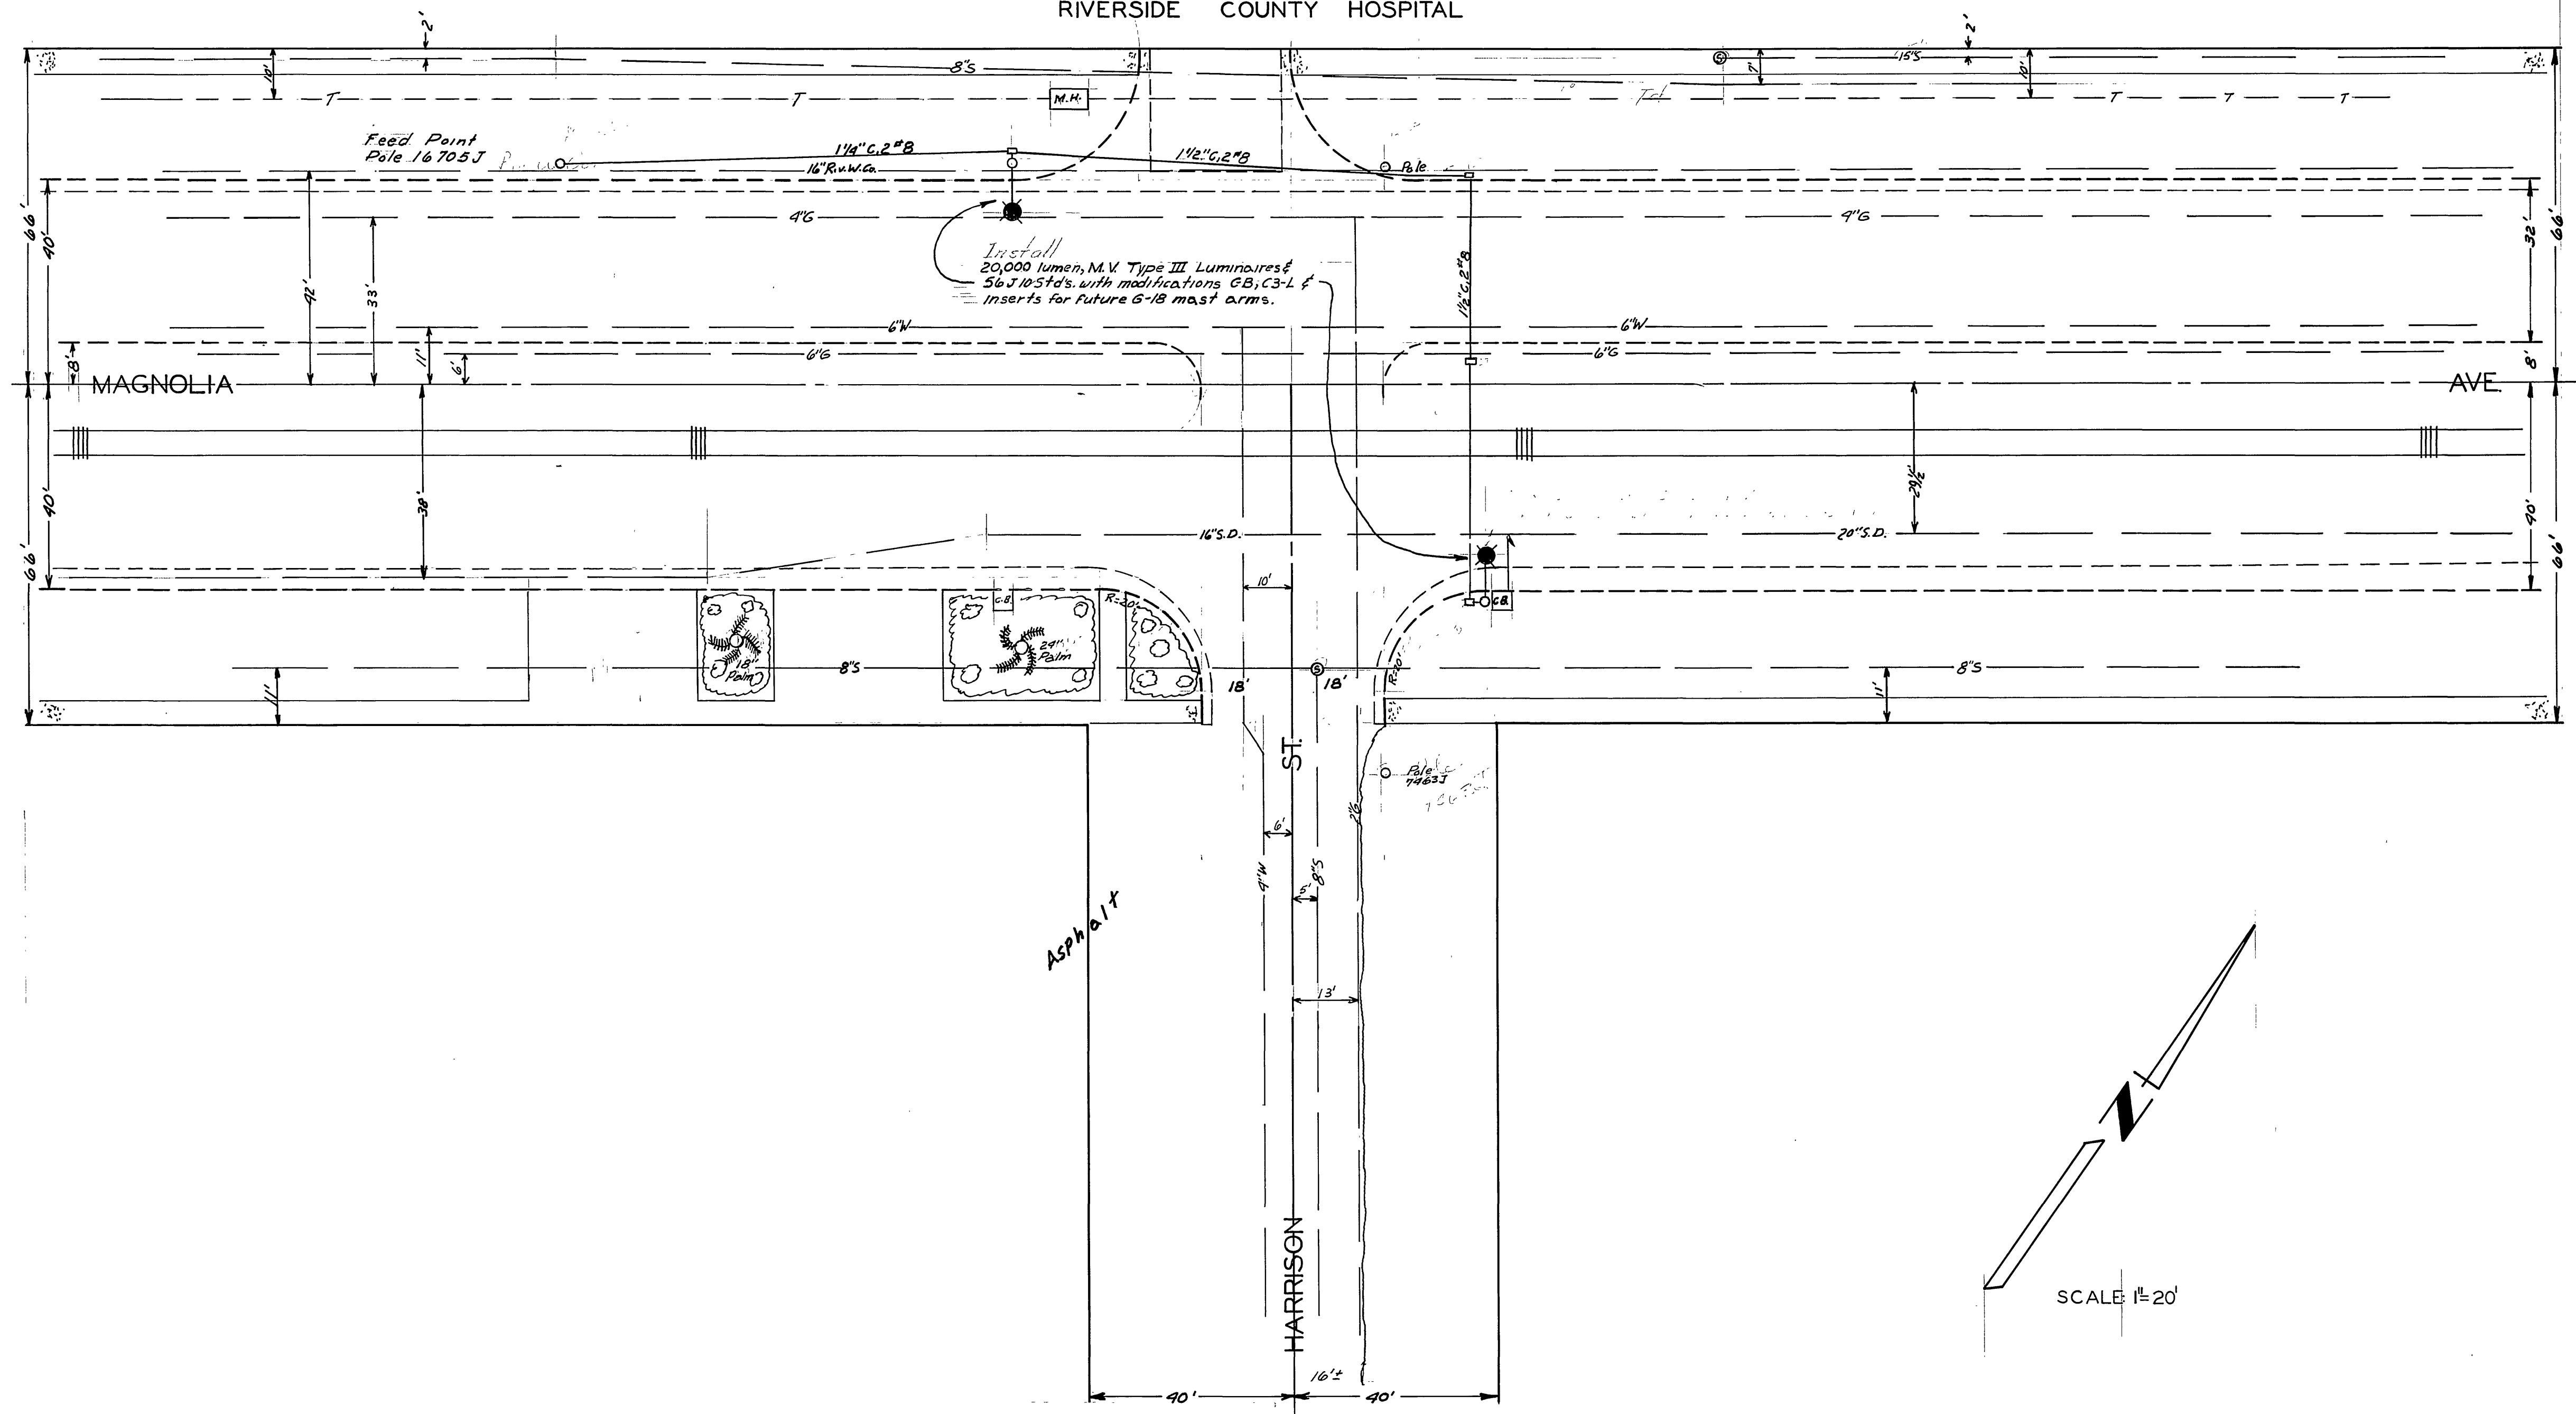

3/19/62 At-Built AOR.

MAGNOLIA AVE.
&
HARRISON ST. SO.

A.D.D. *Mohr*
M.A. Chas
3/20/62

X-312