



EQUIPMENT SCHEDULE

NO.	SIGNAL STANDARD				LUMINAIRE		I.S.N.S.		SIGNAL MOUNTINGS			PPB PHASE
	TYPE	H'GHT	M.A.	L.A.	H.P.S.V.	LEGEND	VEHICLE	PEDESTRIAN	AUDIBLE			
(A)	26A-3-70	35'	40'	15'	400W		MAS				6	
							MAS					
							SV-1-T	SP-1-T	N/A			
(B)	1A	10'					TV-1-T	SP-1-T	N/A		6	
(C)	TYPE 19	35'	30'	10'	400W		MAS				2	
							SV-2-T	SP-1-T	N/A			
(D)	TYPE 17	35'	18'	10'	250W	TYLER	MAS				2	
							SV-2-T	SP-1-T	N/A			
(E)	26A-4-70	35'	45'	15'	400W		MAS				2	
							MAS					
							SV-1-T	SP-1-T	N/A			
(F)	1A	10'					TV-1-T	SP-1-T	N/A		2	
(G)	19-4-70	35'	30'	15'	400W		MAS				6	
							SV-2-T	SP-1-T	N/A			
(H)	TYPE 17	35'	18'	10'	200W	TYLER	MAS				6	
							SV-2-T	SP-1-T	N/A			

CONDUCTOR TABLE

CONTROL FUNCTION	CONDUCTORS	CONDUCTOR RUNS-WB RAMPS								CONDUCTOR RUNS-EB RAMPS															
		1	2	3	4	5	6	7	8	9	10	11	12	13	14	15	16								
VEHICLE & PEDESTRIAN HEADS, PEDESTRIAN PUSH BUTTONS, SPARES & COMMONS	12CSC 3CSC	1	5	4	4	3	2	2	1	1	1	2	4	4	1	1	1	2	4	4	1	1			
DETECTOR CABLE	#16/2																								
PHASE 1			1	1	1																				
PHASE 2			4	4								2	2	2											
PHASE 3																									
PHASE 4			2																						
PHASE 5			3									2	2	2											
PHASE 6			2	2	2							4	4	4		4									
PHASE 7																									
PHASE 8												3	5	5	5										
TOTALS			4	12	3	3						3	9	13	13	4									
INTERCONNECT CABLE	6 PR #20											1	1	1	1	1	1	1	1	1	1	1			
MASTER INTERC. CABLE	6 PR #19		1	1								1	1	1	1	1	1	1	1	1	1	1			
RR PRE-EMPT	3CSC											2	2	2		2	2	2							
TELEPHONE CABLE	4 #18															1									
LUMINAIRES	#8	2		2	2	2	2	2			2	2			2										
SIGNAL SERVICE	#6	2		2																					
SIGNS(BRIDGE)	#8		2																						
SIGNAL SERVICE(RAMP)	#6										2														
TELEPHONE SERVICE	#12										2														
COMMON	#8	1	1	1	1	1	1	1	1	1	1	1	1	1	1	1									
VEHICLE PREEMPTION	#19	1(N)	1(N)	1(N)	1(N)	1(N)	1(N)	1(N)	1(N)	1(N)	1(N)	2(N)	2(N)												
CONDUIT SIZE		2.5"	2"	2-3"	3"	3"	3"	3"	3"	3"	3"	2.5"	3.5"	2-3"	2-3"	2.5"	1.5"	2"	2"						



N = NEW EQUIPMENT TO BE PROVIDED AND INSTALLED. ALL OTHER EQUIPMENT, UNLESS OTHERWISE INDICATED, EXISTS AND SHALL REMAIN IN PLACE.

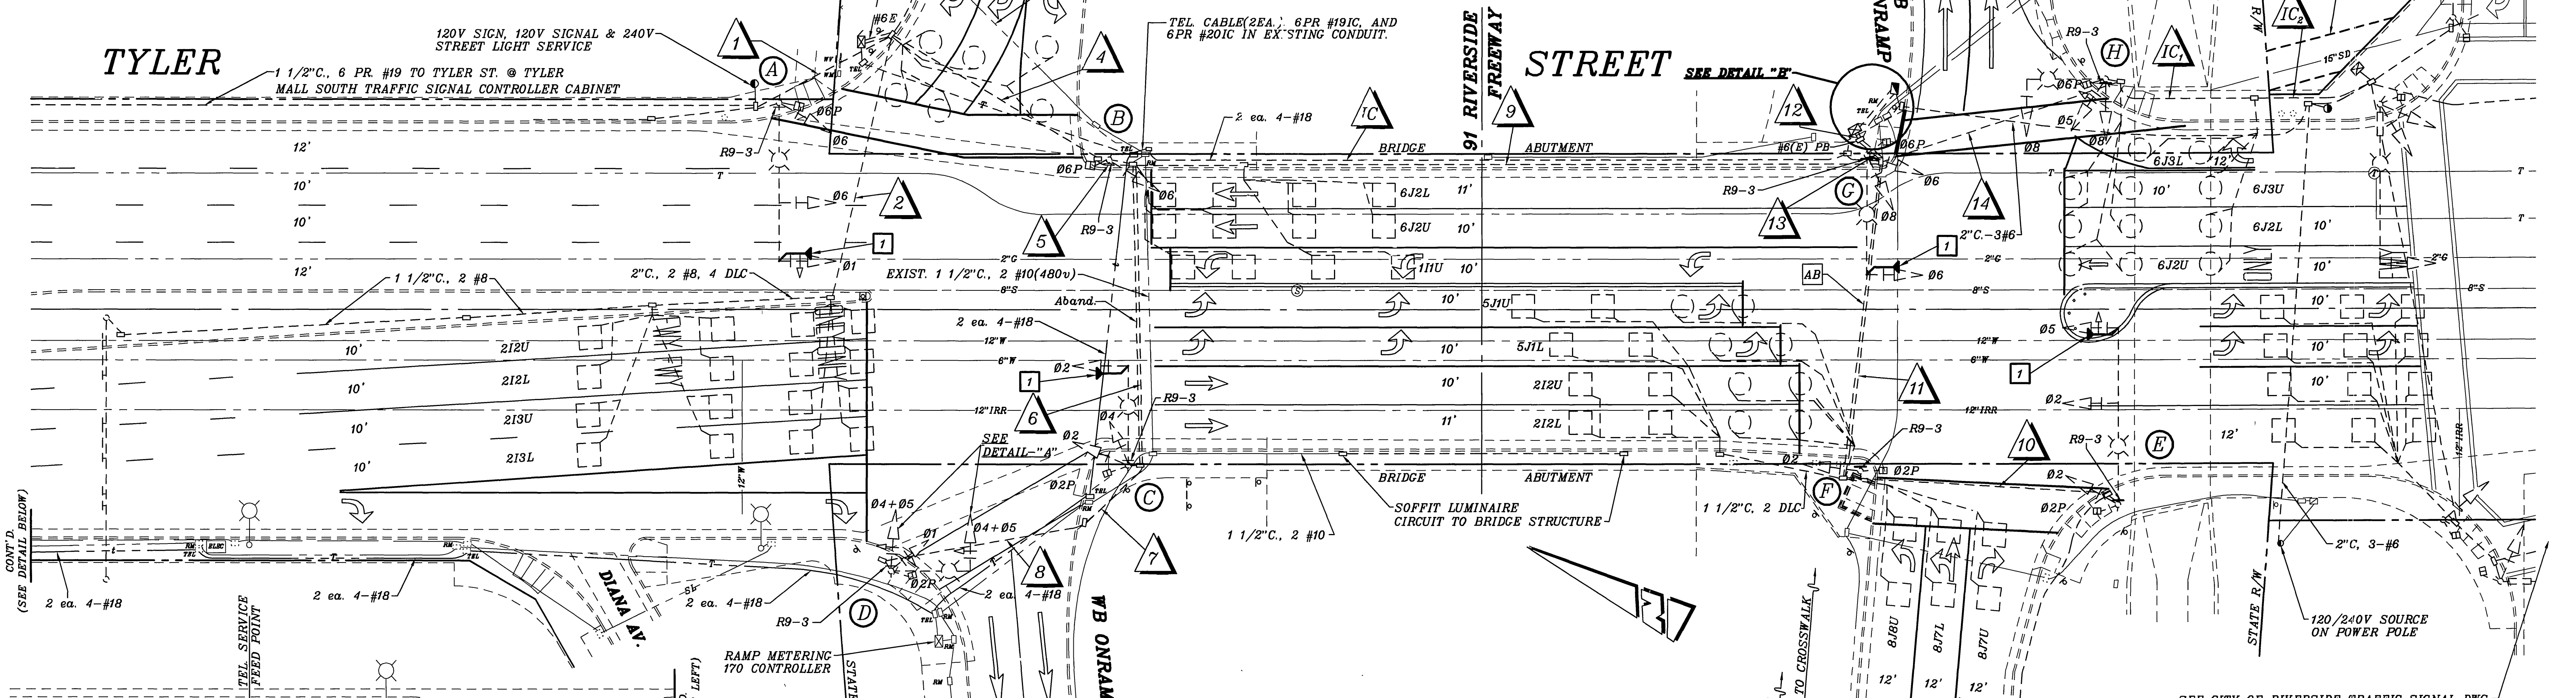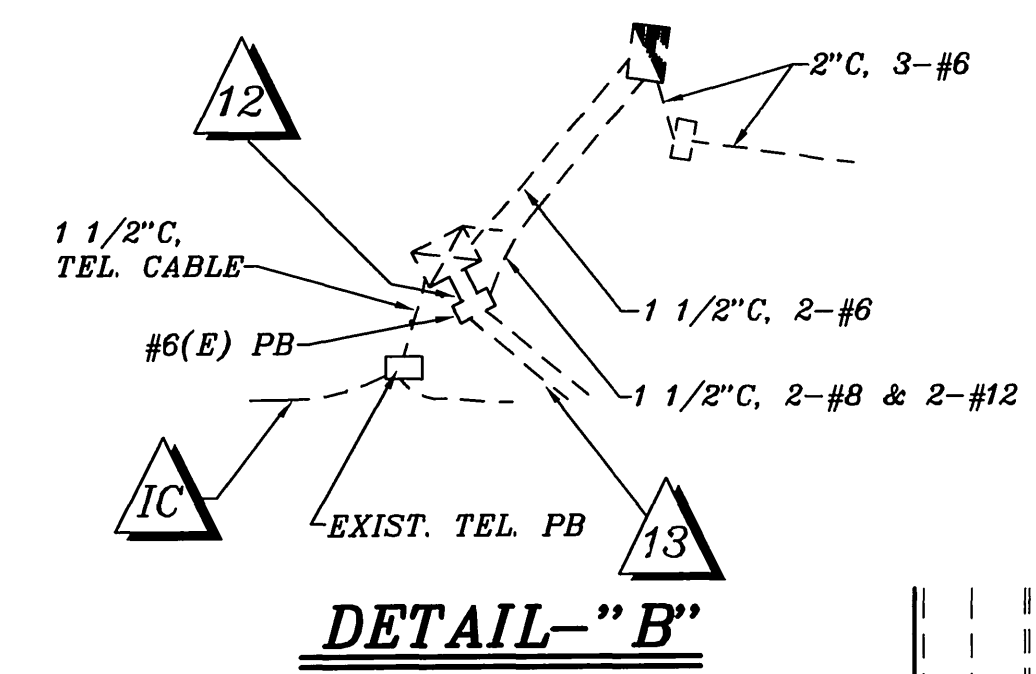

CONSTRUCTION NOTES


1 - INSTALL VEHICLE PREEMPTION DETECTOR PER CALTRANS 2006 STANDARD PLANS ES-4E. EXACT LOCATION OF DETECTOR SHALL BE DETERMINED BY THE ENGINEER'S REPRESENTATIVE IN THE FIELD.

PHASE DIAGRAM WB RAMPS

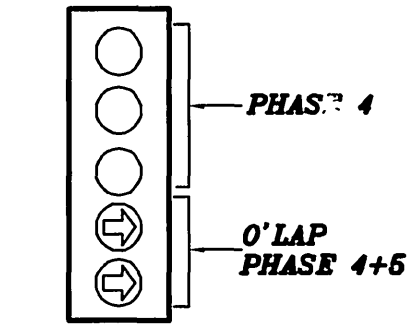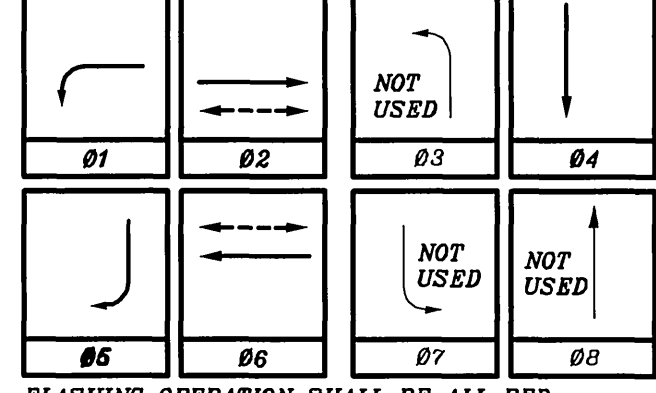

PHAS: 4
O'LAP PHASE 4+5
FLASHING OPERATION SHALL BE ALL RED.

PHASE DIAGRAM EB RAMPS

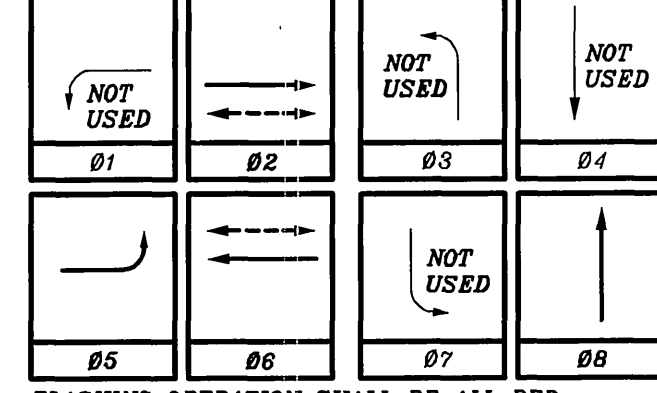


FLASHING OPERATION SHALL BE ALL RED.

08-07-N-SN-1284



ENGINEER IN RESPONSIBLE CHARGE
GILBERT M. HERNANDEZ
R.C.E. No. 69170 expires 6-30-08
DATE 3-3-08

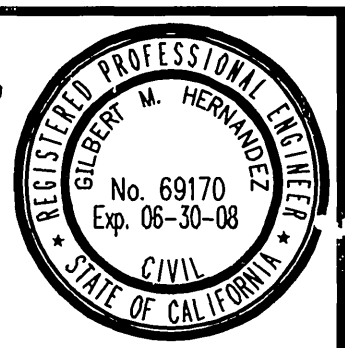

MARK	REVISIONS	APPR.	DATE

CITY OF RIVERSIDE, CALIFORNIA
DEPARTMENT OF PUBLIC WORKS
APPROVED BY: [Signature]
PRINCIPAL ENGINEER: [Signature]
TRAFFIC DIVISION: [Signature]
C.M.P. MGR.: [Signature]

TRAFFIC SIGNAL MODIFICATION
TYLER STREET
AT 91 FREEWAY EB RAMPS
AND WB RAMPS

ACCT. NO. X-320A
SHEET 1 OF 1
FILE NAME: X320A.DWG

SCALE: 1" = 20'

EQUIPMENT SCHEDULE

NO.	SIGNAL STANDARD				LUMINAIRE		I.S.N.S.		SIGNAL MOUNTINGS			PPB PHASE
	TYPE	H'GHT	M.A.	L.A.	H.P.S.V.	LEGEND	VEHICLE	PEDESTRIAN	AUDIBLE			
A	26A-3-70(E)	35'	40'	15'(E)	400W(E)		MAS(E)					
							MAS(E)					
							SV-1-T(E)	SP-1-T(E)	N/A			6(E)
B	1A(E)	10'					TV-1-T(E)	SP-1-T(E)	N/A			6(E)
C	TYPE 19(E)	35'	30'	10'(E)	400W(E)		MAS(E)					
							SV-2-T(E)	SP-1-T(E)	N/A			2(E)
D	TYPE 17(E)	35'	18'	10'(E)	250W(E)		MAS(E)					
							SV-2-T(E)	SP-1-T(E)	N/A			2(E)
E	26A-4-70(E)	35'	45'	15'(E)	400W(E)		MAS(E)					
							MAS(E)					
							SV-1-T(E)	SP-1-T(E)	N/A			2(E)
F	1A(E)	10'					TV-1-T(E)	SP-1-T(E)	N/A			2(E)
G	19-4-70(E)	35'	30'	15'(E)	400W(E)		MAS(E)					
							SV-2-T(E)	SP-1-T(E)	N/A			6(E)
H	TYPE 17(E)	35'	18'	10'(E)	200W(E)		MAS(E)					
							SV-2-T(E)	SP-1-T(E)	N/A			6(E)



(E)=EXISTING (N)=NEW (R)=REUSE

CONDUCTOR TABLE

CONTROL FUNCTION	CONDUCTORS	CONDUCTOR RUNS-WB RAMPS								CONDUCTOR RUNS-EB RAMPS							
		1	2	3	4	5	6	7	8	1	2	3	4	5	6	7	8
VEHICLE & PEDESTRIAN HEADS	12CSC	1	-	5	4	4	3	2	2	-	1	2	4	4	1	-	-
PEDESTRIAN PUSH BUTTONS, SPARES & COMMONS	3CSC	-	-	4	3	3	2	1	1	-	1	2	4	4	1	-	-
DETECTOR CABLE	#16/2	-	-	-	-	-	-	-	-	-	-	-	-	-	-	-	-
PHASE 1		-	-	1	1	1	-	-	-	-	-	-	-	-	-	-	-
PHASE 2		-	-	4	4	-	-	-	-	-	2	2	2	-	-	-	-
PHASE 3		-	-	-	-	-	-	-	-	-	-	-	-	-	-	-	-
PHASE 4		-	-	2	-	-	-	-	-	-	-	-	-	-	-	-	-
PHASE 5		-	-	-	-	-	-	-	-	-	-	-	-	-	-	-	-
PHASE 6		-	-	2	2	2	-	-	-	-	4	4	4	-	-	-	-
PHASE 7		-	-	-	-	-	-	-	-	-	-	-	-	-	-	-	-
PHASE 8		-	-	-	-	-	-	-	-	-	3	5	5	-	-	-	-
TOTALS		-	-	4	12	3	3	-	-	-	3	9	13	13	4	-	-
INTERCONNECT CABLE	6 PR #20	-	-	-	-	-	-	-	-	-	1	1	1	1	1	1	1
MASTER INTERC. CABLE	6 PR #19	1	-	1	-	-	-	-	-	-	1	1	1	1	1	1	1
RR PRE-EMPT	3CSC	-	-	-	-	-	-	-	-	-	2	2	2	-	-	-	-
TELEPHONE CABLE	4 #12	-	-	-	-	-	-	-	-	-	-	-	-	-	1	-	-
LUMINAIRES	#8	2	-	-	2	2	2	2	2	-	2	2	-	-	2	-	-
SIGNAL SERVICE	#6	2	-	2	-	-	-	-	-	-	-	-	-	-	-	-	-
SIGNALS(BRIDGE)	#8	2	-	-	-	-	-	-	-	-	-	-	-	-	-	-	-
SIGNAL SERVICE(RAMP)	#8	-	-	-	-	-	-	-	-	-	-	-	-	-	-	-	-
TELEPHONE SERVICE	#12	-	-	-	-	-	-	-	-	-	2	-	-	-	-	-	-
COMMON (GROUND)	#8	1	1	1	1	1	1	1	1	1	1	1	1	1	1	1	1
CONDUIT FILL		1.05	0.47	4.30	2.79	2.79	1.94	1.31	1.31	0.27	1.03	2.10	4.15	4.15	1.72	0.51	0.68
CONDUIT SIZE		2.5"	2"	2-3"	3"	3"	3"	3"	3"	2.5"	3.5"	2-3"	2-3"	2.5"	1.5"	2"	2"

(E)=EXISTING; (N)=NEW

NOTE: SIGNAL SYSTEM SHALL HAVE NEW CSC CABLES AND NEW CONDUCTORS.

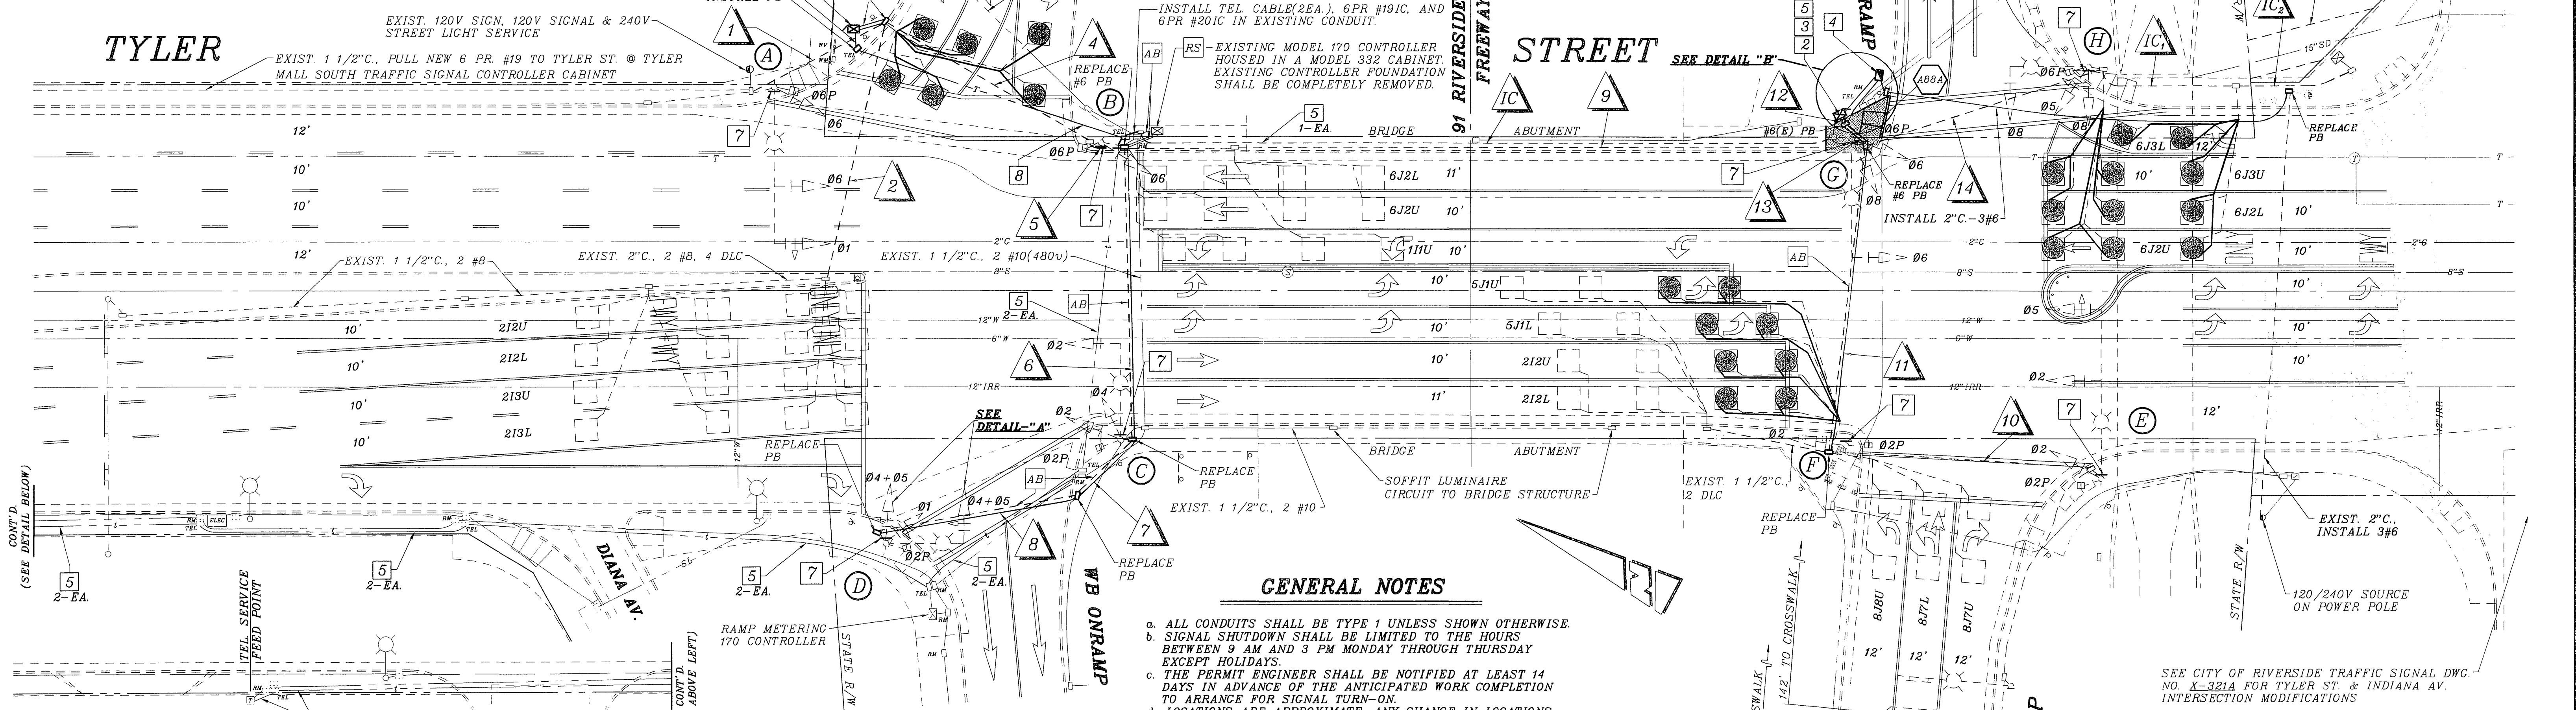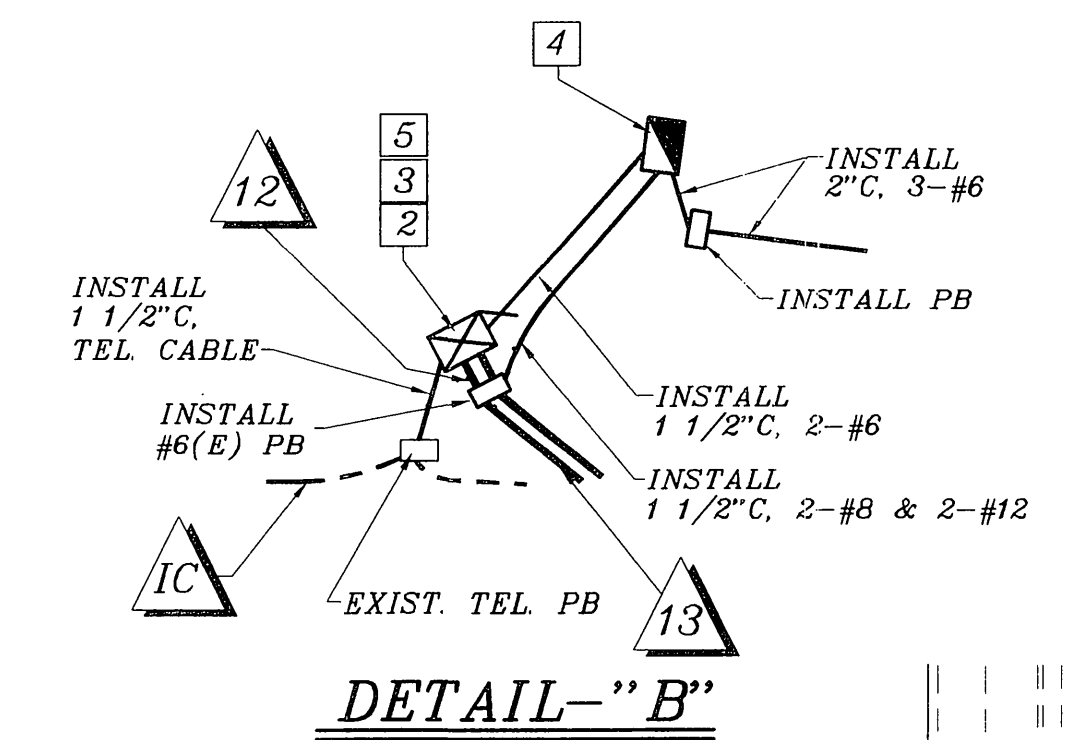


GENERAL NOTES

- ALL CONDUITS SHALL BE TYPE 1 UNLESS SHOWN OTHERWISE.
- SIGNAL SHUTDOWN SHALL BE LIMITED TO THE HOURS BETWEEN 9 AM AND 3 PM MONDAY THROUGH THURSDAY EXCEPT HOLIDAYS.
- THE PERMIT ENGINEER SHALL BE NOTIFIED AT LEAST 14 DAYS IN ADVANCE OF THE ANTICIPATED WORK COMPLETION TO ARRANGE FOR SIGNAL TURN-ON.
- LOCATIONS ARE APPROXIMATE. ANY CHANGE IN LOCATIONS WILL BE DETERMINED BY THE ENGINEER IN THE FIELD.
- THE CONTRACTOR SHALL FURNISH AND INSTALL A NO. 8 BARE COPPER GROUND WIRE IN EACH CONDUIT (NO. 10 IF CONDUIT CONTAINS NO POWER CONDUCTORS).
- EQUIPMENT TO BE SALVAGED WITHIN THE STATE RIGHT-OF-WAY SHALL REMAIN THE PROPERTY OF THE STATE AND SHALL BE DELIVERED TO THE MAINTENANCE YARD LOCATED AT 175 CLUSTER ST. SAN BERNARDINO, CA 92408.
- PEDESTRIAN PUSH BUTTONS (PPBs) SHALL BE TYPE "B", MOUNTED AT A HEIGHT OF 1m. PPBs SHALL COMPLY WITH ADA GUIDELINES.
- CONTRACTOR SHALL ARRANGE TO HAVE A SIGNAL TECHNICIAN, QUALIFIED TO WORK ON EMERGENCY VEHICLE PRE-EMPTION (EVP) UNIT AND EMPLOYED BY THE EVP MANUFACTURER OR HIS REPRESENTATIVE, PRESENT AT THE TIME WHEN THE EQUIPMENT IS TURNED ON.
- DETECTOR LOOPS SHALL BE INSTALLED IN THE PRESENCE OF THE TRAFFIC ENGINEER OR HIS REPRESENTATIVE.
- TYPICAL DETECTOR LOOP SPACING: 10' AND 15'.

CONSTRUCTION NOTES

- INSTALL 1 EA. STATE FURNISHED MODEL 170E CONTROLLER ASSEMBLY IN A 332 CABINET, ON A NEW FOUNDATION. (SEE SPECIAL PROVISIONS SECTION 7-3.1)
- INSTALL 1 EA. STATE FURNISHED MODEL 170E/TRFM CONTROLLER ASSEMBLY IN A 332 CABINET, ON A NEW FOUNDATION. (SEE SPECIAL PROVISIONS SECTION 7-3.1)
- INSTALL NEW BATTERY BACKUP SYSTEM (BBS), MOUNTED EXTERNALLY ON THE CONTROLLER CABINET. ALL BBS PARTS SHOULD BE INSTALLED INSIDE THE BBS CABINET AND NOT IN THE CONTROLLER CABINET.
- INSTALL TYPE III-CF SERVICE EQUIPMENT ENCLOSURE PER CALTRANS STANDARD PLANS ES-2C AND ES-2F.
- INSTALL TELEPHONE CABLE IN EXISTING CONDUIT, FROM THE TELEPHONE SERVICE FEED POINT ON S/S OF TYLER ST. (360'± N/O WB 91 FREEWAY RAMPS) TO 332 CONTROLLER CABINETS AT FREEWAY RAMPS. TELEPHONE CABLE TO TERMINATE AT AN RJ-11 MODULAR JACK INSIDE THE CABINETS. TELEPHONE CABLE SHALL BE FOUR-WIRE #18 IN COMPLIANCE WITH CALTRANS STANDARD SPECIAL PROVISIONS.
- REUSE EXISTING EXTERNAL BBS CABINET, AND INSTALL ON NEW CONTROLLER CABINET.
- INSTALL R96 (24") SIGN ON SIGNAL POLE (8 EA.) PER CALTRANS STANDARD PLAN RS.4.

PHASE DIAGRAM WB RAMPS

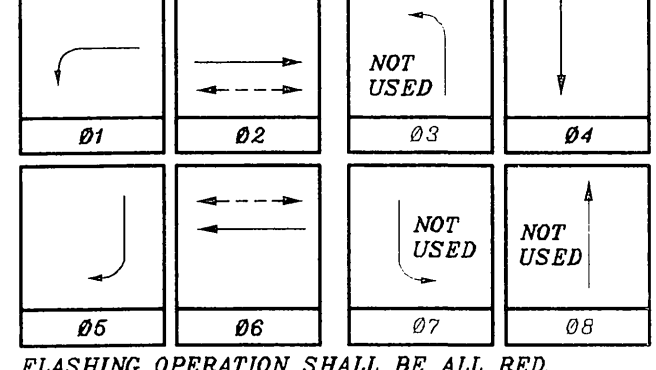


CONSTRUCTION NOTES (CONT'D.)

- INSTALL NEW 2" CONDUIT, TEL. CABLE(2EA.), 6PR #19C, AND 6PR #20C.
- INSTALL CURB RAMP (WHEELCHAIR RAMP), MODIFIED TYPE A, PER CALTRANS STANDARD PLAN RSP A88A.


PAVEMENT DELINEATION

- INDICATES STRIPING AND PAVEMENT MARKINGS TO BE INSTALLED.
- INDICATES STRIPING AND PAVEMENT MARKINGS TO REMAIN.
- INDICATES STRIPING AND PAVEMENT MARKINGS TO BE REMOVED.

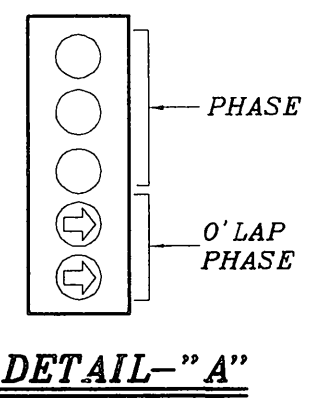

ENGINEER IN RESPONSIBLE CHARGE

THOMAS JOHN BOYD
R.C.E. No. 36170
DATE

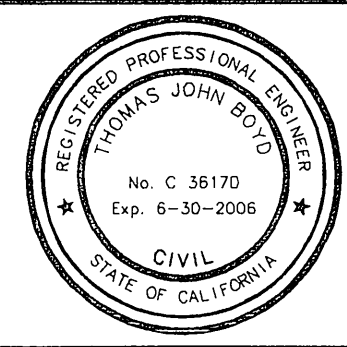

MARK	REVISIONS	APPR.	DATE

CITY OF RIVERSIDE, CALIFORNIA
DEPARTMENT OF PUBLIC WORKS

APPROVED BY: *[Signature]*
PRINCIPAL ENGINEER: *[Signature]*
TRAFFIC DIVISION: *[Signature]*

TRAFFIC SIGNAL MODIFICATION

TYLER STREET
AT 91 FREEWAY EB RAMPS
AND WB RAMPS

SCALE: 1" = 20'



ACCT. NO. 9756433214-44030200
X-320A
SHEET 1 OF 1
FILE NAME: X320A.DWG




-THIS PLAN ACCURATE FOR ELECTRICAL WORK ONLY-

CONTRACT TE-04-01

STATE ENCROACHMENT PERMIT NO.: 08-04-N-SN-0388

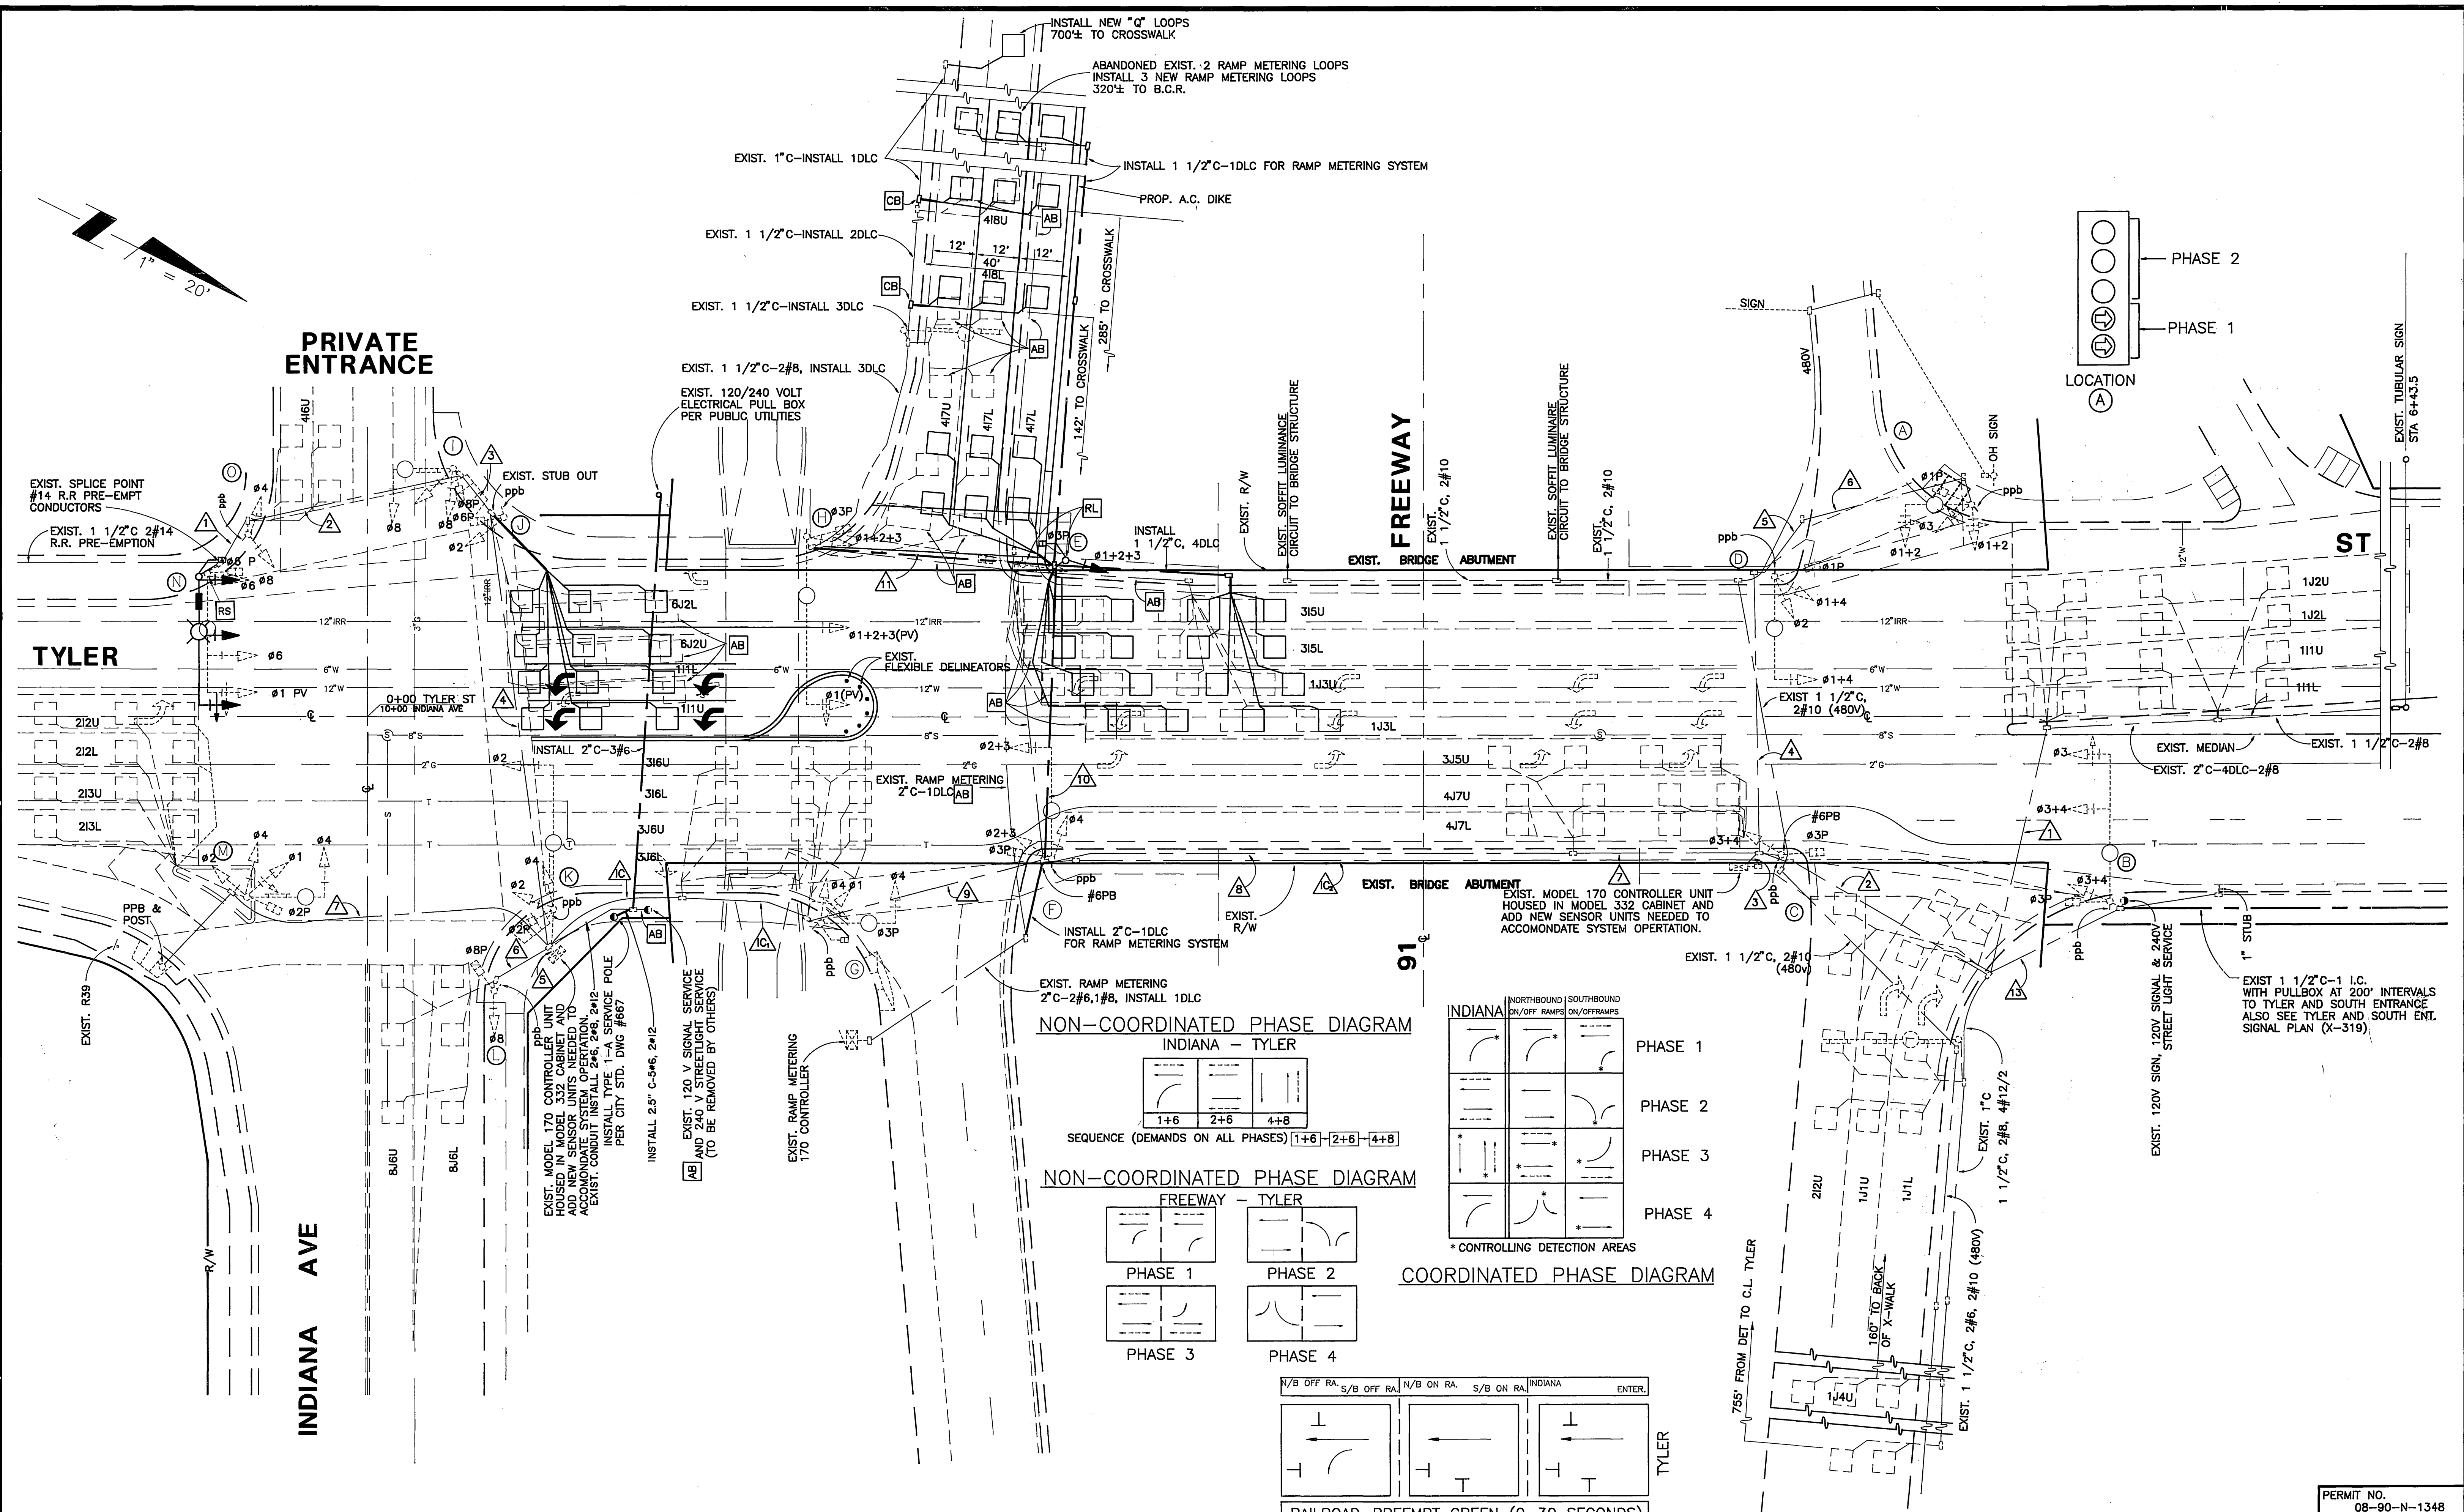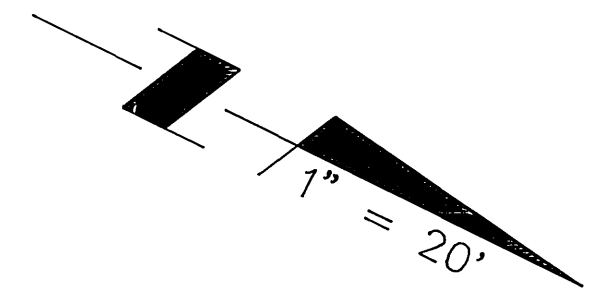


NON-COORDINATED PHASE DIAGRAM
INDIANA - TYLER


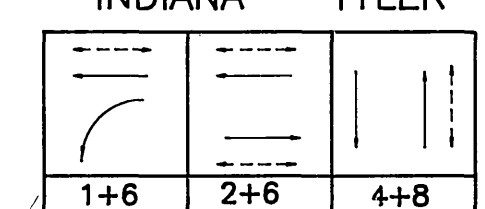


SEQUENCE (DEMANDS ON ALL PHASES) 1+6-2+6-4+8

NON-COORDINATED PHASE DIAGRAM
FREEWAY - TYLER

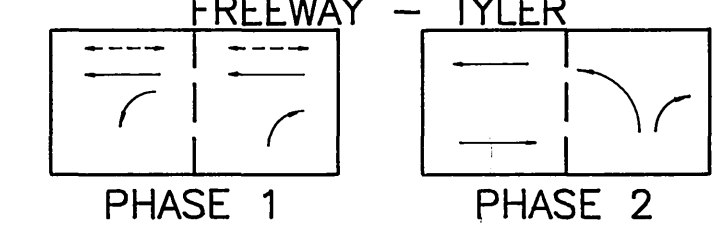


COORDINATED PHASE DIAGRAM

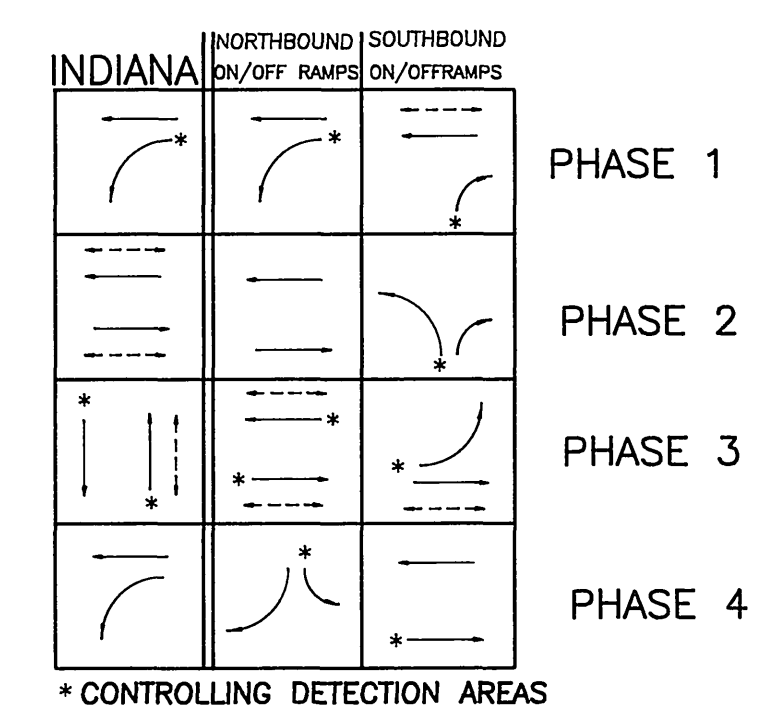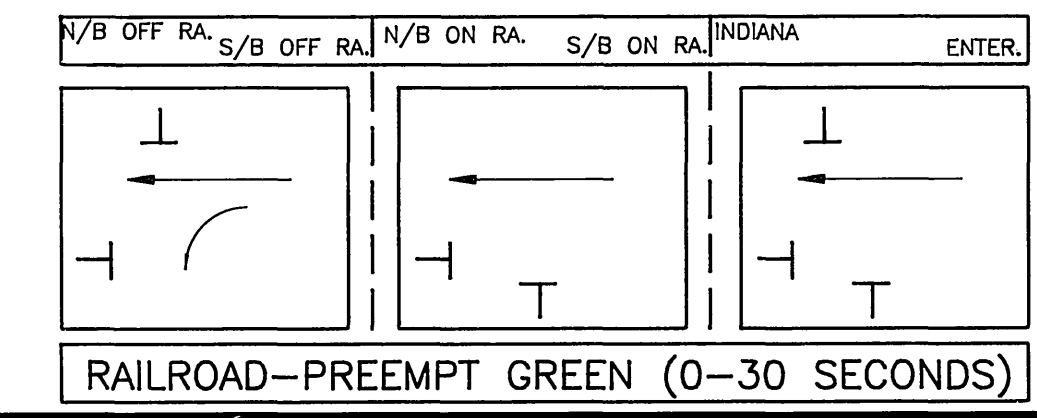

Underground Service Alert
Call: TOLL FREE
1 - 800
422 - 4133
TWO WORKING DAYS BEFORE YOU DIG

PRIVATE ENGINEERING NOTE
CONSTRUCTION CONTRACTOR AGREES THAT IN ACCORDANCE WITH GENERALLY ACCEPTED CONSTRUCTION PRACTICES, CONSTRUCTION CONTRACTOR WILL BE REQUIRED TO ASSUME SOLE AND COMPLETE RESPONSIBILITY FOR JOB SITE CONDITIONS DURING THE COURSE OF CONSTRUCTION OF THE PROJECT, INCLUDING SAFETY OF ALL PERSONS AND PROPERTY, THAT THIS REQUIREMENT SHALL BE MADE TO APPLY CONTINUOUSLY AND NOT BE LIMITED TO NORMAL WORKING HOURS, AND CONSTRUCTION CONTRACTOR FURTHER AGREES TO DEFEND, INDEMNIFY, AND HOLD DESIGN PROFESSIONAL HARMLESS FROM ANY AND ALL LIABILITY, REAL OR ALLEGED, IN CONNECTION WITH THE PERFORMANCE OF WORK ON THIS PROJECT, EXCEPTING LIABILITY ARISING FROM THE SOLE NEGLIGENCE OF DESIGN PROFESSIONAL.

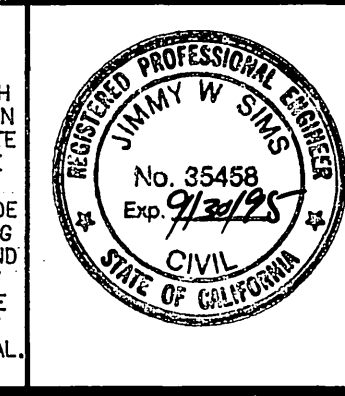

PREPARED UNDER THE DIRECTION OF
[Signature]
REGISTERED CIVIL ENGINEER NO: 35458
EXPIRATION DATE: 9-30-95 DATE: 11-4-91
RECOMMENDED BY:
[Signature]
James B. Dobbins DATE: 11-4-91

J.F. Davidson Associates, Inc.
ENGINEERING PLANNING SURVEYING LANDSCAPE ARCHITECTURE
MUNICIPAL ENGINEERING DIVISION
3426 TENTH STREET
P.O. BOX 493
RIVERSIDE, CA 92502
(714) 683-0209 FAX (714) 686-5807
SCALE: 1"=20'-0" BENCH MARK:
DATE: NOVEMBER, 91


MARK	REVISIONS	APPR.	DATE

DESIGNED BY: K.T.O. DRAWN BY: R.D.W. CHECKED BY: O.M.A.

CITY OF RIVERSIDE, CALIFORNIA
DEPARTMENT OF PUBLIC WORKS
APPROVED BY: *[Signature]* BY: *[Signature]* DATE: 11/12/92
PRINCIPAL ENGINEER
INSPECTION
TRAFFIC DIVISION
CHIEF P.W. ENGINEER
PUBLIC UTILITIES


TYLER MALL EXPANSION
C.F.D. # 90-2 IMPROVEMENTS
TRAFFIC SIGNAL MODIFICATION PLAN
TYLER STREET
AND
91 EB RAMPS
HORIZ SCALE: 1"=20' VERT. SCALE: 1"

PERMIT NO.
08-90-N-1348
08-RV-91-12.91
PROJECT NO.
X-320A
SHEET 1 OF 2
FILE NO:
8911175

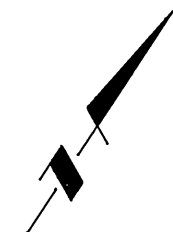

91 FWY.

TYLER ST.

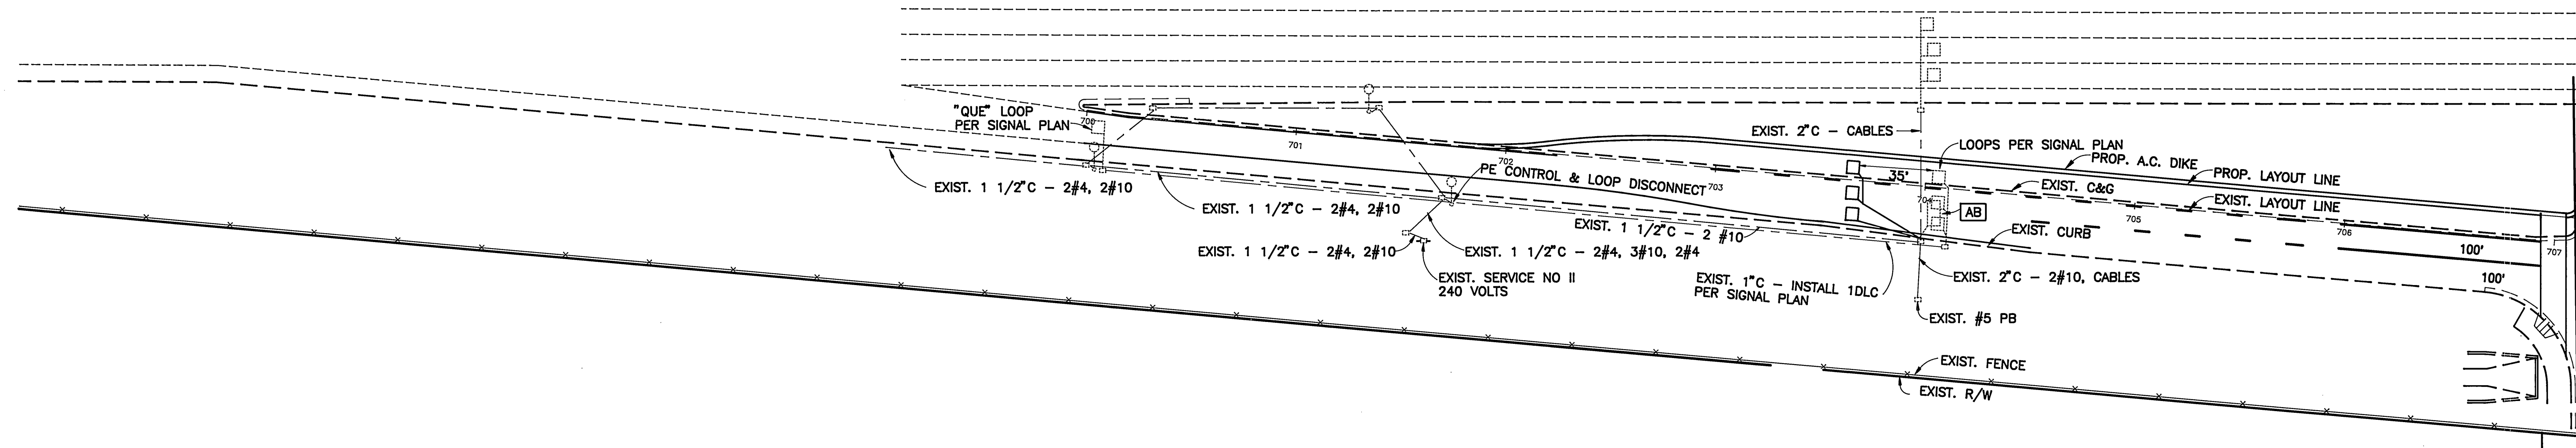

Underground Service Alert
 Call: TOLL FREE
 1 - 800
 422 - 4133

TWO WORKING DAYS BEFORE YOU DIG

PRIVATE ENGINEERING NOTE
 CONSTRUCTION CONTRACTOR AGREES THAT IN ACCORDANCE WITH GENERALLY ACCEPTED CONSTRUCTION PRACTICES, CONSTRUCTION CONTRACTOR WILL BE REQUIRED TO ASSUME SOLE AND COMPLETE RESPONSIBILITY FOR JOB SITE CONDITIONS DURING THE COURSE OF CONSTRUCTION OF THE PROJECT, INCLUDING SAFETY OF ALL PERSONS AND PROPERTY; THAT THIS REQUIREMENT SHALL BE MADE TO APPLY CONTINUOUSLY AND NOT BE LIMITED TO NORMAL WORKING HOURS, AND CONSTRUCTION CONTRACTOR FURTHER AGREES TO DEFEND INDEMNIFY AND HOLD DESIGN PROFESSIONAL HARMLESS FROM ANY AND ALL LIABILITY, REAL OR ALLEGED, IN CONNECTION WITH THE PERFORMANCE OF WORK ON THIS PROJECT, EXCEPTING LIABILITY ARISING FROM THE SOLE NEGLIGENCE OF DESIGN PROFESSIONAL.



PREPARED UNDER THE DIRECTION OF
[Signature]
 REGISTERED CIVIL ENGINEER NO. 35458
 EXPIRATION DATE: 9/30/95 DATE: 11/4/91

APPROVED BY:

J.F. Davidson Associates, Inc.
 ENGINEERING PLANNING SURVEYING LANDSCAPE ARCHITECTURE
 MUNICIPAL ENGINEERING DIVISION
 3426 TENTH STREET
 P.O. BOX 493
 RIVERSIDE, CA 92502
 (714) 683-0209 FAX (714) 686-5807

SCALE: 1" = 40'-0"
 DATE: NOVEMBER, '91

MARK	REVISIONS	APPR.	DATE

DESIGNED BY: KTO/OMA DRAWN BY: KTO CHECKED BY: OMA

CITY OF RIVERSIDE, CALIFORNIA
DEPARTMENT OF PUBLIC WORKS

APPROVED BY	BY	DATE	APPROVED BY	DATE
PRINCIPAL ENGINEER	<i>[Signature]</i>	11/12/91	<i>[Signature]</i>	11/12/91
INSPECTION				
TRAFFIC DIVISION	<i>[Signature]</i>	11/12/91		
CHIEF P.W. ENGINEER	<i>[Signature]</i>	11/12/91		
PUBLIC UTILITIES	<i>[Signature]</i>	11/12/91		

DATE: 11/21/91

TYLER MALL EXPANSION
 C.F.D. # 90-2 IMPROVEMENTS
 REWIRING PLAN

91 E.B. OFFRAMP

HORIZ SCALE: 1" VERT. SCALE: 1"

PERMIT NO.
 08-90-N-1348
 08-RIV-91-12.91

PROJECT NO.
X-320B

SHEET 1 OF 1

FILE NO:
 8911175

REVISED PLANS

POLE SCHEDULE												
NO.	POLE TYPE	MAST ARM LENGTH			SIGNAL MOUNTING			PPB		H.P.S. LUMINAIRE	I.S.N.S. LEGEND	REMARKS
		HEIGHT	SIGNAL	LUMINAIRE	MA	POLE	PED	Ø	QUAD			
(A)	TYPE 17	35'	18'	10'	MAS	SV-2-T	SP-1-T	Ø1	3	250 W.	Tyler ST 3500	
(B)	26A-3-70	35'	40'	15'	2-MAS	SV-1-T	SP-1-T	Ø3	3	400 W.		
(C)	1-A	10'				TV-1-T	SP-1-T	Ø3	3			
(D)	TYPE 19	35'	30'	10'	MAS	SV-2-T	SP-1-T	Ø1	1	400 W.		
(E)	1-A	10'				TV-1-T	SP-1-T	Ø3	1			RELOCATE EXISTING POLE AND EQUIPMENT AS SHOWN
(F)	19-4-70	35'	30'	15'	MAS	SV-2-T	SP-1-T	Ø3	3	400 W.		
(G)	TYPE 17	35'	18'	10'	MAS	SV-2-T	SP-1-T	Ø3	1	200 W.	Tyler ST 3400	
(H)	26A-4-70	35'	45'	15'	2-MAS	SV-1-T	SP-1-T	Ø3	1	400 W.		
(I)	17A-2-70	35'	15'	15'	MAS	SV-1-T	SP-1-T	Ø6	3	400 W.		
(J)	1-A	10'				TV-1-T		Ø8	4			
(K)	26A-4-70	35'	40'	15'	2-MAS	SV-2-T	SP-1-T	Ø8	4	400 W.		
(L)	1-A	10'				TV-1-T	SP-1-T	Ø2	1			
(M)	17A-2-70	35'	20'	15'	MAS	SV-3-TA				400 W.		
(N)	24A-4-80	35'	35'	15'	2-MAS	SV-2-T	SP-1-T			400 W.		INSTALL NEW POLE, RELOCATE EXISTING EQUIPMENT TO NEW POLE
(O)	1-A	10'				TV-1-T		Ø6	3			

ALL POLES AND EQUIPMENT EXISTING UNLESS OTHERWISE SEE REMARKS
 THE ACCURACY OF THIS TABLE IS BASED ON EXISTING PLAN NO X-320
 THE EXACT LOCATION FOR NEW POLE TO BE DETERMINED BY THE ENGINEER IN THE FIELD.


GENERAL NOTES:

- TRAFFIC SIGNAL WORK SHALL BE PERFORMED IN ACCORDANCE TO THE CURRENT PROVISIONS OF SECTION 86 OF THE STANDARD SPECIFICATIONS, THE STANDARD PLANS (DATED JANUARY 1988), BOTH PUBLISHED BY THE STATE OF CALIFORNIA DEPARTMENT OF TRANSPORTATION (CALTRANS), THE CONSTRUCTION PLAN(S) AND SPECIAL PROVISIONS AND AS DIRECTED BY THE TRAFFIC ENGINEER.
- ALL EQUIPMENT AND LOOP LOCATIONS SHALL BE APPROVED BY THE TRAFFIC ENGINEER OR HIS REPRESENTATIVE PRIOR TO INSTALLATION BY CONTRACTOR.
- IT SHALL BE THE RESPONSIBILITY OF THE CONTRACTOR TO VERIFY THE EXISTENCE AND LOCATION OF ALL UNDERGROUND UTILITIES, PUBLIC OR PRIVATE, AND TO PROTECT THEM FROM DAMAGE. THE CONTRACTOR SHALL BEAR THE TOTAL EXPENSE OF REPAIR OR REPLACEMENT OF ANY UNDERGROUND FACILITIES DAMAGED BY HIS OPERATIONS.
- ALL LOOPS SHALL BE 6'X6' UNLESS OTHERWISE NOTED.
- SPlicing OF THE CONDUCTORS IS NOT ALLOWED.
- CONSTRUCTION WORK THAT WILL CAUSE DAMAGE TO THE DETECTOR LOOPS SHALL BE NOT PERFORMED UNTIL TRAFFIC SIGNAL MAINTENANCE PERSONNEL HAVE BEEN NOTIFIED AT (714)351-6096 (CITY OF RIVERSIDE) AND CALTRANS ELECTRICAL INSPECTOR(714) 383-4609.
- ALL SIGNAL AND BACK PLATES SHALL BE METAL. ALL LENSES SHALL BE GLASS LEFT-TURN HEADS SHALL BE RED, YELLOW AND GREEN ARROW. ALL VEHICLE INDICATIONS SHALL BE 12". PEDESTRIAN INDICATIONS SHALL BE INTERNATIONAL SYMBOL TYPE "C".
- ALL SALVAGED MATERIALS SHALL BE DELIVERED TO CITY YARD.

TYLER STREET & SR 91 RAMPS

CONDUCTOR SCHEDULE													
AWG	CONDUCTOR	CONDUIT RUN											
		△	△	△	△	△	△	△	△	△	△	△	△
#14	#1												
	#2												
	#3												
	#4												
	#1+2(OL)												
	#1+2+3(OL)												
	#2+3(OL)												
	#3+4(OL)												
	#1+4(OL)												
	#1PED												
	#3PED												
	#1PPB												
	#3PPB												
	R.R. PRE-EMPT												
PPB COMMON													
SPARE													
TOTAL #14													
#10	120V COMMON												
	LUMINAIRE SOFFIT												
	TOTAL #10												
#8	SIGNAL SERVICE												
	LUMINAIRE												
	TOTAL #8												
DLC	#1												
	#2												
	#3												
	#4												
	TOTAL DLC												
6 PAIRS #20 INTERCONNECT CABLE													
3 PAIRS #19 MASTER INT. CABLE													
CONDUIT SIZE		2"	3"	2-3"	2"	1 1/2"	1 1/2"	3"	3"	2 1/2"	2 1/2"	2 1/2"	2 1/2"
		(E)	(E)	(E)	(E)	(E)	(E)	(E)	(E)	(E)	(E)	(E)	(E)

ALL CONDUITS AND CONDUCTORS EXISTING UNLESS OTHERWISE NOTED.
 (N) = INSTALL NEW CONDUIT
 ⊗ = INSTALL NEW CONDUCTOR

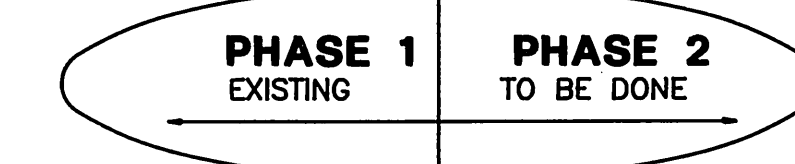

TYLER STREET & INDIANA AVENUE

CONDUCTOR SCHEDULE													
AWG	CONDUCTOR	CONDUIT RUN											
		△	△	△	△	△	△	△	△	△	△	△	△
#14	#1												
	#2												
	#3												
	#4												
	#6												
	#8												
	#2PED												
	#6PED												
	#8PED												
	#2PPB												
	#6PPB												
	#8PPB												
	R.R. PRE-EMPT												
	PPB COMMON												
SPARE													
TOTAL #14													
#10	120V COMMON												
	TOTAL #10												
#8	SIGNAL SERVICE												
	TOTAL #8												
DLC	#1												
	#2												
	#3												
	#4												
	TOTAL DLC												
6 PAIRS #20 INTERCONNECT CABLE													
3 PAIRS #19 MASTER INT. CABLE													
CONDUIT SIZE		2"	2 1/2"	2 1/2"	3"	3 1/2"	2"	2 1/2"					
		(E)	(E)	(E)	(E)	(E)	(E)	(E)					

ALL CONDUITS AND CONDUCTORS EXISTING UNLESS OTHERWISE NOTED.
 ⊗ = INSTALL NEW CONDUCTORS.

Underground Service Alert
 Call: TOLL FREE
 1 - 800
 422 - 4133
 TWO WORKING DAYS BEFORE YOU DIG

PRIVATE ENGINEERING NOTE
 CONSTRUCTION CONTRACTOR AGREES THAT IN ACCORDANCE WITH GENERALLY ACCEPTED CONSTRUCTION PRACTICES, CONSTRUCTION CONTRACTOR WILL BE REQUIRED TO ASSUME SOLE AND COMPLETE RESPONSIBILITY FOR JOB SITE CONDITIONS DURING THE COURSE OF CONSTRUCTION OF THE PROJECT, INCLUDING SAFETY OF ALL PERSONS AND PROPERTY; THAT THIS REQUIREMENT SHALL BE MADE TO APPLY CONTINUOUSLY AND NOT BE LIMITED TO NORMAL WORKING HOURS, AND CONSTRUCTION CONTRACTOR FURTHER AGREES TO DEFEND, INDEMNIFY AND HOLD DESIGN PROFESSIONAL HARMLESS FROM ANY AND ALL LIABILITY, REAL OR ALLEGED, IN CONNECTION WITH THE PERFORMANCE OF WORK ON THIS PROJECT, EXCEPTING LIABILITY ARISING FROM THE SOLE NEGLIGENCE OF DESIGN PROFESSIONAL.

PREPARED UNDER THE DIRECTION OF
James W. Dobbins
 REGISTERED CIVIL ENGINEER NO: 35458
 EXPIRATION DATE: 9-30-95 DATE: 11-4-91
 RECOMMENDED BY:
James B. Dobbins
 DATE: 11-4-91

J.F. Davidson Associates, Inc.
 ENGINEERING PLANNING SURVEYING LANDSCAPE ARCHITECTURE
 MUNICIPAL ENGINEERING DIVISION
 3426 TENTH STREET
 P.O. BOX 493
 RIVERSIDE, CA 92502
 (714) 683-0209 FAX (714) 686-5807

SCALE: NONE BENCH MARK:
 DATE: NOVEMBER, 91

MARK REVISIONS APPR. DATE
 DESIGNED BY: K.T.O. DRAWN BY: R.D.W. CHECKED BY: *[Signature]*

CITY OF RIVERSIDE, CALIFORNIA
 DEPARTMENT OF PUBLIC WORKS


APPROVED BY: *[Signature]* DATE: 4/21/92
 CHIEF P.W. ENGINEER

TYLER MALL EXPANSION
 C.F.D. # 90-2 IMPROVEMENTS
 TRAFFIC SIGNAL MODIFICATION PLAN
TYLER STREET
 AND
91 EB RAMPS
 HORIZ. SCALE: 1" VERT. SCALE: 1"

PERMIT NO.
 08-90-N-1348
 08-RIV-91-12.91

PROJECT NO.
X-320A

SHEET 2 OF 2
 FILE NO:
 8911175

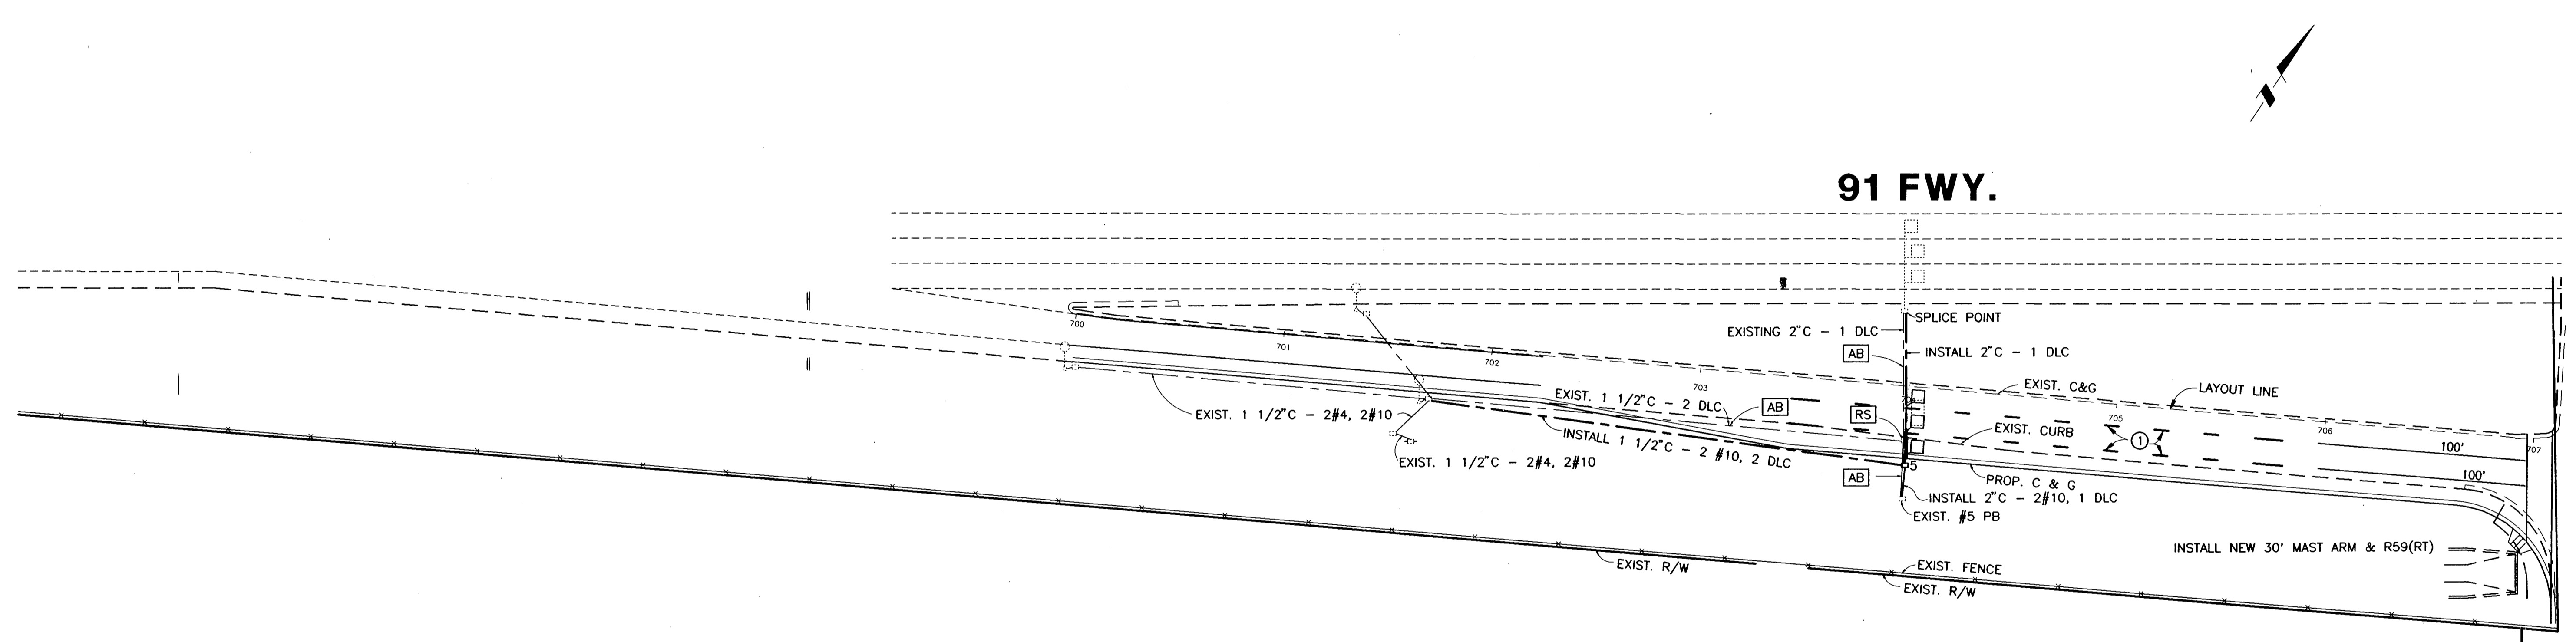


91 FWY.

TYLER ST.

Underground Service Alert
 Call: TOLL FREE
 1 - 800
 422 - 4133
 TWO WORKING DAYS BEFORE YOU DIG

PRIVATE ENGINEERING NOTE
 CONSTRUCTION CONTRACTOR AGREES THAT IN ACCORDANCE WITH GENERALLY ACCEPTED CONSTRUCTION PRACTICES, CONSTRUCTION CONTRACTOR WILL BE REQUIRED TO ASSUME SOLE AND COMPLETE RESPONSIBILITY FOR JOB SITE CONDITIONS DURING THE COURSE OF CONSTRUCTION OF THE PROJECT, INCLUDING SAFETY OF ALL PERSONS AND PROPERTY; THAT THIS REQUIREMENT SHALL BE MADE TO APPLY CONTINUOUSLY AND NOT BE LIMITED TO NORMAL WORKING HOURS, AND CONSTRUCTION CONTRACTOR FURTHER AGREES TO DEFEND, INDEMNIFY AND HOLD DESIGN PROFESSIONAL HARMLESS FROM ANY AND ALL LIABILITY, REAL OR ALLEGED, IN CONNECTION WITH THE PERFORMANCE OF WORK ON THIS PROJECT, EXCEPTING LIABILITY ARISING FROM THE SOLE NEGLIGENCE OF DESIGN PROFESSIONAL.

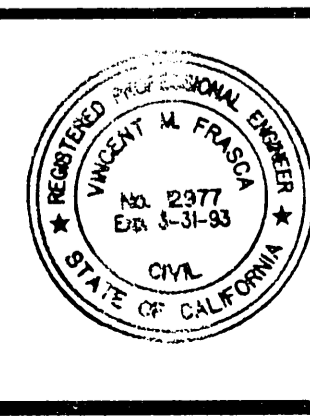

PREPARED UNDER THE DIRECTION OF
Vincent M. Frisco
 REGISTERED CIVIL ENGINEER NO: 12977
 EXPIRATION DATE: 3/31/93 DATE: _____
 APPROVED BY: _____

J.F. Davidson Associates, Inc.
 ENGINEERING PLANNING SURVEYING
 ARCHITECTURE LANDSCAPE ARCHITECTURE
 MUNICIPAL ENGINEERING DIVISION
 3426 TENTH STREET
 RIVERSIDE, CA 92502
 (714) 683-0209 FAX (714) 686-5807

SCALE: 1" = 40'-0" BENCH MARK: _____
 DATE: DECEMBER, 90

MARK	REVISIONS	APPR.	DATE

DESIGNED BY _____ DRAWN BY _____ CHECKED BY _____

CITY OF RIVERSIDE, CALIFORNIA
DEPARTMENT OF PUBLIC WORKS



APPROVED BY	BY	DATE
PRINCIPAL ENGINEER		
INSPECTION		
CHIEF P.W. ENGINEER	<i>Arac</i>	<i>12/1/90</i>

APPROVED BY *Barry Paul*
 DIRECTOR OF PUBLIC WORKS
 DATE *12/21/90*


TYLER MALL EXPANSION
 C.F.D. # 90-2 IMPROVEMENTS
 REWIRING PLAN
91 E.B. OFFRAMP

HORIZ SCALE: 1" VERT. SCALE: 1"




PROJECT NO.
X-320B
 SHEET 1 OF 1
 FILE NO. _____

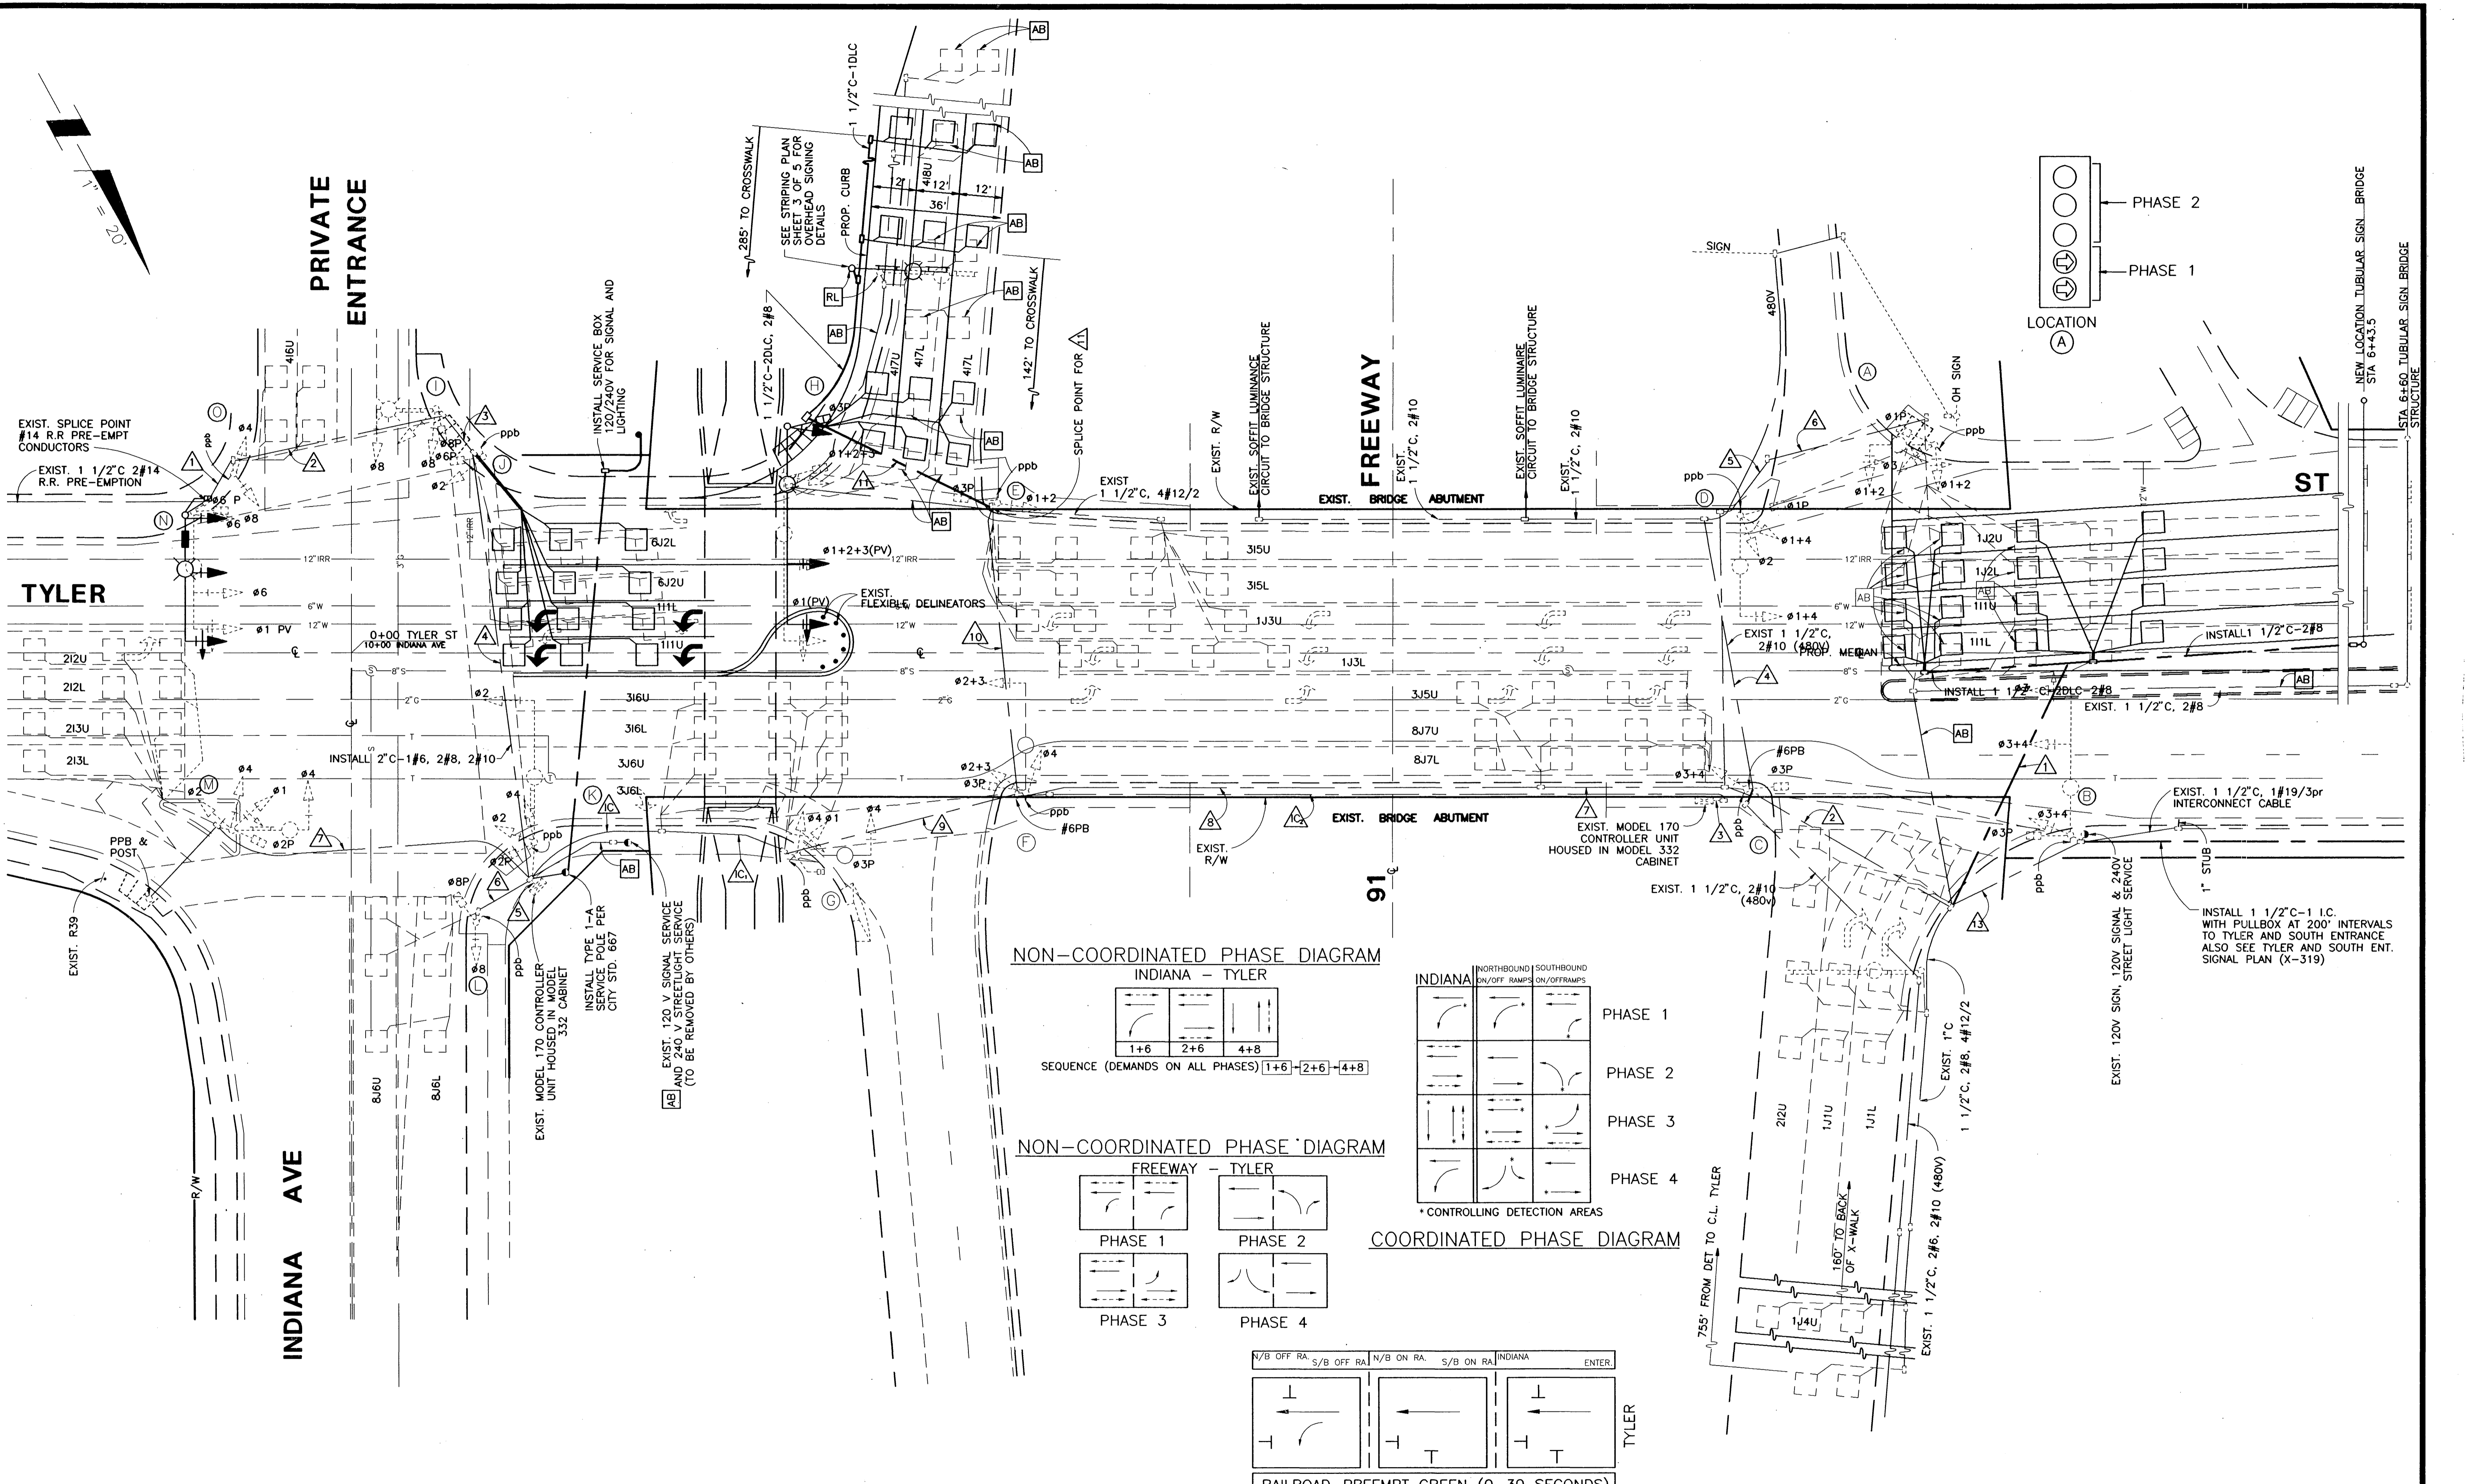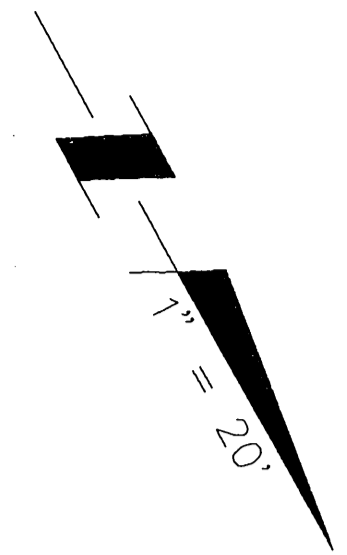

NON-COORDINATED PHASE DIAGRAM
INDIANA - TYLER

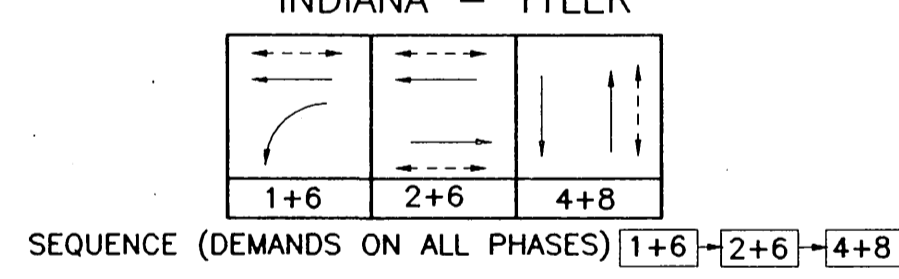


NON-COORDINATED PHASE DIAGRAM
FREEWAY - TYLER

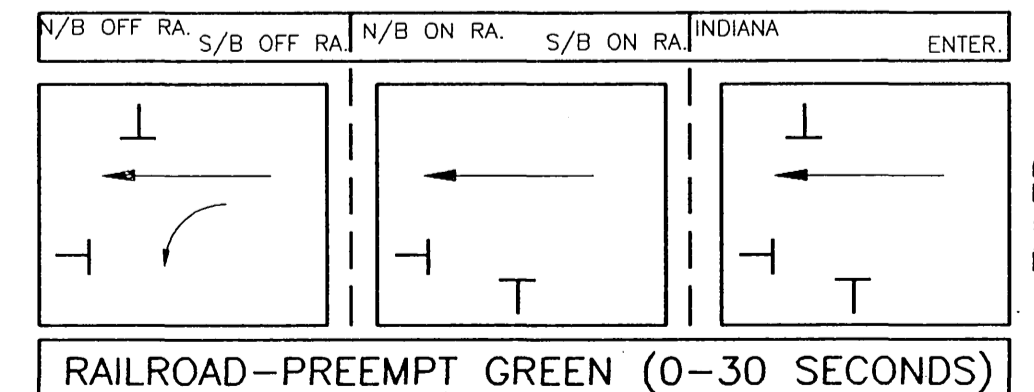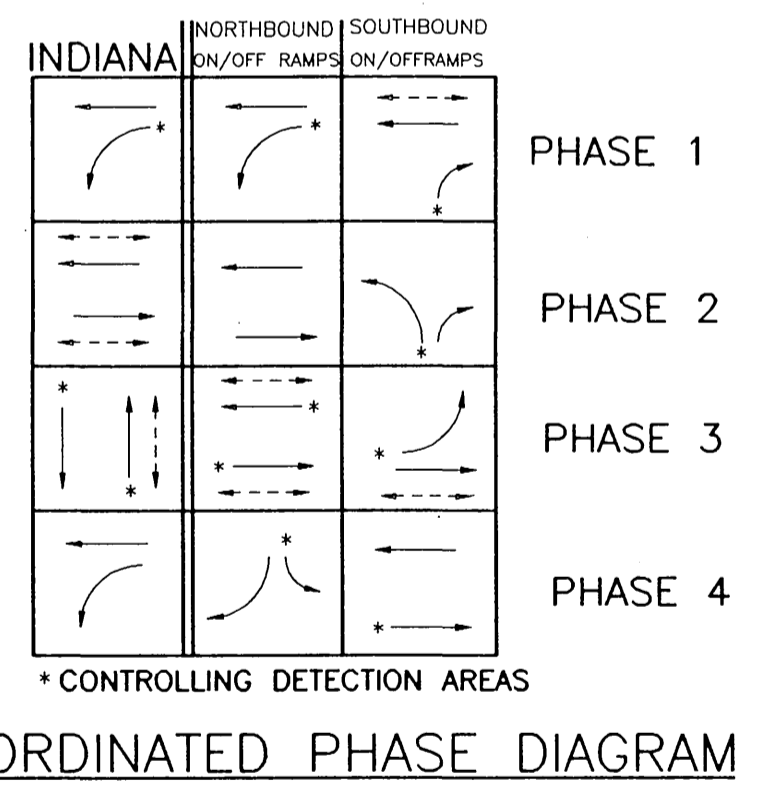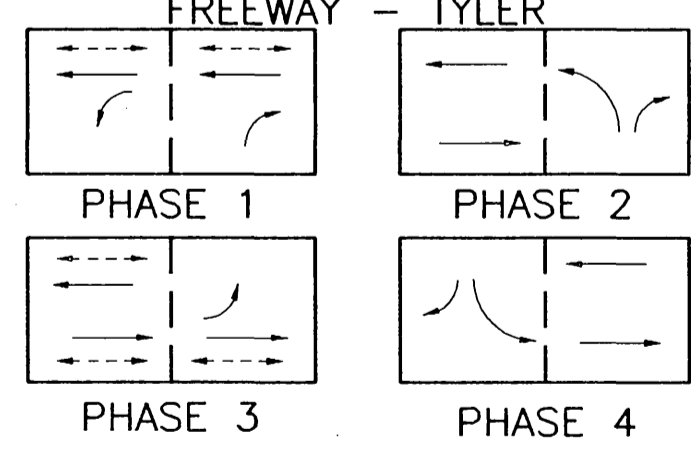

Underground Service Alert
Call: TOLL FREE
1 - 800
422 - 4133
TWO WORKING DAYS BEFORE YOU DIG

PRIVATE ENGINEERING NOTE
CONSTRUCTION CONTRACTOR AGREES THAT IN ACCORDANCE WITH GENERALLY ACCEPTED CONSTRUCTION PRACTICES, CONSTRUCTION CONTRACTOR WILL BE REQUIRED TO ASSUME SOLE AND COMPLETE RESPONSIBILITY FOR JOB SITE CONDITIONS DURING THE COURSE OF CONSTRUCTION OF THE PROJECT INCLUDING SAFETY OF ALL PERSONS AND PROPERTY; THAT THIS REQUIREMENT SHALL BE MADE TO APPLY CONTINUOUSLY AND NOT BE LIMITED TO NORMAL WORKING HOURS, AND CONSTRUCTION CONTRACTOR FURTHER AGREES TO DEFEND, INDEMNIFY AND HOLD DESIGN PROFESSIONAL HARMLESS FROM ANY AND ALL LIABILITY, REAL OR ALLEGED, IN CONNECTION WITH THE PERFORMANCE OF WORK ON THIS PROJECT, EXCEPTING LIABILITY ARISING FROM THE SOLE NEGLIGENCE OF DESIGN PROFESSIONAL.

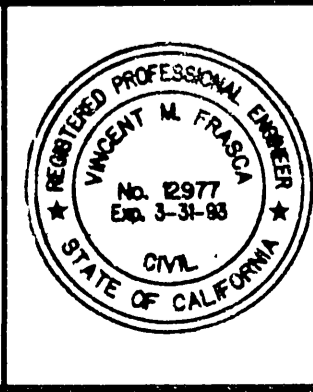

PREPARED UNDER THE DIRECTION OF
James B. Dobbins
REGISTERED CIVIL ENGINEER NO: 12977
EXPIRATION DATE: 3-31-93 DATE: 12-19-90
APPROVED BY:
James B. Dobbins
James B. Dobbins DATE: 12-19-90

J.F. Davidson Associates, Inc.
ENGINEERING PLANNING SURVEYING
ARCHITECTURE LANDSCAPE ARCHITECTURE
MUNICIPAL ENGINEERING DIVISION
3426 TENTH STREET
RIVERSIDE, CA 92502
(714) 683-0209 FAX (714) 686-5807
SCALE: 1"=20'-0" BENCH MARK:
DATE: DECEMBER, 90

MARK REVISIONS APPR. DATE
DESIGNED BY: K.T.O. DRAWN BY: R.D.W. CHECKED BY:

CITY OF RIVERSIDE, CALIFORNIA
DEPARTMENT OF PUBLIC WORKS
APPROVED BY: *Benj. Pal*
PRINCIPAL ENGINEER
PARK DEPARTMENT
TRAFFIC DIVISION
CHIEF P.W. ENGINEER
DATE: 12/21/90

TYLER MALL EXPANSION
C.F.D. # 90-2 IMPROVEMENTS
TRAFFIC SIGNAL MODIFICATION PLAN
**TYLER STREET
AND
91 EB RAMPS**
HORIZ. SCALE: 1"=20' VERT. SCALE: 1"

PROJECT NO. 8911175
X-320A
SHEET 1 OF 2
FILE NO:

TYLER STREET & SR 91 RAMPS

POLE SCHEDULE													
I	POLE		MAST ARM LENGTH			SIGNAL MOUNTING			PPB		H.P.S. LUMINAIRE	I.S.N.S. LEGEND	REMARKS
	NO.	TYPE	HEIGHT	SIGNAL	LUMINAIRE	MA	POLE	PED	Ø	QUAD			
(A)	TYPE 17	35'	18'	10'	MAS	SV-2-T	SP-1-T			200 W.	Tyler ST 3500		
(B)	26A-3-70	35'	40'	15'	2-MAS	SV-1-T	SP-1-T			400 W.			
(C)	1-A	10'				TV-1-T	SP-1-T						
(D)	TYPE 19	35'	30'	10'	MAS	SV-2-T	SP-1-T			400 W.			
(E)	1-A	10'				TV-1-T	SP-1-T						
(F)	19-4-70	35'	30'	15'	MAS	SV-2-T	SP-1-T			400 W.			
(G)	TYPE 17	35'	18'	10'	MAS	SV-2-T	SP-1-T			200 W.	Tyler ST 3400		
(H)	29A-5-80	35'	50'	15'	2-MAS	SV-1-T	SP-1-T			400 W.		INSTALL NEW POLE, RELOCATE EXISTING EQUIPMENT TO NEW POLE	
(I)	17A-2-70	35'	15'	15'	MAS	SV-1-T	SP-1-T			400 W.			
(J)	1-A	10'				TV-1-T							
(K)	26A-4-70	35'	40'	15'	MAS	SV-2-T	SP-1-T			400 W.			
(L)	1-A	10'				TV-1-T	SP-1-T						
(M)	17A-2-70	35'	20'	15'	MAS	SV-3-TA				400 W.			
(N)	24A-4-80	35'	35'	15'	2-MAS	SV-1-T	SP-1-T			400 W.		INSTALL NEW POLE, RELOCATE EXISTING EQUIPMENT TO NEW POLE	
(O)	1-A	10'				TV-1-T							

ALL POLES AND EQUIPMENT EXISTING UNLESS OTHERWISE SEE REMARKS
 THE ACCURACY OF THIS TABLE IS BASED ON EXISTING PLAN NO X-320
 THE EXACT LOCATION FOR NEW POLE TO BE DETERMINED BY THE ENGINEER IN THE FIELD.

GENERAL NOTES:

- TRAFFIC SIGNAL WORK SHALL BE PERFORMED IN ACCORDANCE TO THE MOST CURRENT PROVISIONS OF SECTION 86 OF THE STANDARD SPECIFICATIONS, THE STANDARD PLANS, BOTH PUBLISHED BY THE STATE OF CALIFORNIA DEPARTMENT OF TRANSPORTATION (CALTRANS), THE CONSTRUCTION PLAN(S) AND AS DIRECTED BY THE TRAFFIC ENGINEER.
- ALL EQUIPMENT AND LOOP LOCATIONS SHALL BE APPROVED BY THE TRAFFIC ENGINEER OR HIS REPRESENTATIVE PRIOR TO INSTALLATION BY CONTRACTOR.
- IT SHALL BE THE RESPONSIBILITY OF THE CONTRACTOR TO VERIFY THE EXISTENCE AND LOCATION OF ALL UNDERGROUND UTILITIES, PUBLIC OR PRIVATE, AND TO PROTECT THEM FROM DAMAGE. THE CONTRACTOR SHALL BEAR THE TOTAL EXPENSE OF REPAIR OR REPLACEMENT OF ANY UNDERGROUND FACILITIES DAMAGED BY HIS OPERATIONS.
- ALL LOOPS SHALL BE 6'x6' UNLESS OTHERWISE NOTED.
- SPLICING OF THE CONDUCTORS IS NOT ALLOWED.
- CONSTRUCTION WORK THAT WILL CAUSE DAMAGE TO THE DETECTOR LOOPS SHALL NOT BE PERFORMED UNTIL TRAFFIC SIGNAL MAINTENANCE PERSONNEL HAVE BEEN NOTIFIED AT (714)351-6096 AND THE NECESSARY TIMING ADJUSTMENTS MADE TO MAINTAIN SIGNAL OPERATION.
- ALL SIGNAL PLATES AND BACK PLATES SHALL BE METAL. ALL LENSES SHALL BE GLASS LEFT-TURN HEADS SHALL HAVE RED, YELLOW, AND GREEN ARROWS. ALL VEHICLE INDICATIONS SHALL BE 12". PEDESTRIAN INDICATIONS SHALL BE INTERNATIONAL SYMBOL TYPE "C".
- ALL SALVAGED MATERIALS SHALL BE DELIVERED TO CITY YARD.
- REFERENCE IS MADE TO EXISTING SIGNAL PLAN NO. X-320 FOR TYLER STREET AND 91 RAMPS.

CONDUCTOR SCHEDULE														
AWG	CONDUCTOR	CONDUIT RUN												
		1	2	3	4	5	6	7	8	9	10	11	12	
#14	#2			3	3									
	#1+2(OL)			5	5	5	5							
	#1+2+3(OL)			3				3	3					
	#2+3(OL)			3				3	3					
	#3+4(OL)			3	6									
	#1			3	3				3	3	3	3	3	
	#3			3	6	3	3	3						
	#4			3					3	3	3			
	#1+4(OL)			3	3									
	#1PED			2	2	2	2							
	#3PED			2	4	2	2	2	2	2	2	2	2	
	#1PPB			2	2	1	1							
	#3PPB			1	6				4	4	1	2	(1)	
	R.R. PRE-EMPT			2					2	2	2		2	
PPB COMMON			1	2	(1)	(1)	(1)	(1)	(1)	1	(1)	(1)		
SPARE			3	3	6	3	3	3	3	3	3	3		
TOTAL #14			3	13	68	23	15	29	29	15	16	15		
#10	120V COMMON			1	3	1	1	1	1	1	1	1		
	LUMINAIRE SOFFIT			2	2									
	TOTAL #10			3	3	3	1	1	1	1	1	1		
#8	SIGNAL SERVICE			2	2									
	SIGNS (BRIDGE)			2	2					2	2	2		
	LUMINAIRE			2	2					2	2	2		
TOTAL #8			2	4	2	2	2	2	2	2	2			
DLC	#1			2	2	4	2	2	2					
	#2			1	1									
	#3			7					7	6	4	2		
	#4			2	3				2	3	3	3		
TOTAL DLC			2	3	17	2	2	2	12	9	4	5		
6 PAIRS #22 INTERCONNECT CABLE				1						1		1		
3 PAIRS #19 MASTER INT. CABLE				1	1					1		1		
CONDUIT SIZE		2"	3"	2-3"	2"	1 1/2"	1 1/2"	3"	3"	2 1/2"	2 1/2"	2"	2"	1 1/2"

ALL CONDUITS AND CONDUCTORS EXISTING UNLESS OTHERWISE NOTED.
 (N) = INSTALL NEW CONDUIT
 ⊗ = INSTALL NEW CONDUCTOR


TYLER STREET & INDIANA AVENUE

CONDUCTOR SCHEDULE													
AWG	CONDUCTOR	CONDUIT RUN											
		1	2	3	4	5	6	7	8	9	10	11	12
#14	#1			3	3	3	3	6					
	#2							6					
	#4							6					
	#6			3	3	3	3	3					
	#8			3	3	3	3	6					
	#2PED							4					
	#6PED			2	2	2	2	2					
	#8PED					2	2	2					
	#2PPB							2	1	1			
	#6PPB			1	1	1	1	2					
	#8PPB							1	2				
	R.R. PRE-EMPT			1	1	1	1	2					
	PPB COMMON			1	1	1	1	2	1	1			
	SPARE			3	3	3	3	6	3	3			
TOTAL #14			13	19	21	22	51	5	16				
#10	120V COMMON			1	1	1	1	2	1	1			
	TOTAL #10			1	1	1	1	2	1	1			
#8	SIGNAL SERVICE							2					
	LUMINAIRE			2	2	2	2					2	
	TOTAL #8			2	2	2	2	2	2	2		2	
DLC	#1							1	1				
	#2							4				4	
	#4			1	1	1	1						
	#6					2	2						
	#8							2	2				
TOTAL DLC			1	1	4	10	2	4					
6 PAIRS #22 INTERCONNECT CABLE								1					
3 PAIRS #19 MASTER INT. CABLE								1					
CONDUIT SIZE		2"	2 1/2"	2 1/2"	3"	3 1/2"	2"	2 1/2"					

ALL CONDUITS AND CONDUCTORS EXISTING UNLESS OTHERWISE NOTED.

Underground Service Alert
 Call: TOLL FREE
 1 - 800
 422 - 4133
 TWO WORKING DAYS BEFORE YOU DIG

PRIVATE ENGINEERING NOTE
 CONSTRUCTION CONTRACTOR AGREES THAT IN ACCORDANCE WITH GENERALLY ACCEPTED CONSTRUCTION PRACTICES, CONSTRUCTION CONTRACTOR WILL BE REQUIRED TO ASSUME SOLE AND COMPLETE RESPONSIBILITY FOR JOB SITE CONDITIONS DURING THE COURSE OF CONSTRUCTION OF THE PROJECT, INCLUDING SAFETY OF ALL PERSONS AND PROPERTY; THAT THIS REQUIREMENT SHALL BE MADE TO APPLY CONTINUOUSLY AND NOT BE LIMITED TO NORMAL WORKING HOURS, AND CONSTRUCTION CONTRACTOR FURTHER AGREES TO DEFEND INDEMNIFY AND HOLD DESIGN PROFESSIONAL HARMLESS FROM ANY AND ALL LIABILITY, REAL OR ALLEGED, IN CONNECTION WITH THE PERFORMANCE OF WORK ON THIS PROJECT, EXCEPTING LIABILITY ARISING FROM THE SOLE NEGLIGENCE OF DESIGN PROFESSIONAL.

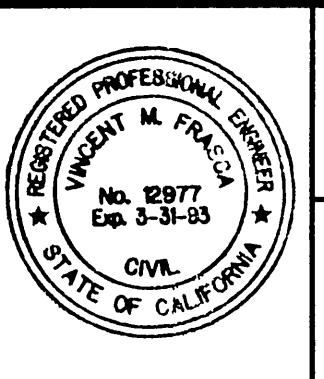

PREPARED UNDER THE DIRECTION OF
James B. Dobbins
 REGISTERED CIVIL ENGINEER NO. 12977
 EXPIRATION DATE: 3/31/93
 RECOMMENDED BY:
James B. Dobbins
 DATE: 12-19-90

J.F. Davidson Associates, Inc.
 ENGINEERING PLANNING SURVEYING
 ARCHITECTURE LANDSCAPE ARCHITECTURE
 MUNICIPAL ENGINEERING DIVISION
 3426 TENTH STREET
 RIVERSIDE, CA 92502
 (714) 683-0209 FAX (714) 686-5807


SCALE: NO SCALE BENCH MARK:
 DATE: DECEMBER, 90

MARK REVISIONS APPR. DATE
 DESIGNED BY: K.T.O. DRAWN BY: KTO/RDW CHECKED BY:


CITY OF RIVERSIDE, CALIFORNIA
 DEPARTMENT OF PUBLIC WORKS
 APPROVED BY: *Samuel*
 PRINCIPAL ENGINEER
 INSPECTION: *12/22/90*
 TRAFFIC DIVISION: *12/22/90*
 CHIEF P.W. ENGINEER: *12/22/90*
 PUBLIC UTILITIES: *12/22/90*
 DATE: 12/21/90

TYLER MALL EXPANSION
 C.F.D. # 90-2 IMPROVEMENTS
 TRAFFIC SIGNAL MODIFICATION PLAN
TYLER STREET AND 91 EB RAMPS
 HORIZ. SCALE: 1" VERT. SCALE: 1"



PROJECT NO. X-320A
 SHEET 2 OF 2
 FILE NO. 8911175

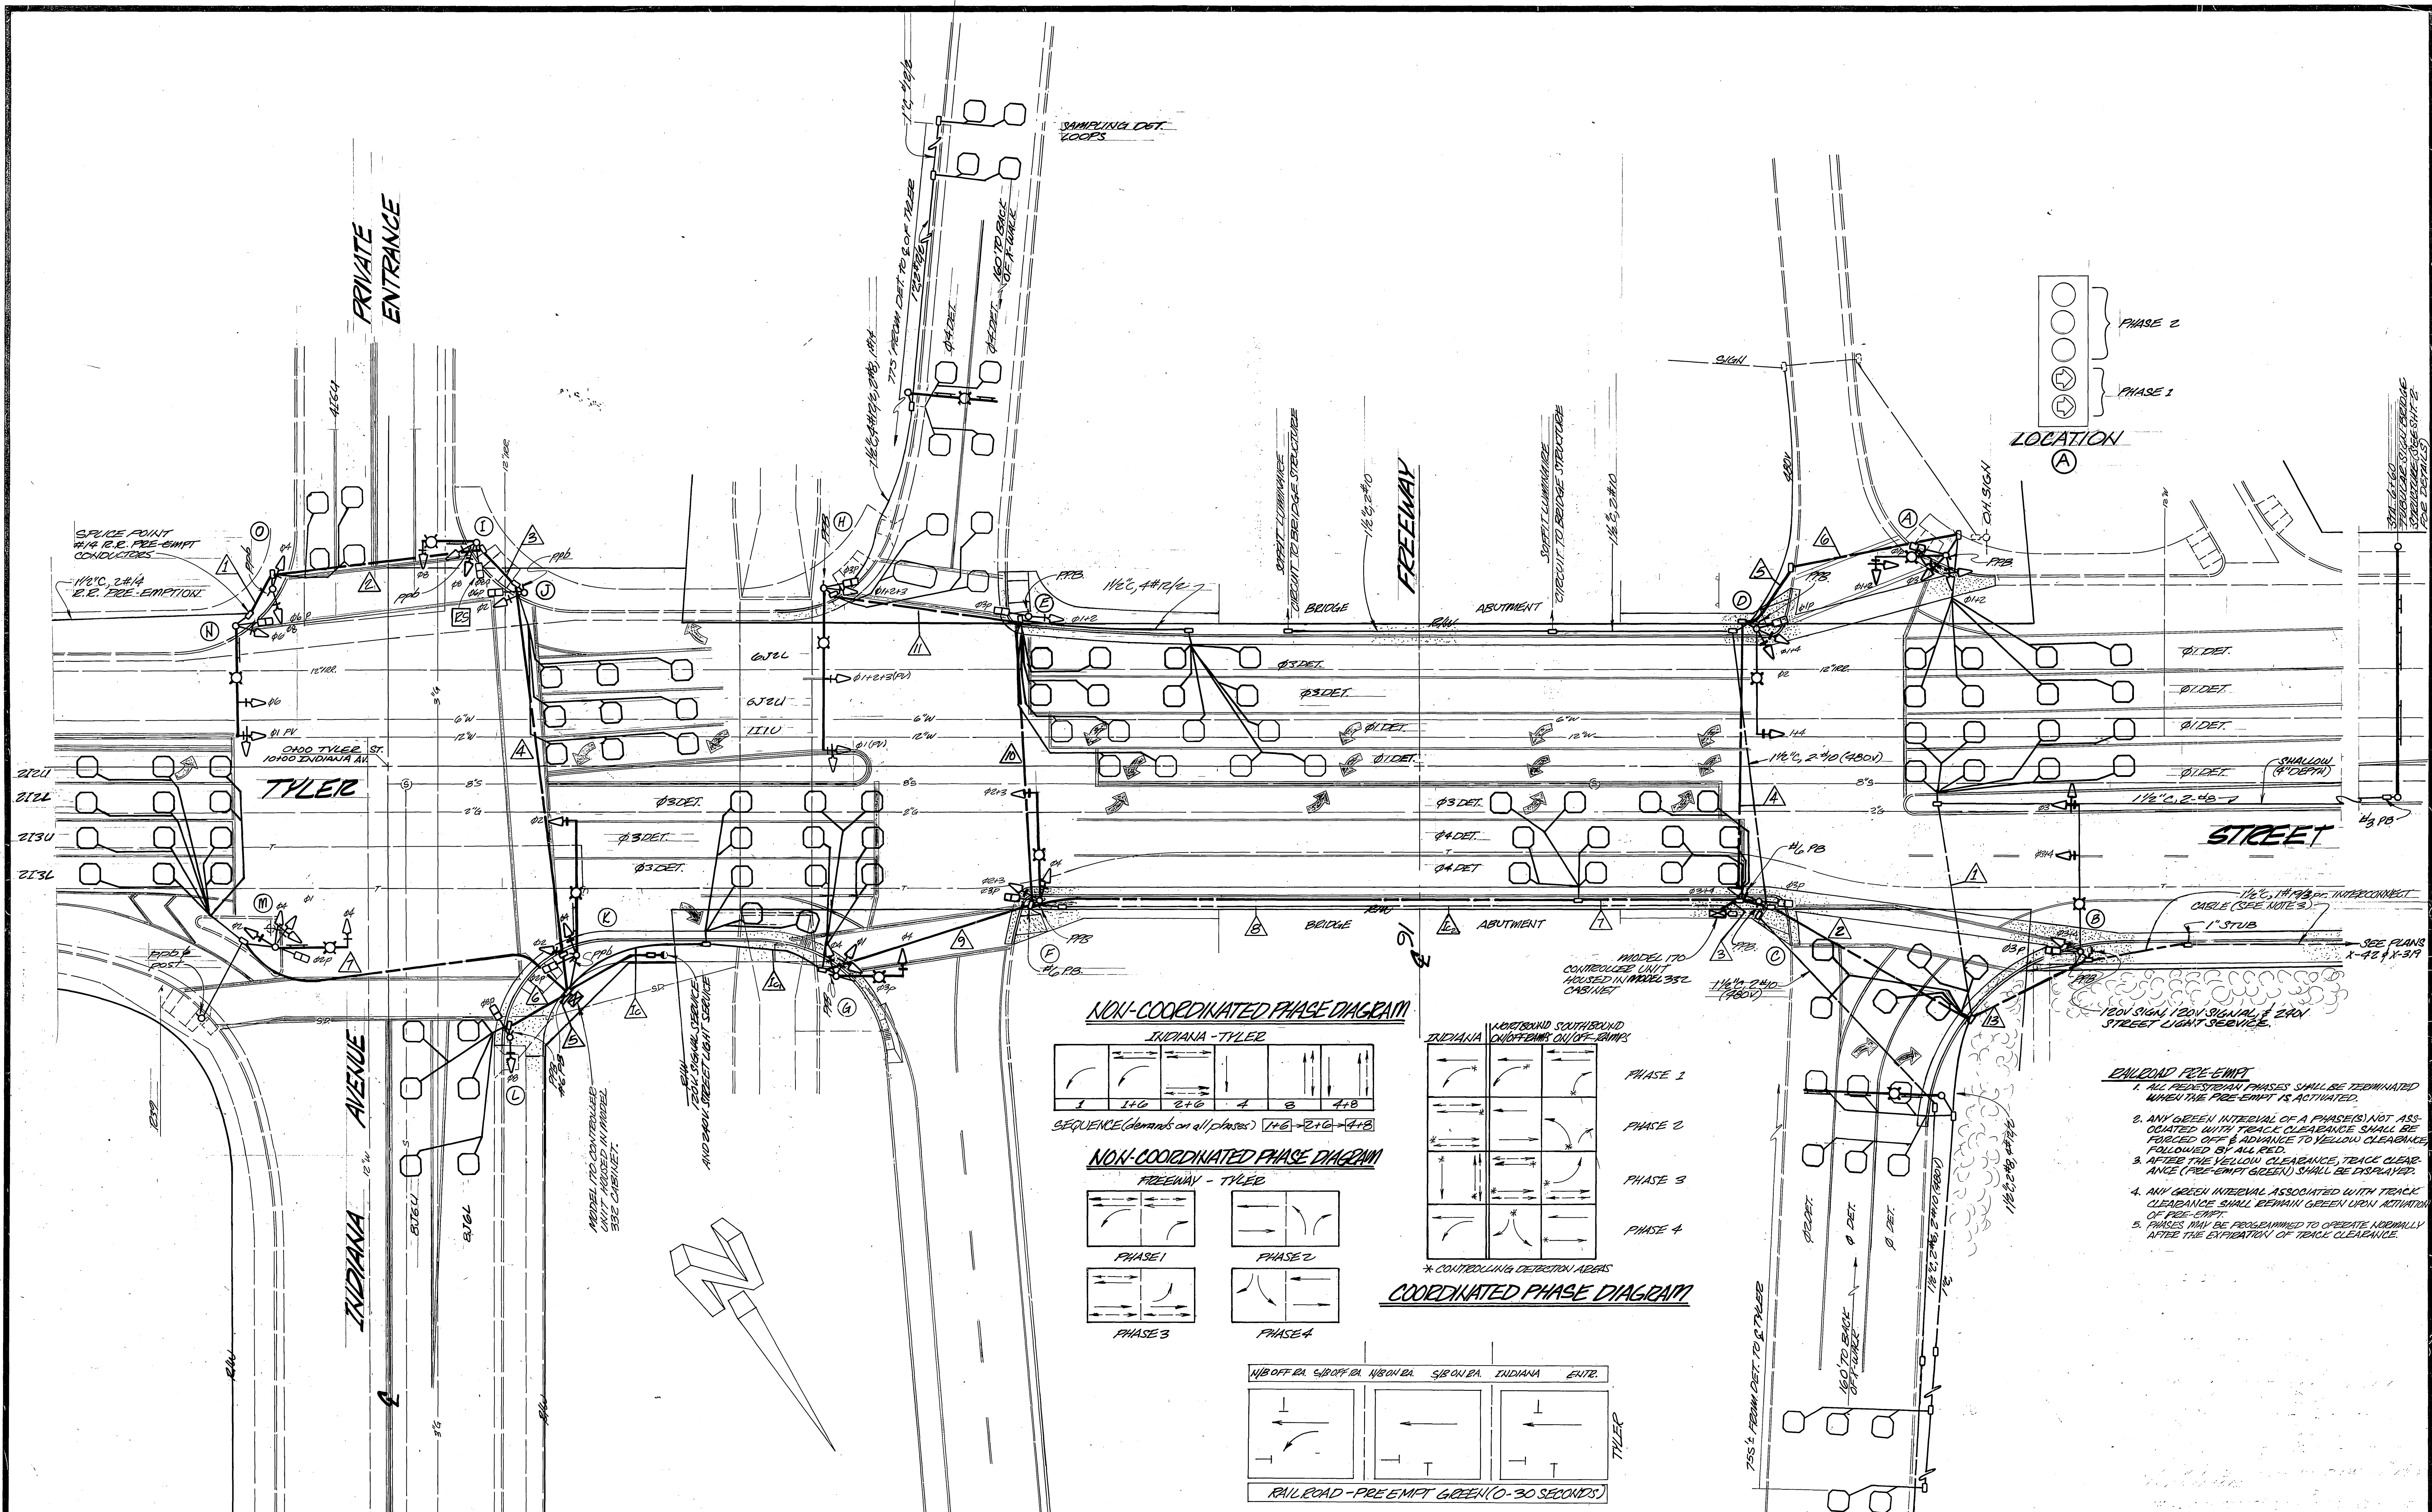



NON-COORDINATED PHASE DIAGRAM

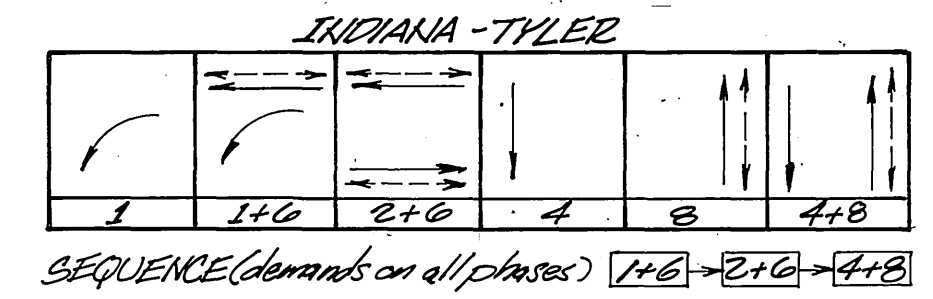

NON-COORDINATED PHASE DIAGRAM

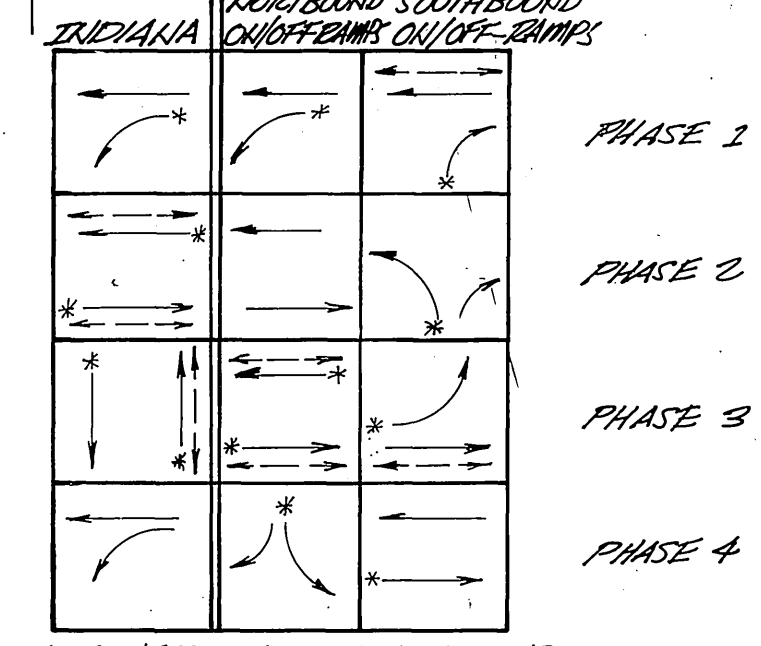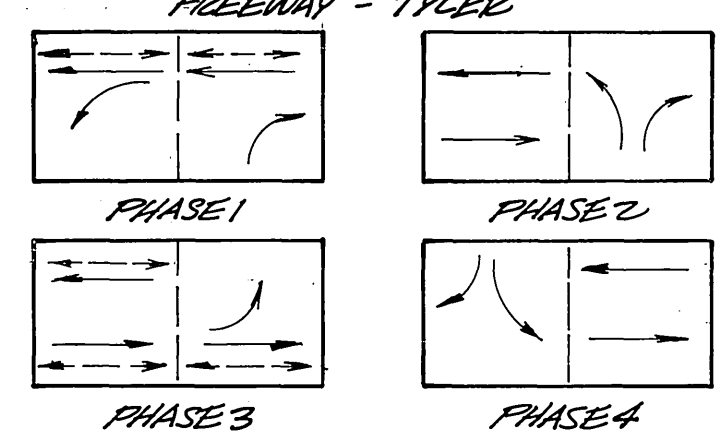


COORDINATED PHASE DIAGRAM

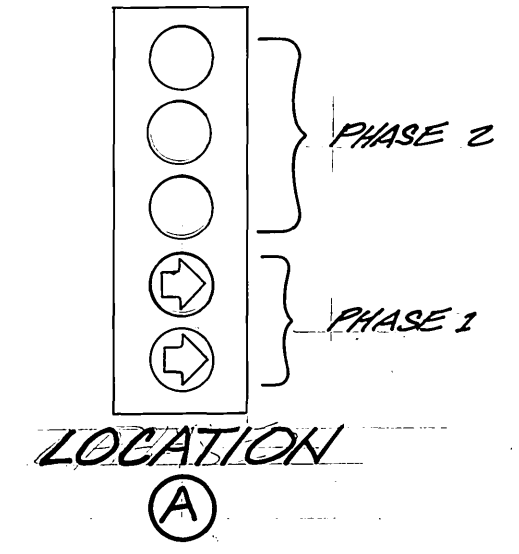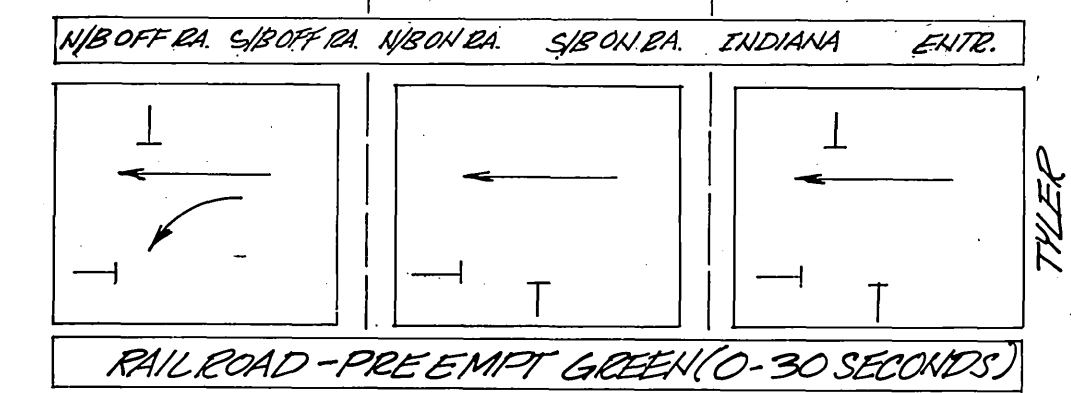

- RAILROAD PRE-EMPT**
1. ALL PEDESTRIAN PHASES SHALL BE TERMINATED WHEN THE PRE-EMPT IS ACTIVATED.
 2. ANY GREEN INTERVAL OF A PHASE(S) NOT ASSOCIATED WITH TRACK CLEARANCE SHALL BE FORCED OFF & ADVANCE TO YELLOW CLEARANCE FOLLOWED BY ALL RED.
 3. AFTER THE YELLOW CLEARANCE, TRACK CLEARANCE (PRE-EMPT GREEN) SHALL BE DISPLAYED.
 4. ANY GREEN INTERVAL ASSOCIATED WITH TRACK CLEARANCE SHALL REMAIN GREEN UPON ACTIVATION OF PRE-EMPT.
 5. PHASES MAY BE PROGRAMMED TO OPERATE NORMALLY AFTER THE EXPIRATION OF TRACK CLEARANCE.




CITY OF RIVERSIDE PUBLIC WORKS DEPARTMENT		TRAFFIC SIGNAL MODIFICATION TYLER STREET WIDENING AND MEDIAN RELOCATION PHASE II BETWEEN INDIANA AVENUE AND 1000' NORTHERLY AT THE TYLER MALL ENTRANCE	ACCOUNT NO. 304575-319(7) X-330 SHEET 1 OF 2
APPROVED BY PRINCIPAL ENGINEER PARK DEPARTMENT TRAFFIC DIVISION CHIEF P.W. ENGINEER PUBLIC UTILITIES ELEC.	DATE 6/3/85	APPROVED BY William D. Gardner PUBLIC WORKS DIRECTOR	DATE JUNE 3, 1985
DESIGNED BY DRAWN BY CHECKED BY	REVISIONS APPR. DATE	HORIZ. SCALE: 1" = 20' VERT. SCALE: 1" =	

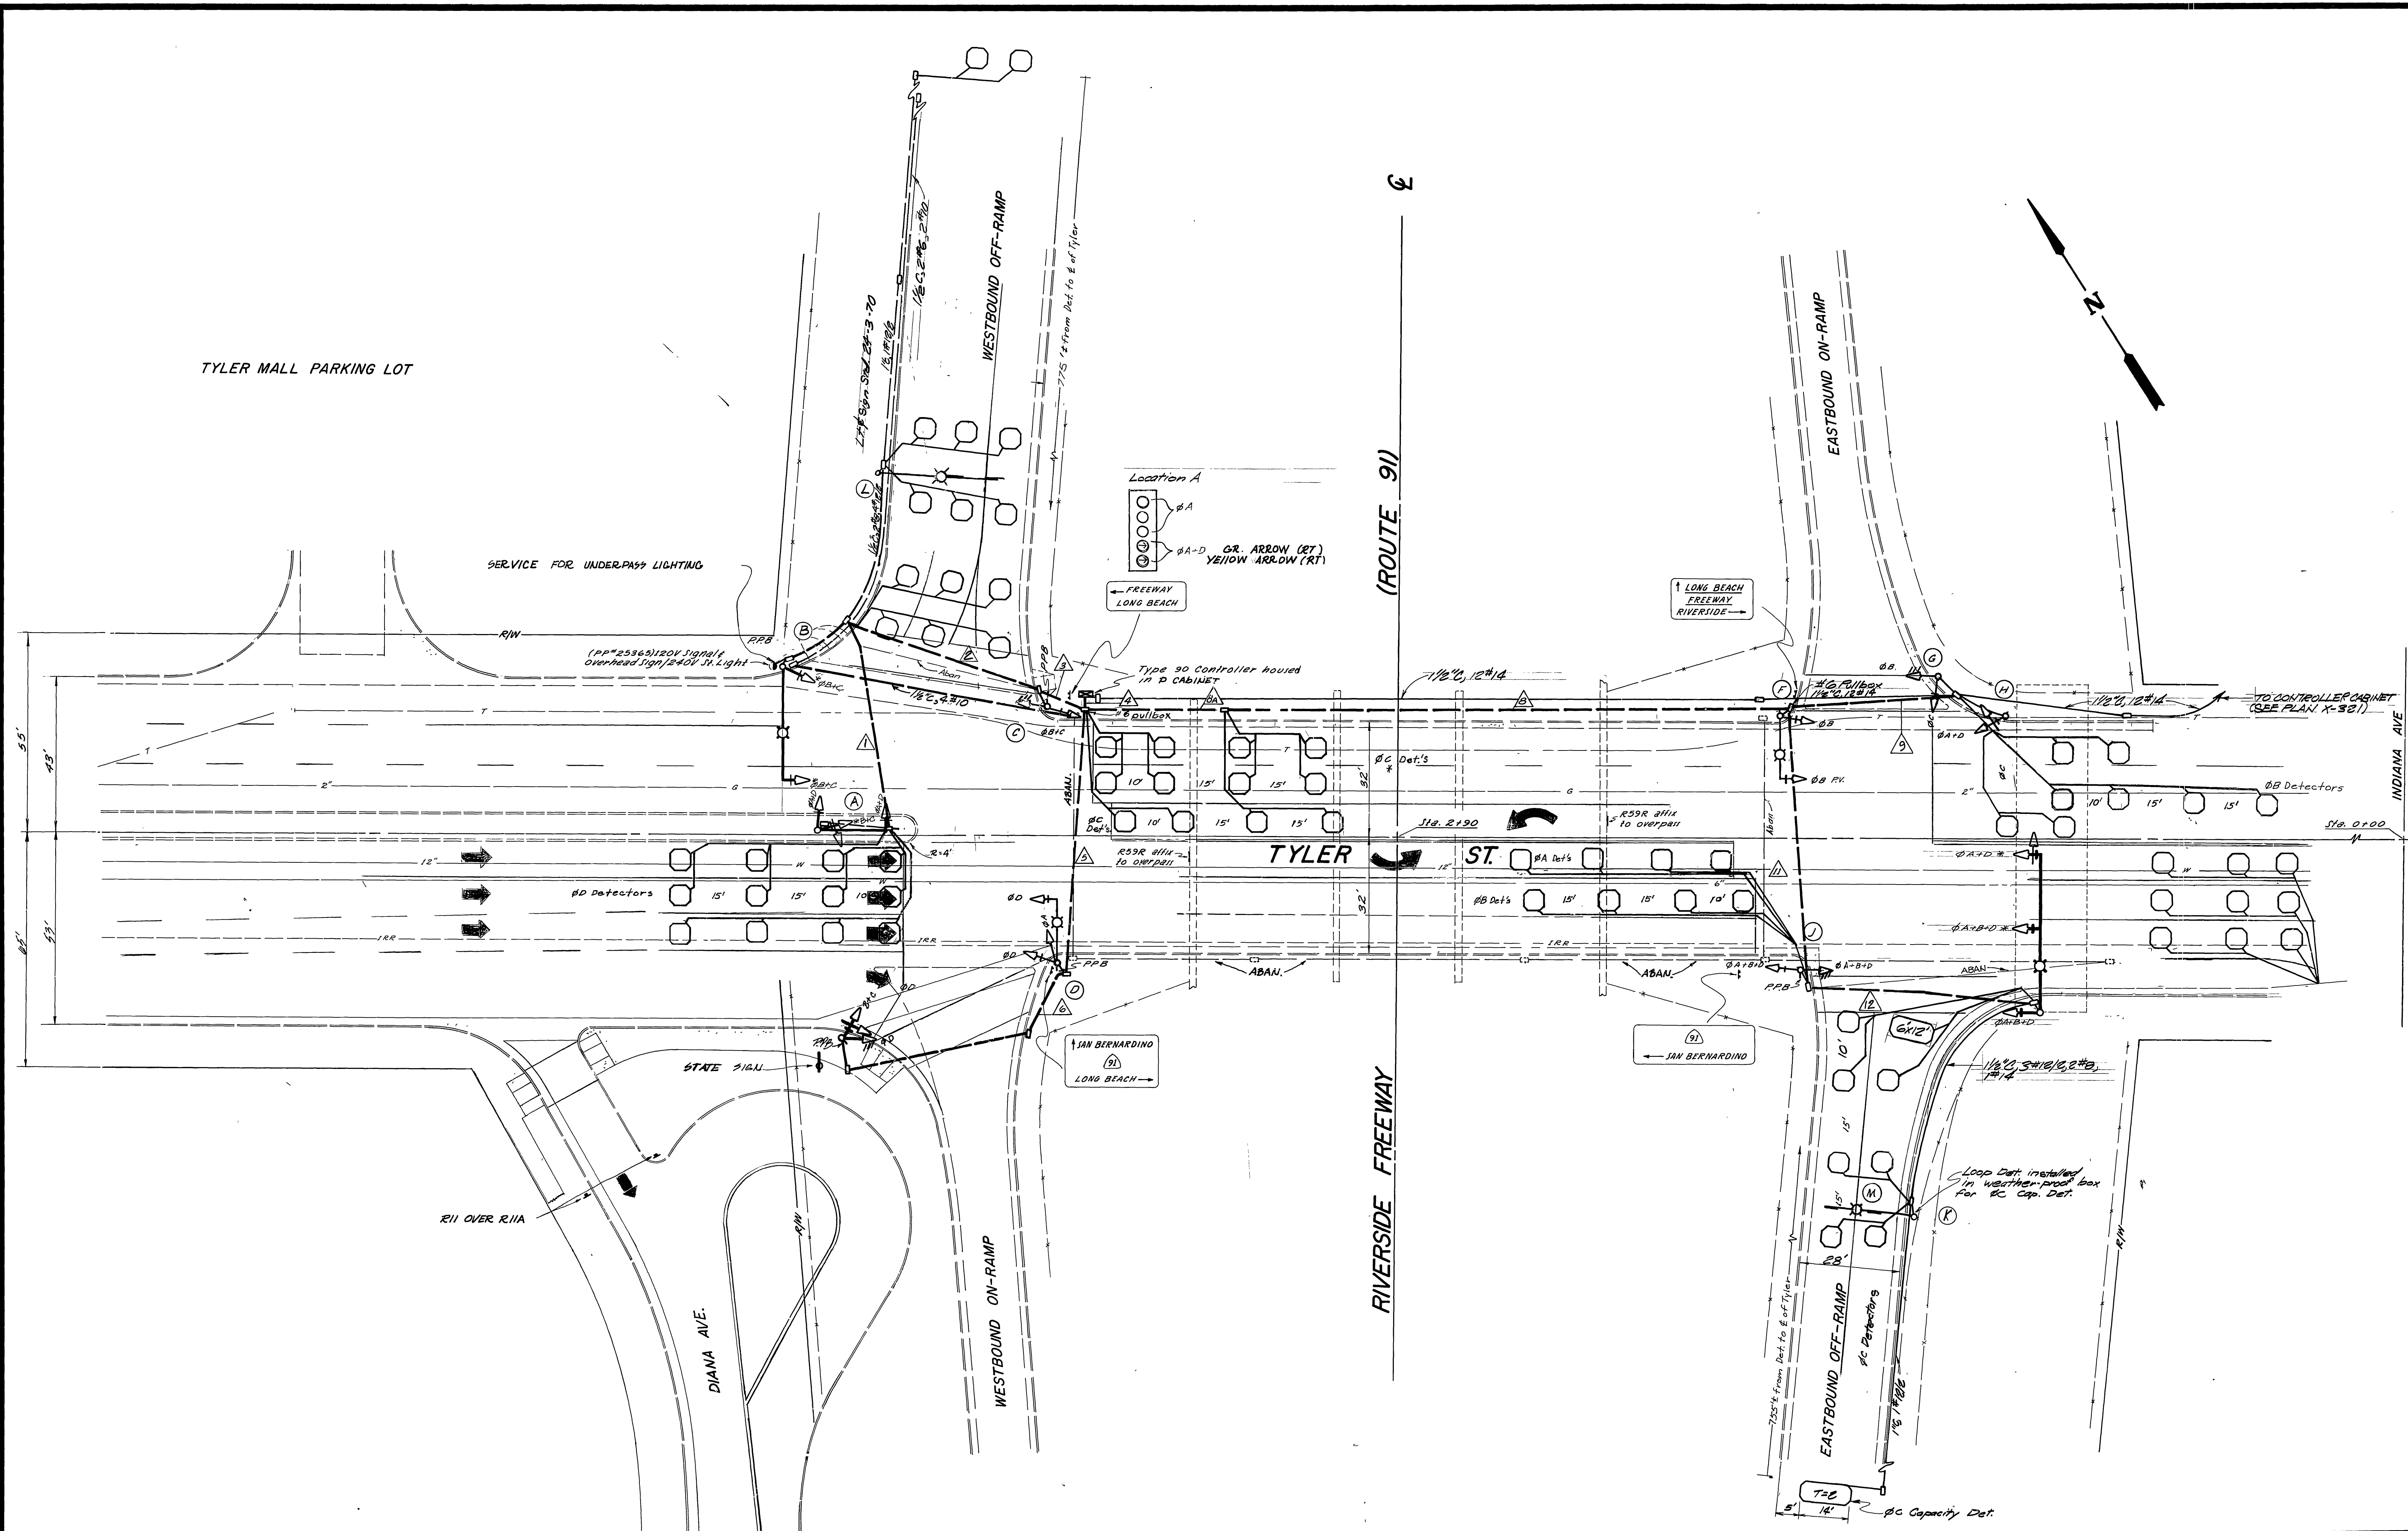

AS-BUILT PER CONT. 76-77-3 AS BUILT PER W/BE OF RAMP WIDENING AS BUILT PER MODIFICATION & AS BUILT (AND) PHASING & AS BUILT DIANA & TYLER (TREASURY) & AS BUILT PER CONT. 76-77-3 &		7-11-80 7-11-80 7-11-80 7-11-80 7-11-80	CITY OF RIVERSIDE, CALIFORNIA PUBLIC WORKS DEPARTMENT		TRAFFIC SIGNALS TYLER STREET AND RIVERSIDE FREEWAY, 91		ACCOUNT No. 30-576-307-30 DRAWING NUMBER X-320 SHEET 1 OF 2
DESIGNED BY: _____ DRAWN BY: JMK CHECKED BY: _____		APPROVED BY: _____ BY: _____ DATE: _____ APPROVED BY: _____ BY: _____ DATE: _____ APPROVED BY: _____ BY: _____ DATE: _____	PRINCIPAL ENGINEER PARK DEPARTMENT TRAFFIC DIVISION CHIEF PUB. WKS ENGR.		DIRECTOR OF PUBLIC WORKS DATE: _____		SCALE: 1" = 20'

Conductor Schedule		Conduit Run													
Conductor Function	Conductors Size	1	2	3	4	5	6	7	8	9	10	11	12	13	14
Vehicular Heads	#14 T.W.	3	3	3	6	3									
ΦA		3	3	3	6	3									
ΦB+C		3	3	3	6	3	3	3							
ΦB+C*		3	3	3											
ΦD					3	3	3	3							
ΦA+B+D					3				3	3					
ΦA+D		2	2	2	8				3	3	3				
ΦB					3				3	3					
ΦC					6				6	6	3	3	3		
Spares					3				3	3	3	3	3		
Spares		3	3	3	3	3	3	3							
Ped. Push Button	#10														
ΦC					2				2	2	1	1	1	1	
Detector Cable	#12 U.I.E. or R.H.K.														
ΦA Capacity Det			1	1	1				1	1			1	1	
ΦC Capacity Det															
ΦA			1*	1*	2*				1	1			1	1	
ΦB					3				3	3	2	2	1		
ΦC					3*				3*	2			2	2	
ΦD					2				2						
12V Common	#10 T.W.								1	1	1	1	1	1	
120V Common	#8								1	1	1	1	1	1	
Luminaires			2	2	2	2			2	2			2	2	
Signal Service			2	2	2				2	2			2	2	
Interconnect	#14 RE		1	1	1									1	
Totals	#14 T.W.	9	12	12	21	12	9	9							
	#12 U.I.E. or R.H.K.	3	7	6	6	16			10	7	2	2	5	3	
	#12 T.W.														
	#10 T.W.				2*				2*	2*	1*	1*	1*	1*	
	#8 RE		1	1	1				1	1	1	1	1	1	
Conduit Size		2"	3"	3"	2-3"	2"	1 1/2"	1 1/2"	3 1/2"	3"	2"	2"	2 1/2"	2 1/2"	1 1/2"

Place all detector cable in 1 of the 3" conduits

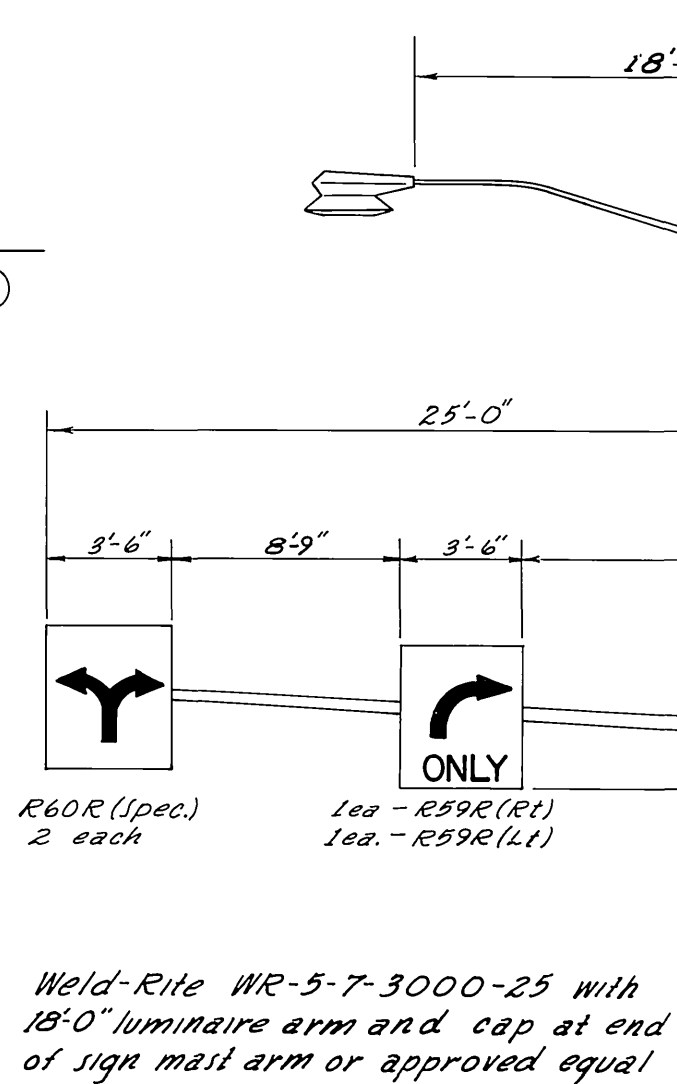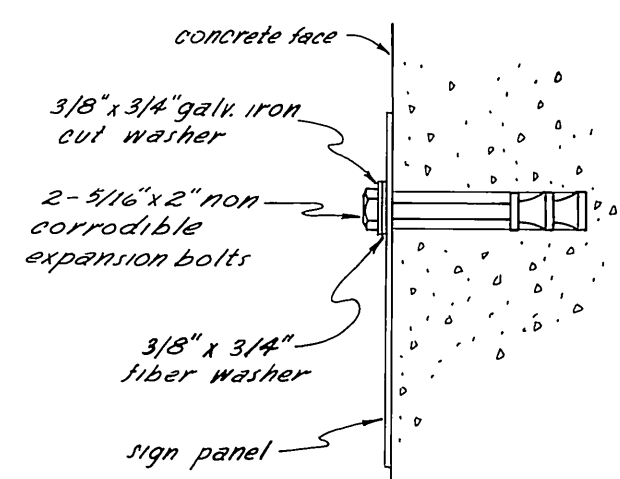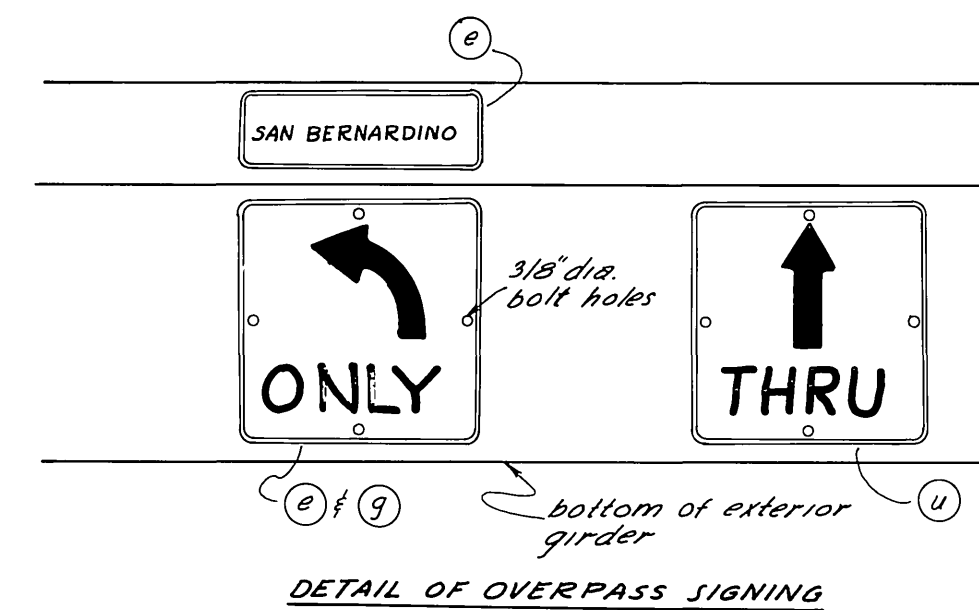

SIGNING REQUIREMENTS (also see "Sign Location Diagram")



Code	Size	Mtg.	Loc.	Facing	Remarks
R53R (PAR) (R)	24" x 24"	Signal Std.	A	N/S	Erect R53R to face south
R53R (R) (R)	24" x 24"	Wood Post	A	-	Remove f salvage exist. post f sign
W41R	48" x 48"	Light Std.	b	E	Erect
R16R/R65R	30" x 36"	Wood Post	c	-	Remove f salvage R16R
R16R	30" x 36"	Signal Std.	c	S	Erect
R16R	30" x 36"	Wood Post	d	S	Remove f salvage post f sign
R53R (L)	24" x 24"	Overpass	e	N	Affix to side of overpass. See structure Mtg. detail.
R53R (R)	24" x 24"	Signal Std.	e	S	Erect
Guide	42" x 42"	2-Wood Post	f	E	Replace with new panel f relocate 10'-20' north
R59R (L)	42" x 42"	Overpass	g	S	Affix to side of overpass. See structure Mtg. detail.
Guide	42" x 42"	2-Wood Post	h	S	Remove f salvage sign f post
R53R	24" x 24"	Signal Std.	H	N	Erect
R53R (spec)	38" x 22"	OH Signal Std.	I	N	Erect, see Detail E-14-5
W41R	48" x 48"	Wood Post	j	S	Erect
R16R/R10R/R	30" x 36"	Wood Post	k	-	Remove f salvage R16R f relocate post w/R10R
R16R	30" x 36"	Signal Std.	J	N	Erect
W41R	48" x 48"	Light Std.	k	W	Remove exist. W41R f post f erect W41R on sid.
R16R/R10R/R	30" x 36"	Wood Post	L	-	Remove f salvage R16R f relocate post w/R10R
R59R (R)	42" x 50"	OH Std.	L	E	Erect, see Detail - Location L1M
R60R	42" x 50"	OH Std.	L2	E	Erect, see Detail - Location L1M
R59R (L)	42" x 50"	OH Std.	M	W	Erect, see Detail - Location L1M
R60R	42" x 50"	OH Std.	M2	W	Erect, see Detail - Location L1M
Guide	42" x 50"	2-Wood Post	m	N	Relocate sign f posts 10' to 20' south
R16R	30" x 36"	Wood Post	n	N	Remove f salvage R16R f post
Guide	42" x 50"	2-Wood Post	o	N	Relocate sign f post 4' west
R16R/R10R/R	30" x 36"	Wood Post	p	-	Remove f salvage sign f post
R10R/R	30" x 36"	Wood Post	q	E	Remove f salvage sign f post
R16R/R65R	30" x 36"	Wood Post	r	W	Relocate sign f post 10'-20' west
R60R (spec)	-	Wood Post	s	N	Erect
R60R (spec)	-	Wood Post	t	N	Erect
R60R (spec)	-	Overpass	u	N	Affix to side of overpass. See structure Mtg. detail.
Guide	-	2-Wood Post	v	S	Erect

Equipment Schedule

Location	Standard	Vehicle Equipment			Ped. Equipment		Luminaire	Remarks
		Head	Mtg	Base Plate	Head	Mtg		
A	Type I	* 1W3C(12')	A-4	1				
B	Type III	* 1W3C(12')	M-2	1			400W	Remove f salvage exist. steel std. f luminaire.
C	Type I	1W3C	B-1	1				
D	Type III	* 1W3C(12')	M-2	1			400W	Remove f salvage exist. steel std. f luminaire.
E	Type I	1W3C(12')	A-4	1		5(8")		
F	Type III	1W3C(12')	M-2	1			400W	Remove f salvage existing steel std. f luminaire.
G	Type I	2W3C	B-2	1				
H	Type I	1W3C(12')	A-4	1		3(8")	400W	
I	Type III	* 1W3C(12')	M-2	1				
J	Type I	2W3C	B-2	1				
K	Special Std.						1000W	Remove f salvage exist. steel std. f luminaire. See detail for type of std. f additional data.
L	Special Std.						1000W	See detail for type of std. f additional data.
M	Special Std.						1000W	See detail for type of std. f additional data.

* Programmed Visibility Signal Heads and Type I stds will be City furnished.

TYLER ST - RIVERSIDE FWY ON AND INDIANA AVENUE COORDINATED PHASING

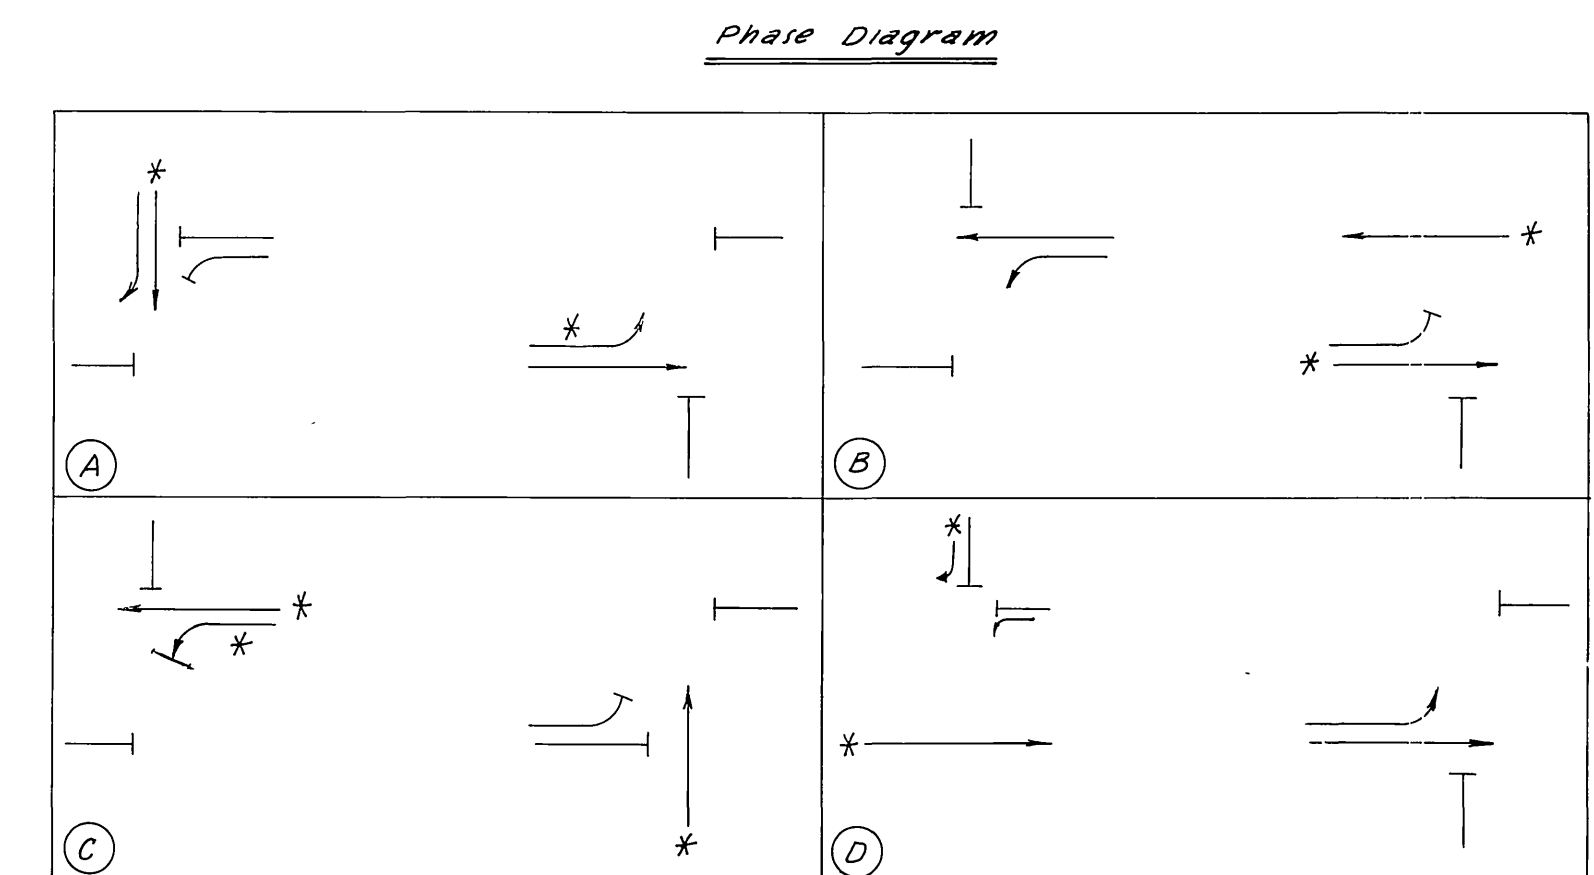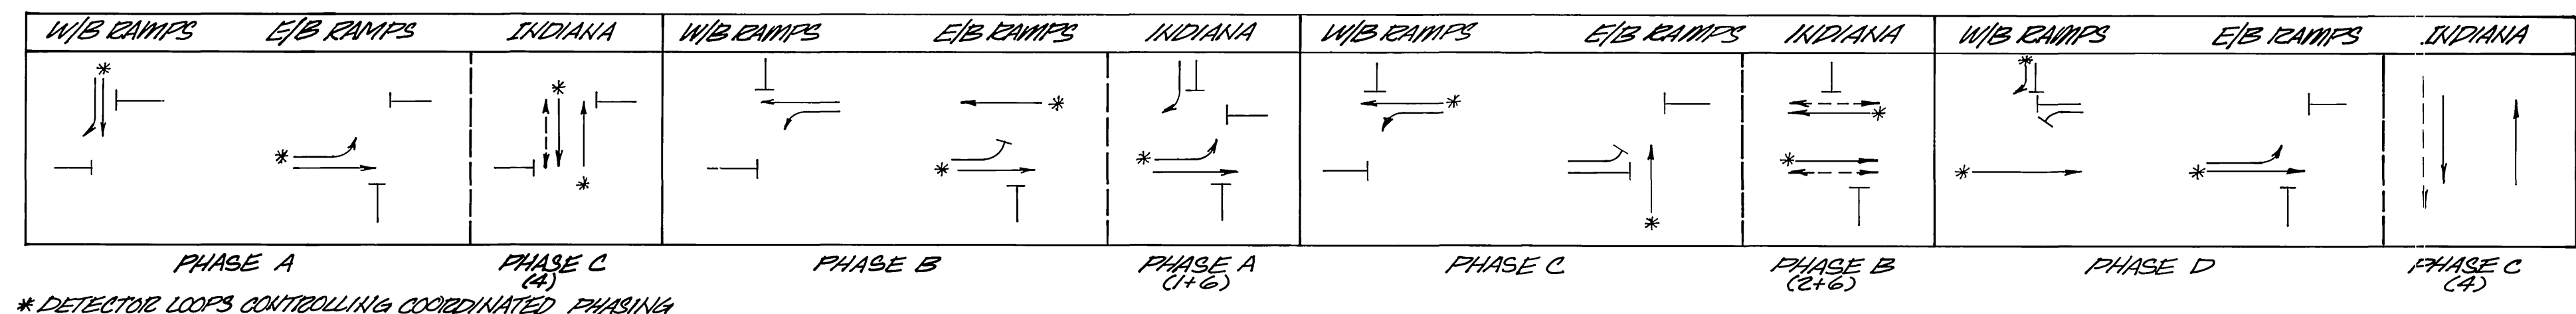

CITY OF RIVERSIDE, CALIFORNIA PUBLIC WORKS DEPARTMENT		TRAFFIC SIGNALS TYLER STREET AND RIVERSIDE FREEWAY, 91		ACCOUNT No. 30-576-301-30 DRAWING NUMBER X-320 SHEET 2 OF 2
APPROVED BY PRINCIPAL ENGINEER	BY DATE	APPROVED BY DIRECTOR OF PUBLIC WORKS	DATE	SCALE: NONE
DESIGNED BY	DRAWN BY JAW	CHECKED BY		