
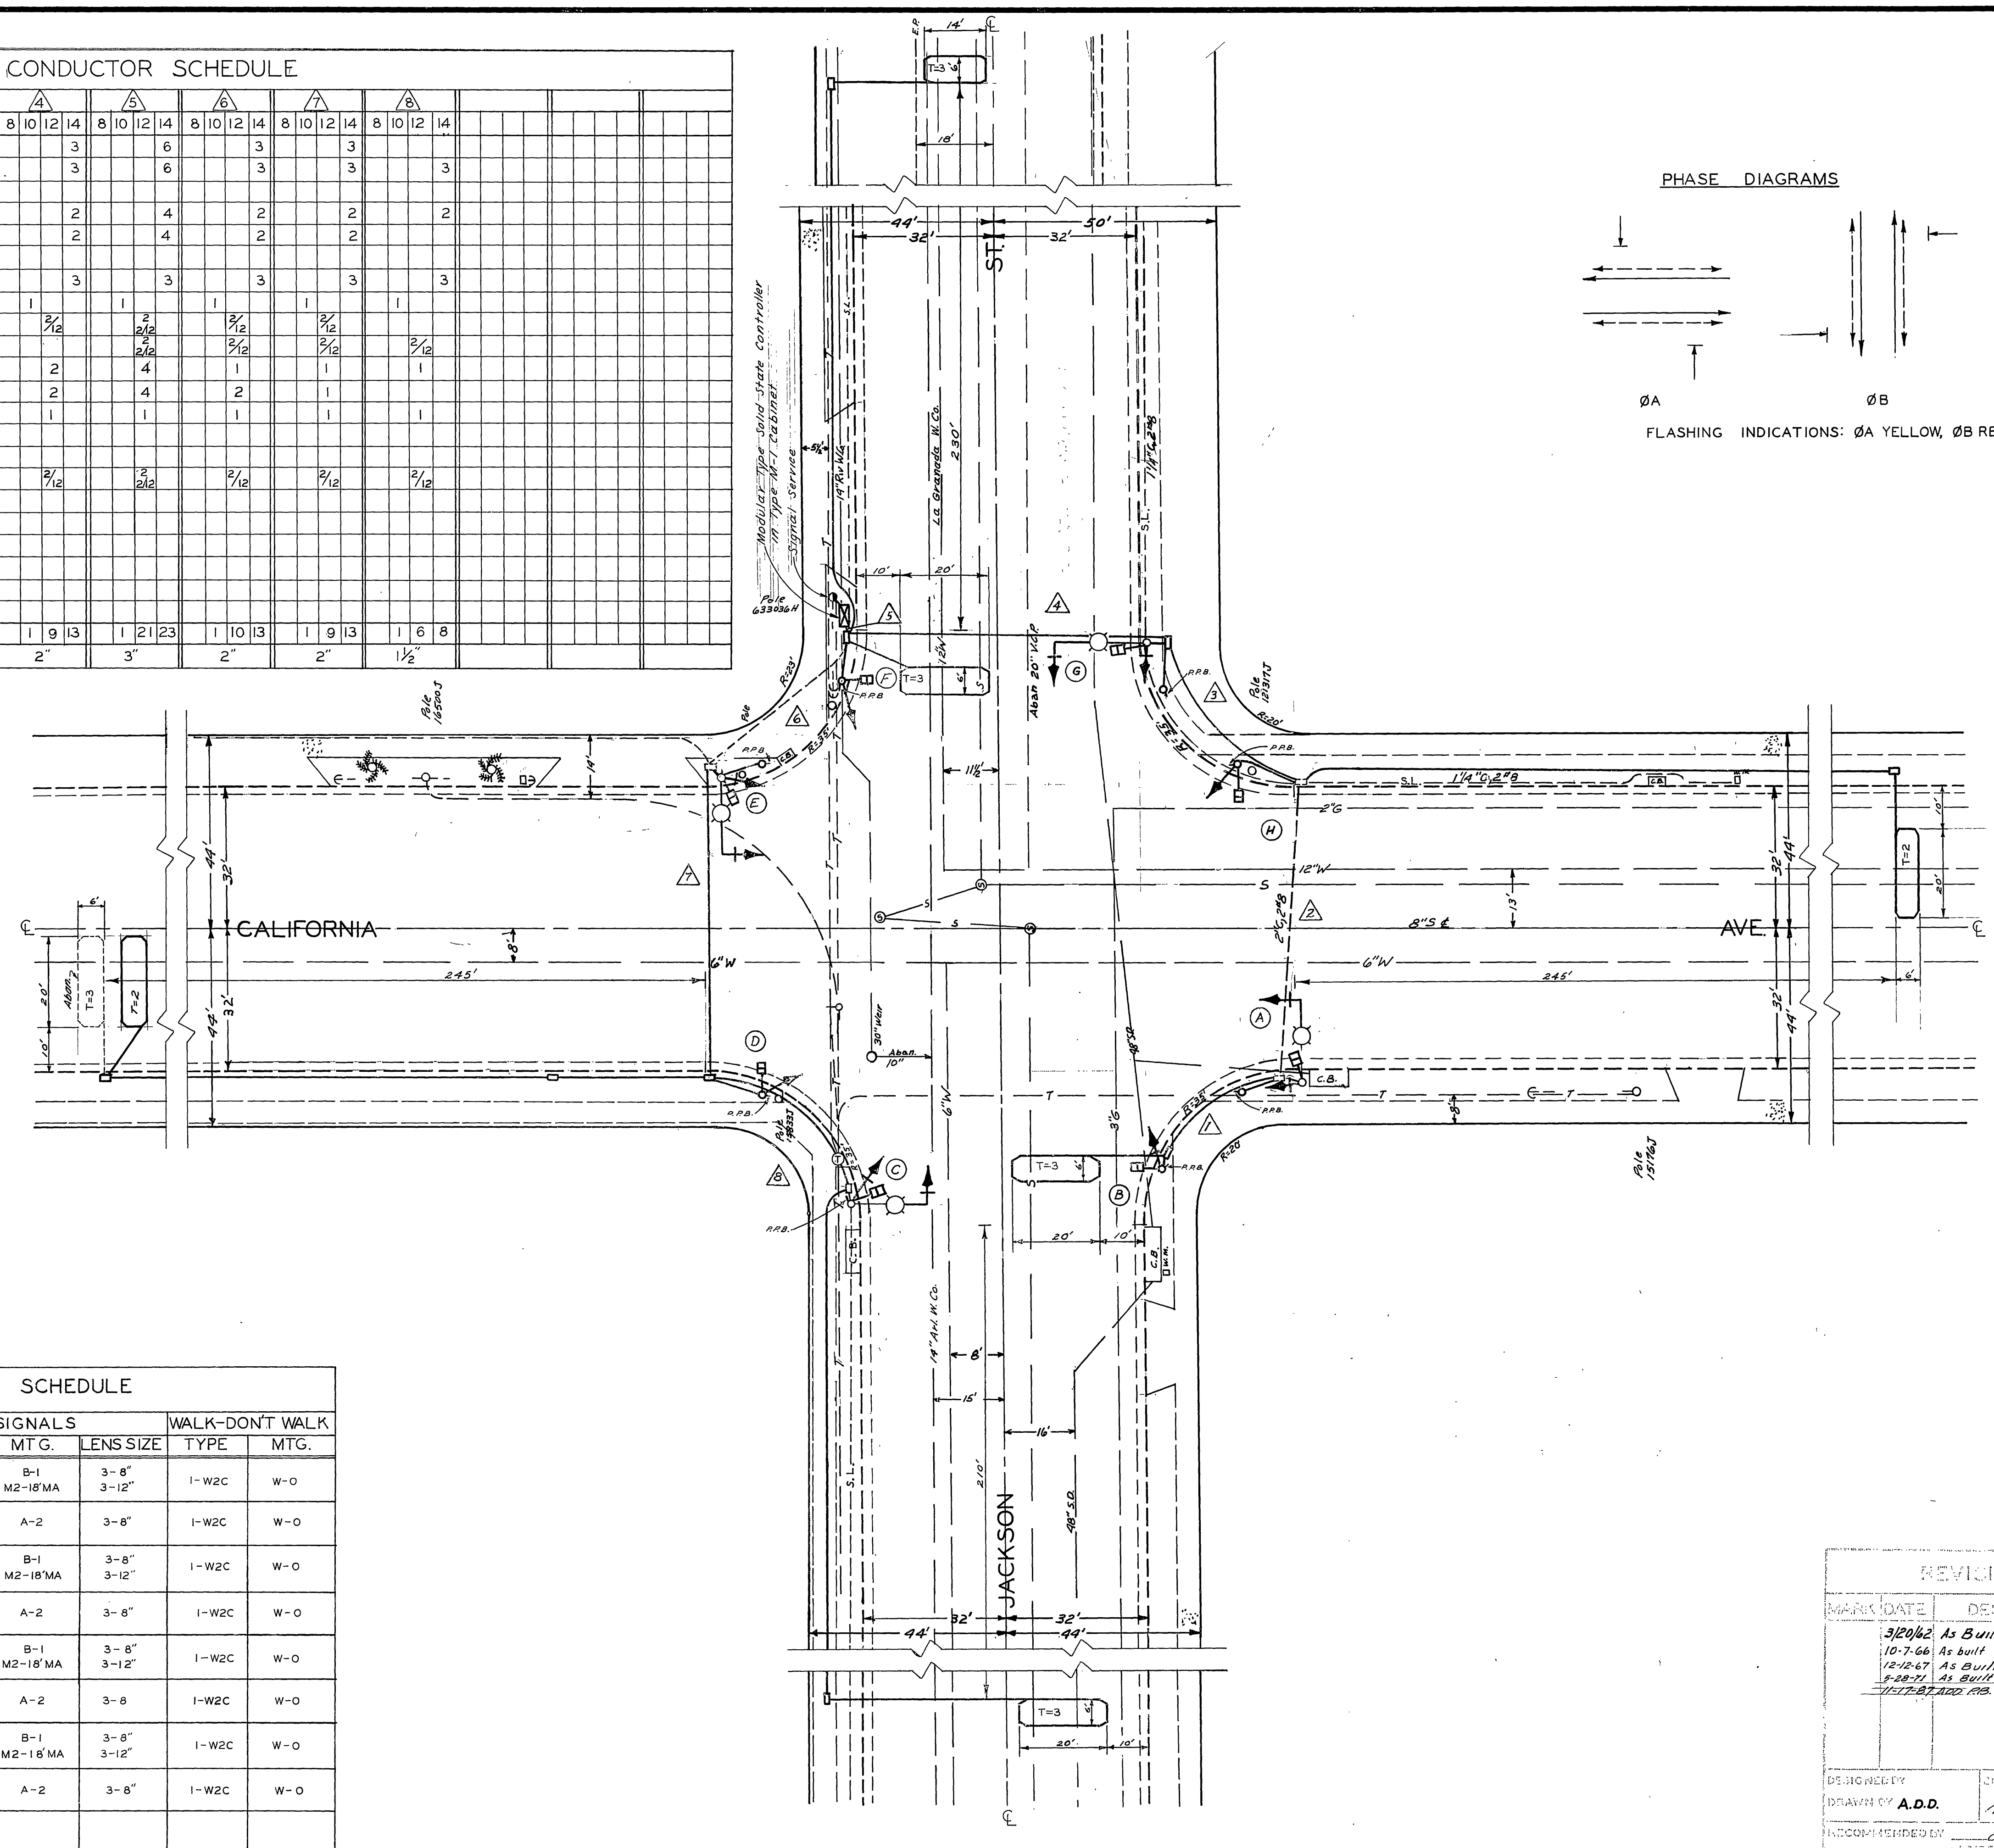


CONDUCTOR SCHEDULE																																
CONDUCTOR RUN	A			B			C			D			E			F			G			H										
CONDUCTORS	8	10	12	14	8	10	12	14	8	10	12	14	8	10	12	14	8	10	12	14	8	10	12	14	8	10	12	14				
Ø A																																
Ø B																																
Ø A W-DW																																
Ø B W-DW																																
SPARES																																
120V NEUTRAL																																
Ø A DETECTOR																																
Ø B DETECTOR																																
Ø A PPB																																
Ø B PPB																																
12V NEUTRAL																																
SIGNAL SERVICE																																
LUMINAIRES																																
Ø B CALL DET.																																
TOTAL CONDUCTORS	1	8	2	15	13	1	8	13	1	9	13	1	21	23	1	10	13	1	9	13	1	6	8									
CONDUIT SIZE	1 1/2"	2"	2"	2"	2"	2"	2"	2"	2"	2"	2"	2"	2"	2"	2"	2"	2"	2"	2"	2"	2"	2"	2"	2"	2"	2"	2"	2"	2"	2"	2"	

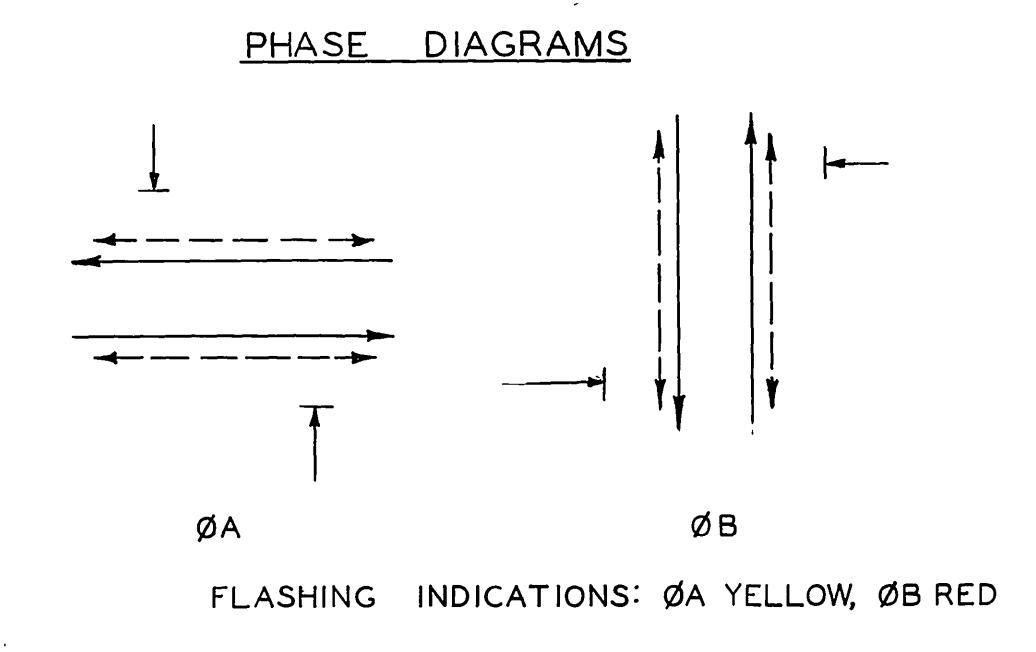

POLE AND SIGNAL SCHEDULE							
LOCATION	STANDARD	LUMINAIRE	SIGNALS			WALK-DON'T WALK	
			TYPE	MT.G.	LENS SIZE	TYPE	MT.G.
(A)	56J10	20000 MV	I-W3C I-W3C	B-1 M2-18'MA	3-8" 3-12"	I-W2C	W-O
(B)	TYPE I		I-W3C	A-2	3-8"	I-W2C	W-O
(C)	68J10	20000 MV	I-W3C I-W3C	B-1 M2-18'MA	3-8" 3-12"	I-W2C	W-O
(D)	TYPE I			A-2	3-8"	I-W2C	W-O
(E)	56D8	20000 MV	I-W3C I-W3C	B-1 M2-18'MA	3-8" 3-12"	I-W2C	W-O
(F)	TYPE I			A-2	3-8"	I-W2C	W-O
(G)	68J10	20000 MV	I-W3C I-W3C	B-1 M2-18'MA	3-8" 3-12"	I-W2C	W-O
(H)	TYPE I			A-2	3-8"	I-W2C	W-O

REVISIONS		CITY OF RIVERSIDE CALIFORNIA DEPARTMENT OF PUBLIC WORKS	
MARK	DATE	DESCRIPTION	
3/20/62		As Built	ADD
10-7-66		As built (south corner)	M.G.
12-2-67		As built	M.W.
5-28-71		As built (del. 6/18)	M.W.
11-17-72		As built (del. 6/18)	M.G.
DESIGNED BY		CHECKED BY	APPROVED BY
DRAWN BY A.D.D.			
INCOMPLETED BY		DATE	3/20/62
PROJECT NO. 822-7 (1966)		X-330	