

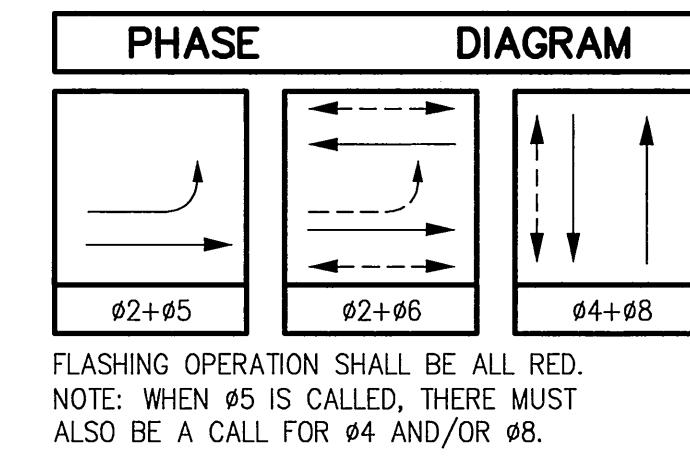


CONDUCTOR		TABLE					
AWG	CIRCUIT	RUNS					
		1	2	3	4	5	6
Ø2		3	3	3	6	3	3
Ø4		-	3	3	3	-	-
Ø5		2	2	2	4	2	2
Ø6		-	3	3	3	-	-
Ø8		-	-	-	6	3	-
Ø2 PED		2	2	2	2	-	-
Ø4 PED		-	2	2	4	-	-
Ø6 PED		-	-	2	4	2	2
Ø2 PPB		1	1	1	1	-	-
Ø4 PPB		-	1	1	1	-	-
Ø6 PPB		-	-	-	2	1	-
PPB COMMON		1	1	1	2	1	-
SPARES		3	3	3	6	3	3
TOTAL		12	21	23	44	15	10
Ø2 DETECTOR		-	2	2	2	-	-
Ø4 DETECTOR		-	-	-	2	-	-
Ø5 DETECTOR		-	2	2	2	-	-
Ø6 DETECTOR		-	-	-	2	2	2
Ø8 DETECTOR		1	1	1	1	-	-
TOTAL		1	5	5	9	2	2
#12 I.I.S.N.S.		2	2	2	-	-	-
#10 SIGNAL COMMON		1	1	1	2	1	1
* INTERCONNECT		-	1	1	-	-	-
#B LUMINAIRE		2	2	2	-	-	-
SIGNAL SERVICE		-	-	-	2	-	-
TOTAL		2	2	2	2	-	-
CONDUIT SIZE		2"	3"	3"	2-3"	3"	2"

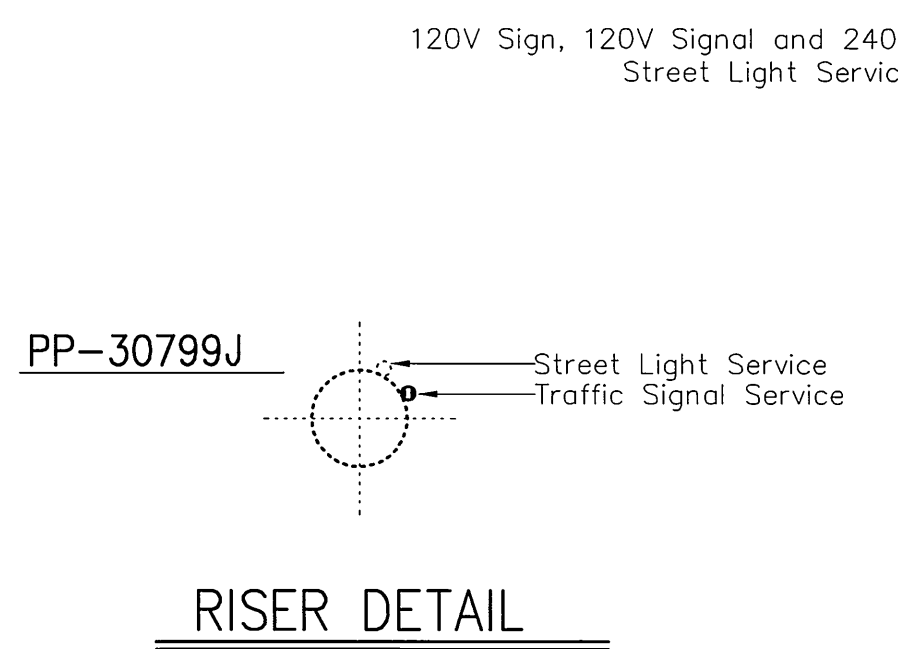

No.	TYPE	STANDARD			LUM. HPSV	I.I.S.N.S. LEGEND	SCHEDULE				REMARKS
		HGT.	SIG. M.A.	LUM. M.A.			SIGNAL HEAD	SIGNAL MOUNTING VEHICLE	PPB PHASE	PED	
(A)	19-2-80	30'	25'	12'	250W	County Circle Dr	1W3C	MAS	SP-1-T	Ø4	
(B)	18-1-80	17'	25'				1W3C	MAS	SP-1-T	Ø6	
(C)	1-A	10'					1W3C	TV-1-T		Ø6	
(D)	1-A	10'					1W5C	TV-1	SP-1-T		
(E)	19-2-80	30'	25'	12'	250W	County Circle Dr	1W5C	MAS	SP-1-T	Ø2	
(F)	18-2-80	17'	25'			Hole Ave 10200	1W3C	MAS	SP-2-T	Ø4, Ø2	

ALL EQUIPMENT IS EXISTING.

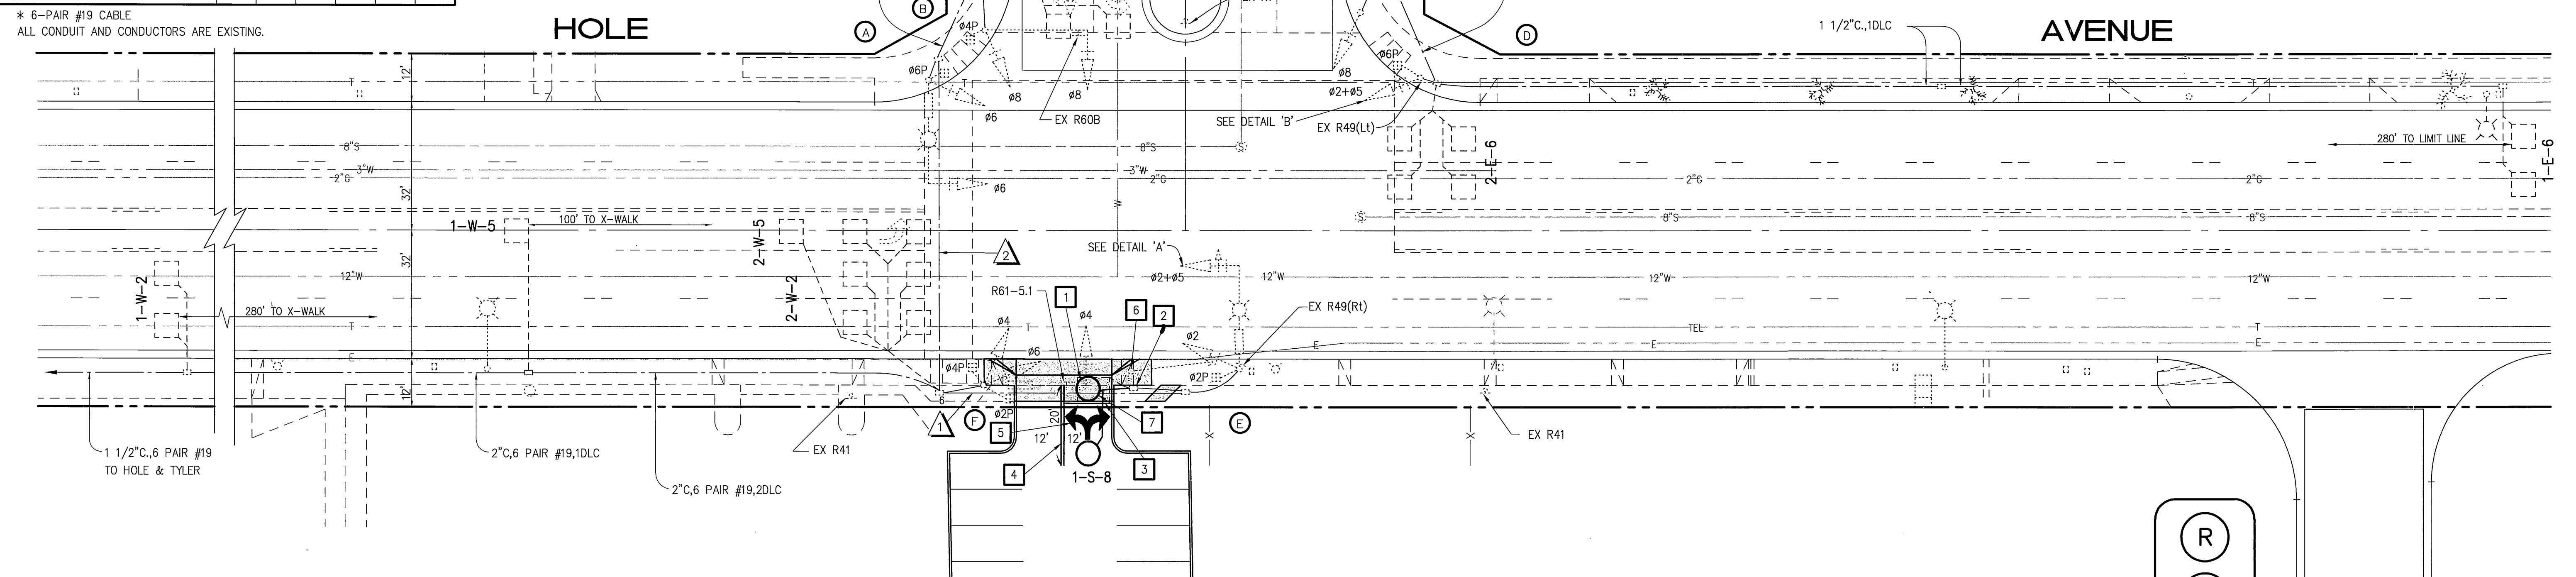


* 6-PAIR #19 CABLE
ALL CONDUIT AND CONDUCTORS ARE EXISTING.

DETECTOR		ASSIGNMENT	
CHANNELS	LOOP DESIGNATION	NUMBER OF LOOPS	FEATURES
1	1-W-5	1	
2	2-W-5	3	
1,2	1-W-2	2	■●
1	2-W-2	4	
1,2	1-E-6	2	■●
1	2-E-6	4	
2	1-N-4	3	
1	2-N-4	3	
2	1-S-8	1	

■ = CALL-HOLD (EXTENSION).
● = ADDITIONAL CHANNEL FOR SAMPLING (FUTURE).
ALL SENSOR UNITS ARE EXISTING.
NOTE: 1-S-8 DETECTOR LOOPS ARE PREFORMED.


- GENERAL NOTES:**
- THIS TRAFFIC SIGNAL WORK REQUIRES A "STREET OPENING PERMIT" OBTAINED AT THE PUBLIC WORKS DEPARTMENT'S COUNTER ON THE THIRD FLOOR OF CITY HALL.
 - TRAFFIC SIGNAL WORK SHALL BE PERFORMED IN ACCORDANCE TO THE MOST CURRENT PROVISIONS OF SECTION 86 OF THE STANDARD SPECIFICATIONS, THE STANDARD PLANS, BOTH PUBLISHED BY THE STATE OF CALIFORNIA DEPARTMENT OF TRANSPORTATION (CALTRANS), THE CONSTRUCTION PLAN(S), THE CONTRACT SPECIAL PROVISIONS AND AS DIRECTED BY THE CITY TRAFFIC ENGINEER.
 - CONTACT TRAFFIC SIGNAL MAINTENANCE (909-351-6096) 48 HOURS IN ADVANCE TO SCHEDULE INSPECTION OF THE WORK PERFORMED. INSPECTION FOR TRAFFIC SIGNAL WORK SHALL BE AT THE RATE OF \$55.00 PER HOUR.
 - THE PRIVATE ENGINEER SIGNING THESE PLANS IS RESPONSIBLE FOR ASSURING THE ACCURACY AND ACCEPTABILITY OF THE WORK HEREON. IN THE EVENT OF DISCREPANCIES ARISING DURING CONSTRUCTION, THE PRIVATE ENGINEER SHALL BE RESPONSIBLE FOR DETERMINING AN ACCEPTABLE SOLUTION AND REVISING THESE PLANS FOR APPROVAL BY THE CITY TRAFFIC ENGINEER.
 - CONSTRUCTION WORK THAT WILL CAUSE DAMAGE TO THE DETECTOR LOOP(S) SHALL NOT BE PERFORMED UNTIL TRAFFIC SIGNAL MAINTENANCE PERSONNEL HAVE BEEN NOTIFIED (909-351-6096) AND THE NECESSARY TIMING ADJUSTMENTS MADE TO MAINTAIN SIGNAL OPERATION.
 - ALL EQUIPMENT AND LOOP LOCATIONS SHALL BE APPROVED BY THE CITY TRAFFIC ENGINEER OR HIS INSPECTOR PRIOR TO INSTALLATION BY THE CONTRACTOR.
 - ALL DETECTOR LOOPS SHALL BE TYPE E WITH 10' AND 15' SPACING IN THE DIRECTION OF TRAVEL UNLESS SHOWN OTHERWISE.
 - ALL DETECTOR LOOPS SHALL BE INSTALLED IN THE PRESENCE OF THE CITY TRAFFIC ENGINEER'S INSPECTOR.
 - CONDUCTORS FOR DETECTOR LOOPS SHALL BE TYPE 2.

- CONSTRUCTION NOTES (THIS SHEET):**
- ABANDON EXISTING LOOP DETECTOR AND INSTALL NEW TYPE E 6' ROUND LOOP DETECTORS PER STATE STANDARD PLAN ES-5B.
 - SPlice NEW LOOP DETECTORS TO EXISTING LOOP DETECTOR LEAD-IN CABLE.
 - INSTALL 12" THERMOPLASTIC LIMIT LINE PER CITY STD. (±12 L.F.).
 - INSTALL 4" THERMOPLASTIC DOUBLE YELLOW STRIPE (±20 L.F.).
 - INSTALL THERMOPLASTIC "ARROW" LEGEND PER CITY STD. (1 EA.).
 - PROTECT IN PLACE.
 - INSTALL TYPE 2 PREFORMED LOOP.

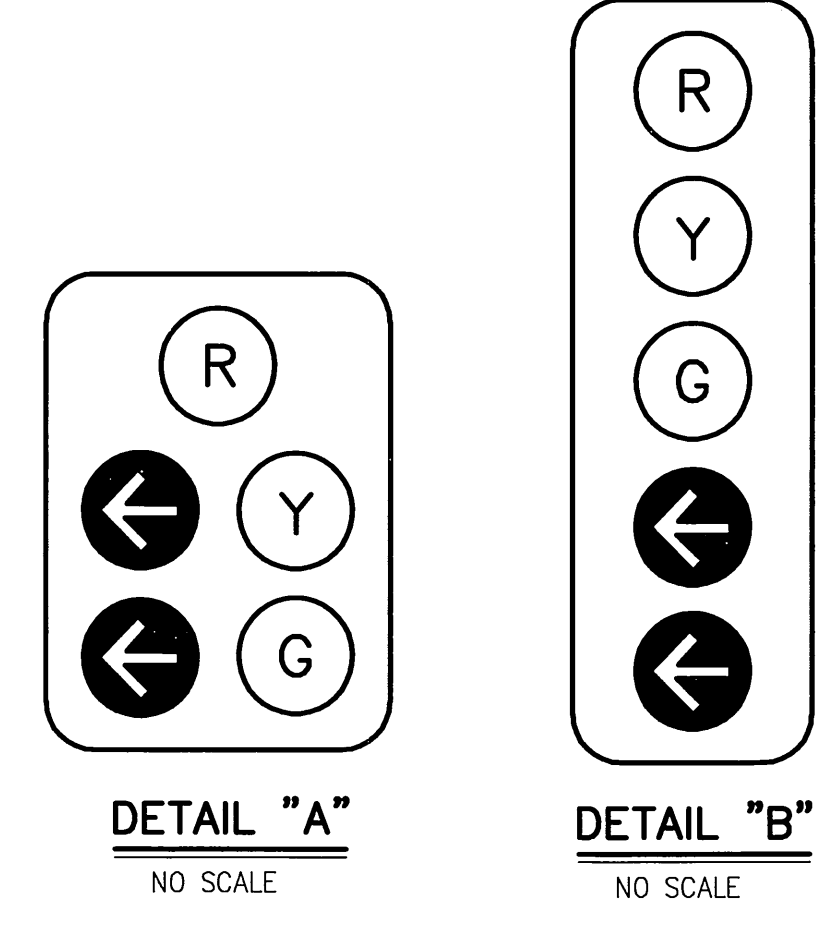

TRAFFIC No. 1575
DATE: 9-27-01
AGA Job No.: 611-001
AGA File Name: NORMS_MD
Print Date: 9/27/01
Last Revision: 9/27/01

PROJECT: NORMS RESTAURANT
3887 TYLER STREET
RIVERSIDE, CA.

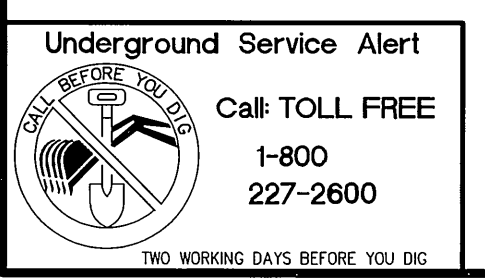



CITY OF RIVERSIDE, CALIFORNIA DEPARTMENT OF PUBLIC WORKS				TRAFFIC SIGNAL PLAN		ACCOUNT NO.
APPROVED BY		DATE	BY	APPROVED BY		
PRINCIPAL ENGINEER		10/5/01	AG	Mum Bag		
INSPECTION				PUBLIC WORKS DIRECTOR		
TRAFFIC DIVISION		10/2/01	CS	DATE		10/2/01
CHIEF P. W. ENGINEER				HORIZ. SCALE: 1" = 20'		VERT. SCALE: 1" = -
DESIGNED BY		DRAWN BY	CHECKED BY	HOLE AVENUE AND COUNTY CIRCLE DRIVE		X-338A
				SHEET 1 OF 1		

CONDUCTOR		TABLE					
AWG	CIRCUIT	RUNS					
		1	2	3	4	5	6
Ø2		3	3	3	3	6	3
Ø4		-	3	3	3	3	-
Ø5		2	2	2	2	4	2
Ø6		-	3	3	3	3	-
Ø8		-	-	-	3	6	-
Ø2 PED		2	2	2	2	2	-
Ø4 PED		-	2	2	2	2	-
Ø6 PED		-	2	2	2	4	2
Ø2 PPB		1	1	1	1	1	-
Ø4 PPB		-	1	1	1	1	-
Ø6 PPB		-	-	-	1	2	-
PPB COMMON		1	1	1	1	2	-
SPARES		3	3	3	3	6	3
TOTAL		12	21	23	27	42	10


Ø2 DETECTOR	-	2	2	2	2	-
Ø4 DETECTOR	-	-	-	2	2	-
Ø5 DETECTOR	-	2	2	2	2	-
Ø6 DETECTOR	-	-	-	2	2	-
Ø8 DETECTOR	1	1	1	1	1	-
TOTAL	1	5	5	7	9	2

#12 I.I.S.N.S.	2	2	2	2	2	-
#10 SIGNAL COMMON	1	1	1	1	2	1
* INTERCONNECT	-	1	1	1	1	-
#8 LUMINAIRE	2	2	2	-	-	-
SIGNAL SERVICE	-	-	-	2	2	-
TOTAL	2	2	2	2	2	-

CONDUIT SIZE	2"	3"	3"	3"	2-3"	2"
* 6-PAIR #19 CABLE						

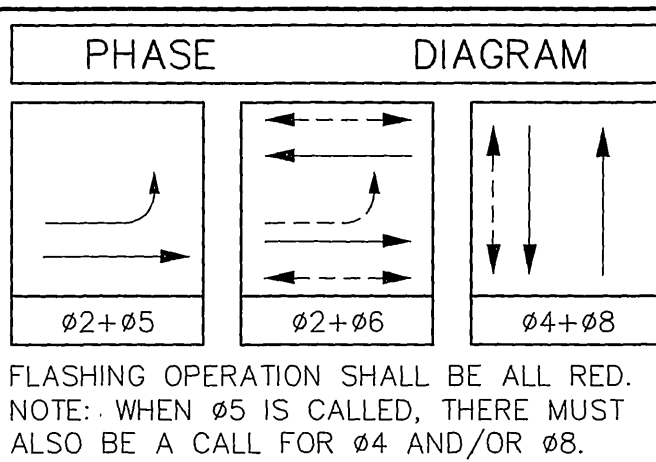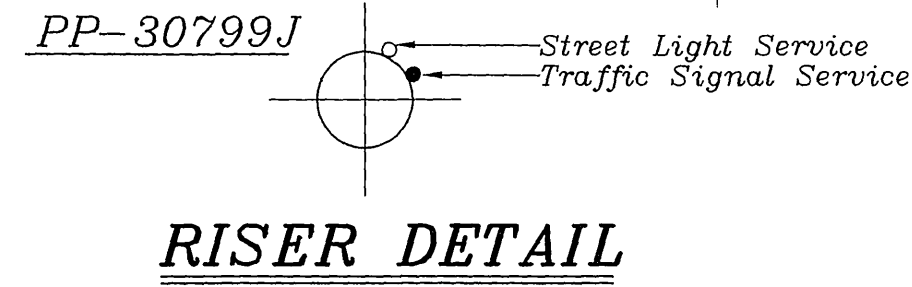



No.	TYPE	STANDARD				LUM. HPSV	I.I.S.N.S. LEGEND	SCHEDULE			REMARKS
		HGT.	SIG.	M.A.	LUM. M.A.			SIGNAL HEAD	SIGNAL VEHICLE	MOUNTING PED	
(A)	19-2-80	30'	25'	12'	250W	County Circle Dr	1W3C	MAS			
							1W3C	SV-1-T	SP-1-T	Ø4	
(B)	18-1-80	17'	25'				1W3C	MAS			
							1W3C	SV-1-T	SP-1-T	Ø6	
(C)	1-A	10'					1W3C	TV-1-T		Ø6	
(D)	1-A	10'					1W5C	TV-1	SP-1-T		
(E)	19-2-80	30'	25'	12'	250W	County Circle Dr	1W5C	MAS			
							1W3C	SV-1-T	SP-1-T	Ø2	
(F)	18-2-80	17'	25'			Hole Ave 10200	1W3C	MAS			
							1W3C	SV-2-TB	SP-2-T	Ø4,Ø2	

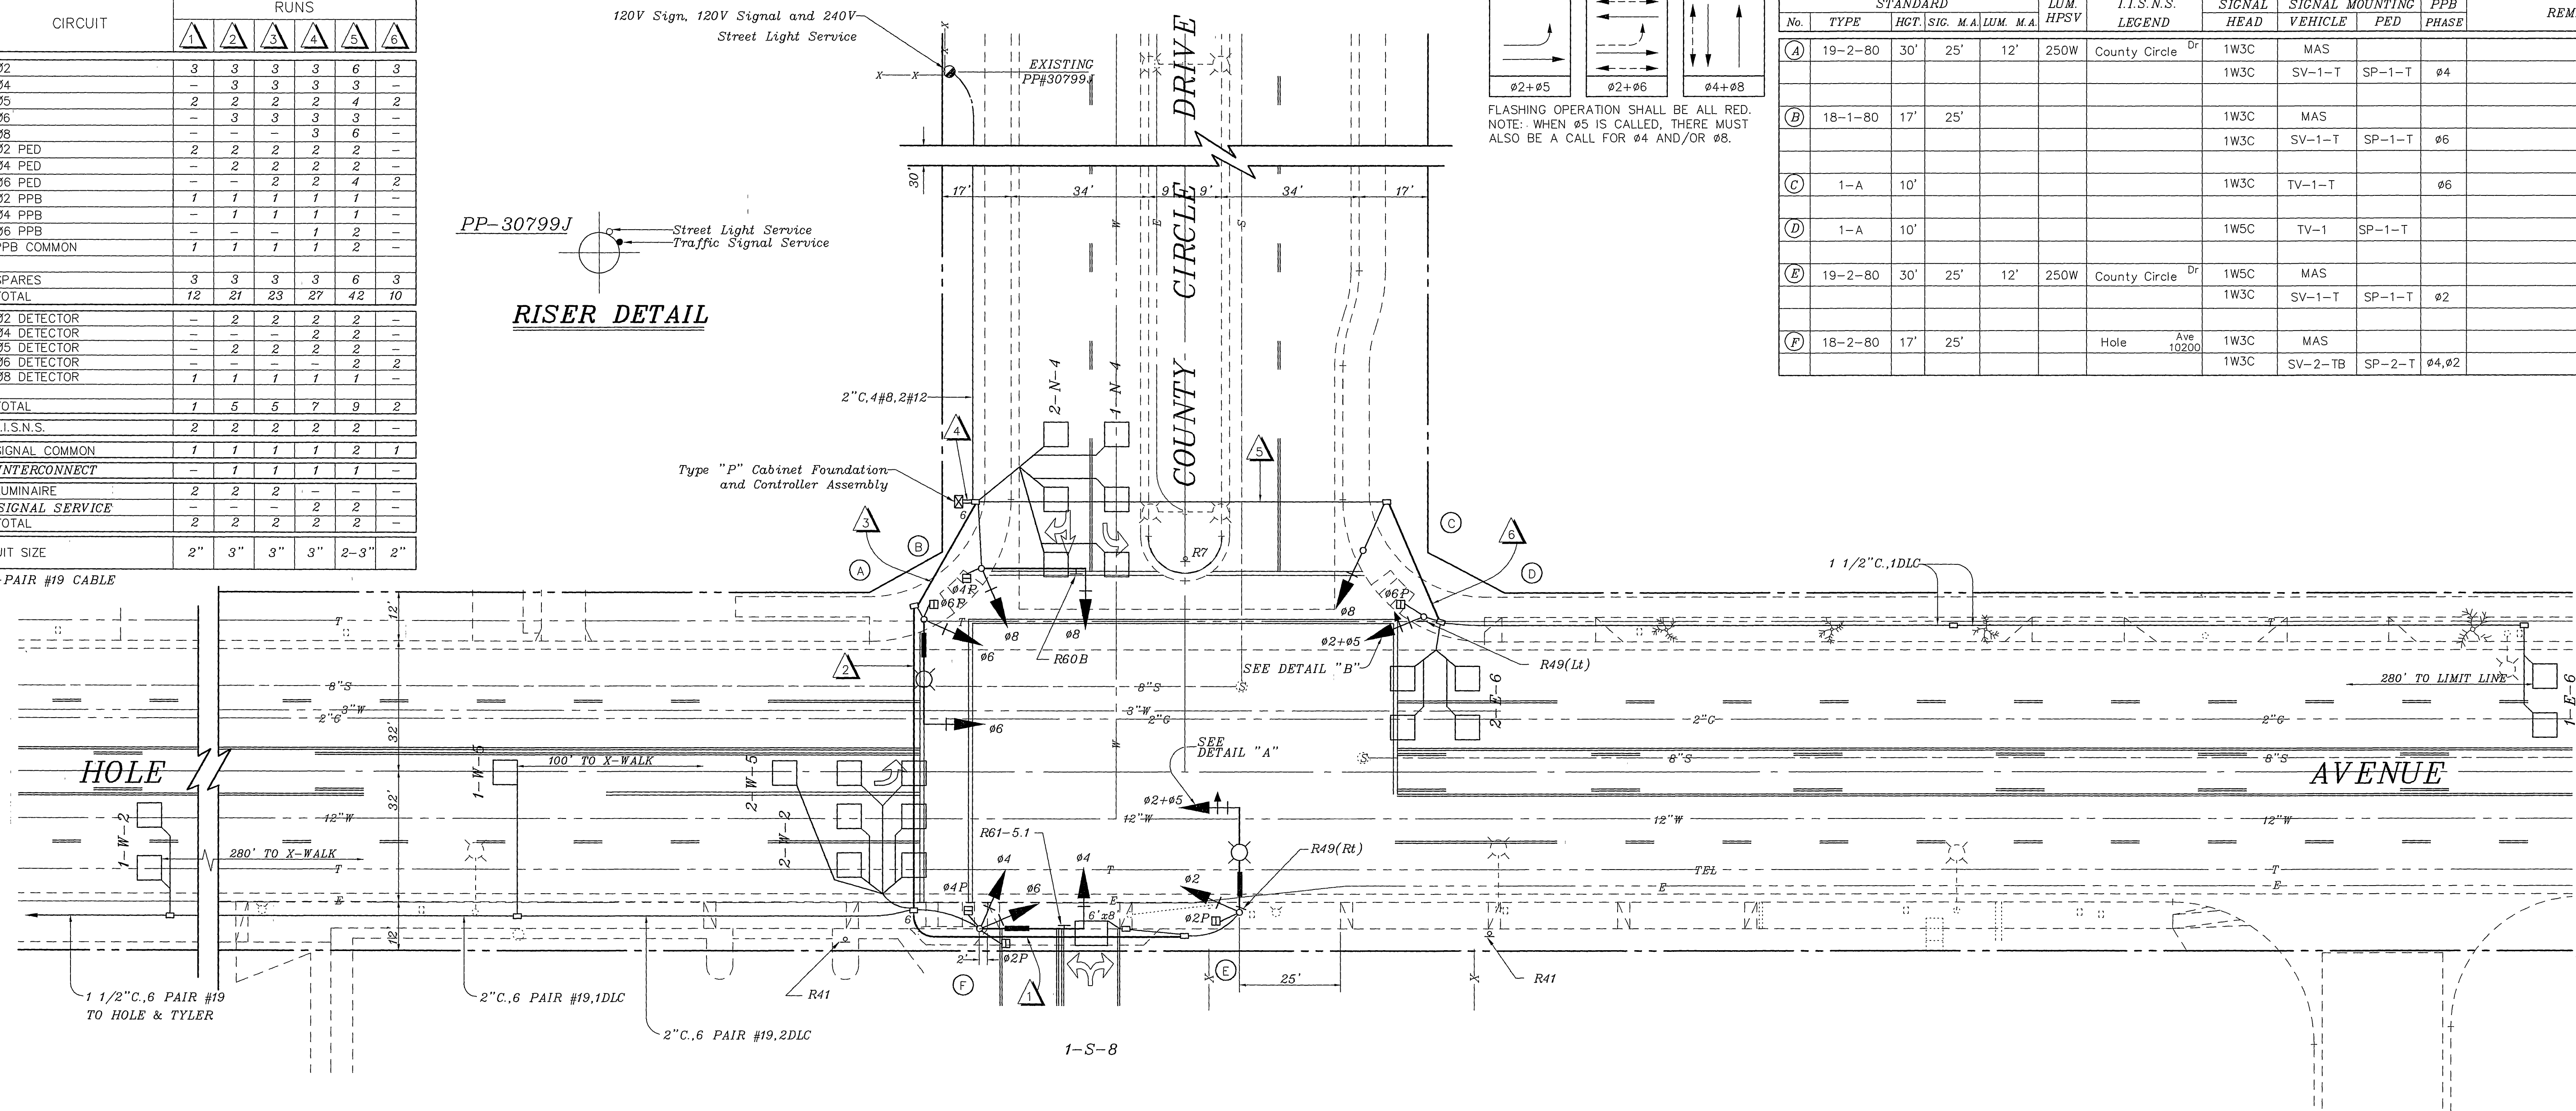

DETECTOR		ASSIGNMENT	
CHANNELS	LOOP DESIGNATION	NUMBER OF LOOPS	FEATURES
1	1-W-5	1	
2	2-W-5	3	
1,2	1-W-2	2	■ ●
1	2-W-2	4	
1,2	1-E-6	2	■ ●
1	2-E-6	4	
2	1-N-4	3	
1	2-N-4	3	
2	1-S-8	1	

■ = CALL-HOLD (EXTENSION).
 ● = ADDITIONAL CHANNEL FOR SAMPLING (FUTURE).
 DETECTORS SHALL BE RACK-MOUNTED 2-CHANNEL

NOTE: (1) DETECTOR TIMING FEATURES MAY BE ACCOMPLISHED THROUGH INTERNAL LOGIC OF THE CONTROLLER UNIT.
 (2) 1-S-8 DETECTOR LOOP IS PREFORMED.

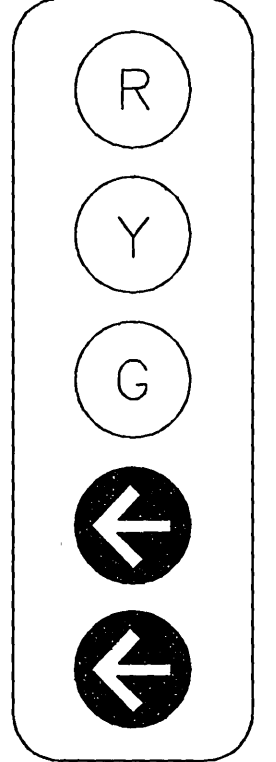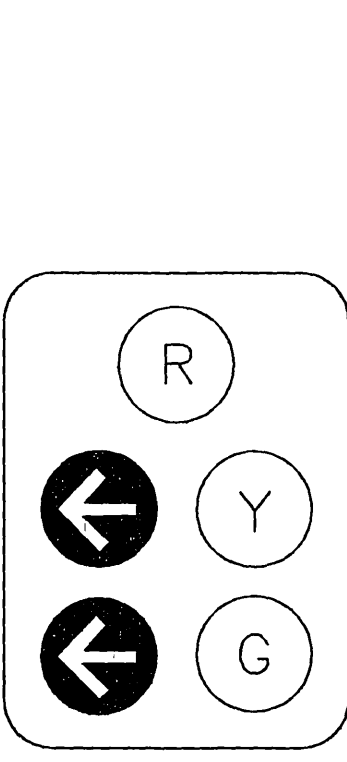

Underground Service Alert
 Call: TOLL FREE
 1-800-422-4133
 TWO WORKING DAYS BEFORE YOU DIG

CITY OF RIVERSIDE, CALIFORNIA DEPARTMENT OF PUBLIC WORKS				TRAFFIC SIGNAL PLAN HOLE AVENUE AND COUNTY CIRCLE DRIVE		ACCT. NO. X-338
DESIGNED BY	DRAWN BY	CHECKED BY	APPROVED BY	DATE	DIRECTOR OF PUBLIC WORKS	SHEET 1 OF 1
AS-BUILT PER SIGNALIZATION			DATE	DATE	FILE NO.	