

CONDUCTOR		SCHEDULE							
CONTROL FUNCTION	CONDUCTORS	RUNS							
		1	2	3	4	5	6	7	8
VEHICLE HEADS	#14 T.W.								
PHASE 1			3	3	3				
PHASE 2			3	3	3	3	3	3	3
PHASE 4				3	3	3	3	3	3
PHASE 5		3	3	3	3	3	3	3	3
PHASE 6			3	3					
PHASE 8			3	3					
PED HEADS									
PHASE 2			2	2	2	2	2	2	2
PHASE 4			4	2	2				
PHASE 6		2	2	4	2				
PHASE 8			2	4	2	2	2	2	2
PED PUSH BUTTON									
PHASE 2			2	2	2	2	1		
PHASE 4			2	2	1				
PHASE 6		1	1	2					
PHASE 8		1	1	2	1	1	1	1	1
SPARES		3	3	6	3	3	3	3	3
12V COMMON		1	1	2	1	1	1	1	1
DETECTORS	#12/2 P.E.		2	2					
PHASE 1			2	2					
PHASE 2				2	2				
PHASE 4				2	2				
PHASE 5				2	2				
PHASE 6		2	2						
PHASE 8			2	2					
I.S.N.S.	#12 T.W.	2	2	2	2	2	2	2	2
120V COMMON	#10 T.W.	1	1	2	1	1	1	1	1
LUMINAIRES	#8 T.H.W.	2	2	2	2	2	2	2	2
SIGNAL SERVICE	#6 T.H.W.	2	2						
INTERCONNECT	#20/2 P.E.	1	1	2	1	1			
TOTAL	#14 T.W.	10	16	51	32	26	22	16	13
	#12 T.W.	2	2	2	2	2	2	2	2
	#10 T.W.	1	1	2	1	1	1	1	1
	#8 T.H.W.	2	2	2	2	2	2	2	2
	#6 T.H.W.	2	2						
	#12/2 P.E.	4	4	12	6	6	2	2	2
	#20/2 P.E.	1	1	2	1	1			
#14 EQUIV.		26.5	39.5	108	61.5	52.5	36.5	30.5	21.5
CONDUIT SIZE		2"	2"	1 1/2"	3"	3"	1 1/2"	1 1/2"	2"

DETECTOR SCHEDULE			
CHANNELS	LOOP DESIGNATION	NUMBER OF LOOPS	FEATURES
1	1-E-1	1	● ■
2	2-E-1	3	
1	1-W-5	1	● ■
2	2-W-5	3	
1	1-W-2	2	● ■
2	2-W-2	4	
1	1-E-6	2	● ■
2	2-E-6	4	
1	1-N-4	3	
2	2-N-4	3	
1	1-S-8	3	
2	2-S-8	3	



● Sampling (future)
 ■ Call-hold (Extension)

NOTES
 1. Detectors are rack-mounted 2-channel.
 2. Detector loops designated for sampling also perform normal operation.
 3. Detector features are accomplished through internal logic.

POLE		SCHEDULE							
No.	TYPE	STANDARD		LUM. HPSV	I.S.N.S. LEGEND	SIGNAL HEAD	SIGNAL MOUNTING VEHICLE	PPB	REMARKS
		HGT.	SIG. M.						
(A)	24-4-80	30'	35'	12'	250w	HILLSIDE AVE 8260	1W3C	MAS	
							1W3C	MAS	
							1W3C	SV-I-T	SP-I-T
(B)	1A	7'						TP-I-T	2
(C)	19-2-80	30'	25'	12'	200w	CENTRAL AVE 8260	1W3C	MAS	
							1W3C	SV-I-T	SP-I-T
(D)	1A	10'					1W3C	TV-I-T	SP-I-T
(E)	26-4-80	30'	40'	12'	250w	HILLSIDE AVE 8260	1W3C	MAS	
							1W3C	MAS	
							1W3C	SV-I-T	SP-I-T
(F)	Type 15	30'		12'	200w				SP-I-T
(G)	18-2-80	17'	25'			CENTRAL AVE 8260	1W3C	MAS	
							1W3C	SV-I-T	SP-I-T
(H)	1A	10'					1W3C	TP-1	SP-I-T

NOTE:
 1. All vehicular heads have 12" lenses.
 2. Left-turn heads are all arrows.
 3. Luminaires are High Pressure Sodium Vapor.
 4. All 1A standards are aluminum.

RISER DETAIL
 PP-17736J

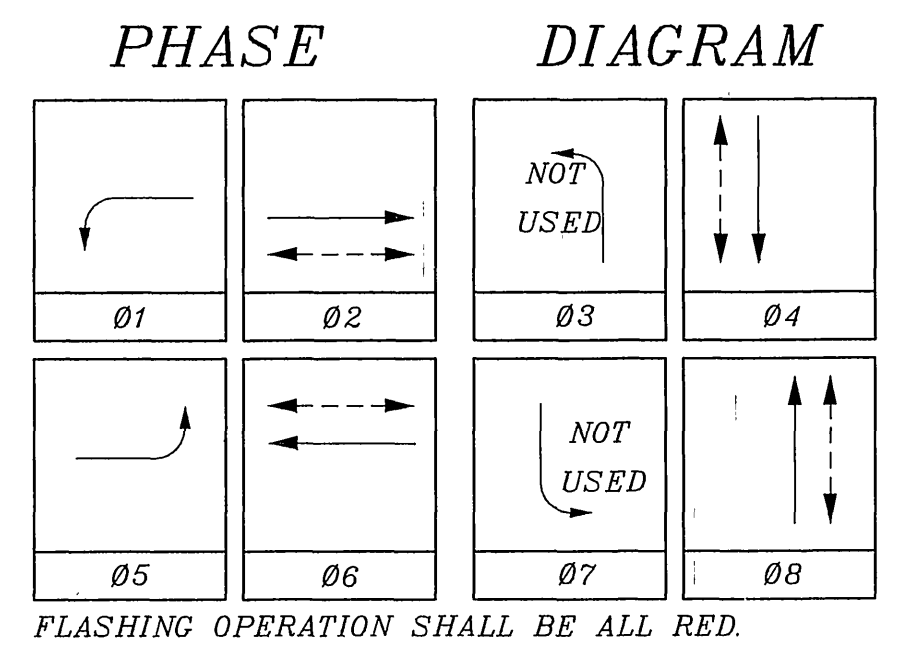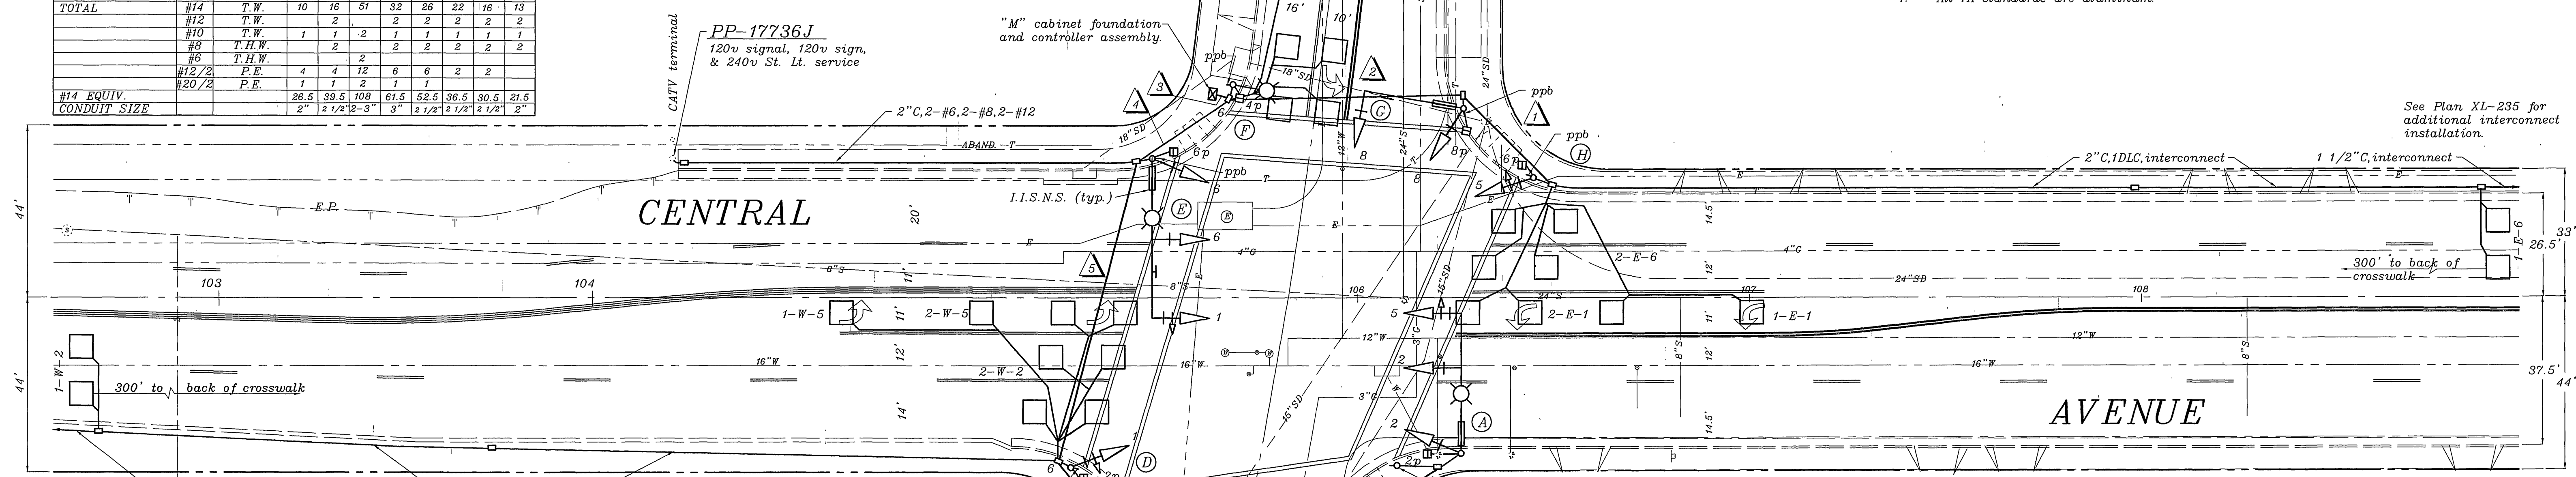

See Plan XL-235 for additional interconnect installation.

See Plan XL-235 for additional interconnect installation.

CITY OF RIVERSIDE, CALIFORNIA DEPARTMENT OF PUBLIC WORKS				TRAFFIC SIGNALS		ACCT. NO.
APPROVED BY _____ BY DATE _____				CENTRAL AVENUE @ HILLSIDE AVENUE		X-346
AS-BUILT PER SIGNALIZATION <i>MAC 1/4/82</i>				TRAFFIC DIVISION		SHEET 1 OF 1
MARK	REVISIONS	APPR.	DATE	DATE _____		FILE NO.
DESIGNED BY _____	DRAWN BY _____	CHECKED BY _____	PUBLIC UTILITIES	HORIZ. SCALE: 1" = 20'		VERT. SCALE: 1" = _____