



CONDUCTOR		SCHEDULE											
CONTROL FUNCTION	CONDUCTORS	RUNS											
		1	2	3	4	5	6	7	8	9	10	11	12
VEHICLE HEADS	#14 T.W.	-	-	-	-	-	-	-	-	-	-	-	-
PHASE 1		3	3	6	3	3	3	3	3	3	3	3	3
PHASE 2 + OL2				5	5								
PHASE 3				6	6	6	6	6	6	6	6	6	6
PHASE 4 + OL3				5									
PHASE 5				6	6	3							
PHASE 6 + OL4				5	5	5	5	5	5	5	5	5	5
PHASE 7				3	6								
PHASE 8 + OL1				5	5	5	5	5	5	5	5	5	5
PED. HEADS													
PHASE 2		2	2	4	2								
PHASE 4		2	4	2	2	2	2	2	2	2	2	2	2
PHASE 6		4	4	4	2	2	2	2	2	2	2	2	2
PHASE 8		4	2	2	2								
PED. PUSH BUTTON													
PHASE 2		1	2										
PHASE 4		1	1	2	1	1	1	1	1	1	1	1	1
PHASE 6		2	2	2	2	2	2	2	2	2	2	2	2
PHASE 8		2	2	1									
SPARES		7	14	56	35	29	21	14	7				
12V COMMON		1	2	8	5	4	3	2	1				
DETECTORS	#16/2 P.E.												
PHASE 1				1	1	1							
PHASE 2		3	3	3									
PHASE 3		1											
PHASE 4		3	3	3	3	3	3	3	3	3	3	3	3
PHASE 5		1	1	1									
PHASE 6		3	3	3									
PHASE 7		1	1	1	1	1	1	1	1	1	1	1	1
PHASE 8		3											
I.I.S.N.S.	#12 T.W.	2	2	2	2	2	2	2	2	2	2	2	2
120V COMMON	#12 T.W.	1	2	8	5	4	3	2	1				
LUMINAIRES	#8 T.H.W.	2	2	2	2	2	2	2	2	2	2	2	2
SIGNAL SERVICE	#6 T.H.W.	2											
INTERCONNECT	#19/2 P.E.												
CONDUIT SIZE		2"	3"	2-3/4"	3.5"	3"	3"	3"	2"	1.5"	1.5"		

POLE		SCHEDULE									
No.	TYPE	STANDARD			LUM. HPSV	I.S.N.S. LEGEND	SIGNAL HEAD	SIGNAL MOUNTING VEHICLE	PED	PPB PHASE	REMARKS
		HGT	SIG.	M.A.							
(A)	26A-4-80	35'	45'	12'	250w	Chicago 4V 4200	1W3C	MAS			
							1W3C	MAS			
							1W5C	SV-1-T	SP-1-T	6	
(B)	1A	10'					1W3C	TV-1-T	SP-1-T	8	
(C)	26A-4-80	35'	45'	12'	250w	M.L.K. BLD 1600	1W3C	MAS			
							1W3C	MAS			
							1W5C	SV-1-T	SP-1-T	8	
(D)	TYPE 21	35'		12'	250w		1W3C	SV-1-T	SP-1-T	2	
(E)	29A-5-80	35'	50'	12'	250w	Chicago 4V 4200	1W3C	MAS			
							1W3C	MAS			
							1W5C	SV-1-T	SP-1-T	2	
(F)	1A	10'					1W3C	TV-1-T	SP-1-T	4	
(G)	26A-4-80	35'	40'	12'	250w	M.L.K. BLD 1700	1W3C	MAS			
							1W3C	MAS			
							1W5C	SV-1-T	SP-1-T	4	
(H)	TYPE 21	35'		12'	250w		1W3C	TV-1-T	SP-1-T	6	

NOTE: 1. All left-turn indications to have all arrows.  
 2. All vehicular heads to have 12" lenses.  
 3. Luminaires to be High Pressure Sodium Vapor.  
 4. All 1A poles shall be Aluminum.

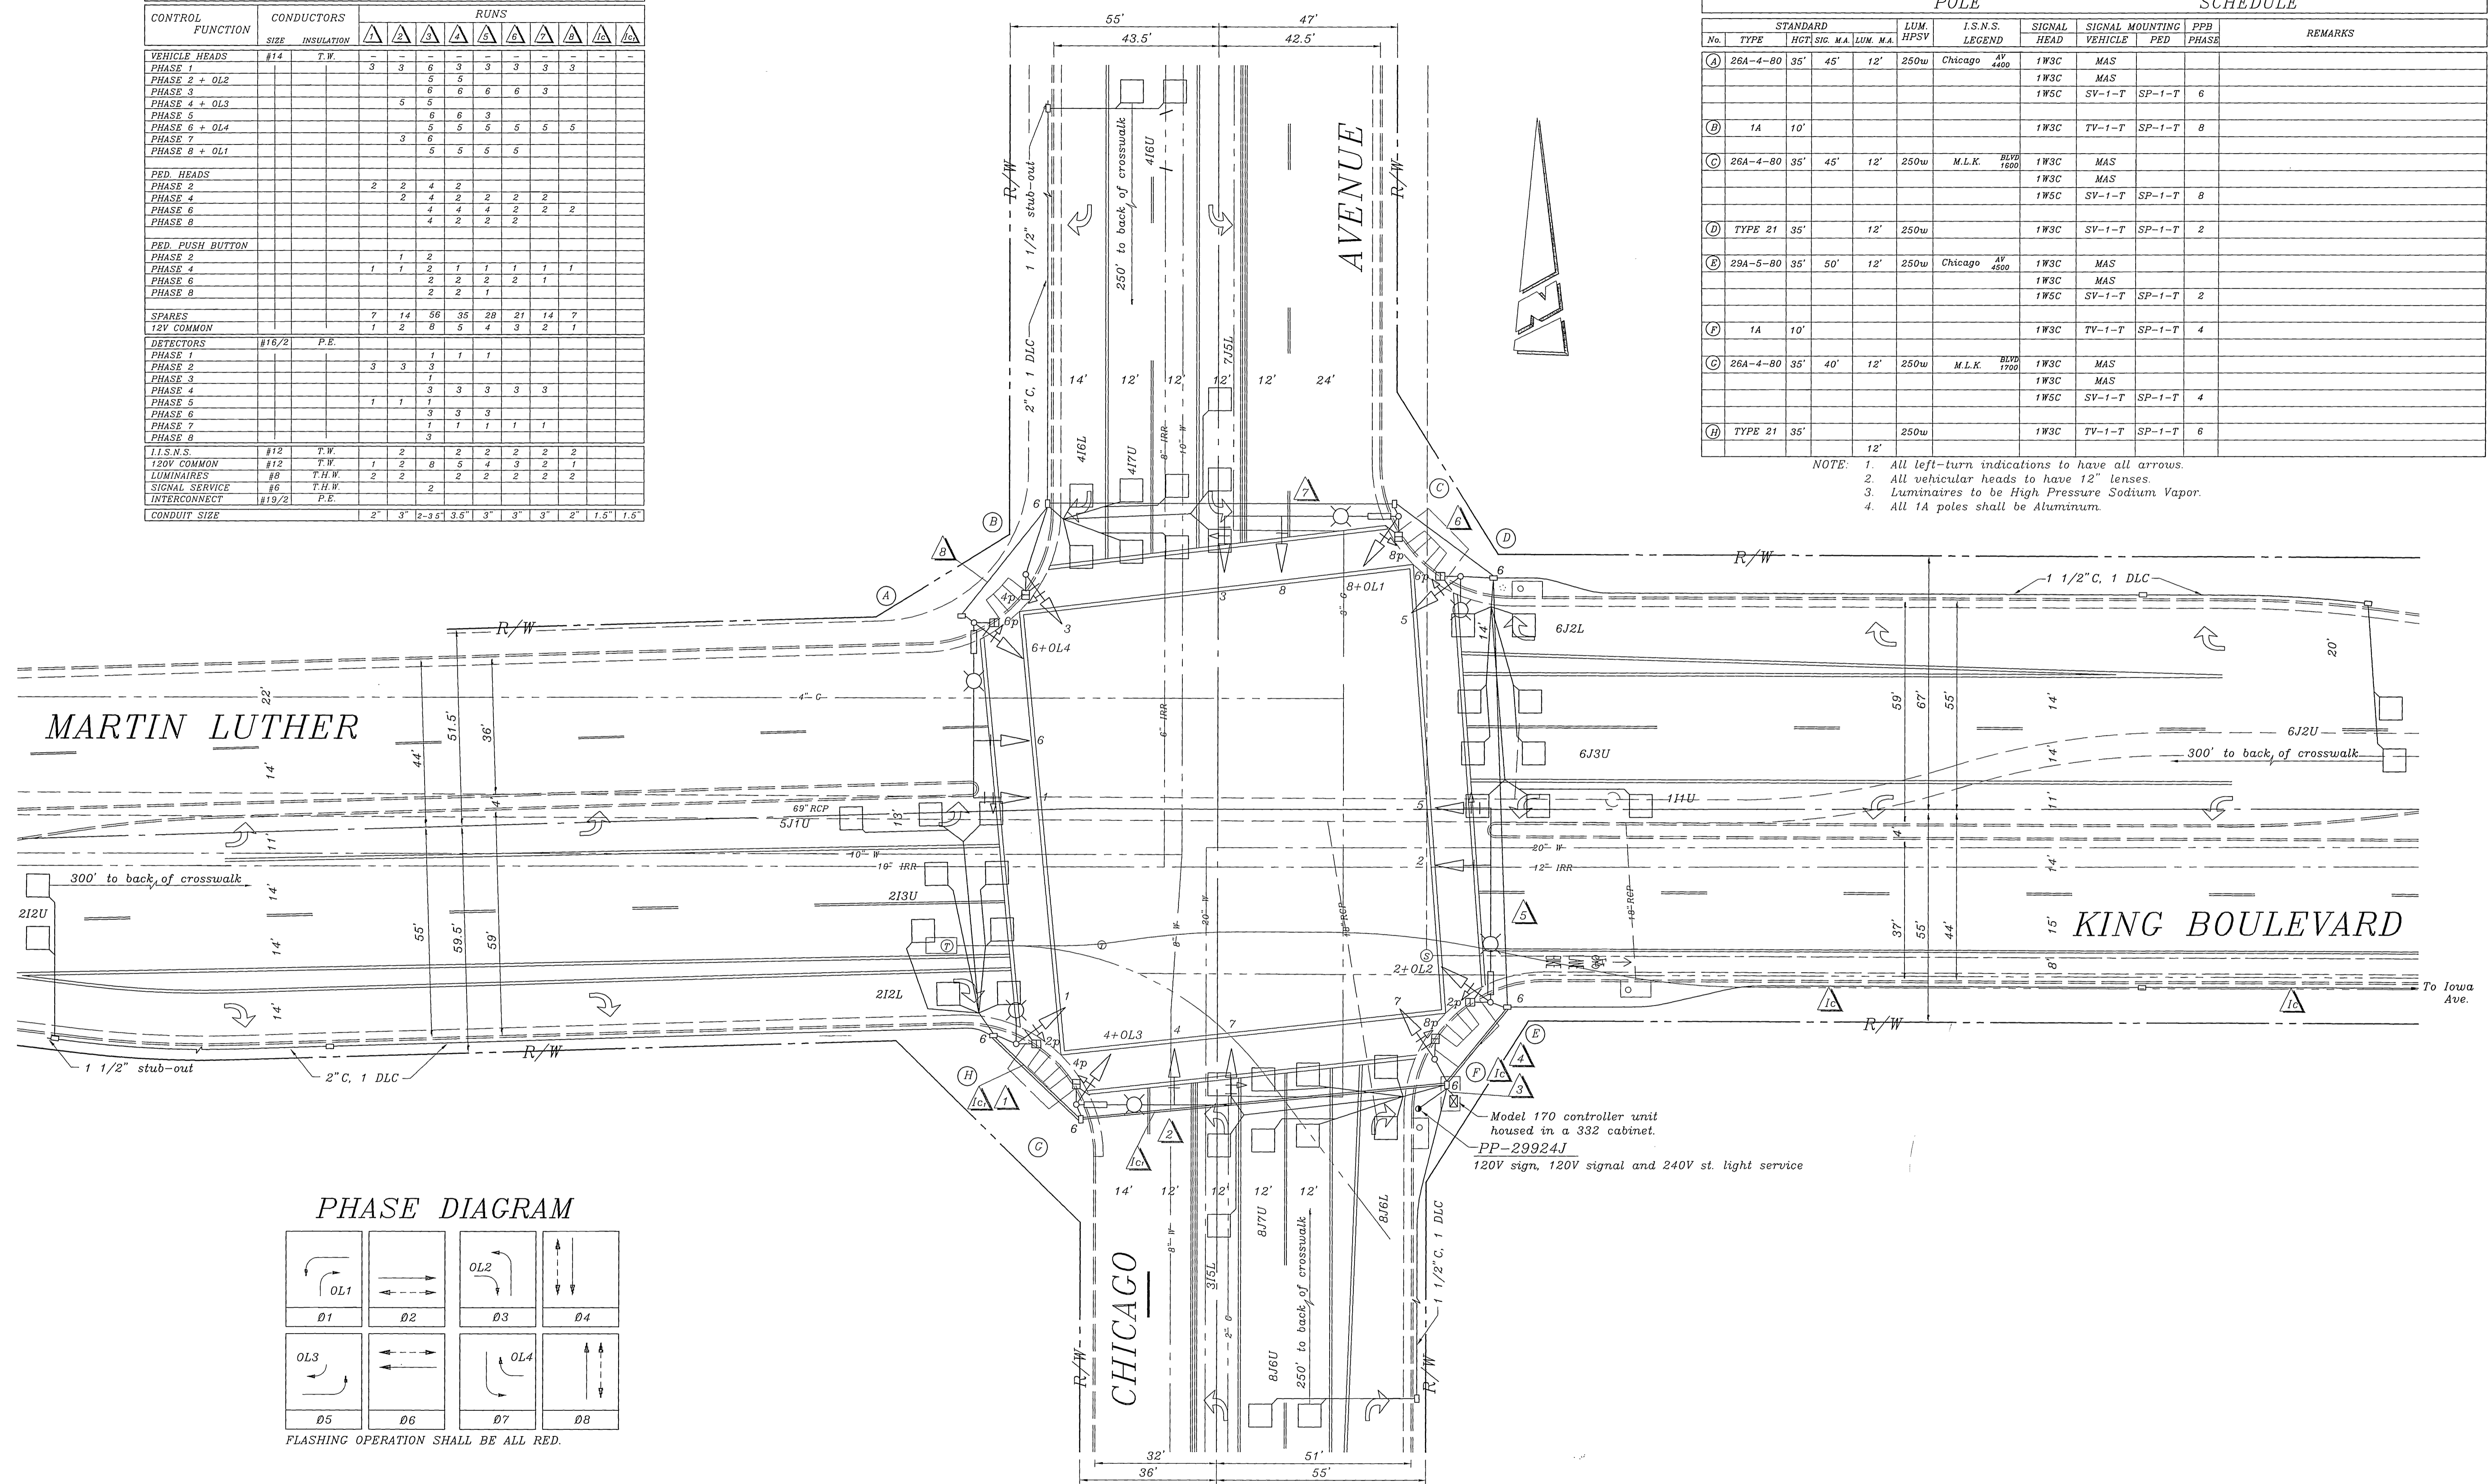


PHASE DIAGRAM

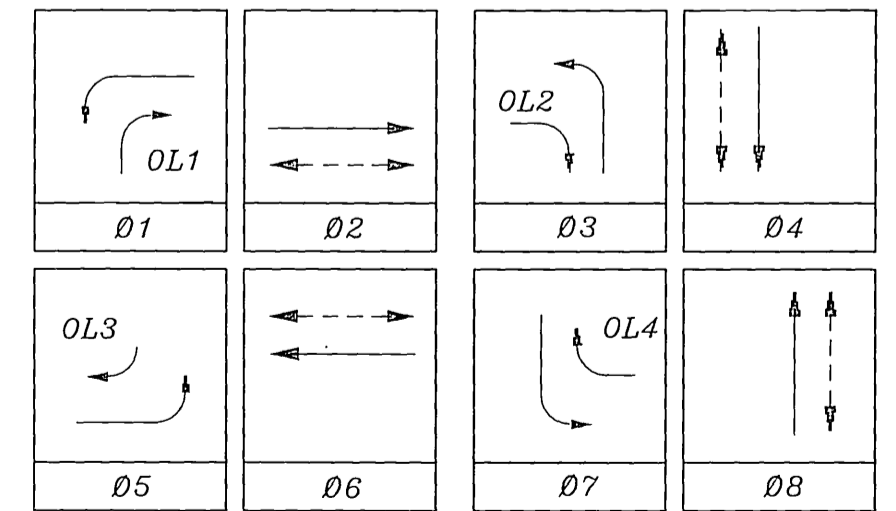

FLASHING OPERATION SHALL BE ALL RED.



AS-BUILT PER R-3057 MAC 11/00 AS-BUILT PER R-2630 MAC 11/00 AS-BUILT (UTL & EQUIP SCHED) MHL 12/81 AS-BUILT (LOOP DETECTORS) JMW 1/67 AS-BUILT PER SIGNALIZATION RBD 8/65		CITY OF RIVERSIDE, CALIFORNIA DEPARTMENT OF PUBLIC WORKS		TRAFFIC SIGNAL <b>CHICAGO AVENUE          AND MARTIN LUTHER          KING BOULEVARD</b>		ACCT. NO. <b>X-414</b>
APPROVED BY ENGINEERING MANAGER PRINCIPAL ENGINEER P.W. INSPECTION TRAFFIC DIVISION PUBLIC UTILITIES	BY        	DATE        	APPROVED BY DIRECTOR OF PUBLIC WORKS	DATE        	SCALE: 1" = 20'	SHEET 1 OF 1 FILE NAME: X414AS.DWG

AWG	CIRCUIT	CONDUCTOR SCHEDULE											
		1	2	3	4	5	6	7	8	9	10	11	12
#1		3	3	3	3	3	(N)3	(N)3	3	(N)3	3	(N)3	
#2 + OL1		-	-	-	-	5	-	-	5	-	-	-	
#3		-	3	6	6	6	-	-	6	-	-	-	
#4 + OL2		-	-	-	-	3	6	-	6	-	-	-	
#5		-	-	-	-	5	5	-	5	-	-	-	
#6 + OL4		5	5	5	5	-	-	-	5	-	-	-	
#7		-	-	-	-	(N)3	(N)3	3	(N)3	3	(N)3	3	
#8 + OL1		-	-	-	-	5	5	-	5	-	-	-	
#14		-	-	-	-	(N)2	(N)2	2	(N)2	2	(N)2	2	
#4P		-	2	2	2	2	-	-	2	-	-	-	
#6P		-	2	2	2	2	-	-	2	-	-	-	
#8P		-	2	2	2	2	-	-	2	-	-	-	
#2 PPB		-	-	-	-	(N)1	(N)1	1	(N)1	1	(N)1	1	
#4 PPB		-	1	1	1	1	-	-	1	-	-	-	
#6 PPB		-	1	2	2	2	-	-	2	-	-	-	
#8 PPB		-	-	-	-	1	2	-	2	-	-	-	
PPB COMMON		1	2	3	4	5	(N)1	(N)2	5	(N)3	3	(N)3	
SPARES		3	3	3	3	3	(N)3	(N)3	3	(N)3	3	(N)3	
TOTAL		15	22	34	41	51	10	22	82	-	-	-	
L.I.S.N.S.		2	2	2	2	2	-	-	2	-	-	-	
#12 SIGNAL COMMON		1	2	3	4	5	(N)1	(N)2	6	(N)2	-	-	
TOTAL		3	4	5	6	7	1	4	8	-	-	-	
#8 LUMINAIRE		2	2	2	2	2	(N)2	(N)2	-	-	-	-	
#1		-	-	-	-	1	-	-	1	-	-	-	
#2		-	-	-	-	(N)3	(N)3	(N)3	-	-	-	-	
#3		-	-	-	-	-	-	-	1	-	-	-	
#4		-	3	3	3	3	-	-	3	-	-	-	
#5		-	-	-	-	(N)1	(N)1	(N)1	-	-	-	-	
#6		-	-	-	-	3	3	3	-	-	-	-	
#7		-	1	1	1	1	-	-	1	-	-	-	
#8		-	-	-	-	-	-	-	3	-	-	-	
TOTAL		0	4	4	8	8	4	4	16	-	-	-	
#6 SIGNAL SERVICE		-	-	-	-	-	-	-	2	-	-	-	
6 PAIR #19 SIC		-	-	-	-	-	-	-	1	(N)1	-	-	
CONDUIT SIZE		2"	3"	3"	3"	3.5"	(N)2	(N)3	2-3.5"	-	-	-	
PERCENT FILL		15%	13%	17%	23%	20%	19%	13%	18%	-	-	-	

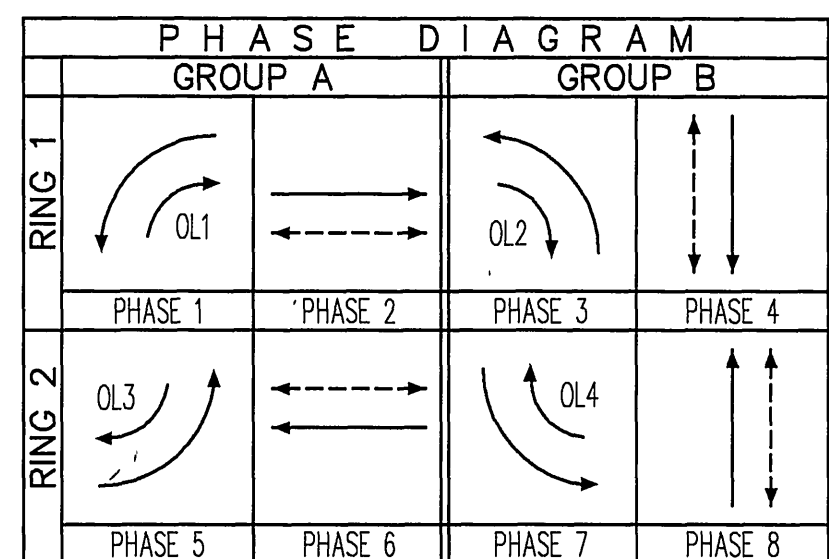

STANDARD	TYPE	HT.	SIG.	ARMS	LUM.	H.P.S.V.	LUMINAIRE	PED. PUSH BT.	QUAD	SIGNAL MOUNTING		L.I.S.N.S.	PLACEMENT	
										VEHICLE	PED.		A	B
26A-4-80	1-A	35' (10.7m)	45' (13.7m)	12' (3.7m)	250 W	B	4	E	MAS, MAS, SV-1-T	SP-1-T	CHICAGO #460	15'	3.0'	
26A-4-80	2	35' (10.7m)	45' (13.7m)	12' (3.7m)	250 W	B	6	S	MAS, MAS, SV-1-T	SP-1-T	M.L.K. #100	16'	3.0'	
29A-5-80	1-A	35' (10.7m)	50' (15.2m)	12' (3.7m)	250 W	B	8	W	MAS, MAS, SV-1-T	SP-1-T	CHICAGO #460	-	-	
(N) 29A-5-129	(R) 21	35' (10.7m)	(N)50' (15.2m)	(N)12' (3.7m)	(R) 250 W	(R) B	2	N	(R)MAS, (R)MAS, (R)SV-1-T	(R)SP-1-T	(R) M.L.K. #100	-	-	

ALL EQUIPMENT IS EXISTING UNLESS OTHERWISE INDICATED.  
 (N) = NEW  
 (R) = REUSE (SEE GENERAL NOTE No. 10)

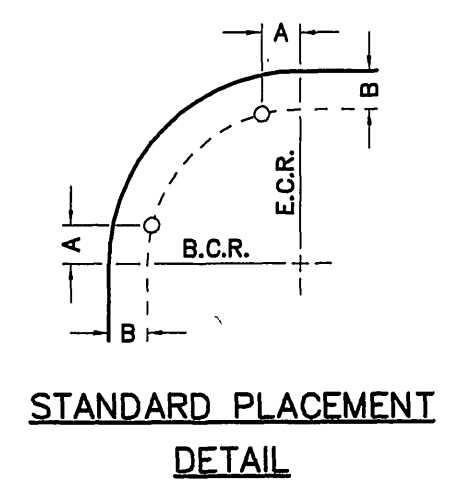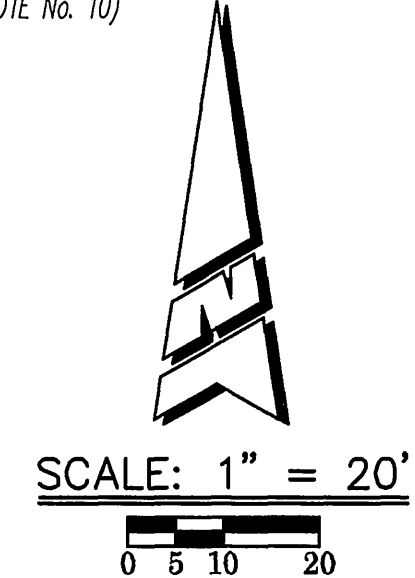


MARTIN LUTHERN KING

AVENUE

BOULEVARD

CHICAGO

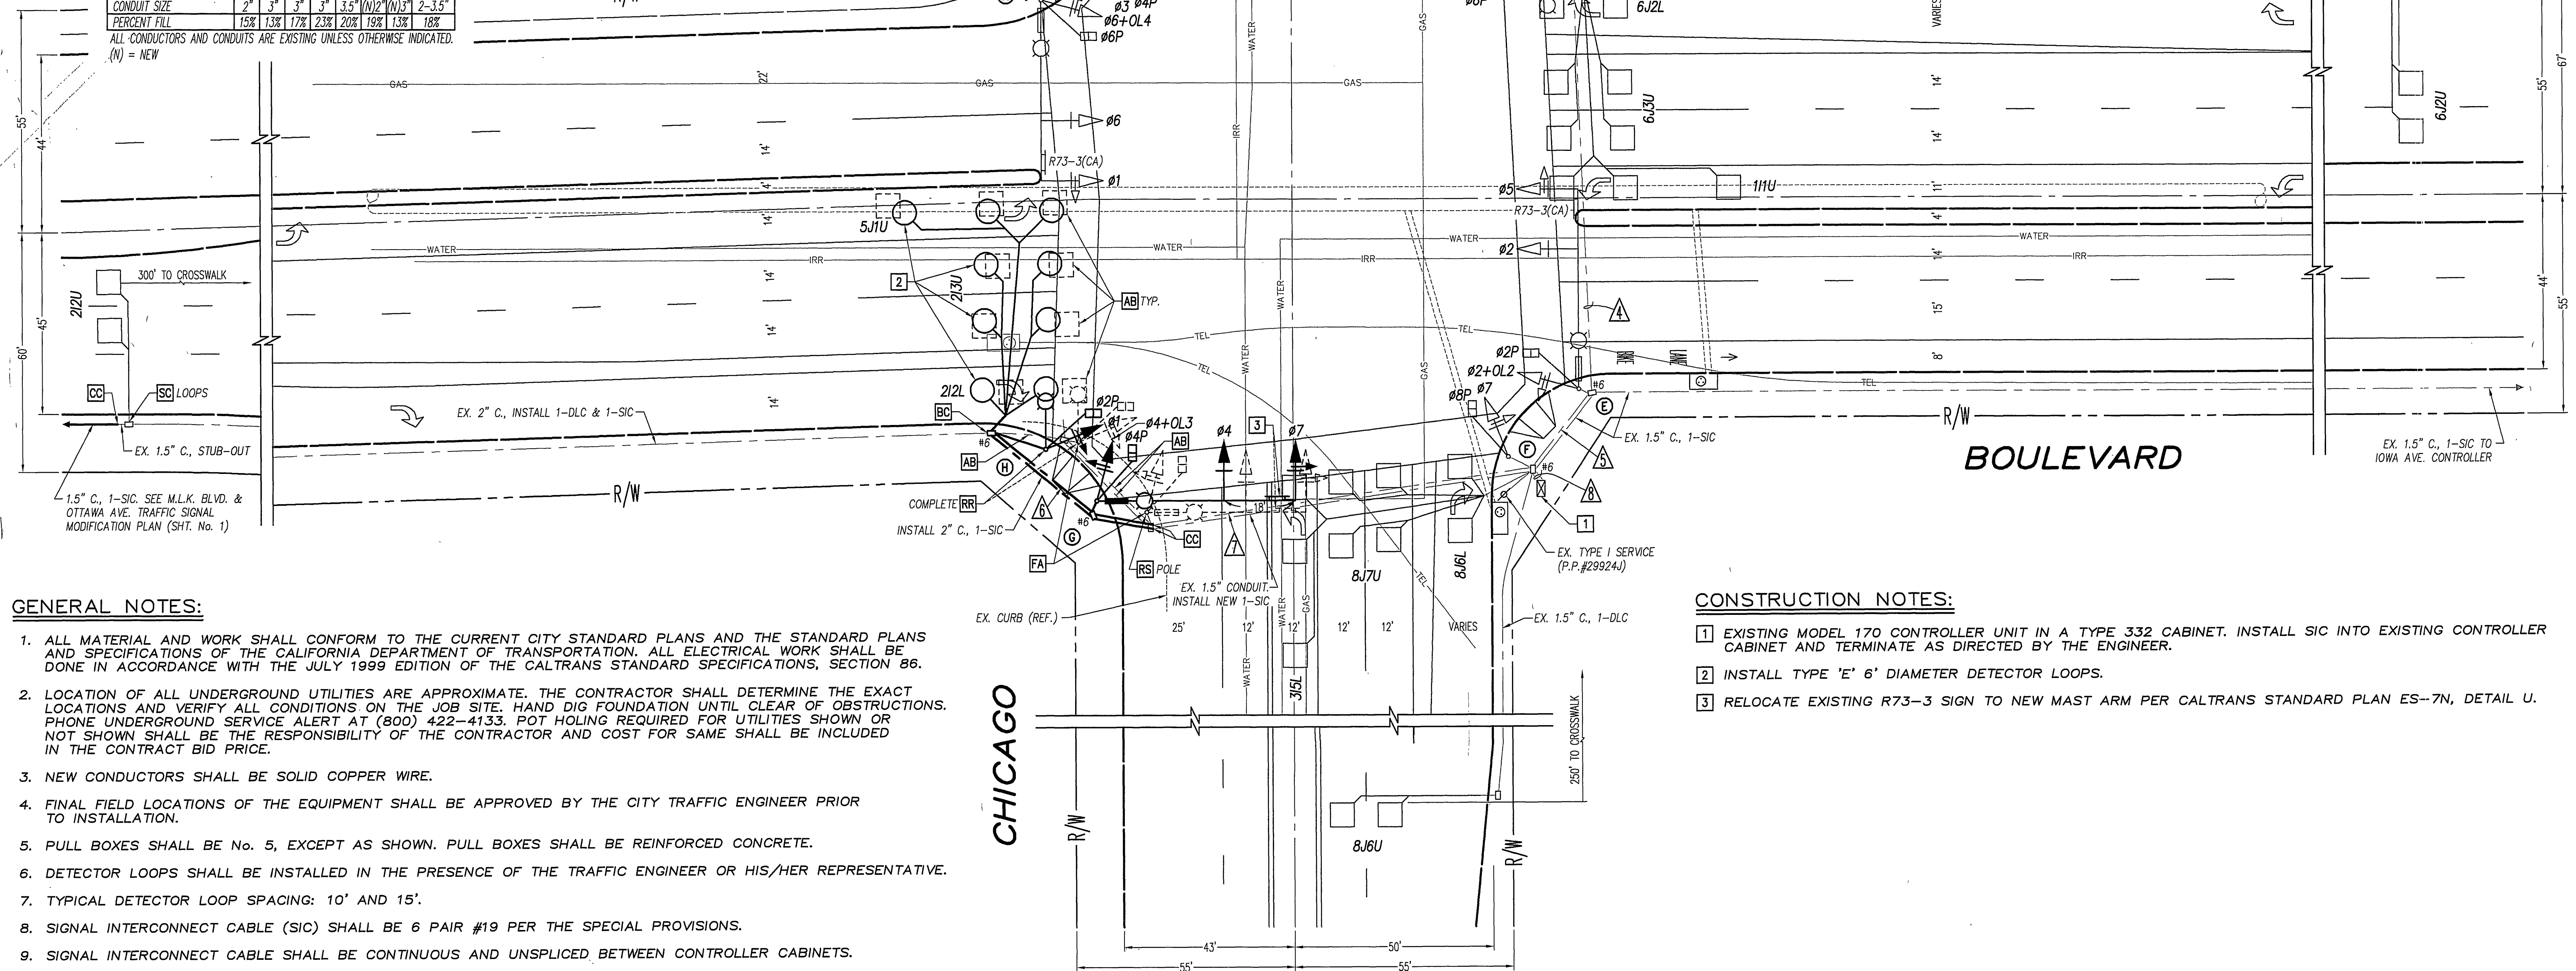

**GENERAL NOTES:**


1. ALL MATERIAL AND WORK SHALL CONFORM TO THE CURRENT CITY STANDARD PLANS AND THE STANDARD PLANS AND SPECIFICATIONS OF THE CALIFORNIA DEPARTMENT OF TRANSPORTATION. ALL ELECTRICAL WORK SHALL BE DONE IN ACCORDANCE WITH THE JULY 1999 EDITION OF THE CALTRANS STANDARD SPECIFICATIONS, SECTION 86.
2. LOCATION OF ALL UNDERGROUND UTILITIES ARE APPROXIMATE. THE CONTRACTOR SHALL DETERMINE THE EXACT LOCATIONS AND VERIFY ALL CONDITIONS ON THE JOB SITE. HAND DIG FOUNDATION UNTIL CLEAR OF OBSTRUCTIONS. PHONE UNDERGROUND SERVICE ALERT AT (800) 422-4133. POT HOLING REQUIRED FOR UTILITIES SHOWN OR NOT SHOWN SHALL BE THE RESPONSIBILITY OF THE CONTRACTOR AND COST FOR SAME SHALL BE INCLUDED IN THE CONTRACT BID PRICE.
3. NEW CONDUCTORS SHALL BE SOLID COPPER WIRE.
4. FINAL FIELD LOCATIONS OF THE EQUIPMENT SHALL BE APPROVED BY THE CITY TRAFFIC ENGINEER PRIOR TO INSTALLATION.
5. PULL BOXES SHALL BE No. 5, EXCEPT AS SHOWN. PULL BOXES SHALL BE REINFORCED CONCRETE.
6. DETECTOR LOOPS SHALL BE INSTALLED IN THE PRESENCE OF THE TRAFFIC ENGINEER OR HIS/HER REPRESENTATIVE.
7. TYPICAL DETECTOR LOOP SPACING: 10' AND 15'.
8. SIGNAL INTERCONNECT CABLE (SIC) SHALL BE 6 PAIR #19 PER THE SPECIAL PROVISIONS.
9. SIGNAL INTERCONNECT CABLE SHALL BE CONTINUOUS AND UNSPLICED BETWEEN CONTROLLER CABINETS.
10. CONTRACTOR SHALL PROVIDE NECESSARY SIGNAL FRAMEWORKS AND STREET NAME SIGN MOUNTING HARDWARE FOR RELOCATED EQUIPMENT.
11. SEE STREET IMPROVEMENT PLAN R-\_\_\_ FOR IMPROVEMENTS.

**CONSTRUCTION NOTES:**

1. EXISTING MODEL 170 CONTROLLER UNIT IN A TYPE 332 CABINET. INSTALL SIC INTO EXISTING CONTROLLER CABINET AND TERMINATE AS DIRECTED BY THE ENGINEER.
2. INSTALL TYPE 'E' 6" DIAMETER DETECTOR LOOPS.
3. RELOCATE EXISTING R73-3 SIGN TO NEW MAST ARM PER CALTRANS STANDARD PLAN ES-7N, DETAIL U.

<p><b>DIG ALERT</b></p> <p>DIAL TOLL FREE 1-800-422-4133</p> <p>AT LEAST TWO DAYS BEFORE YOU DIG</p> <p>UNDERGROUND SERVICE ALERT OF SOUTHERN CALIFORNIA</p>	<p>PLANS PREPARED BY:  <b>HARTZOG CRABILL, Inc.</b>          Consulting Traffic Engineers          275 Centennial Way, Suite 208          Tustin, California 92780          714.731.9455 fax: 714.731.9498          www.hartzog-crabill.com</p> <p>Gerald J. Stock R.C.E. No. C052822 Exp. 12-31-06 DATE 3/30/05</p>	<p><b>CITY OF RIVERSIDE</b> DEPARTMENT OF PUBLIC WORKS</p> <p>APPROVED BY: <i>[Signature]</i> DATE: 3/21/05          PRINCIPAL ENGINEER          TRAFFIC DIVISION</p> <p>APPROVED BY: <i>[Signature]</i> DATE: 4/1/05          CITY ENGINEER</p>	<p><b>TRAFFIC SIGNAL MODIFICATION PLAN</b></p> <p>Martin Luther King Boulevard and Chicago Avenue</p> <p>SCALE: 1" = 20'</p>	<p>ACCOUNT No. <b>X-414A</b></p> <p>Sheet 2 of 2</p>


PHASE DIAGRAM

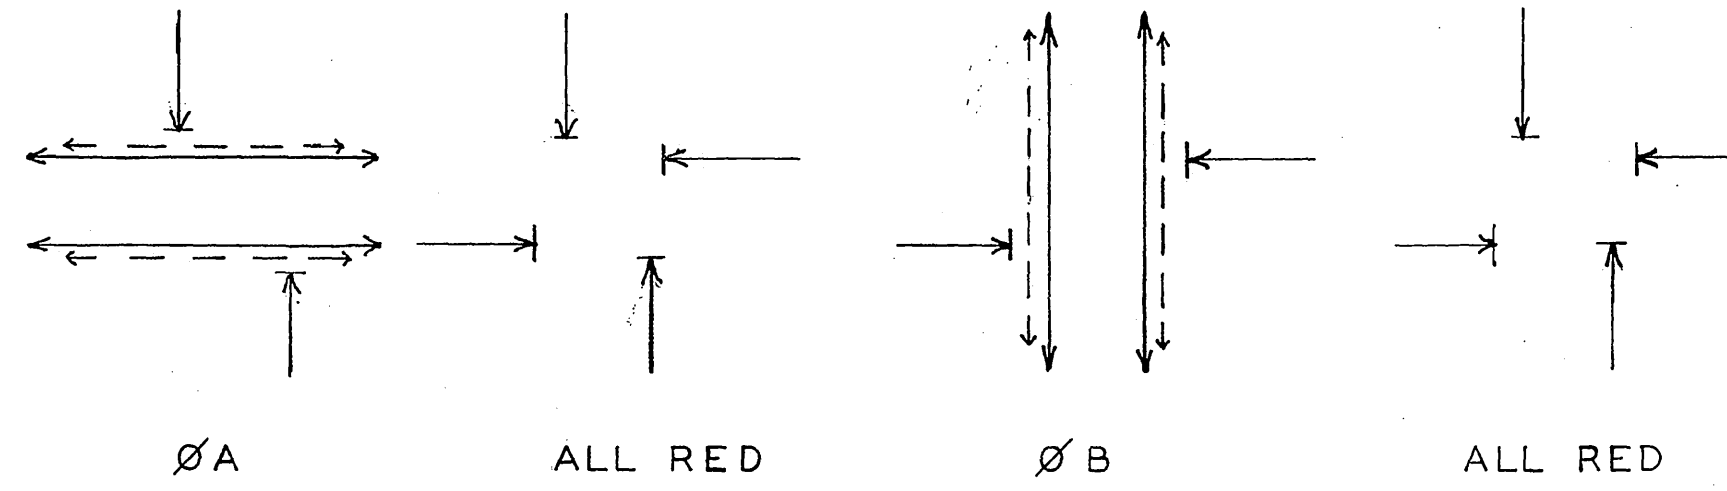


FLASHING INDICATIONS:  
Ø A YELLOW, Ø B RED.

LOCATION	STANDARD	VEHICLE HEADS			PEDESTRIAN HEADS		LUMINAIRE	MOUNTING	REMARKS
		HEAD	MOUNTING	BACK PLATE	HEAD	MOUNTING			
A	TYPE III Aluminum	1W3C	MAS	SV-1-T	1		400W		
B	TYPE III Aluminum	1W3C	MAS	SV-1-T	1		400W		
C	TYPE III Aluminum	1W3C	MAS	SV-1-T	1		400W		
D	TYPE III Aluminum	1W3C	MAS	SV-1-T	1		400W		

Note: All Luminaires are Mercury Vapor

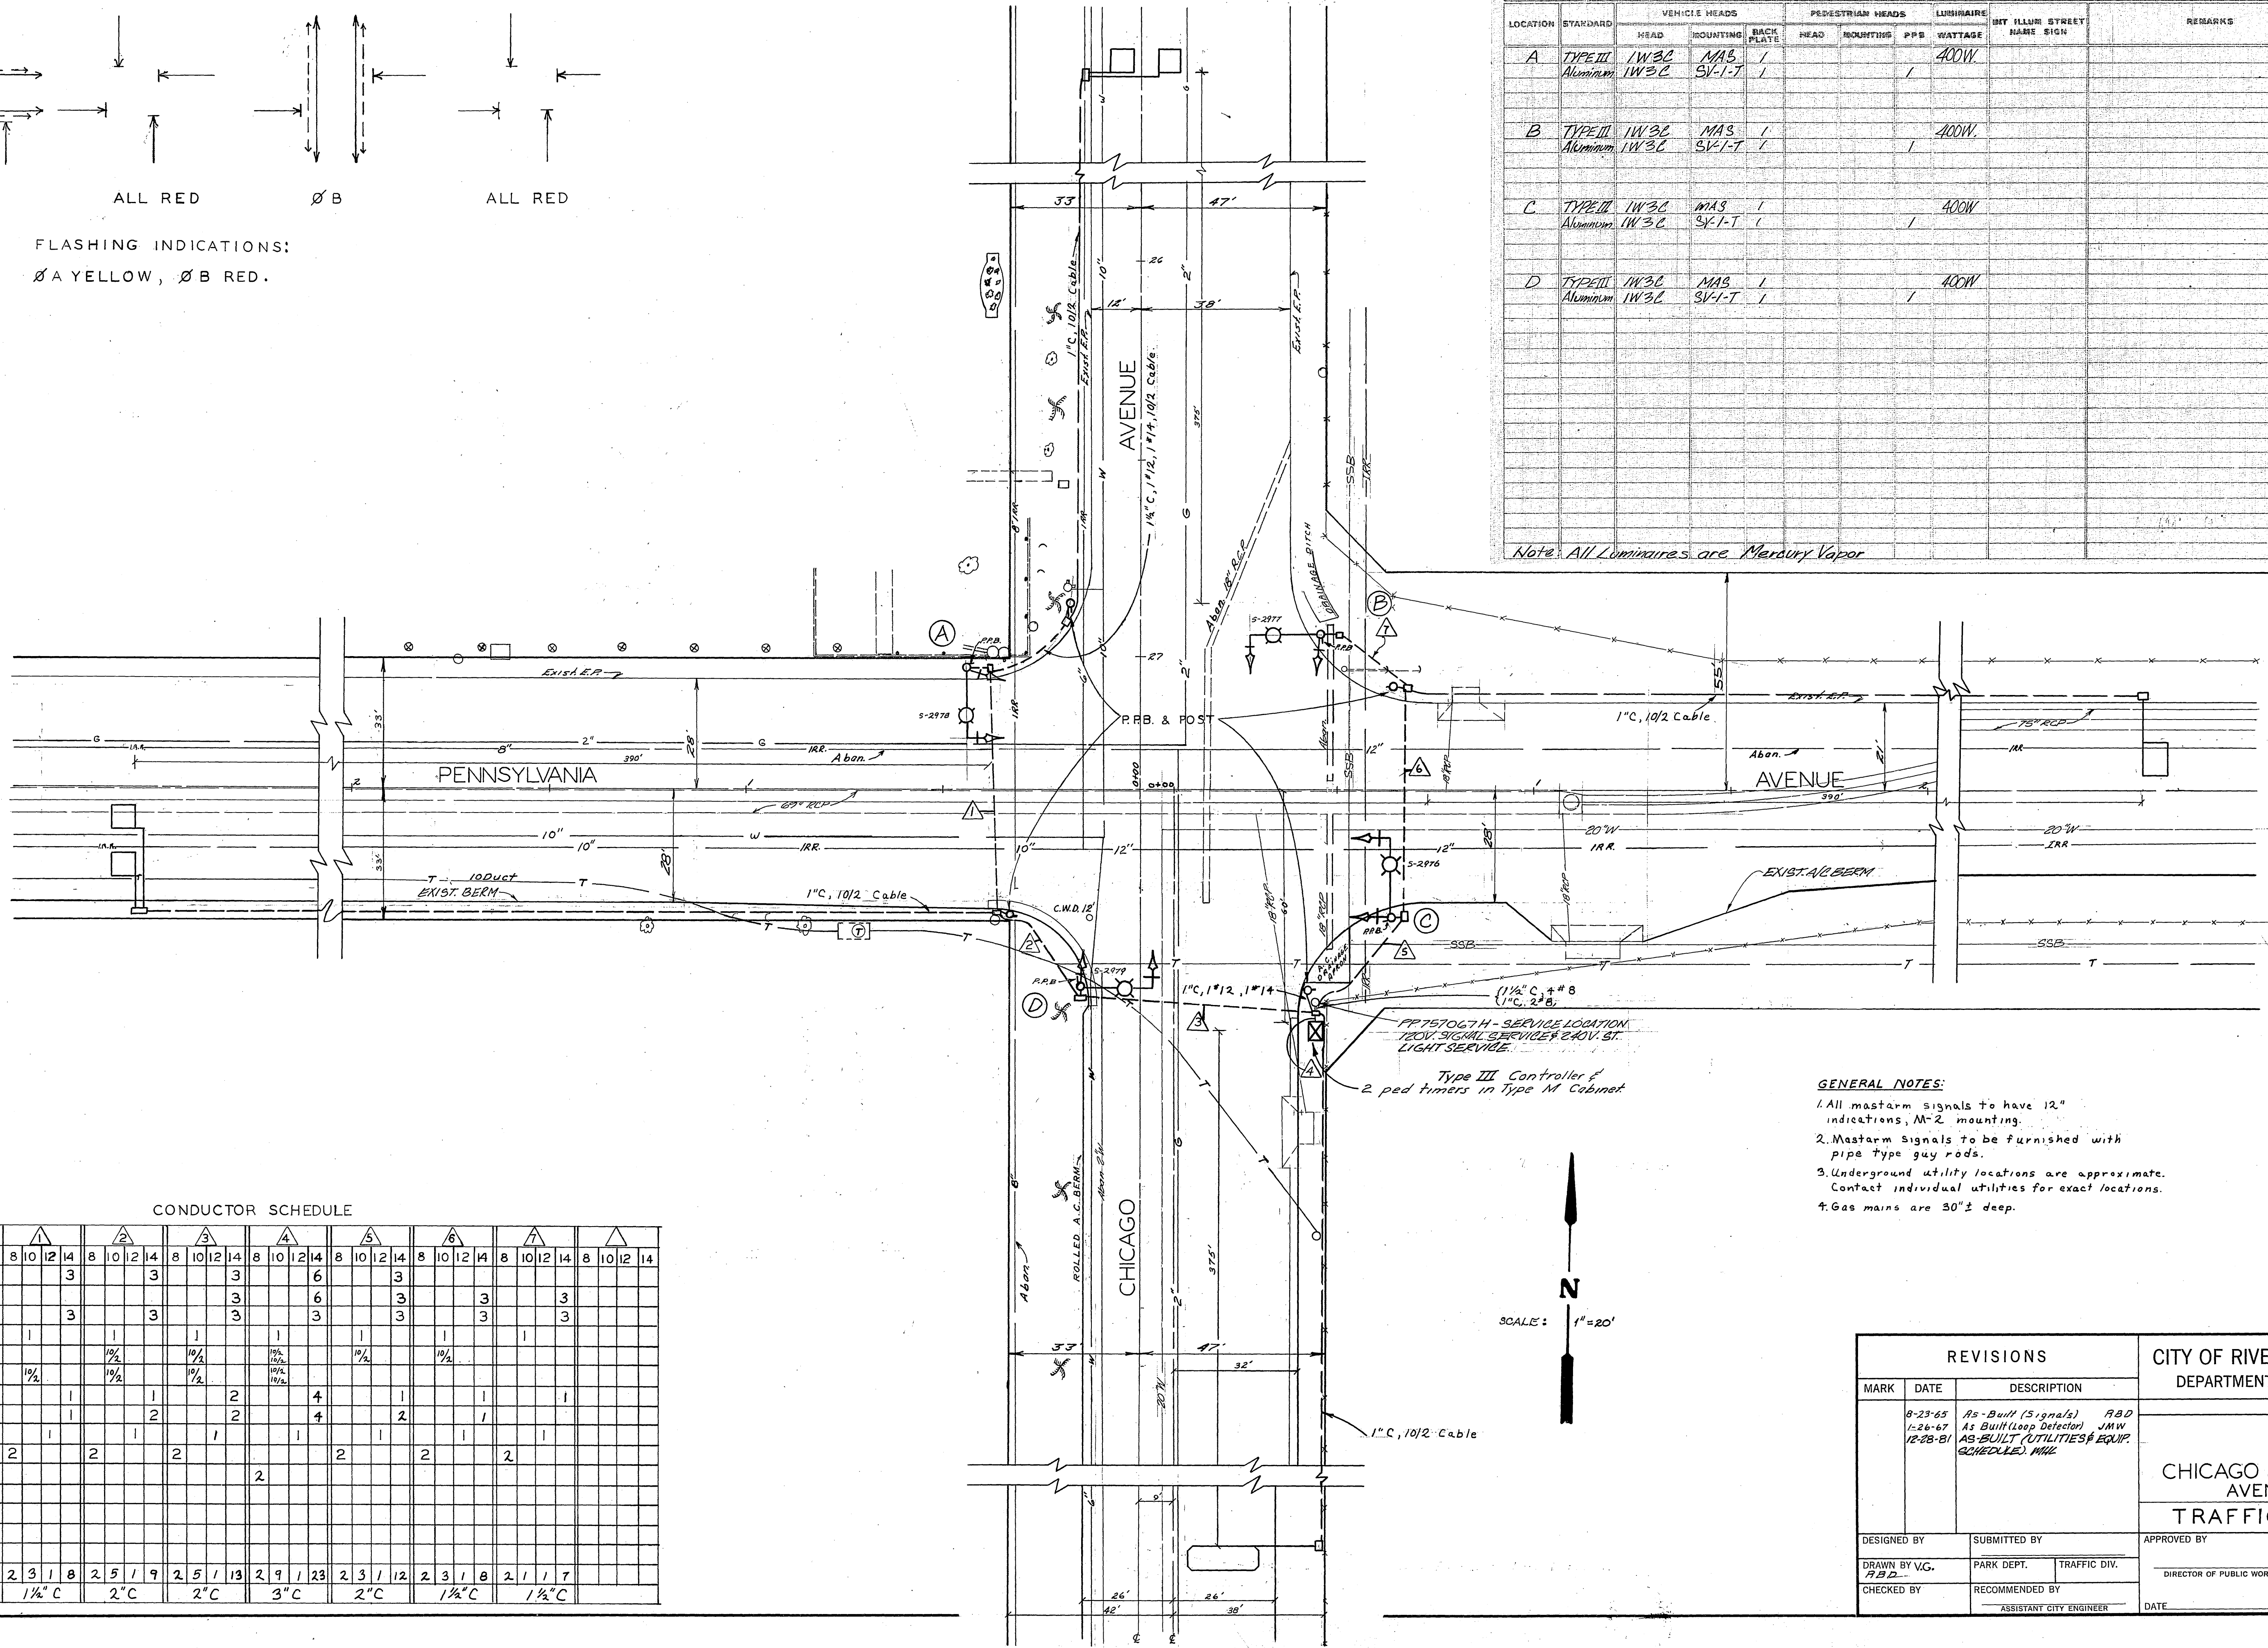

- GENERAL NOTES:**
- All mastarm signals to have 12" indications, M-2 mounting.
  - Mastarm signals to be furnished with pipe type guy rods.
  - Underground utility locations are approximate. Contact individual utilities for exact locations.
  - Gas mains are 30" ± deep.

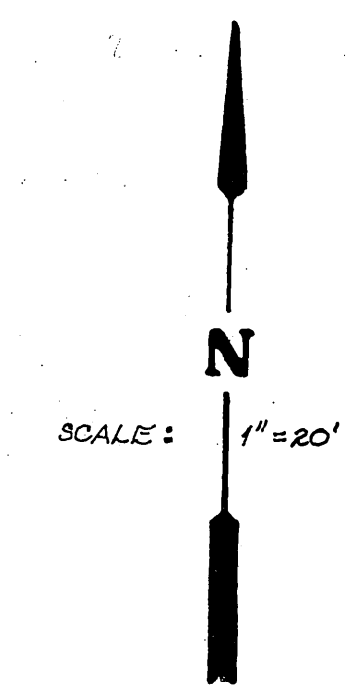

CONDUCTOR SCHEDULE

CONDUCTOR RUN	1		2		3		4		5		6		7			
CONDUCTORS	8	10	12	14	8	10	12	14	8	10	12	14	8	10	12	14
Ø A				3				3				6				3
Ø B								3				6				3
SPARES				3				3				3				3
120V. NEUTRAL	1				1				1				1			
Ø A DET.				1/2				1/2				1/2				1/2
Ø B DET.				1/2				1/2				1/2				1/2
Ø A P.R.B.			1				1				2				4	
Ø B P.R.B.			1				2				2				4	
12V. NEUTRAL																
LIGHTING	2				2				2				2			
SIGNAL SERVICE									2				2			
TOTAL CONDUCTORS	2	3	1	8	2	5	1	9	2	5	1	13	2	9	1	23
CONDUIT. SIZE	1 1/2" C		2" C		2" C		3" C		2" C		1 1/2" C		1 1/2" C			

REVISIONS		CITY OF RIVERSIDE, CALIFORNIA DEPARTMENT OF PUBLIC WORKS
MARK	DATE	
8-23-65	As-Built (Signals)	RBD
1-26-67	As-Built (Loop Detector)	JMW
12-28-81	AS-BUILT (UTILITIES & EQUIP. SCHEDULE)	MHC

DESIGNED BY	SUBMITTED BY	APPROVED BY	PROJ. NO.
DRAWN BY V.G. RBD	PARK DEPT. TRAFFIC DIV.	DIRECTOR OF PUBLIC WORKS	X-414
CHECKED BY	RECOMMENDED BY	DATE	SHEET OF