



CONDUCTOR		TABLE							
AWG	CIRCUIT	RUNS							
		1	2	3	4	6	7	8	
UF #14	ØA1	3	3	3	3	3	3	6	
	ØA2	3	3	3	3	—	—	3	
	ØA3	—	—	—	3	—	—	3	
	ØB	3	3	3	3	—	—	3	
	ØA3p	—	—	—	—	2	—	2	
	ØBp	—	2	2	2	—	—	2	
	ØA3PPB	—	—	—	—	1	—	2	
	ØBPPB	—	1	2	3	—	—	3	
	Spares	3	3	3	3	3	3	6	
	PPB Common	—	1	1	1	1	1	2	
TOTAL		12	16	17	21	10	6	32	
UF #10	Signal Common	1	1	1	1	1	1	2	
TOTAL		1	1	1	1	1	1	2	
UF #12	Illuminated Signs	2	2	2	—	—	—	—	
TOTAL		2	2	2	—	—	—	—	
PE LOOP DET. CABLE 2-#12	1A1	—	—	—	—	—	—	1	
	2B	—	—	—	—	—	—	1	
	3A3	—	—	—	—	2	2	2	
	4A2	—	2	2	2	—	—	2	
	5A1	—	—	1	1	—	—	1	
TOTAL		—	2	3	3	2	2	7	
UF/THW #8	Luminaires	2	2	2	2	—	—	2	
	Signal Service	2	2	2	2	—	—	2	
TOTAL		2	2	2	2	—	—	2	
CONDUIT SIZE		2"	2 1/2"	2 1/2"	2 1/2"	2"	2"	3 1/2"	

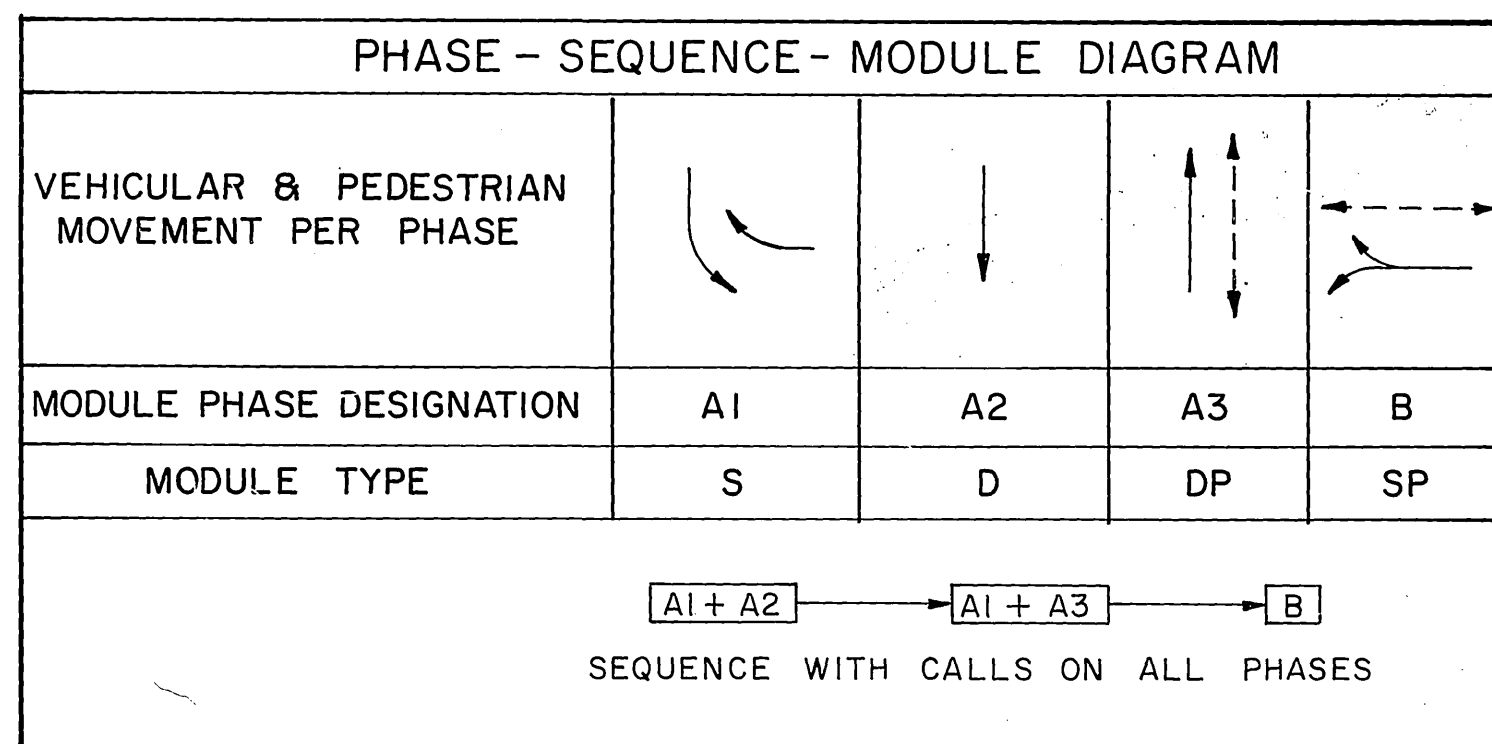

NOTE: Flashing indications shall be all RED.

POLE		SCHEDULE										
No.	TYPE	STANDARD			LUMINAIRE	I.S.N.S. LEGEND	SIGNAL MTG.		PED. PUSH BTN.		REMARKS	
		HEIGHT	SIG. M.A.	LUM. M.A.			VEHICLE	PED.	TYPE	PHASE		
(A)	26A-S	35'-9"	40'	15'	400W.H.P.S.	Central Ave.	MAS	SV-2-T	—	—		
(B)	16-S	18'-6"	20'	—	—	Van Buren Blvd.	MAS	SV-1-T	SP-1-T	B	B	See Detail 'A'
(C)	19A-S	35'-9"	30'	15'	400W.H.P.S.	Central Ave.	MAS	SV-1-T	SP-1-T	B	B	
(D)	1-A	7'-0"	—	—	—	—	—	—	TP-1	B	A3	
(E)	1-A	7'-0"	—	—	—	—	—	—	TP-1	B	A3	
(F)	1-A	10'-0"	—	—	—	—	—	TV-1-T	—	—	—	Yellow & Red Indications shall be lowered

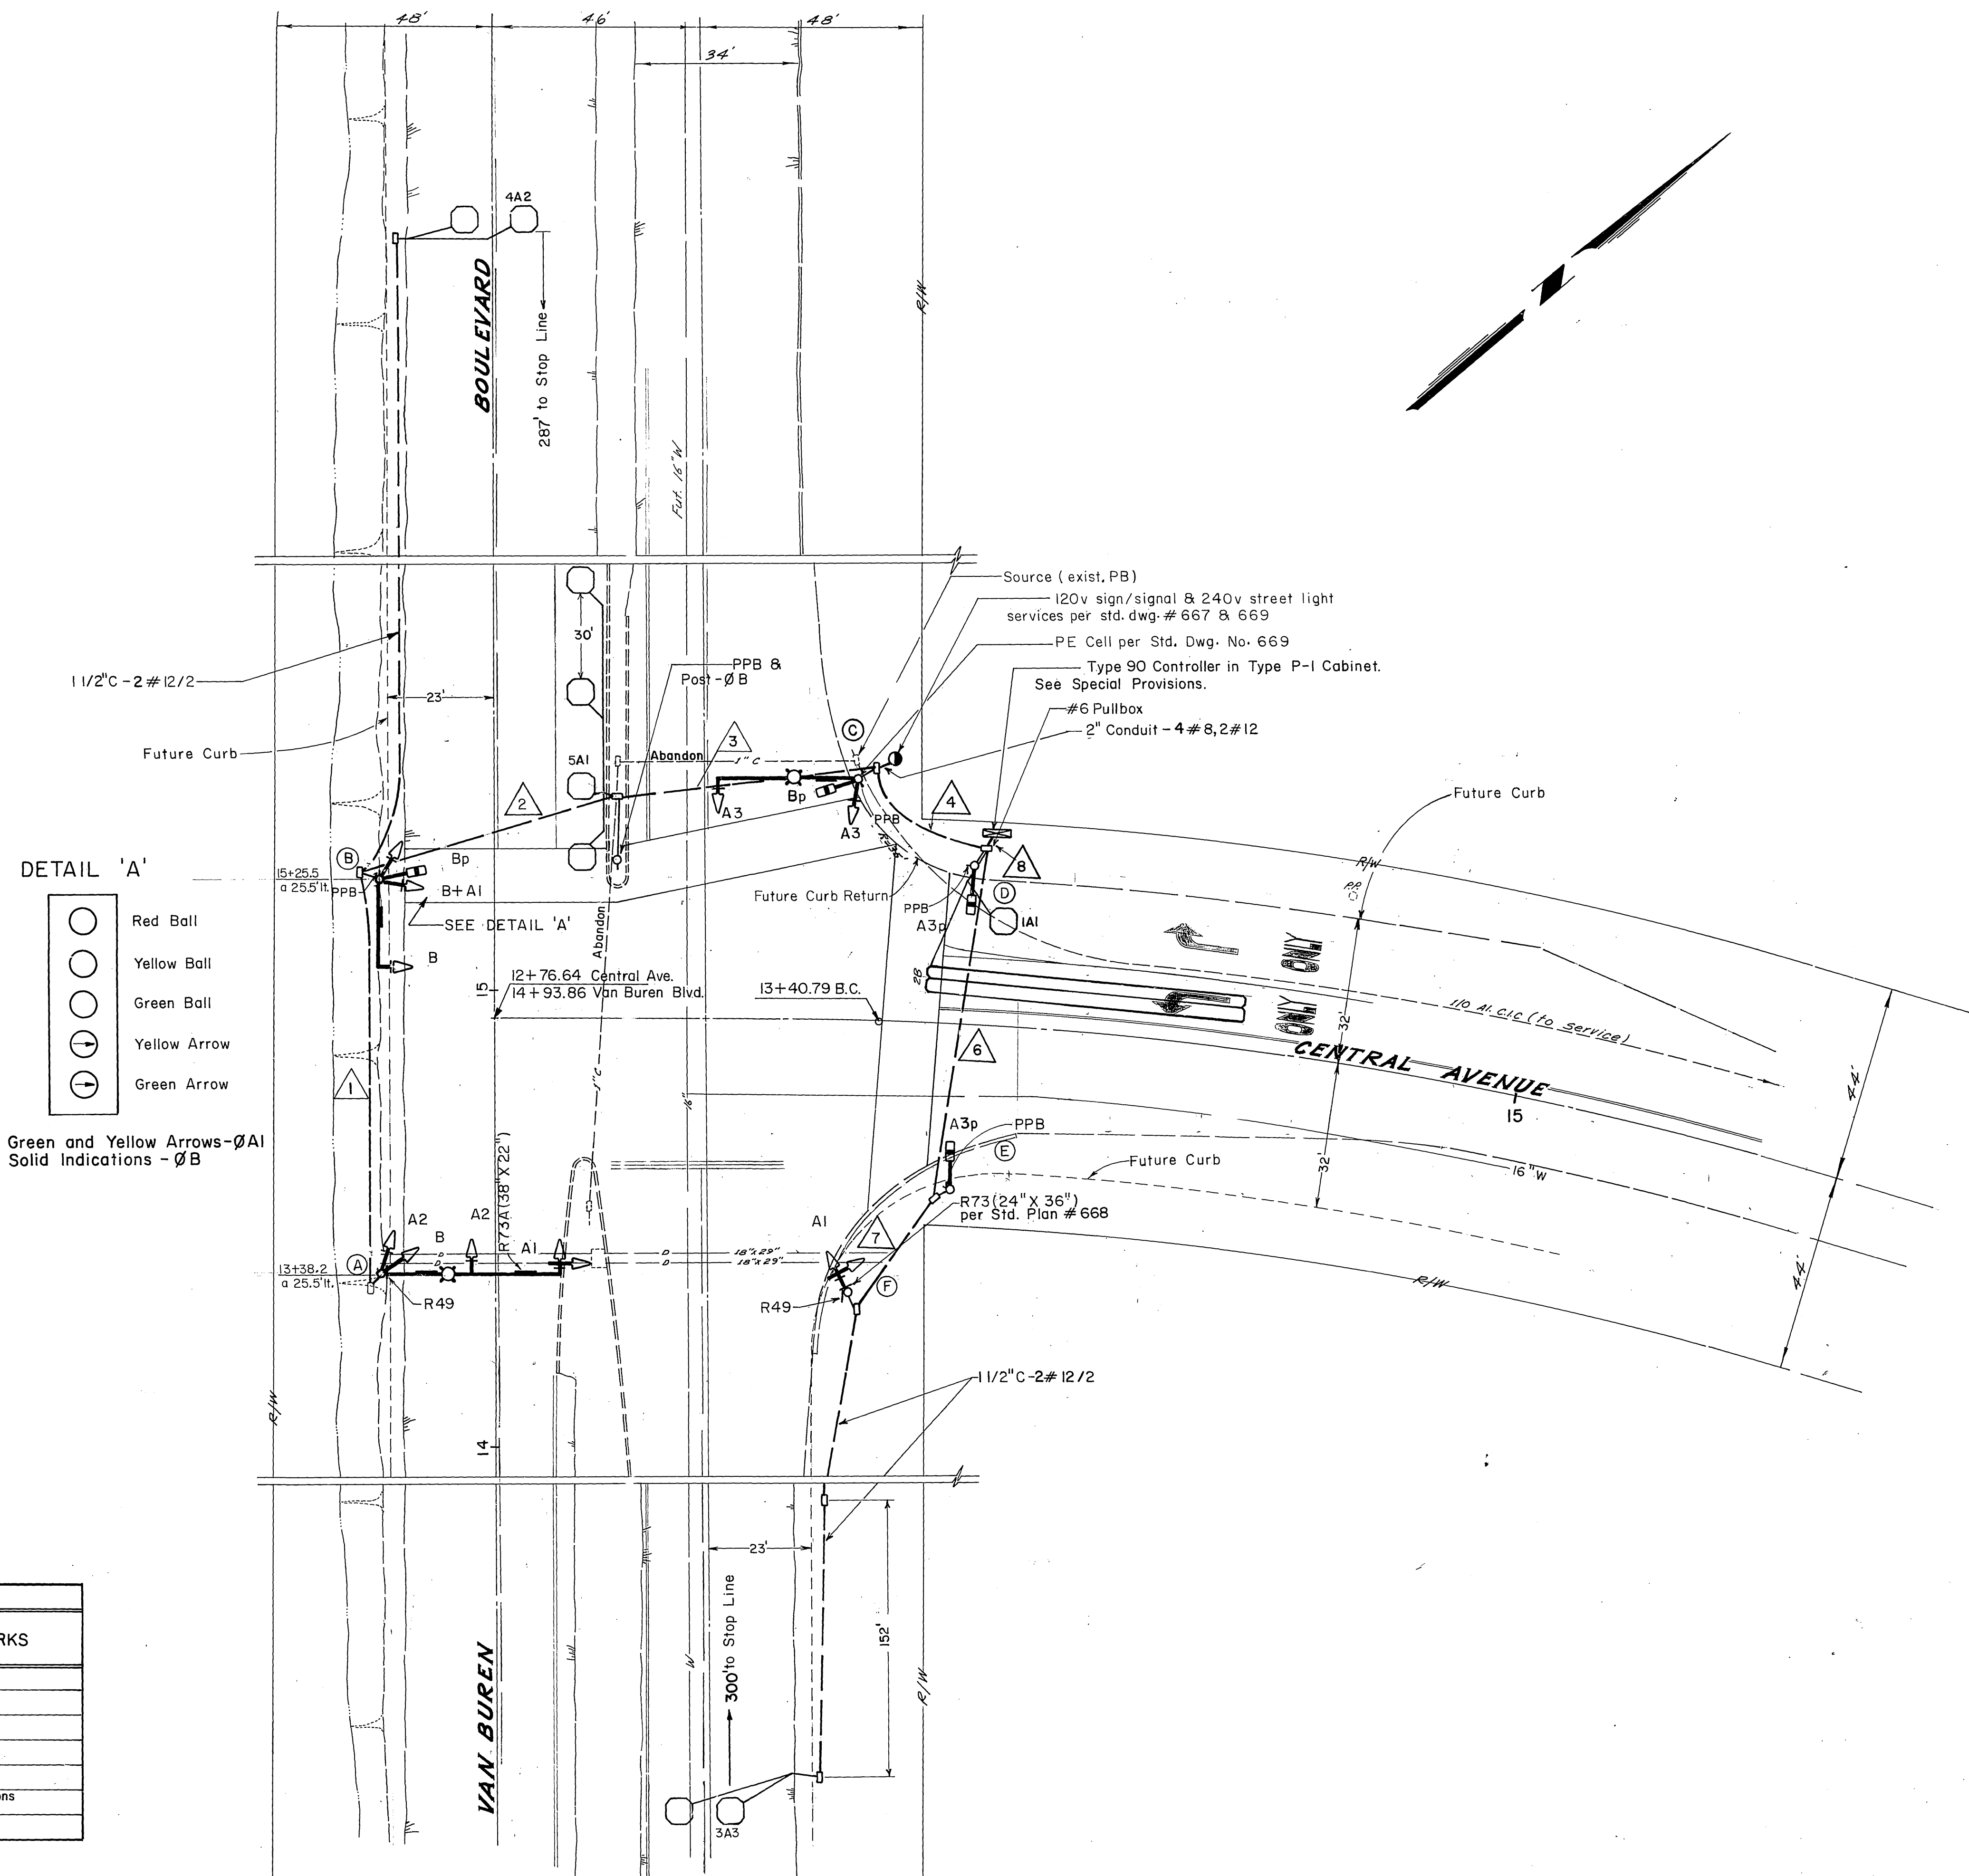

PREPARED BY  
 DESIGN ENGINEER  
 CROMMELIN ■ PRINGLE AND ASSOCIATES

AS BUILT PER SIGNALIZATION 80 2-17-01  
 APPROVED BY  
 PRINCIPAL ENGINEER  
 PARK DEPARTMENT  
 TRAFFIC DIVISION  
 CHIEF P. W. ENGINEER  
 DATE 7-24-75

CITY OF RIVERSIDE  
 PUBLIC WORKS DEPARTMENT

TRAFFIC SIGNALS  
 VAN BUREN BOULEVARD  
 AND CENTRAL AVENUE  
 ACCOUNT NO. 30-876-361  
 X-442  
 SHEET 1 OF 2  
 FILE NO.