

CONDUCTOR SCHEDULE

AWG SIZE OR CABLE TYPE	POLE OR CIRCUIT	CONDUIT SIZE AND RUN NUMBER							
		2"	2.5"	3"	3.5"	3.5"	3.5"	3.5"	2"
12 CONDUCTOR	POLE - A	1	1	1	1	1	1	1	1
	B	1	1	1	1	1	1	1	1
	C	1	1	1	1	1	1	1	1
	D	1	1	1	1	1	1	1	1
	E	1	1	1	1	1	1	1	1
	F	1	1	1	1	1	1	1	1
	G	1	1	1	1	1	1	1	1
	H	1	1	1	1	1	1	1	1
3 CONDUCTOR	I	1	1	1	1	1	1	1	1
	TOTAL	1	1	1	1	1	1	1	1
#12	I.I.S.N.S.	2	2	2	2	2	2	2	2
#10	LUMINAIRES	2	2	2	2	2	2	2	2
DLC (TYPE "B")	Ø1	1	1	1	1	1	1	1	1
	Ø2	3	1	3	3	3	3	3	3
	Ø3	1	1	1	1	1	1	1	1
	Ø4	2	2	2	2	2	2	2	2
	Ø5	1	1	1	1	1	1	1	1
	Ø6	2	2	2	2	2	2	2	2
	Ø7	1	1	1	1	1	1	1	1
	Ø8	2	2	2	2	2	2	2	2
TOTAL	3	13	10	7	7	3	3	3	3
3M OPTICOM CABLE #138		4	2	2	2	2	2	2	2
CONDUIT FILL RATIO				26%	21%	14%			

(E) (E) (E) (E) (N) (N) (N) (E)

INSTALL ALL NEW CONDUCTOR UNLESS OTHERWISE NOTED:

(E) - EXISTING CONDUIT




(N) - NEW CONDUIT

△ - EXISTING RUNS

△ - NEW RUNS

POLE SCHEDULE													
NO.	TYPE	HEIGHT	MAST ARM LENGTH		SIGNAL MOUNTING			PPB	H.P.S.V.	LOCATION		I.I.S.N.S. LEGEND (SHAFT MOUNT)	REMARKS
			SIGNAL	LUMINAIRE	MA	POLE	PED			QUAD	LUMINAIRE		
A	26-4-129(80)	30'	40'	12'	2-MAS	SV-1-T	SP-1-T	6	4	400 W	EX	EX	IOWA Av - 2800
B	1-A	10'	-	-	-	TV-1-T	SP-1-T	8	1	-	EX	EX	
C	26S-A	35'	40'	15'	2-MAS	SV-1-T	SP-1-T	-	-	400 W	EX	EX	SPRUCE
D	PED. POST	3'10"	-	-	-	-	-	8	1	-	EX	EX	
E	1-A	10'	-	-	-	TV-1-T	SP-1-T	2	2	-	EX	EX	
F	26-4-161(N)	30' (N)	45' (N)	15' (N)	2-MAS (N)	SV-1-T (N)	SP-1-T (N)	2	2	400 W	3'	12'	IOWA Av - 2900
G	1-A	10'	-	-	-	TV-1-T	SP-1-T (N)	4	3	-	3'	10'	RELOCATE EXIST U.I.S.N.S. AND 721 OPTICAL DETECTORS
H	26S-A	35'	45'	15'	2-MAS	SV-1-T	SP-1-T	4	3	400 W	EX	EX	SPRUCE
I	1-A	10'	-	-	-	TV-1-T	SP-1-T (N)	6	4	-	EX	EX	RELOCATE EXIST POLE AND SIGNAL MOUNTING

(N) = New

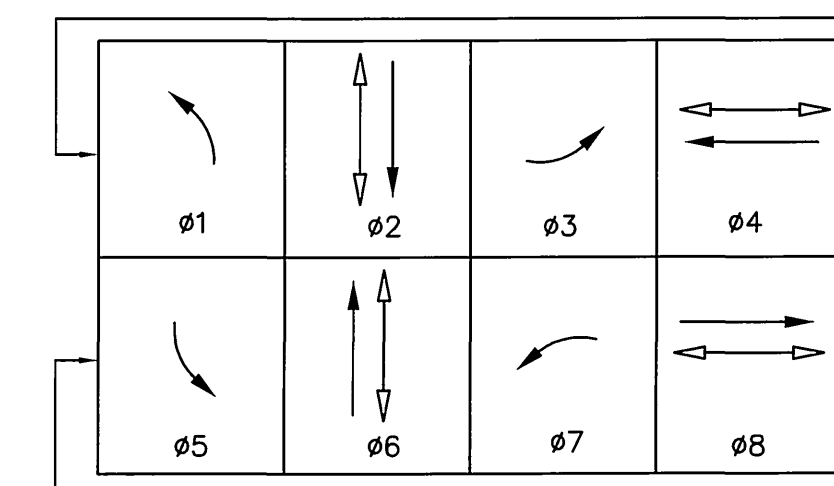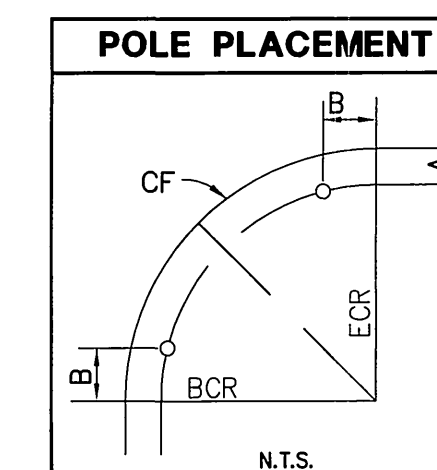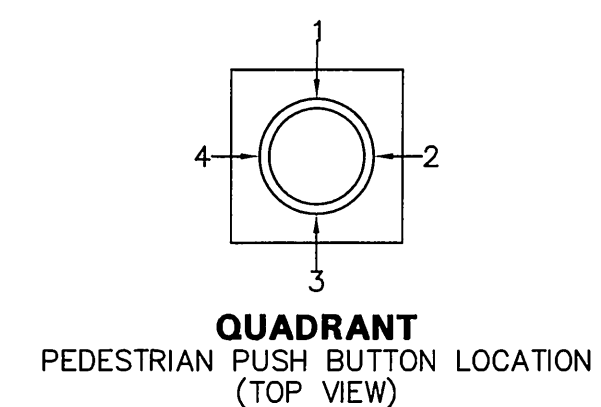

PHASE DIAGRAM




SENSOR TABLE	
LOOP DESIGNATION	NUMBER OF LOOPS
1-S-Ø1	3
1-N-Ø2	2
2-N-Ø2	4
1-W-Ø3	3
1-E-Ø4	4
2-E-Ø4	4
1-N-Ø5	3
1-S-Ø6	2
2-S-Ø6	4
1-E-Ø7	3
1-W-Ø8	4
2-W-Ø8	4
3-N-Ø2	2

SPRUCE STREET

CONSTRUCTION NOTES:

- FURNISH AND INSTALL NO. 5 PULL BOX
- FURNISH AND INSTALL 1 1/2" CONDUIT AND 1 DLC
- FURNISH AND INSTALL R3-7 SIGN
- FURNISH AND INSTALL NO. 6 PULL BOX
- REMOVE AND SALVAGE SIGNAL FACILITIES
- REMOVE AND RELOCATE SIGNAL FACILITIES
- REMOVE CONFLICTING STRIPING BY SAND BLASTING
- EXISTING CURB AND SIDEWALK
- FURNISH AND INSTALL NO. 6 E PULL BOX
- EXISTING MODEL 721 OPTICAL DETECTORS

FOR SIGNING AND STRIPING DETAILS, REFER TO THE SIGNING AND STRIPING PLAN

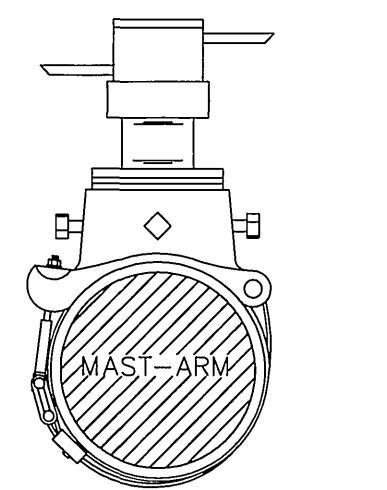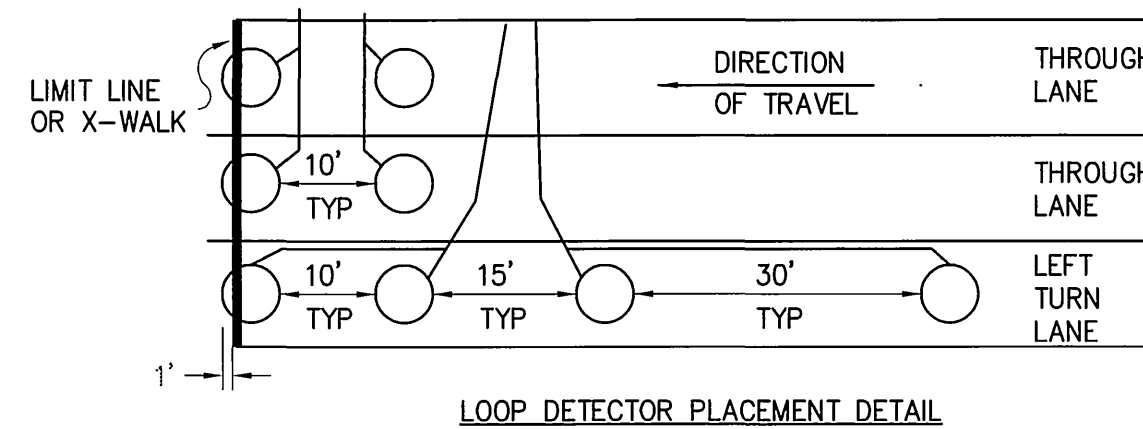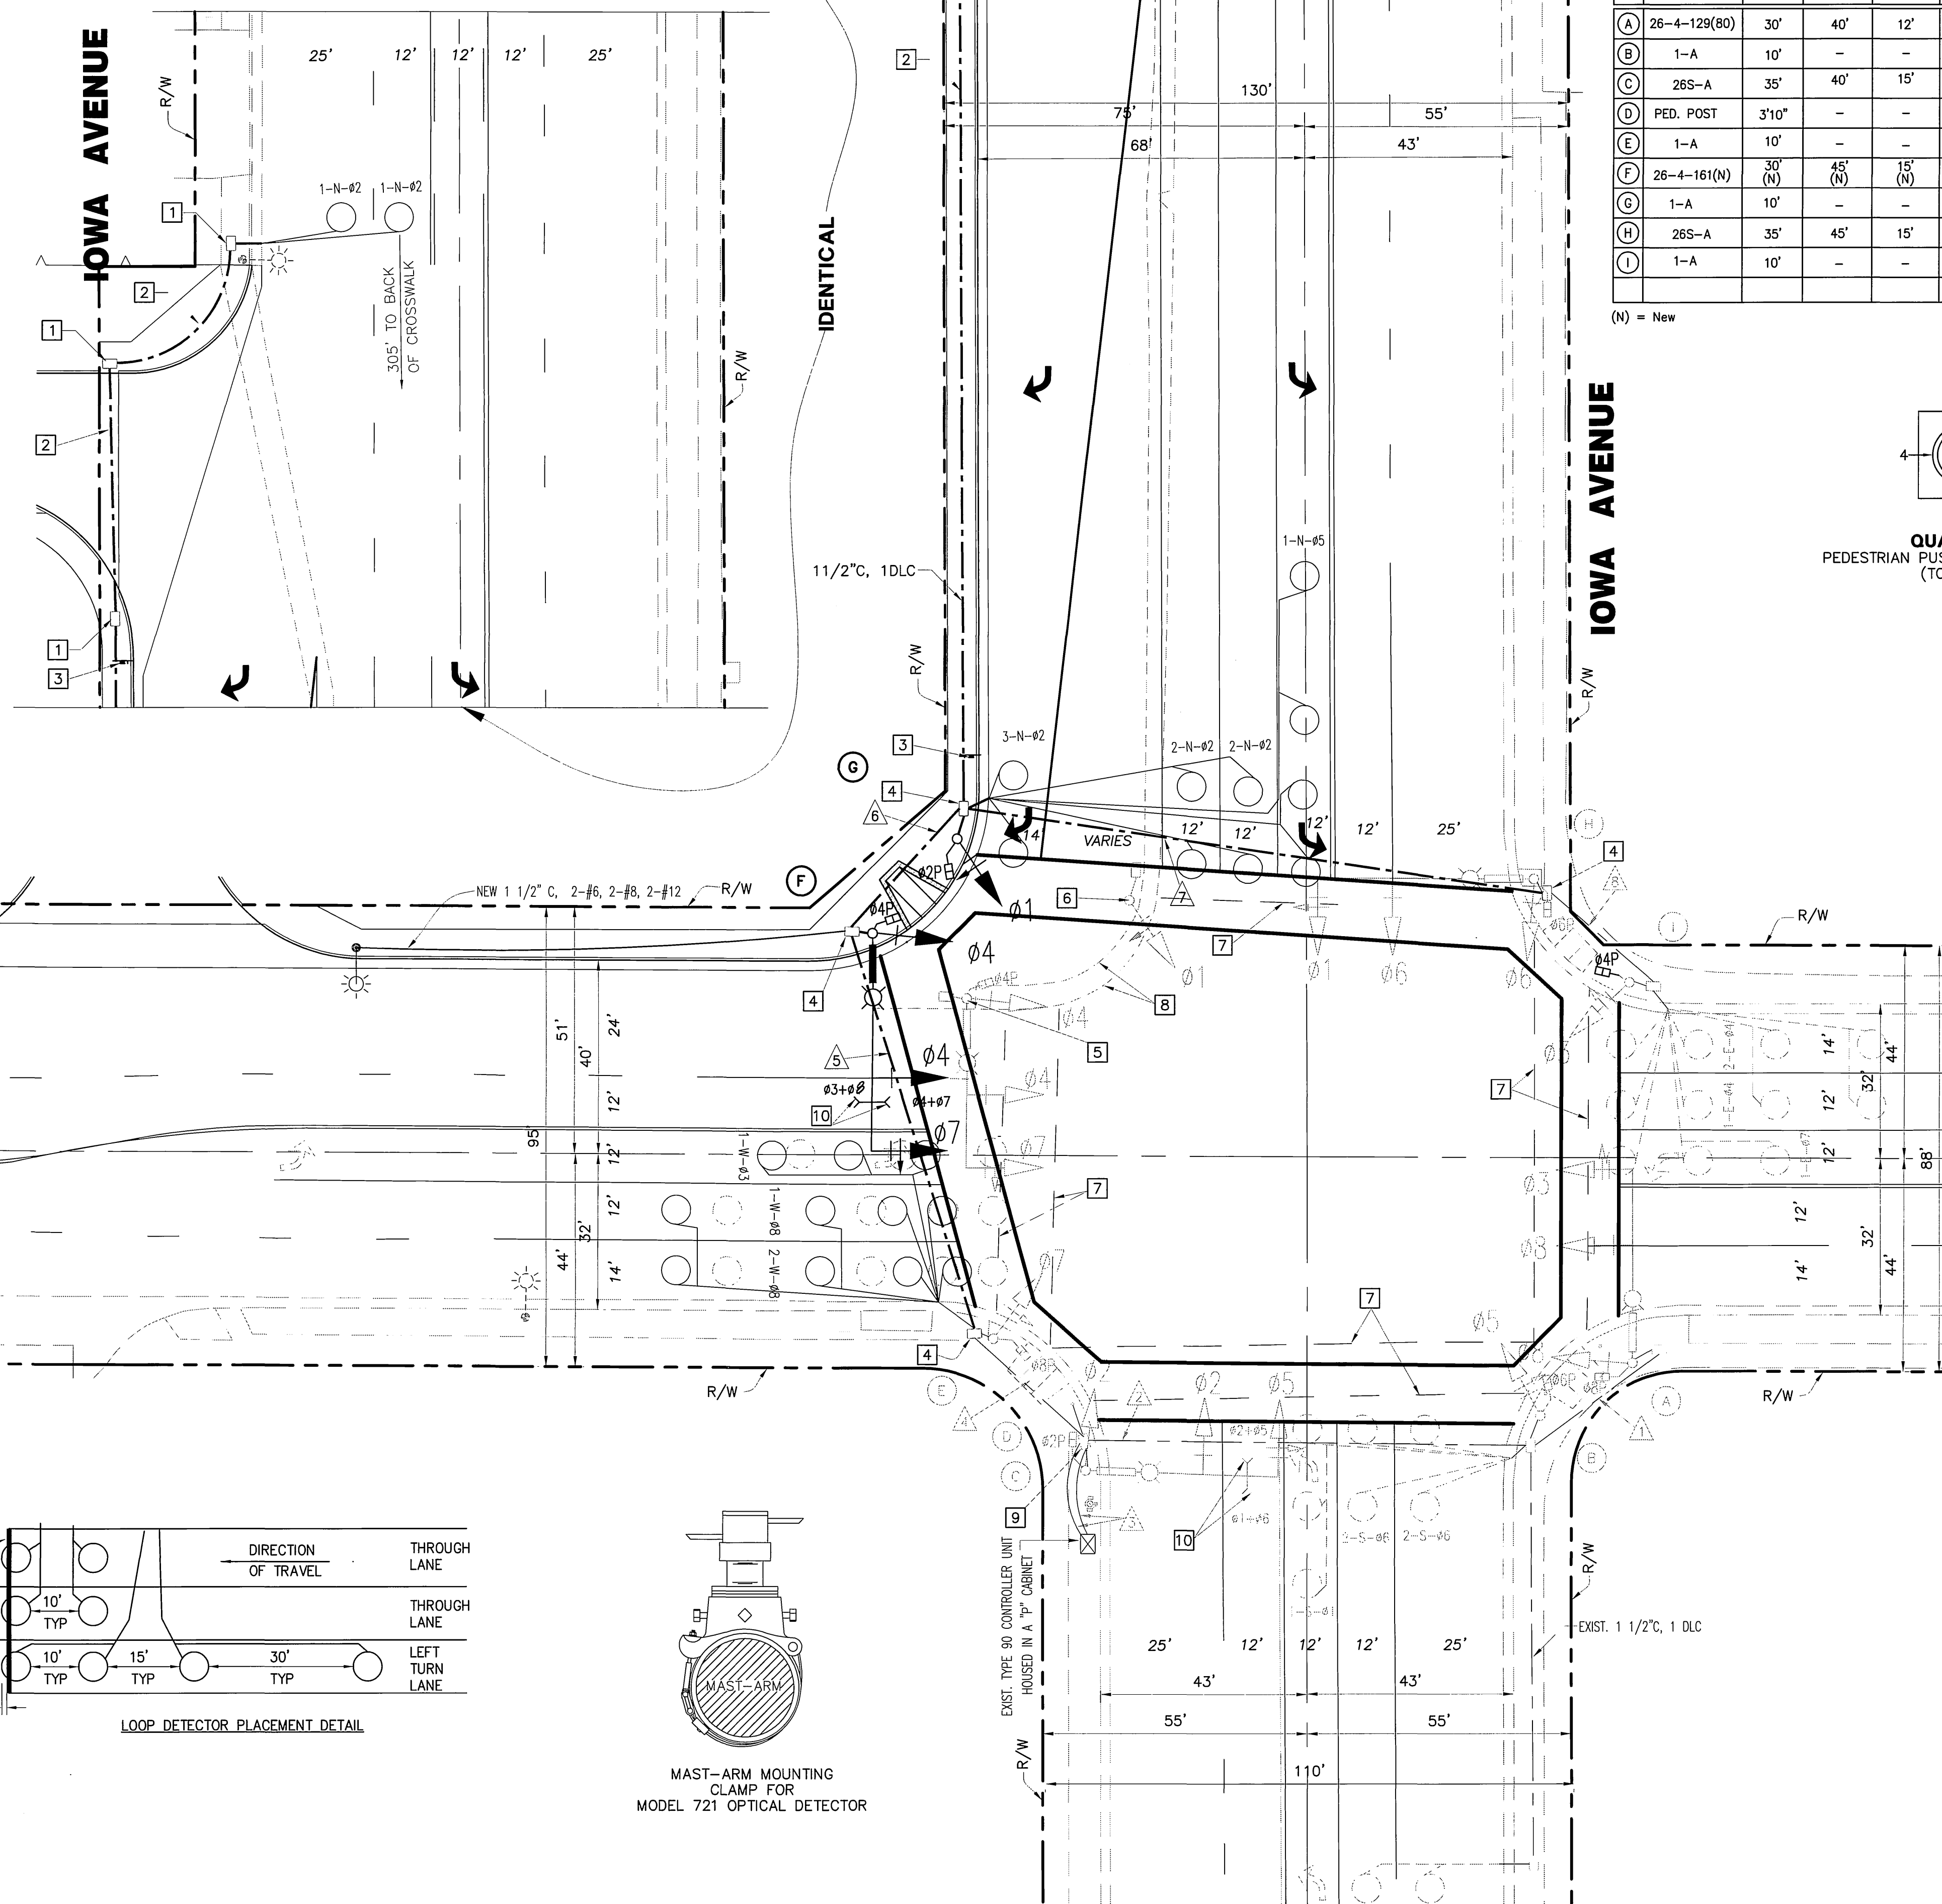

SCALE: 1"=20'

Underground Service Alert

DIAL BEFORE YOU DIG

TWO WORKING DAYS YOU DIG

TOLL FREE 1-800-227-2600

A PUBLIC SERVICE BY UNDERGROUND SERVICE ALERT

NOTE:

WORK CONTAINED WITHIN THESE PLANS SHALL NOT COMMENCE UNTIL AN ENCROACHMENT PERMIT AND / OR A GRADING PERMIT HAS BEEN ISSUED.

The private engineer signing these plans is responsible for accuracy and acceptability of the design hereon, in the event of discrepancies arising after county approval or during construction, the private engineer shall be responsible for determining an acceptable solution and revising the plans for approval by the county.

MINAGAR & ASSOCIATES, INC.
 ITS - TRAFFIC ENGINEERING - TRANSPORTATION PLANNING - CIVIL
 18662 MACARTHUR BLVD, SUITE 435, AIRPORT BUSINESS CENTER
 IRVINE, CA 92612
 Tel: (949) 727-3399 Fax: (949) 727-4418 www.minagarinc.com
 Fred Minagar Sept. 13, 06
 R.C.E. 53466 EXP. 6-30-07

CITY OF RIVERSIDE
 PUBLIC WORKS DEPARTMENT

APPROVED BY DATE BY
 PRINCIPAL ENGINEER 9-19-06
 TRAFFIC DIVISION 9-19-06
 CITY ENGINEER
 DATE 9/20/06

TRAFFIC SIGNAL PLAN
 SPRUCE STREET
 AND
 IOWA AVENUE

ACCOUNT NO.
X-443A
 SHEET 1 OF 1
 W.O. 24169

MARK	REVISIONS	APPR.	DATE


EQUIPMENT SCHEDULE

NO.	SIGNAL STANDARD		LUMINAIRE		I.I.S.N.S. LEGEND	SIGNAL MOUNTINGS		PPB PHASE	
	TYPE	H'CHT	M.A.	L.A.		H.P.S.V.	VEHICLE		PEDESTRIAN
(A)	26-4-80	30'	40'	12'	400W IOWA	AV 2800	MAS MAS SV-1-T	SP-1-T	6
(B)	1A	10'					TV-1-T	SP-1-T	8
(C)	26S-A	35'	40'	15'	400W SPRUCE		MAS MAS SV-1-T	SP-1-T	
(D)	Ped. post	3'10"							8
(E)	1A	10'					TV-1-T	SP-1-T	2
(F)	24-4-80	30'	35'	12'	400W IOWA	AV 2800	MAS MAS SV-1-T	SP-1-T	2
(G)	1A	10'					TV-1-T	SP-1-T	
(H)	26S-A	35'	45'	15'	400W SPRUCE		MAS MAS SV-1-T	SP-1-T	
(I)	1A	10'					TV-1-T	SP-1-T	6

NOTES:
 1. All vehicle heads have 12" lenses.
 2. Left-turn vehicle heads have all arrows.

CONDUCTOR TABLE


CONTROL FUNCTION	CONDUCTORS	CONDUCTOR RUNS							
		1	2	3	4	5	6	7	8
VEHICLE & PEDESTRIAN HEADS, PEDESTRIAN PUSH BUTTONS, SPARES & COMMONS	12 WIRE IMSA 9 WIRE IMSA 5 WIRE IMSA 3 WIRE IMSA	1 1 1 1	1 4 3 2	4 2 2 6	2 2 2 3	2 2 2 2	1 2 1 1	1 1 1 1	
DETECTOR CABLE	#16/2		1	1					
PHASE 1									
PHASE 2				2	2	2	2		
PHASE 3				1	1				
PHASE 4				2	2	2	2	2	2
PHASE 5				1	1	1	1		
PHASE 6				3	3				
PHASE 7				1	1	1	1	1	1
PHASE 8				2	2				
I.I.S.N.S.	#12	2	2		2	2	2	2	
LUMINAIRES	#8	2	2		2	2	2	2	
SIGNAL SERVICE	#6			2	2	2			
CONDUIT SIZE		2"	2.5"	2.3"	3.5"	3"	3"	2.5"	2"

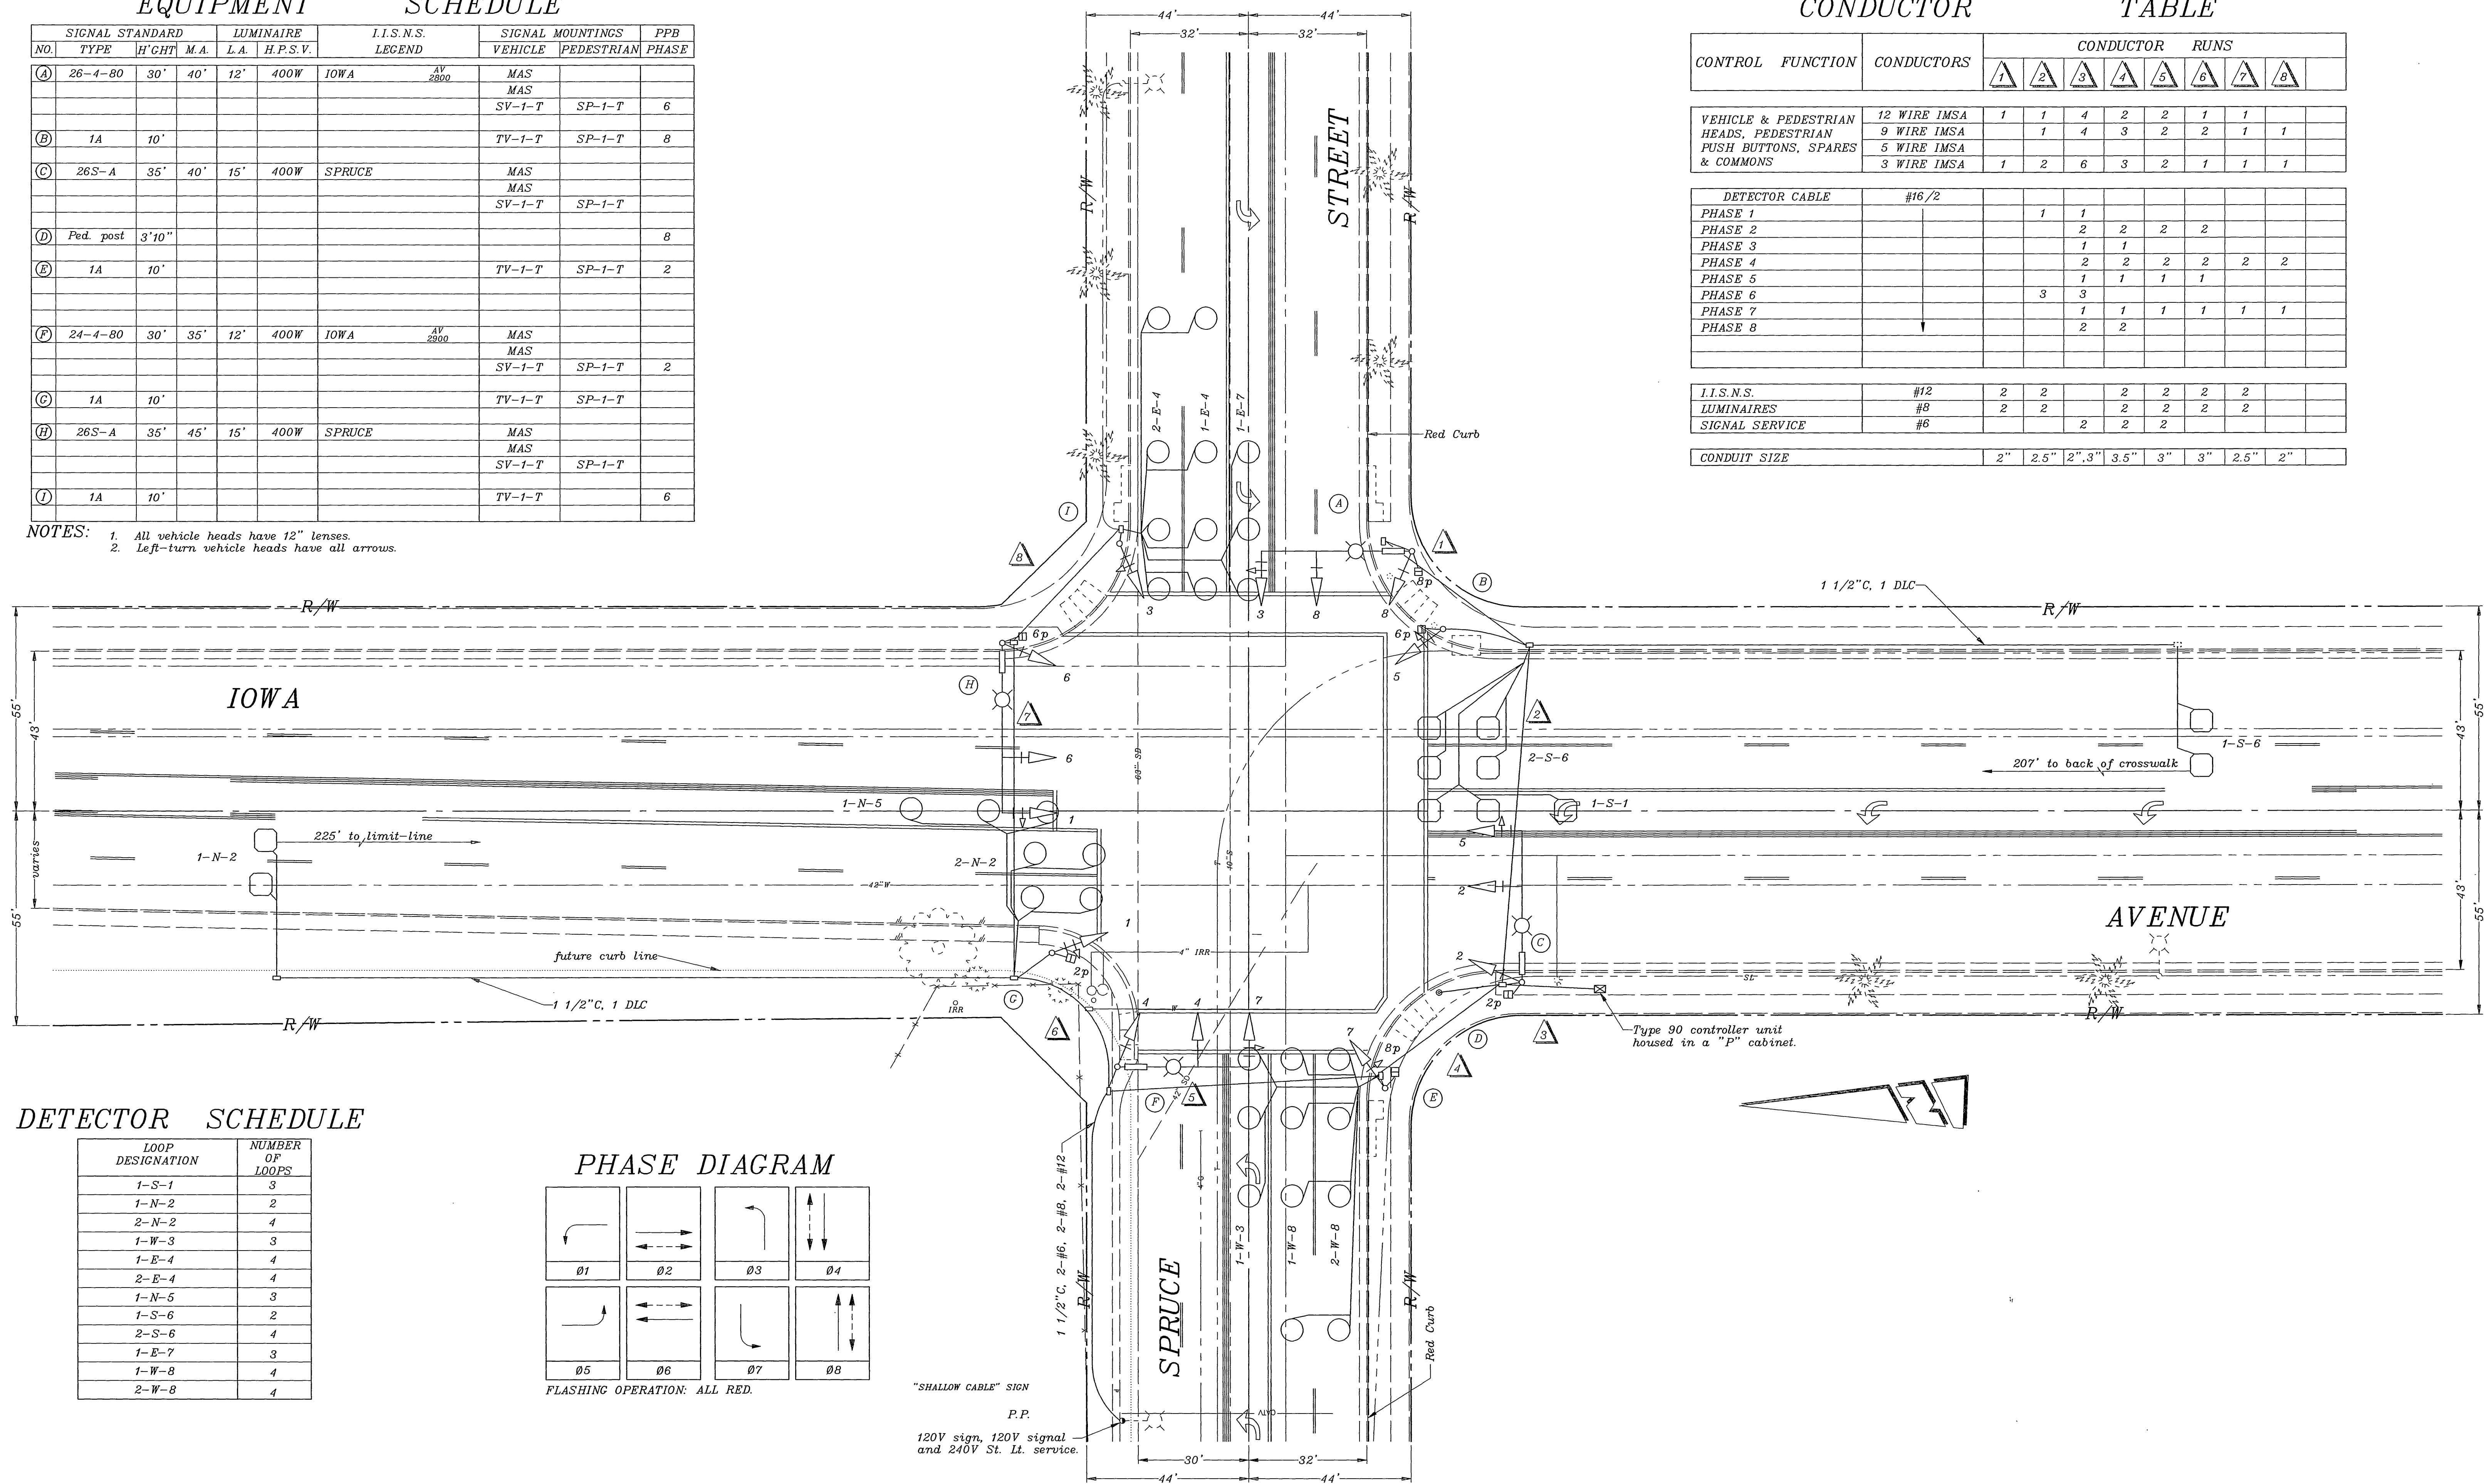

DETECTOR SCHEDULE


LOOP DESIGNATION	NUMBER OF LOOPS
1-S-1	3
1-N-2	2
2-N-2	4
1-W-3	3
1-E-4	4
2-E-4	4
1-N-5	3
1-S-6	2
2-S-6	4
1-E-7	3
1-W-8	4
2-W-8	4

PHASE DIAGRAM

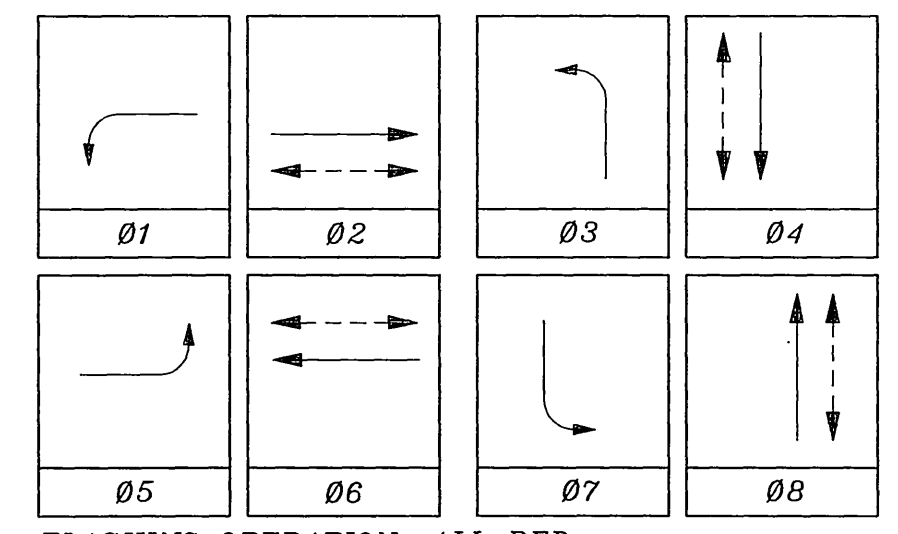

FLASHING OPERATION: ALL RED.

"SHALLOW CABLE" SIGN
 P.P.
 120V sign, 120V signal and 240V St. Ll. service.

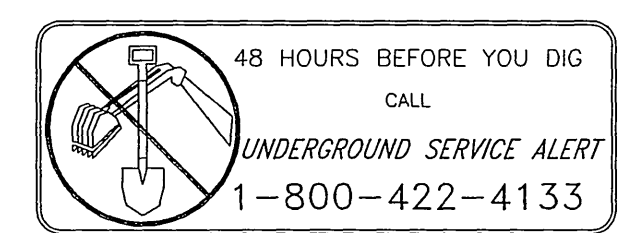

ENGINEER IN RESPONSIBLE CHARGE

 RICHARD D. McGRATH
 R.C.E. No. 31952 expires 3/75
 DATE _____

As-built per Plan R-3392	MAC	1/96
As-built per Plan R-2733	MAC	1/95
As-built SEC Plan R-2583	MHL	
Loop install. per 83 Rehab.	MHL	6/84
As-built per Contract TE-76-2	JS	6/77
Moved controller SW to NW corner	CL	2/76
Correct T-lines of check print	CKP	3/75
MARK	REVISIONS	APPR. DATE
DESIGNED BY _____	DRAWN BY: MAC	CHECKED BY _____

CITY OF RIVERSIDE, CALIFORNIA
 DEPARTMENT OF PUBLIC WORKS
 APPROVED BY _____ BY _____ DATE _____
 PRINCIPAL ENGINEER
 P.W. INSPECTION
 TRAFFIC DIVISION
 CHIEF P.W. ENGR.
 PUBLIC UTILITIES

TRAFFIC SIGNAL
IOWA AVENUE @ SPRUCE ST.
 SCALE: 1" = 20'
 ACCT. NO. X-443
 SHEET 1 OF 1
 FILE NAME: X443B.DWG



Pole Schedule

Pole No	Type	Mast Arm		Pole Height	Veh Sig		Ped Sig		Luminaire	Location	
		Lum.	Sig.		HGT	MTG	HGT	MTG			SIG.
1	1B(special)	-	30'	17'-0"	23/10	23/10	7	SP-2T	C/C	B	NW Corner
2	I-A	-	-	10'	10'	10'	7	SP-1-T	-	B	NW Corner
3	17-5A	15'	15'	35'-9"	23/10	23/10	7	SP-1-T	-	B	N.E. Corner
4	I-A	-	-	10'	10'	10'	7	SP-1-T	C/C	B	N.E. Corner
5	19-5A	15'	30'	35'-9"	23/10	23/10	7	SP-1-T	C	B	S.E. Corner
6	I-A	-	-	10'	10'	10'	7	SP-1-T	C	B	S.E. Corner
7	17-5A	15'	20'	35'-9"	23/10	23/10	7	SP-1-T	C	B	S.W. Corner
8	I-A	-	-	10'	10'	10'	7	SP-1-T	C	B	S.W. Corner

- Type & size of signal head shown by # referenced to Detail Sheet #5
- Type IA standards to be aluminum, and will be City furnished, including anchor bolts.
- Luminaires to be the High Pressure Sodium Vapor Type
- All new standards shall be installed 3' behind face of curb unless noted otherwise.
- Type 1B (special) standard shall be manufactured to accommodate internally illuminated St. Name Sign.
- TRAFFIC CONTROL SIGNS, R73A AND R73 SHALL BE 38" X 22" AND 30" X 36", RESPECTIVELY AND SHALL CONFORM TO THE STATE OF CALIF. UNIFORM SIGN CHART DATED OCT. 1974.

CONDUCTOR TABLE

AWG	CIRCUIT	TABLE							
		1	2	3	4	5	6	7	8
#14 U.F.	A VEHICLE SIGNAL								
	A ₂ " "	3	3	3	3				
	A ₃ " "				6	3			
	A ₄ " (B ₂)	3	3	3(2)	6(4)	3(2)	3(2)	3	3
	B ₁ VEHICLE SIGNAL								
	B ₂ " "	3	3	3	3	3			
	B ₃ (FUTURE)								
	A ₁ PED. SIGNAL								
	A ₂ " "	2	2	2	2	2	2		
	B ₁ " "	2	2	2	4	2	2	2	2
	B ₂ " "				4	2			
A ₁ PED. PUSH BUTTN					2	2	2	1	
A ₂ " "		1	2	2					
B ₁ " "	1	1	1	2	1	1	1	1	
B ₂ " "				2					
12 V Common	1	1	1	2	1	1	1	1	
SPARES	3	3	3	6	3	3	3	3	
TOTAL # 14		15	19	22	50	31	22	10	10
#12 P.E.	A ₁ DET.				2	2	2	2	2
	A ₂ DET.								
	A ₃ DET.				1	1	1	1	1
	A ₄ DET.								
	B ₁ DET.		1	1	1				
	B ₂ DET.				3	3	3		
TOTAL # 12/R		1	1	7	6	6	3	3	
#12 U.F.	Ill. St. Name Signs	2	2	2	4	2	2	2	
TOTAL # 12		2	2	2	4	2	2	2	
#10 U.F.	120 V. COMMON	1	1	1	2	1	1	1	
#8 U.F.	SIGNALS								
#8 THW.	LUMINAIRES			2	4	2	2	2	
CONDUIT SIZE		2"	2"	2 1/2"	3 1/2"	5"	2 1/2"	2 1/2"	2"

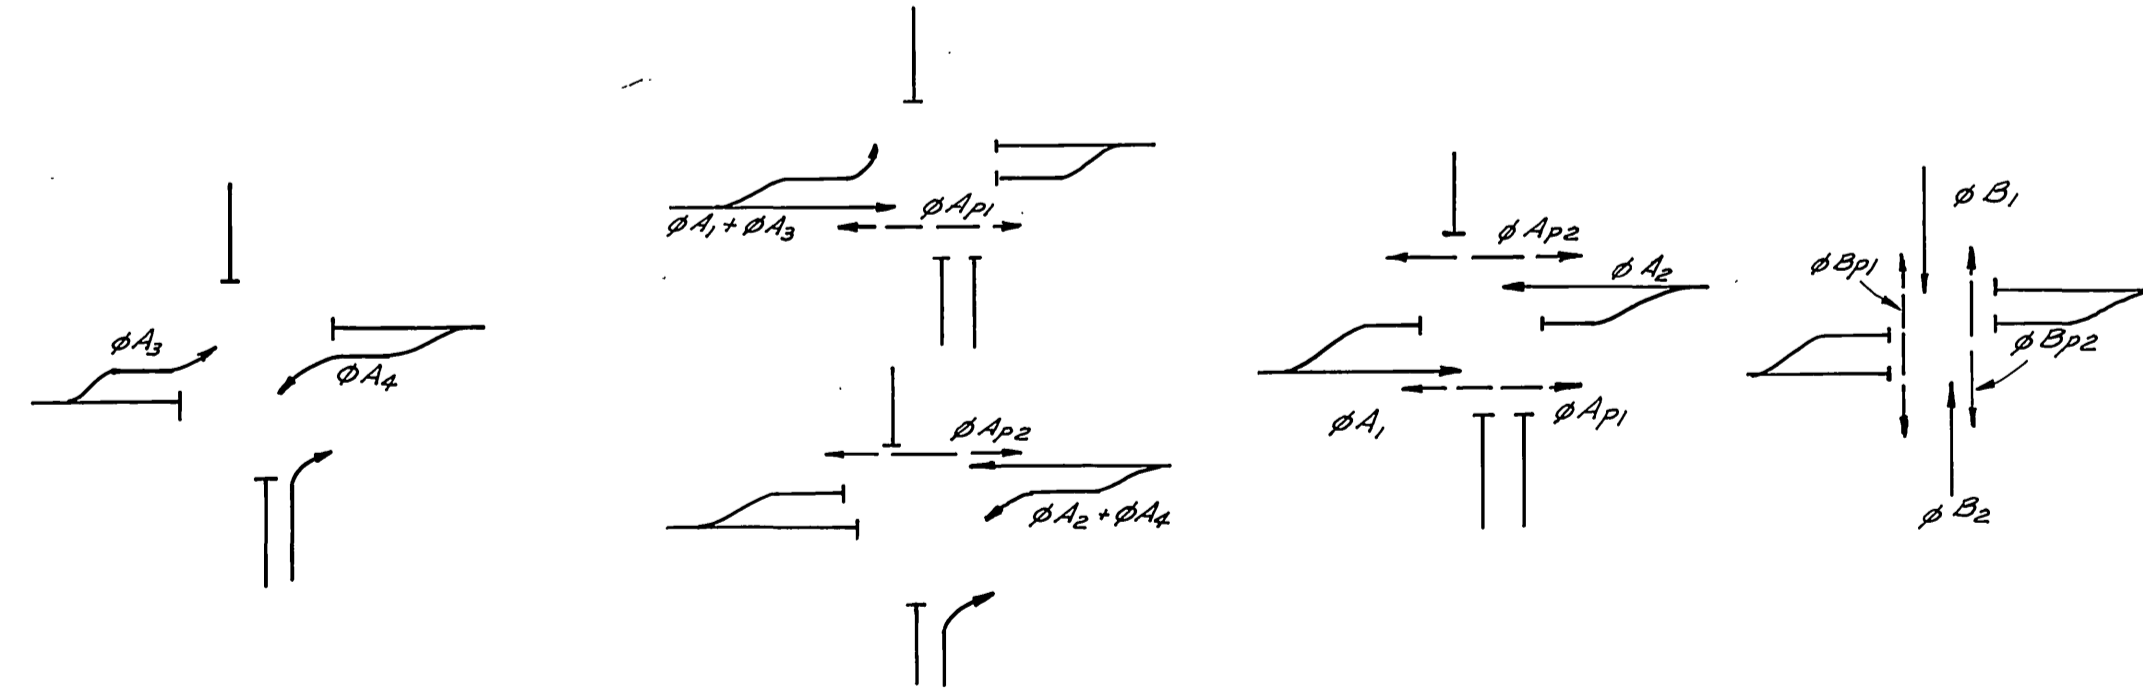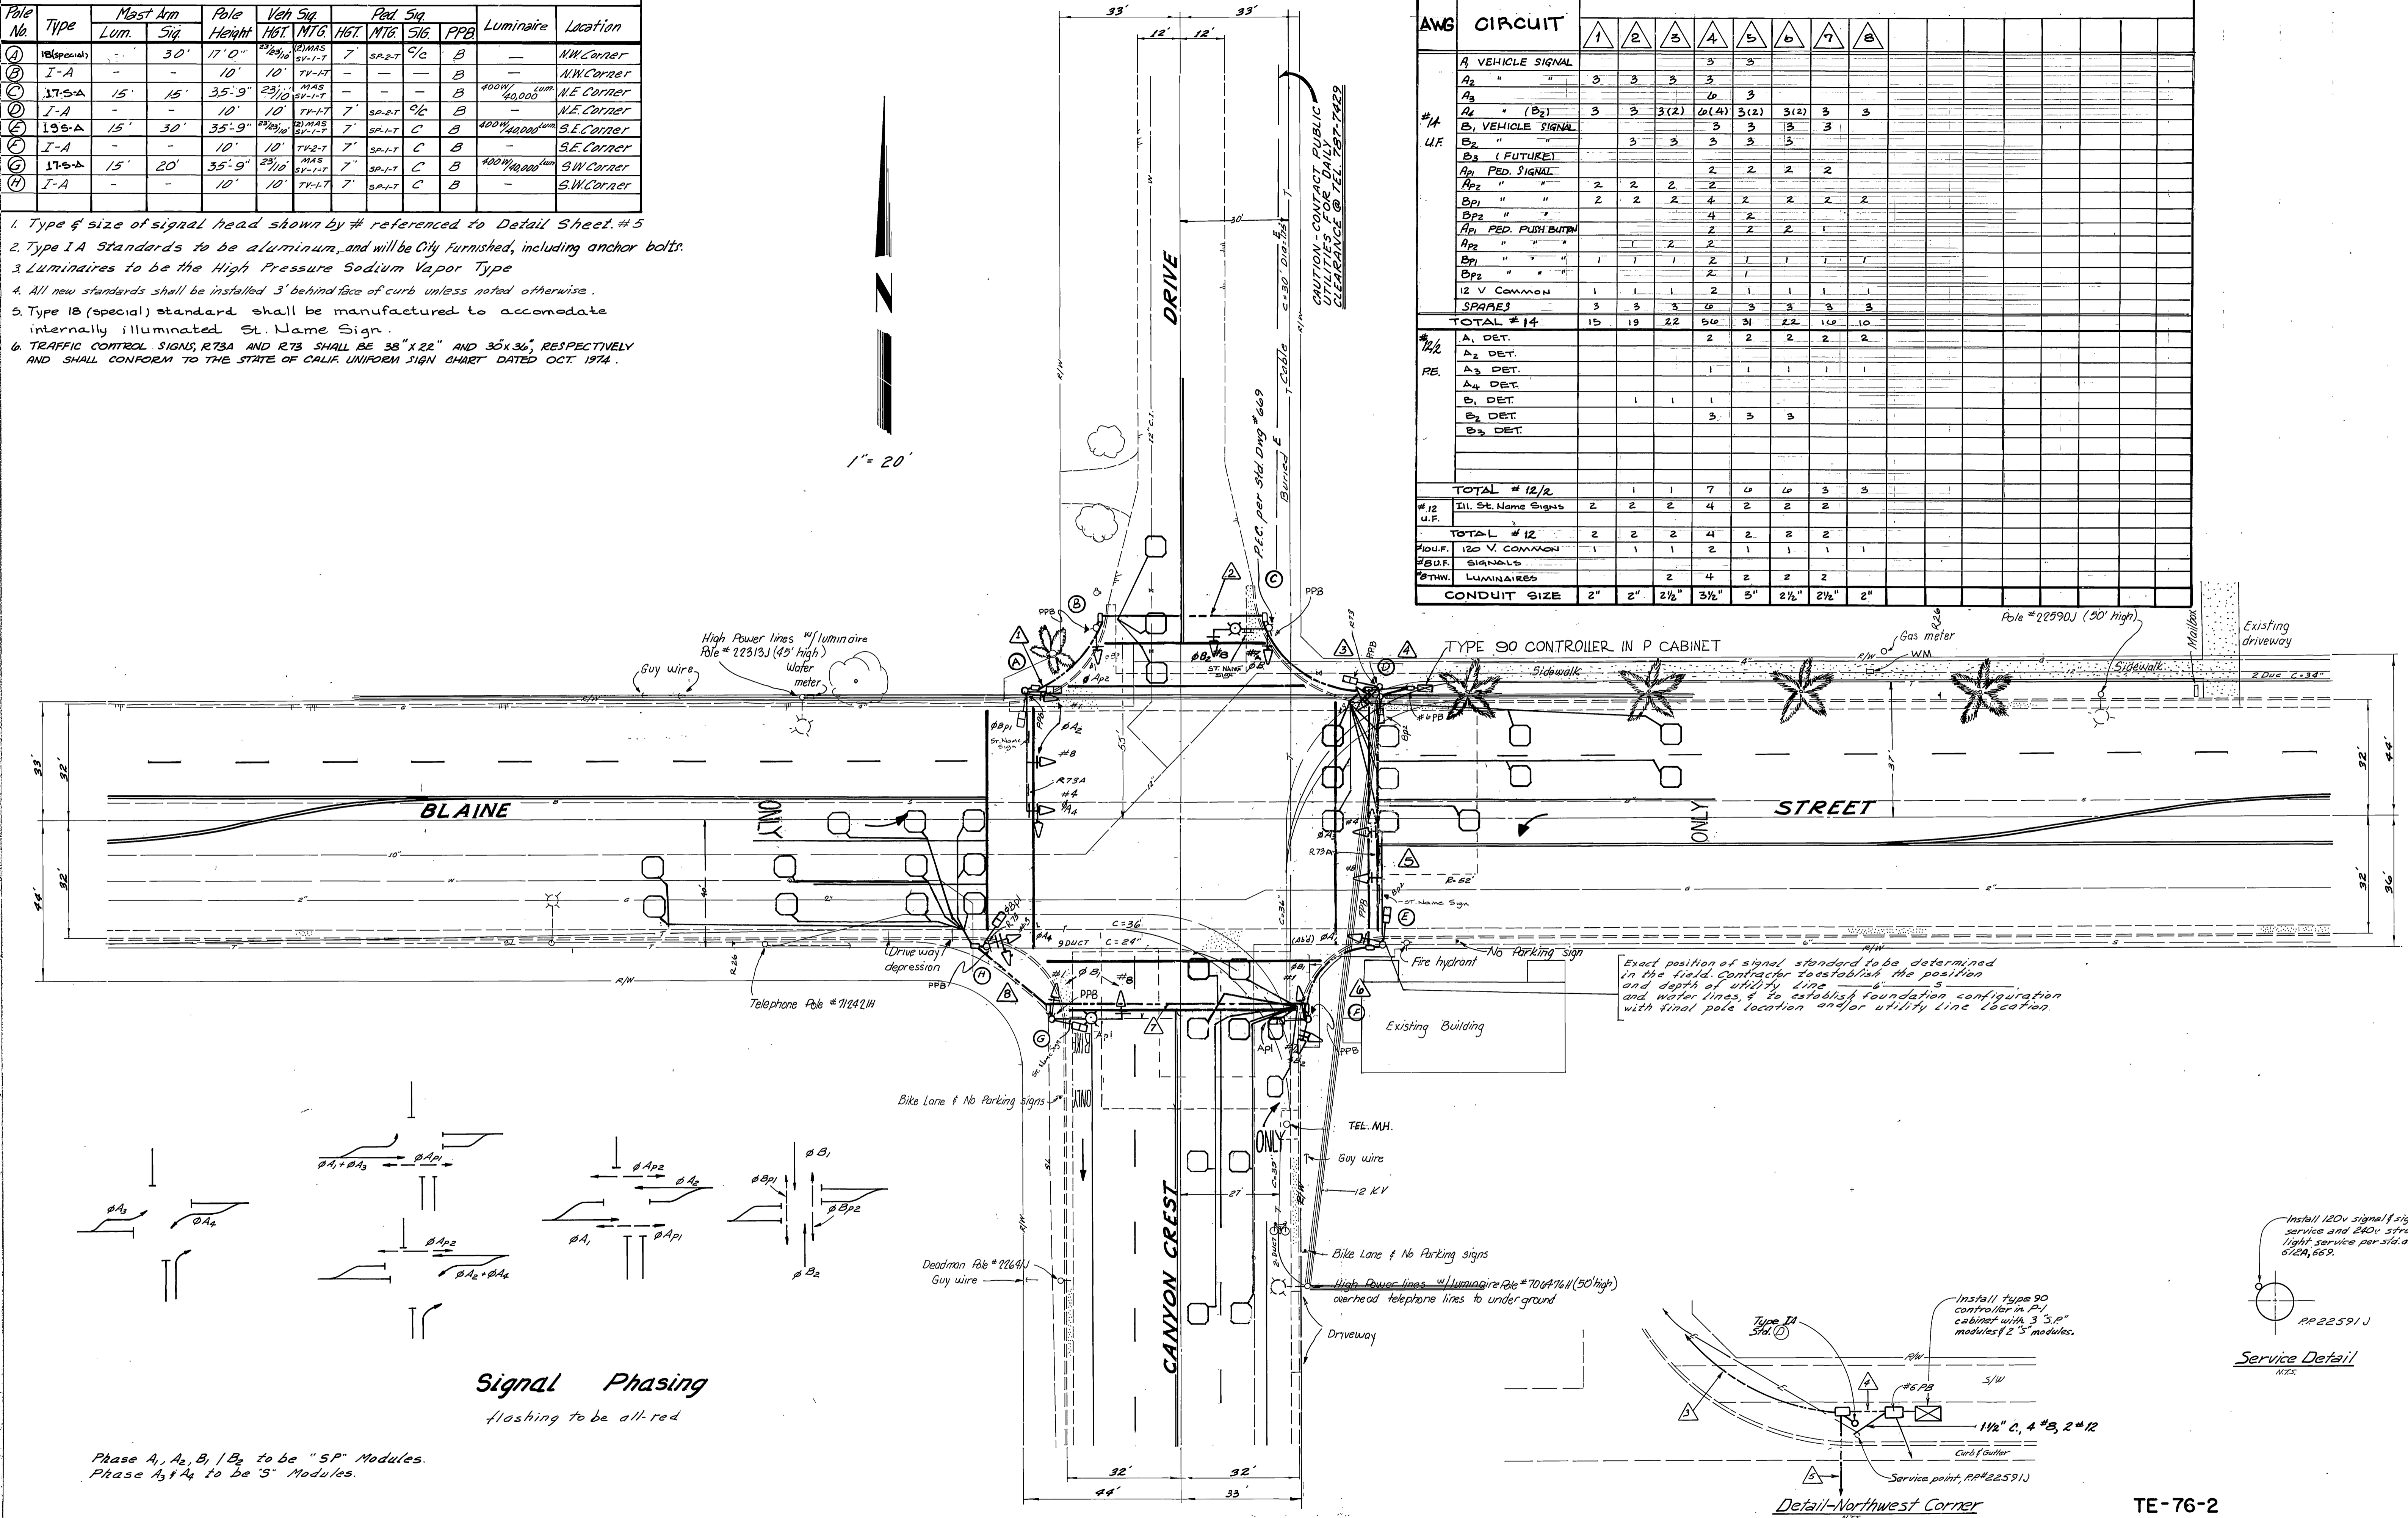


Signal Phasing
flashing to be all red

Phase A₁, A₂, B₁, B₂ to be "SP" Modules.
Phase A₃, A₄ to be "S" Modules.

Exact position of signal standard to be determined in the field. Contractor to establish the position and depth of utility line and water lines, & to establish foundation configuration with final pole location and/or utility line location.

Install 120v signal & sign service and 240v street light service per std. des. 9-23A, 659.

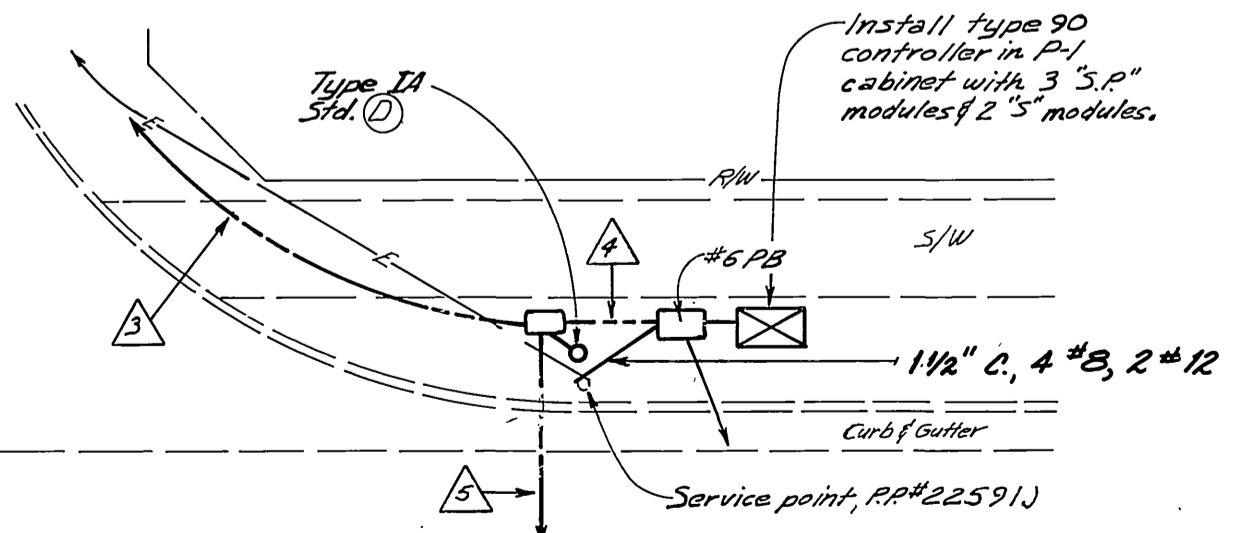

Service Detail
NITE

Detail-Northwest Corner

TE-76-2

DESIGNED: H.J.K.
DRAWN: R.G.
CHECKED: H.J.K.
JOB NO: 254-01.66
SCALE: 1" = 20'
Date: Jan 75

krueper engineering & associates
civil engineering • land surveying
568 north mountain view, suite 230
san bernardino, california 92401
884-2159
Calif. Reg. No. 2953

AS BUILT PER CONTRACT TE-76-2
AS BUILT PER ST. LIGHT PLAN IS APPROX. 7-15-80
AS BUILT LOOKS PER B.L. PERHAPS 11/29/84 (BY)

MARK: REVISIONS: APPR. DATE: CHECKED BY: DRAWN BY: DESIGNED BY:

CITY OF RIVERSIDE
PUBLIC WORKS DEPARTMENT

APPROVED BY: [Signature]
PRINCIPAL ENGINEER

APPROVED BY: [Signature]
PUBLIC WORKS DIRECTOR

DATE: 2-23-76

TRAFFIC SIGNALS

BLAINE STREET & CANYON CREST DRIVE

HORIZ. SCALE: 1" = 20' VERT. SCALE: 1" =

ACCOUNT NO. 30-576-365-07

X-443
SHEET 3 OF 5
FILE NO.