

**EQUIPMENT SCHEDULE**

NO.	SIGNAL STANDARD				LUMINAIRE		I.I.S.N.S.		SIGNAL MOUNTINGS			PPB
	TYPE	H'GHT	M.A.	L.A.	H.P.S.V.	LEGEND	VEHICLE	PEDESTRIAN	AUDIBLE	PHASE		
(A)	19-4-80	30'	30'	12'	250W	ANNA	ST 5700	MAS				
								MAS				
								SV-2-TD	SP-1-T	((C1))		
(B)	PED. POST	3'10"										4
(C)	1A	7'							TP-1-T	((P1))		
(D)	PED. POST	3'10"										6
(E)	17-2-80	30'	20'	12'	200W	ARLINGTON	AV 2900	MAS				
								SV-1-T	SP-1-T	((P1))		6
(F)	1A	10'						TV-1-T				6 Bike
(G)	26-4-80	30'	45'	12'	250W	ANNA	ST 2900	MAS				
								MAS				
								SV-1-T	SP-1-T	((P1))		
(I)	1A	10'						TV-1-T				2
(K)	17-2-80	30'	20'	12'	200W	ARLINGTON	AV 2900	MAS				
								SV-1-T	SP-1-T	((C1))		2
(L)	1A	10'						TV-1-T	SP-1-T	((P1))		2 Bike, 4

NOTES: 1. ALL VEHICULAR HEADS HAVE 12" LENSES.  
2. ALL LEFT TURN HEADS HAVE ALL ARROWS.



**DETECTOR SCHEDULE**

LOOP DESIGNATION	NUMBER OF LOOPS	FEATURES
111U	3	
212U	2	● ■
212L	4	
315U	3	
4J6U	2	
4J6L	4	
4J7U	1	▲
5J1U	3	
6J2U	2	● ■
6J2L	4	
6J3U	2	▲



● SAMPLING (future)  
■ CALL-HOLD (extension)  
▲ DELAY  
Detectors shall be 2-channel rack-mounted.

**CONDUCTOR TABLE**

CONTROL FUNCTION	CONDUCTORS	CONDUCTOR RUNS								
		1	2	3	4	5	6	7	8	9
VEHICLE & PEDESTRIAN HEADS, PEDESTRIAN PUSH BUTTONS, SPARES & COMMONS	12 WIRE IMSA 9 WIRE IMSA 5 WIRE IMSA 3 WIRE IMSA	1	1	1	4	2	2	1		1
DETECTOR CABLE	#16/2				1	1				
PHASE 1			2	2	2					
PHASE 2						3	3	3	3	1
PHASE 4										2
PHASE 5			1	1	1	1				
PHASE 6						3	3			
PHASE 3 (fut. phase B)					1	1				
I.I.S.N.S.	#12		2	2		2	2	2		2
LUMINAIRES	#8		2	2		2	2	2		2
SIGNAL SERVICE	#6				2					
CONDUIT SIZE		2"	2.5"	3"	2-3"	3"	2.5"	2.5"	2"	2.5"

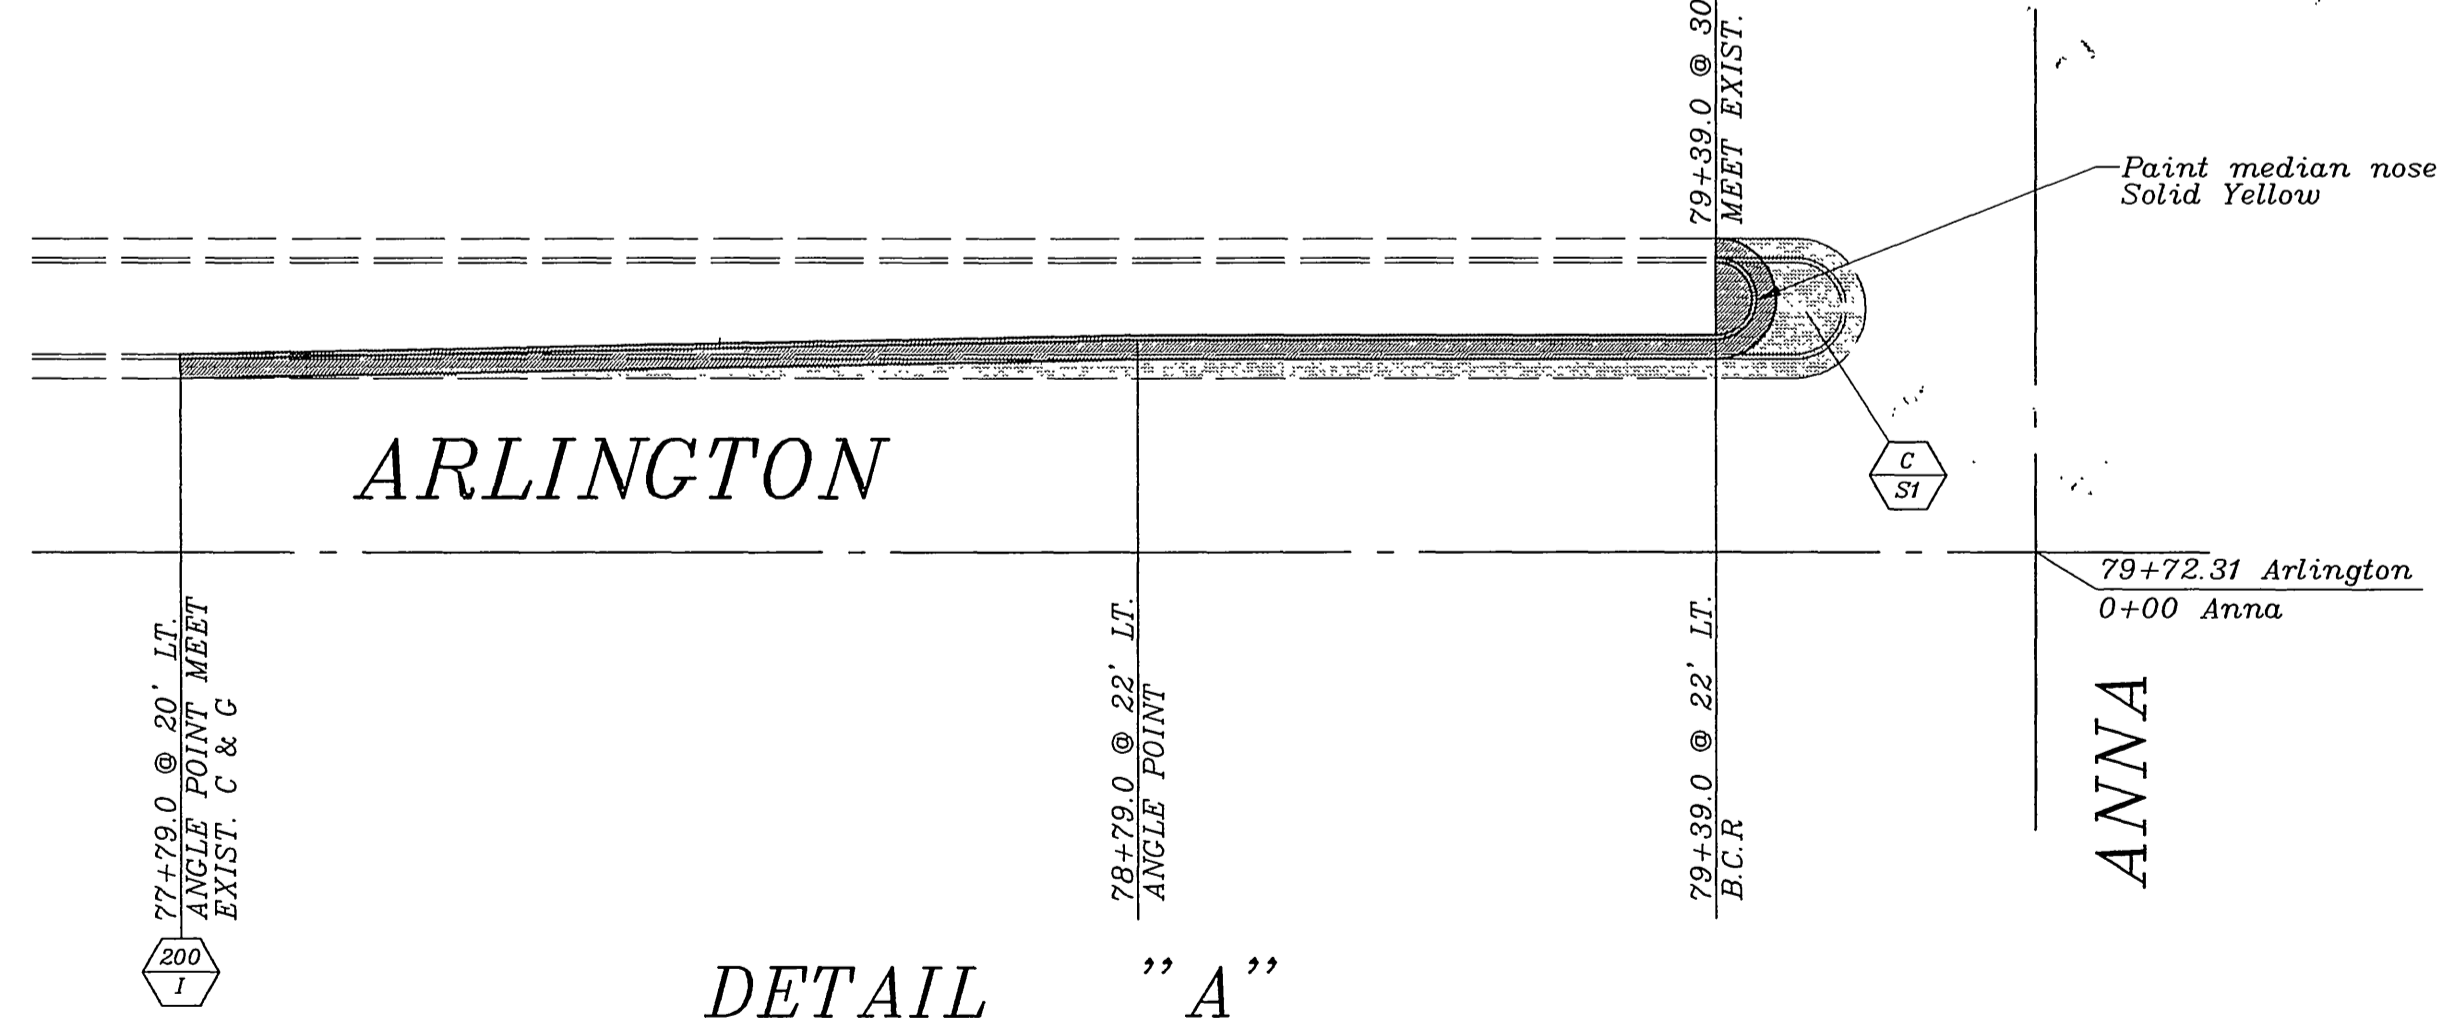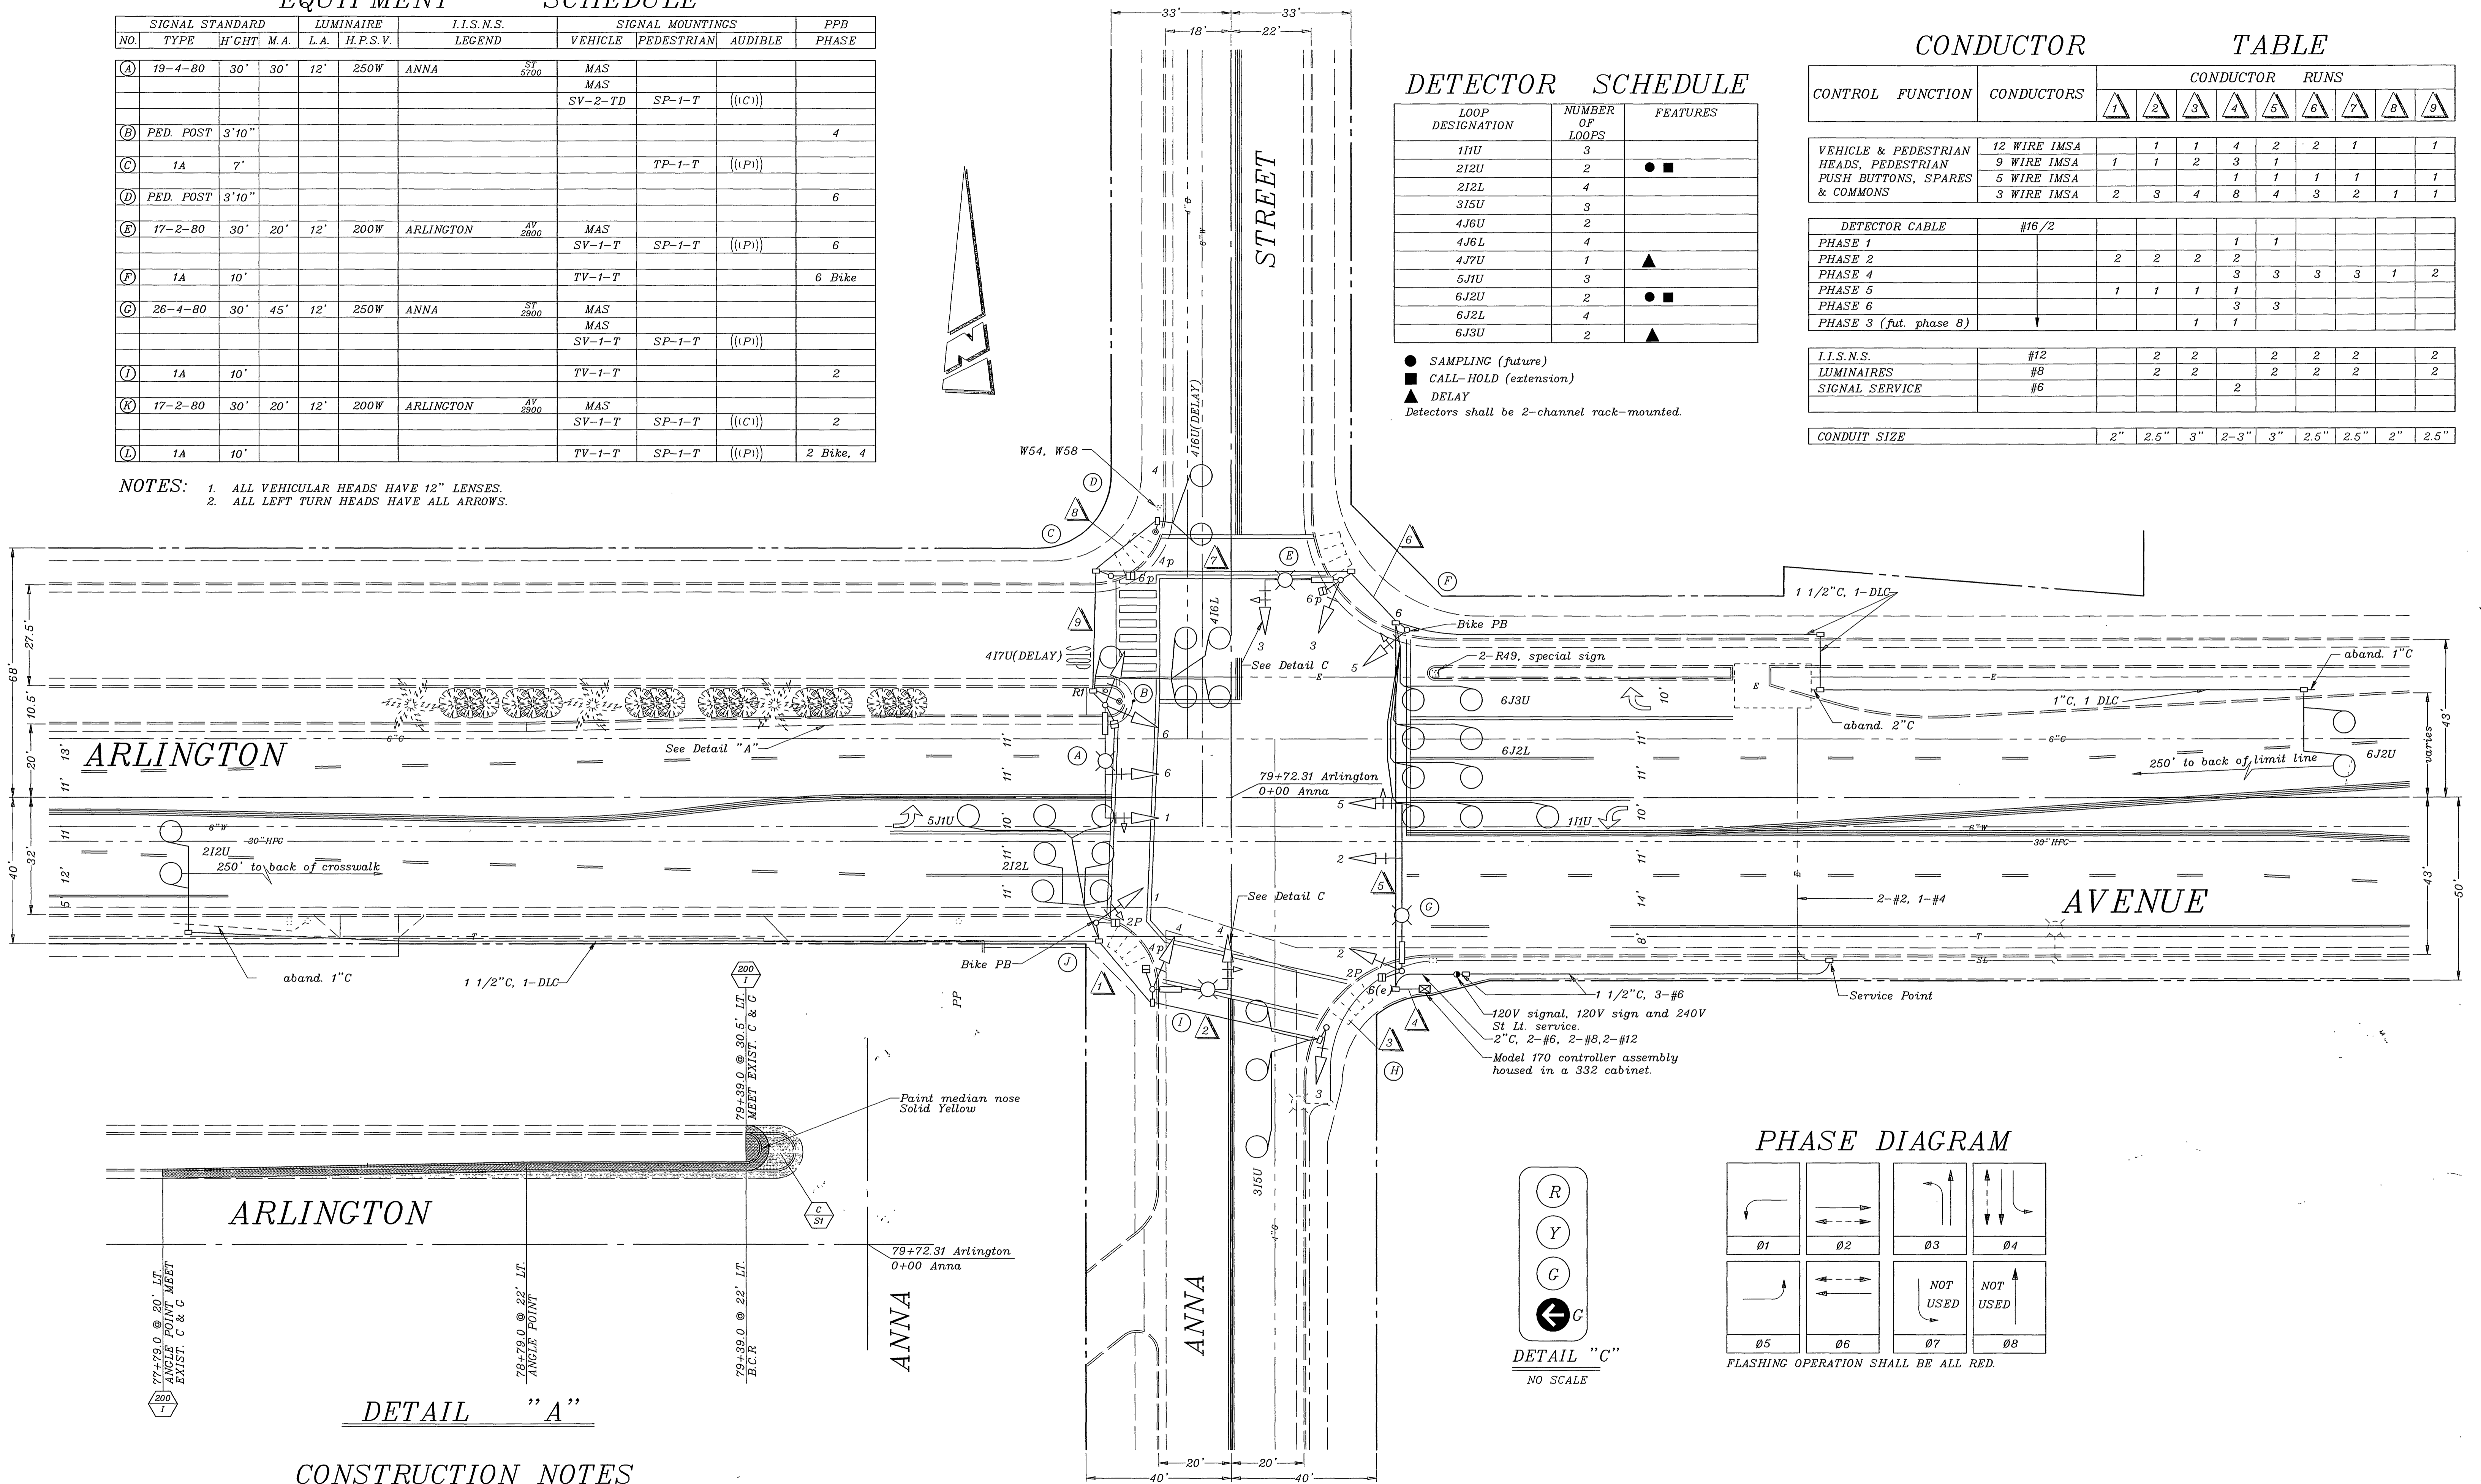

**PHASE DIAGRAM**

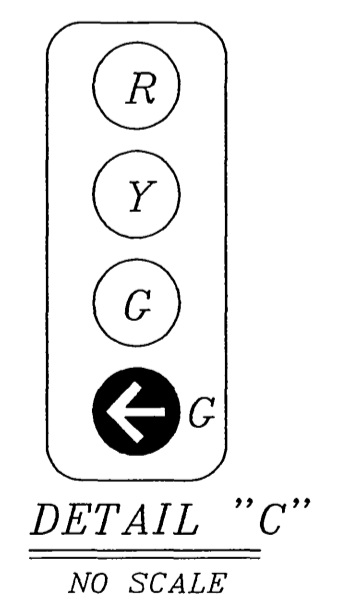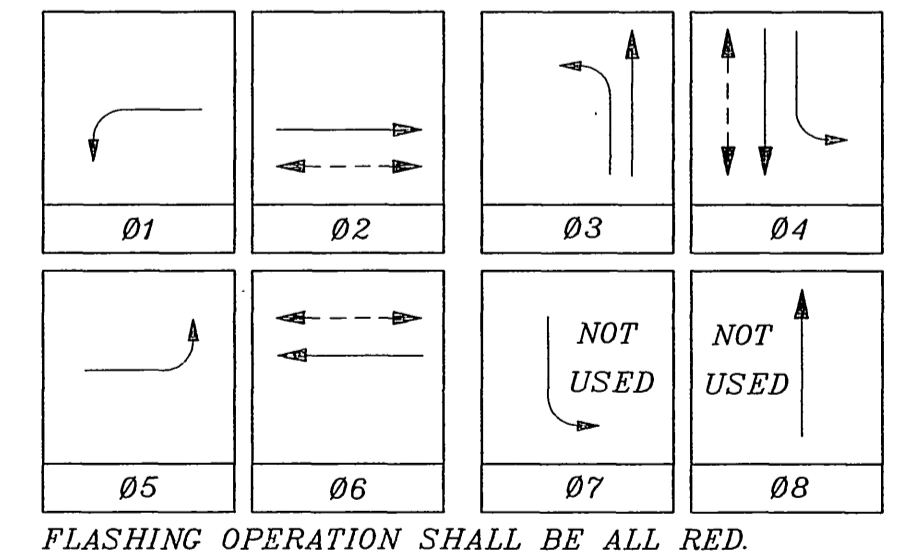

**CONSTRUCTION NOTES**

- Construct P.C.C. concrete curb (6") per City of Riverside Standard Drawing No. 200.
- Construct 1'-0" full depth A.C. pavement over compacted native soil: T1 = 10; R = 33.

**ENGINEER IN RESPONSIBLE CHARGE**  
  
 RICHARD D. McGRATH  
 R.C.E. No. 31952 expires 1996  
 DATE \_\_\_\_\_

CITY OF RIVERSIDE, CALIFORNIA  
 DEPARTMENT OF PUBLIC WORKS

APPROVED BY	BY	DATE	APPROVED BY
PRINCIPAL ENGINEER			DIRECTOR OF PUBLIC WORKS
P.W. INSPECTION			
TRAFFIC DIVISION			
CHIEF P.W. ENGR.			
PUBLIC UTILITIES			

AS-BUILT PER TE-95-1      MAC 1/96  
 REVISIONS      APPR. DATE

DESIGNED BY \_\_\_\_\_ DRAWN BY MAC CHECKED BY \_\_\_\_\_

TRAFFIC SIGNAL  
**ANNA STREET @ ARLINGTON AVENUE**  
 SCALE: 1" = 20'

ACCT. NO. X-471  
 SHEET 1 OF 1  
 FILE NAME: X471.DWG