


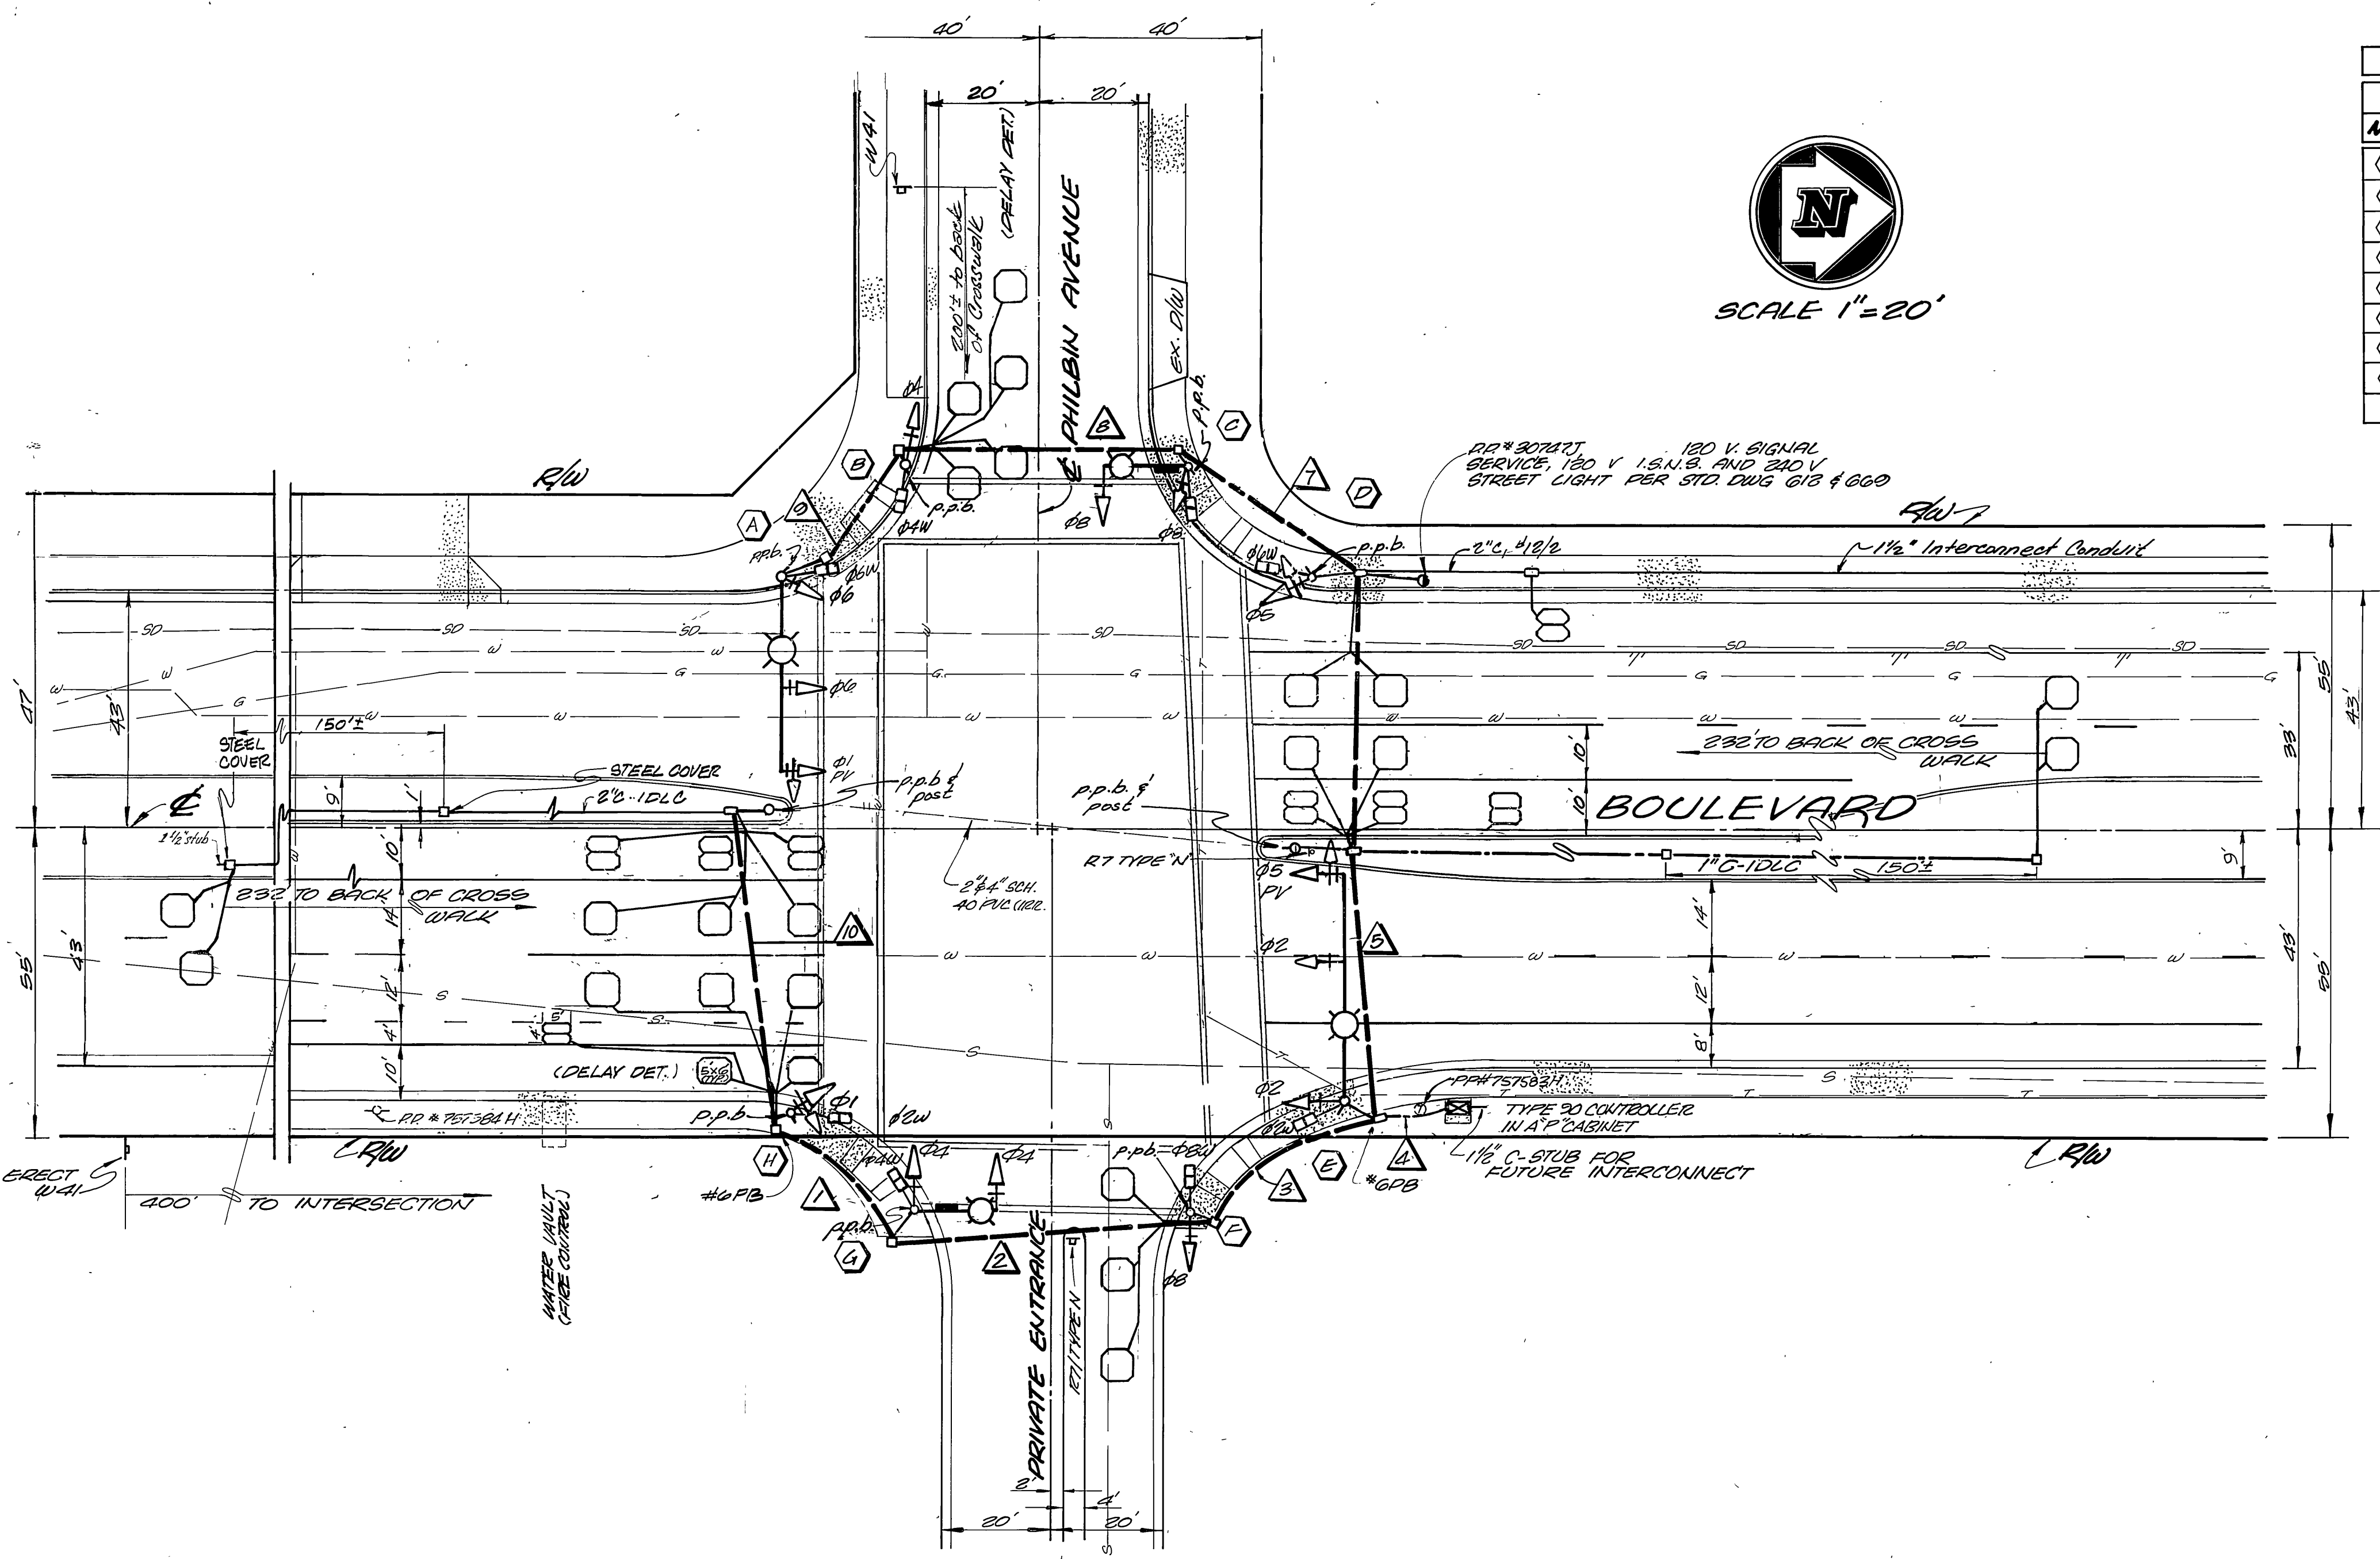


SCALE 1" = 20'



STANDARD		SCHEDULE										REMARKS	
No.	TYPE	HEIGHT	SIG.	MA.	LUMINAIRE	LUMINAIRE	I.S.N.S.	LEGEND	SIGNAL	MOUNTING	PDB		VEHICLE
A	2AA-4-70	35'	25'	15'	400W HPSV	Philbin 7300	Philbin 7300	MAS	MAS	SV-T	SR-T	4	MAS-ALL 12' LENSES, SV-T-ALL 8' LENSES
B	I-A	10'	-	-	-	-	-	-	-	TV-T	SR-T	4	ALL 8' LENSES
C	PA-2-70	35'	15'	15'	250W HPSV	Van Buren 7500	Van Buren 7500	MAS	-	SV-T	SR-T	4	MAS-ALL 12' LENSES, SV-T-ALL 8' LENSES
D	I-A	10'	-	-	-	-	-	-	-	TV-T	SR-T	4	12' GREEN ARROW, 8' YELLOW & RED LENSES
E	2AA-4-70	35'	40'	15'	400W HPSV	Philbin 7300	Philbin 7300	MAS	MAS	SV-T	SR-T	8	MAS-ALL 12' LENSES, SV-T-ALL 8' LENSES
F	I-A	10'	-	-	-	-	-	-	-	TV-T	SR-T	8	ALL 8' LENSES
G	PA-2-70	35'	15'	15'	250W HPSV	Van Buren 7500	Van Buren 7500	MAS	-	SV-T	SR-T	2	MAS-ALL 12' LENSES, SV-T-ALL 8' LENSES
H	I-A	10'	-	-	-	-	-	-	-	TV-T	SR-T	4	12' GREEN ARROW, 8' YELLOW & RED LENSES

NOTE: ALL TYPE I-A STANDARDS ARE ALUMINUM

AWG	CIRCUIT	SCHEDULE RUNS									
		1	2	3	4	5	6	7	8	9	10
TW #14	01	3	3	3	3	3	3	3	3	3	3
	02										
	04		3	3	3	3	3	3	3		
	05				3	3	3	3	3		
	06				3	3	3	3	3		
	08				3	3	3	3	3		
	02 PED	2	2	2	4	2	2	2	2		
	04 PED	2	2	2	4	2	2	2	2		
	06 PED	2	2	2	4	2	2	2	2		
	08 PED	2	2	2	4	2	2	2	2		
TW #8	01 DETECTOR				1	1					
	02 (Veh. & Bike)	5	5	5	5	5	5	5			
	04	2	2	2	2	2	2	2			
	06 (Veh. & Bike)	1	1	1	1	1	1	1			
TW #10	01 DETECTOR				1	1					
	02 (Veh. & Bike)	5	5	5	5	5	5	5			
	04	2	2	2	2	2	2	2			
TOTAL		10	10	10	60	60	24	18	12	4	
PPB COMMON		1	1	1	1	1	1	1	1	1	
I.S.N.S.		2	2	2	2	2	2	2	2	2	
TOTAL		1	3	3	2	2	3	3	3	3	
CONDUIT SIZE		2 1/2"	3"	3"	2 1/2"	3 1/2"	3"	2 1/2"	2"	2 1/2"	

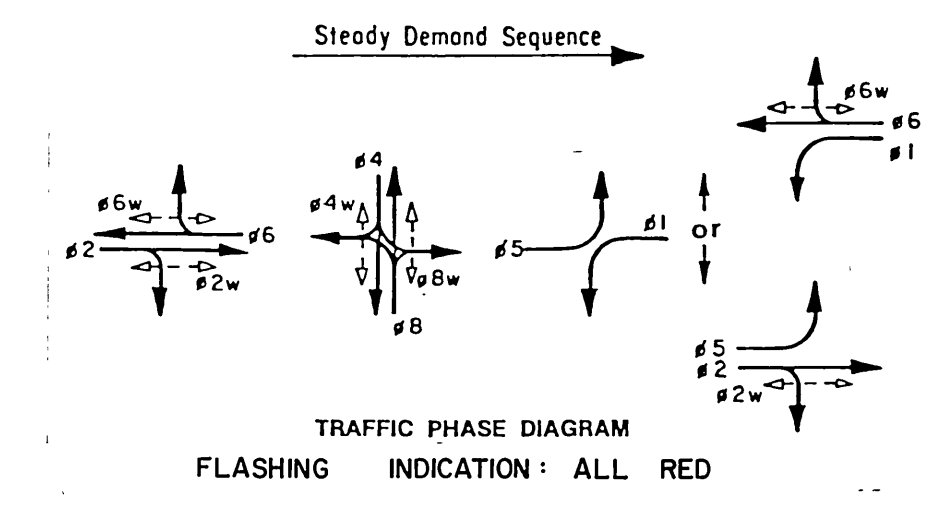

**CG ENGINEERING**  
Consultants to Government  
307 SO. WATERMAN AVE., SUITE F, SAN BERNARDINO, CA 92408  
LAURENCE S. EISENBERG, P.E. R.C.E. 2402

CITY OF RIVERSIDE, CALIFORNIA PUBLIC WORKS DEPARTMENT		TRAFFIC SIGNALS VAN BUREN BLVD. AT PHILBIN AVENUE		ACCOUNT No. DRAWING NUMBER <b>X-474</b> SHEET OF
AS-BUILT SW (12-2817) AS-BUILT SW (12-2144) AS-BUILT FOR VAN BUREN WIDENING (12-1855) AS-BUILT FOR SIGNALIZATION	MRC 1/2/87 MRC 1/2/87 MRC 9/2/87 MRC 1/2/88	APPROVED BY PRINCIPAL ENGINEER PARK DEPARTMENT TRAFFIC DIVISION CHIEF PUB. WKS. ENGR.	APPROVED BY DIRECTOR OF PUBLIC WORKS DATE 11/24/82	SCALE: 1" = 20'
DESIGNED BY C.B.E. DRAWN BY C.R. CHECKED BY C.B.E.				