
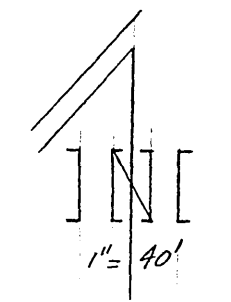
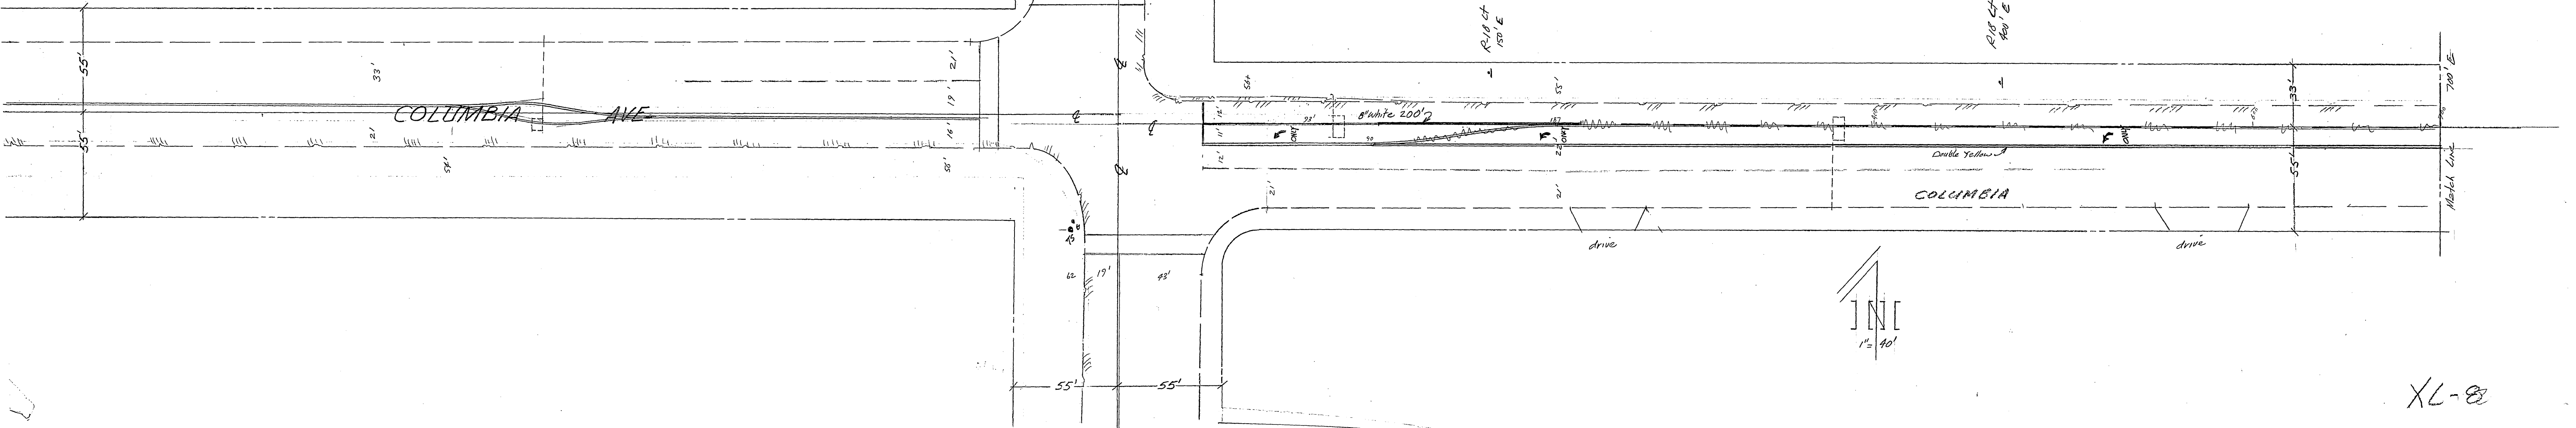


This corner to be Revised (WN# 75-P-51 & 75-P-52)

IOWA AVE

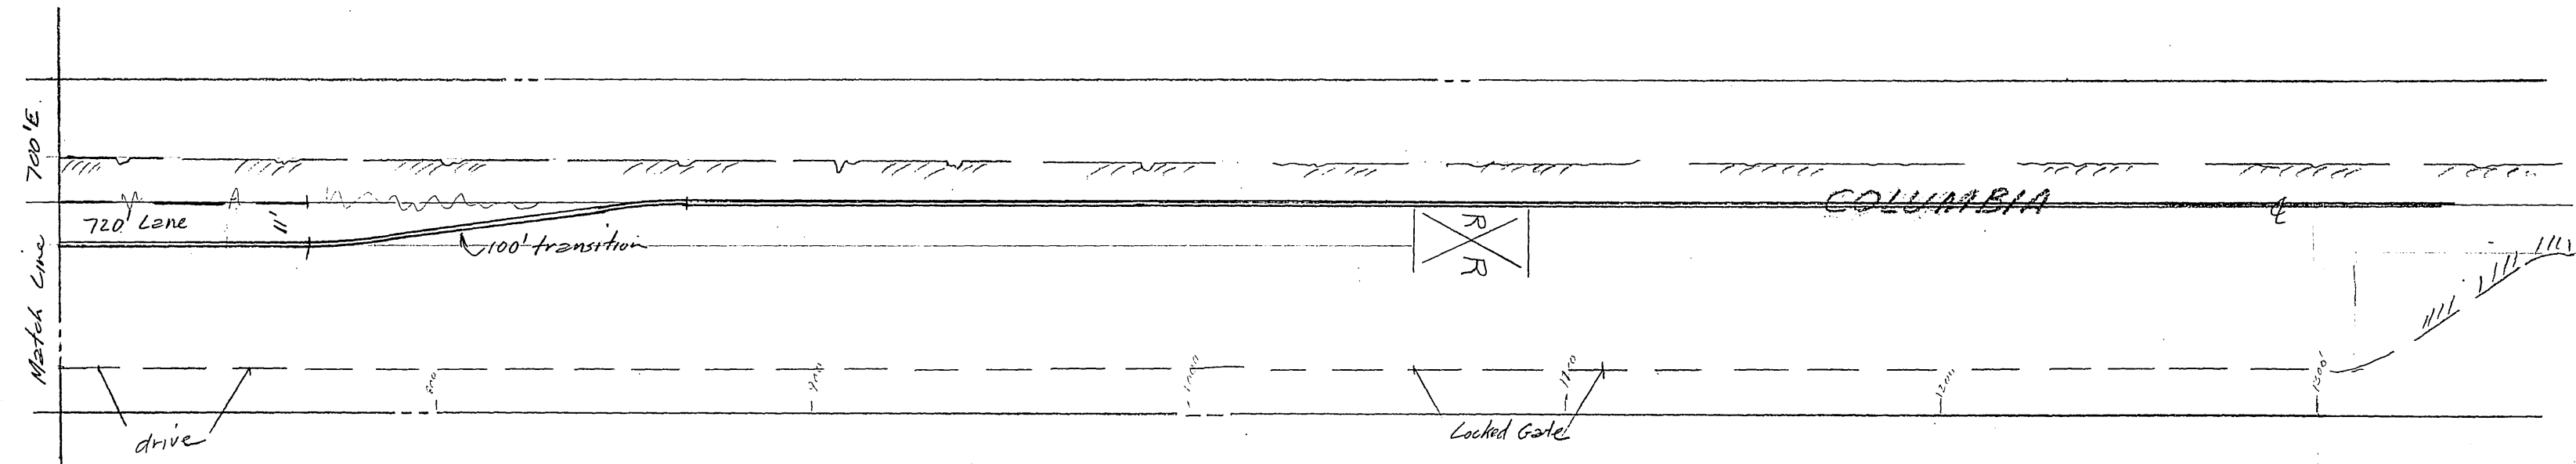

XL-8