
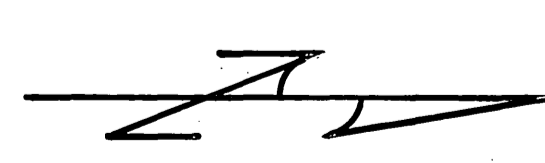


THIRD STREET
XL-116

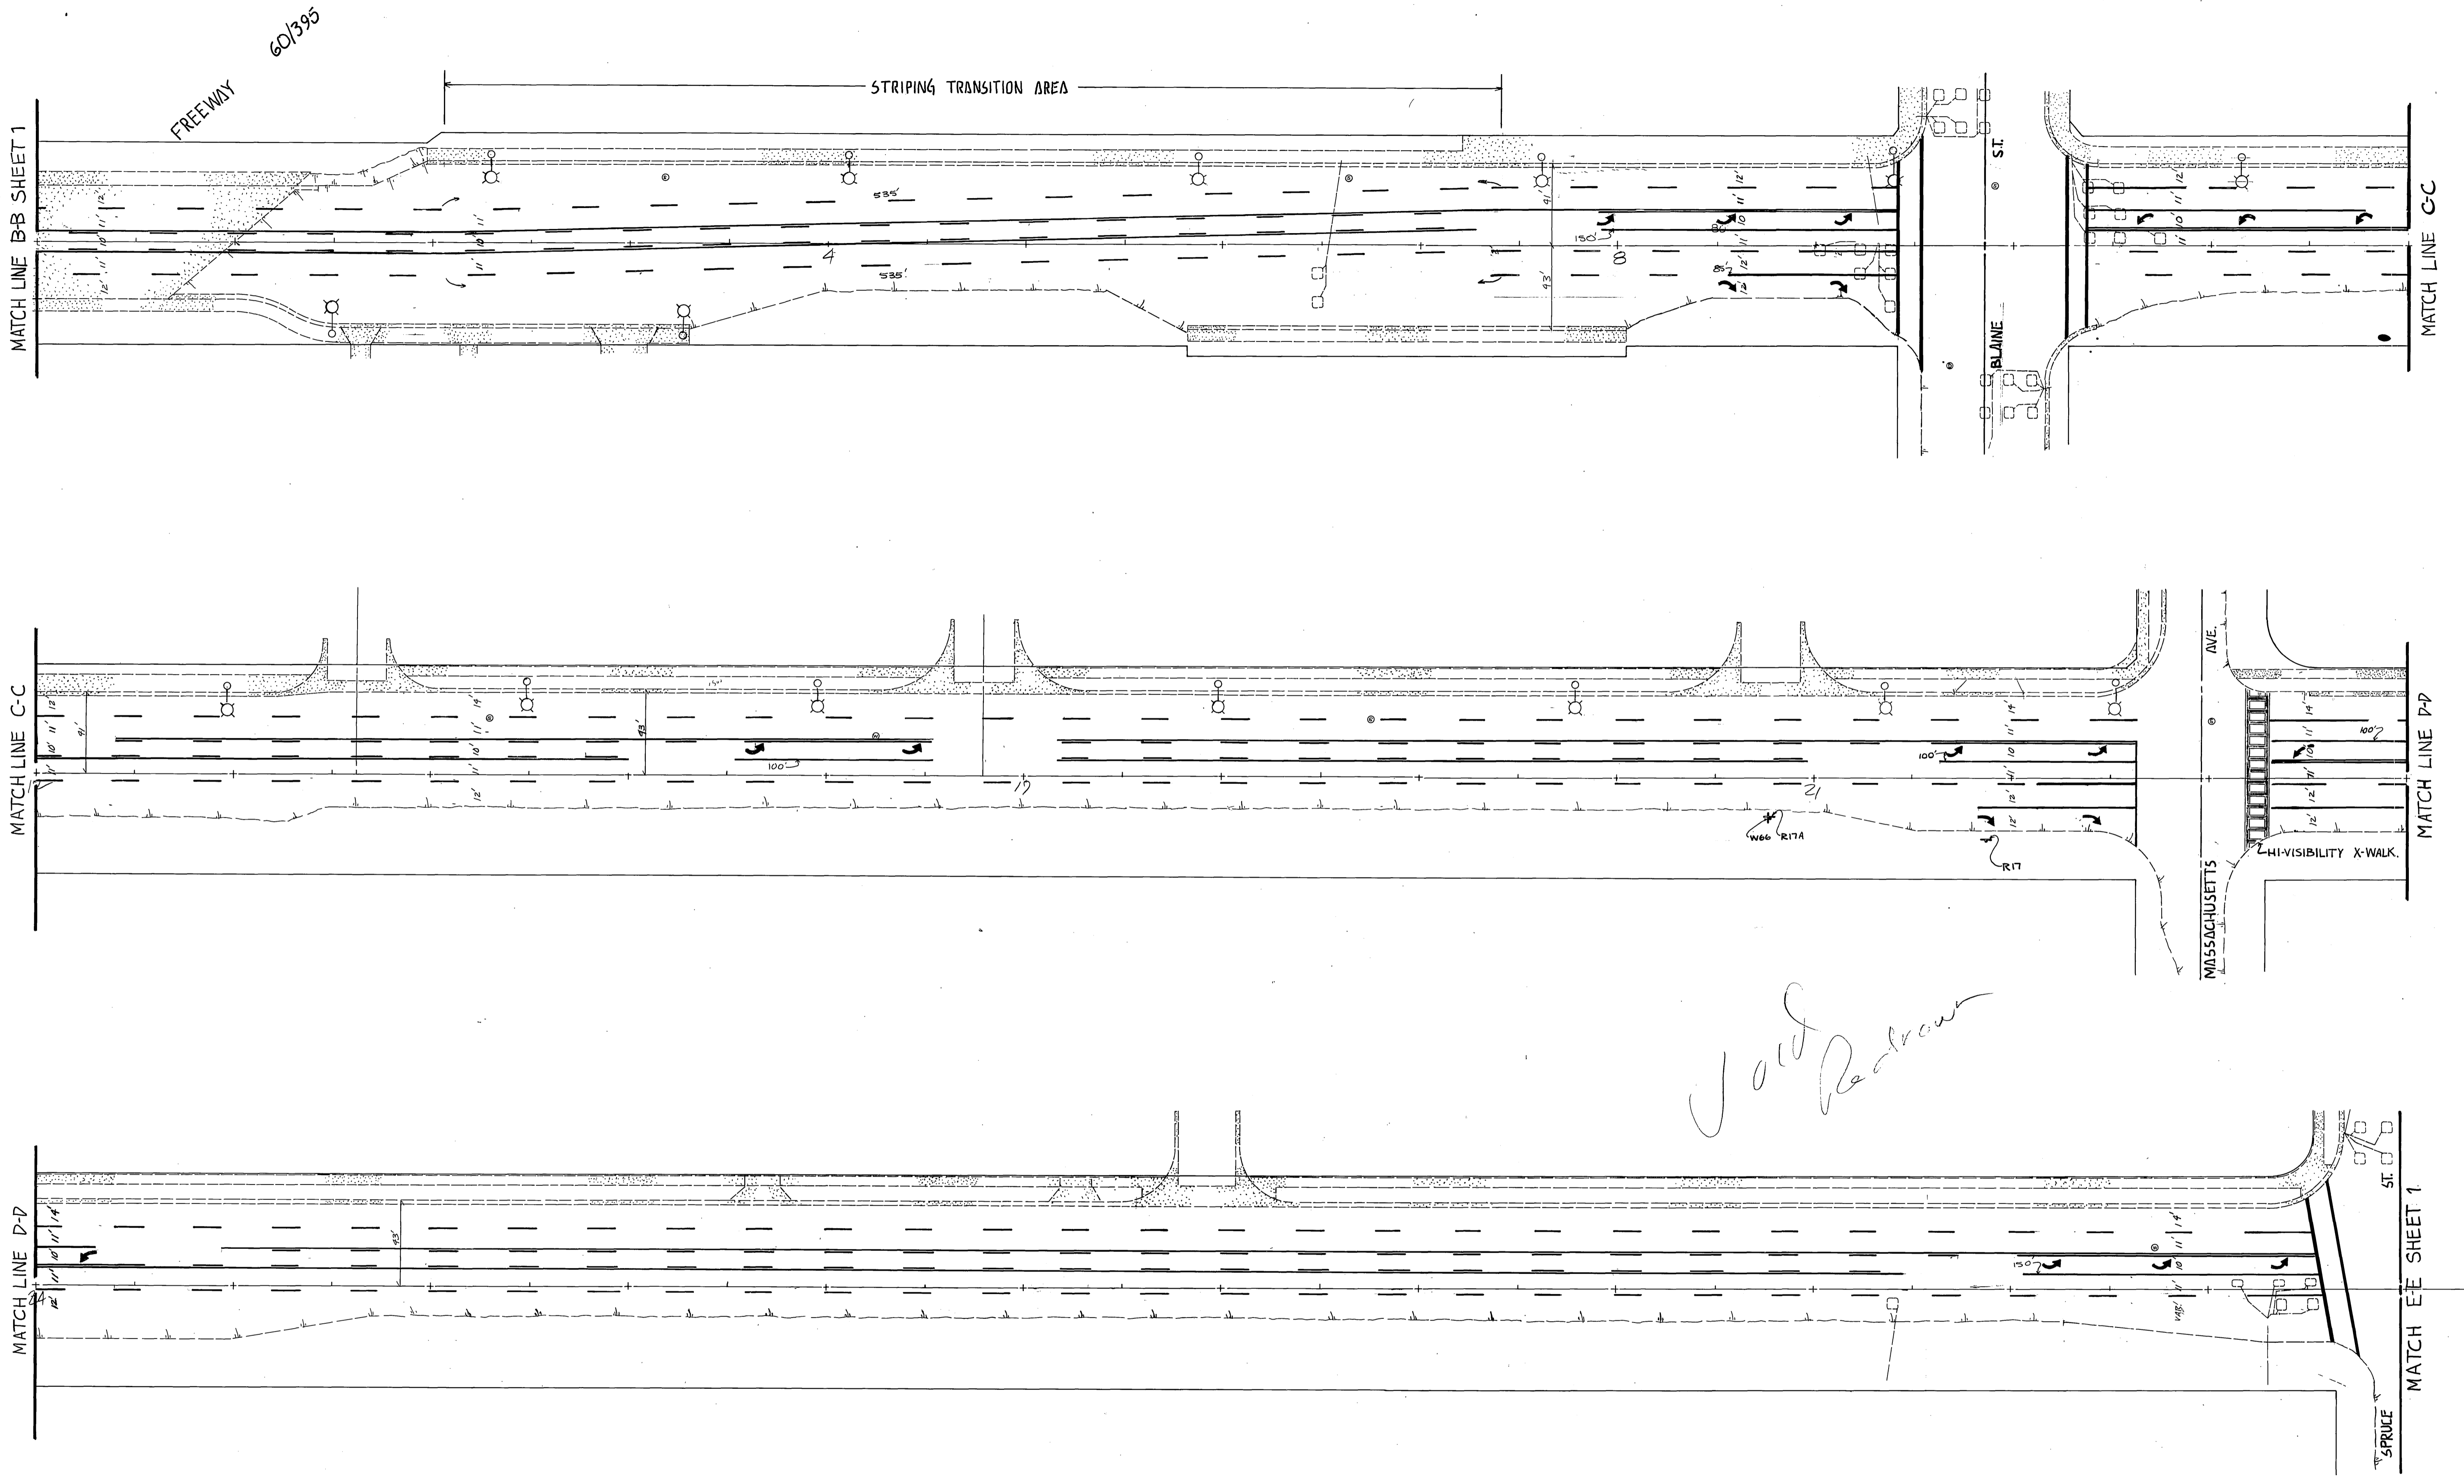

VOID REVISION

		CITY OF RIVERSIDE		STRIPING PLAN		ACCOUNT NO. 30-575-377-09	
		PUBLIC WORKS DEPARTMENT		IOWA AVE.		XL-118	
		APPROVED BY	DATE	BY	APPROVED BY	UNIVERSITY AVE. TO SPRUCE ST.	
		PRINCIPAL ENGINEER			PUBLIC WORKS DIRECTOR		
		MARK	REVISIONS	APPR. DATE	DATE	HORIZ. SCALE: 1" = 40' VERT. SCALE: 1" =	
		DESIGNED BY	DRAWN BY G.V.	CHECKED BY			
				CHIEF P.W. ENGINEER			

Co/9/82