

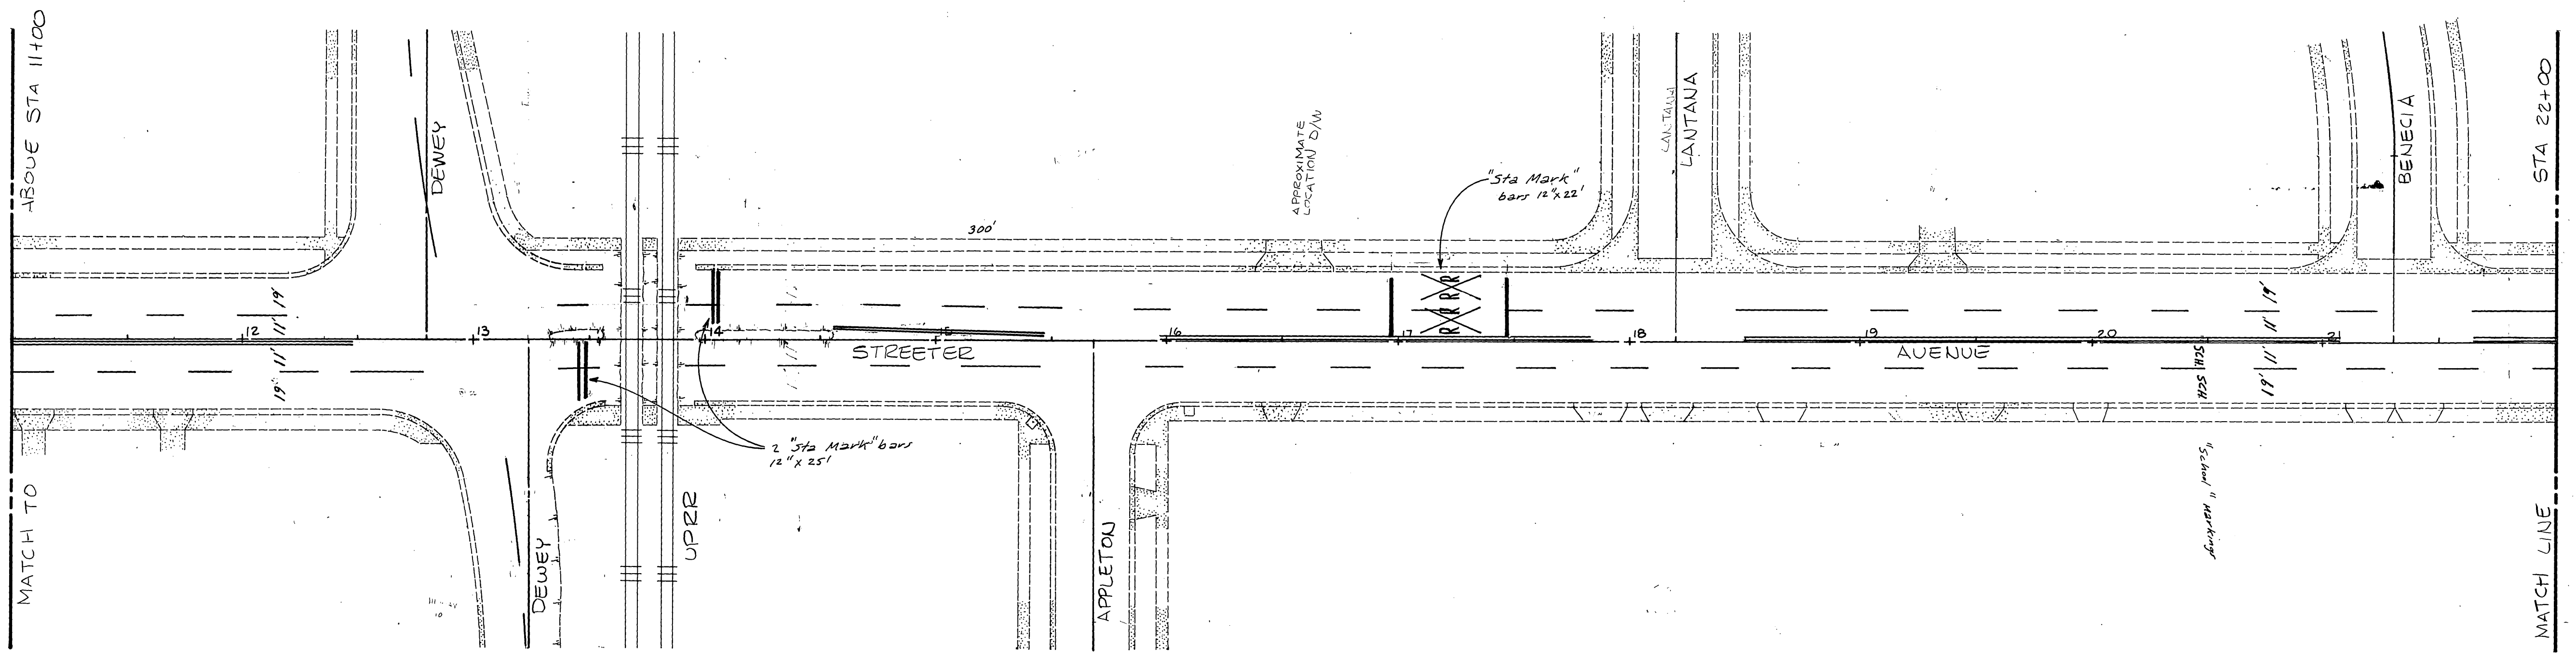


Loop etc

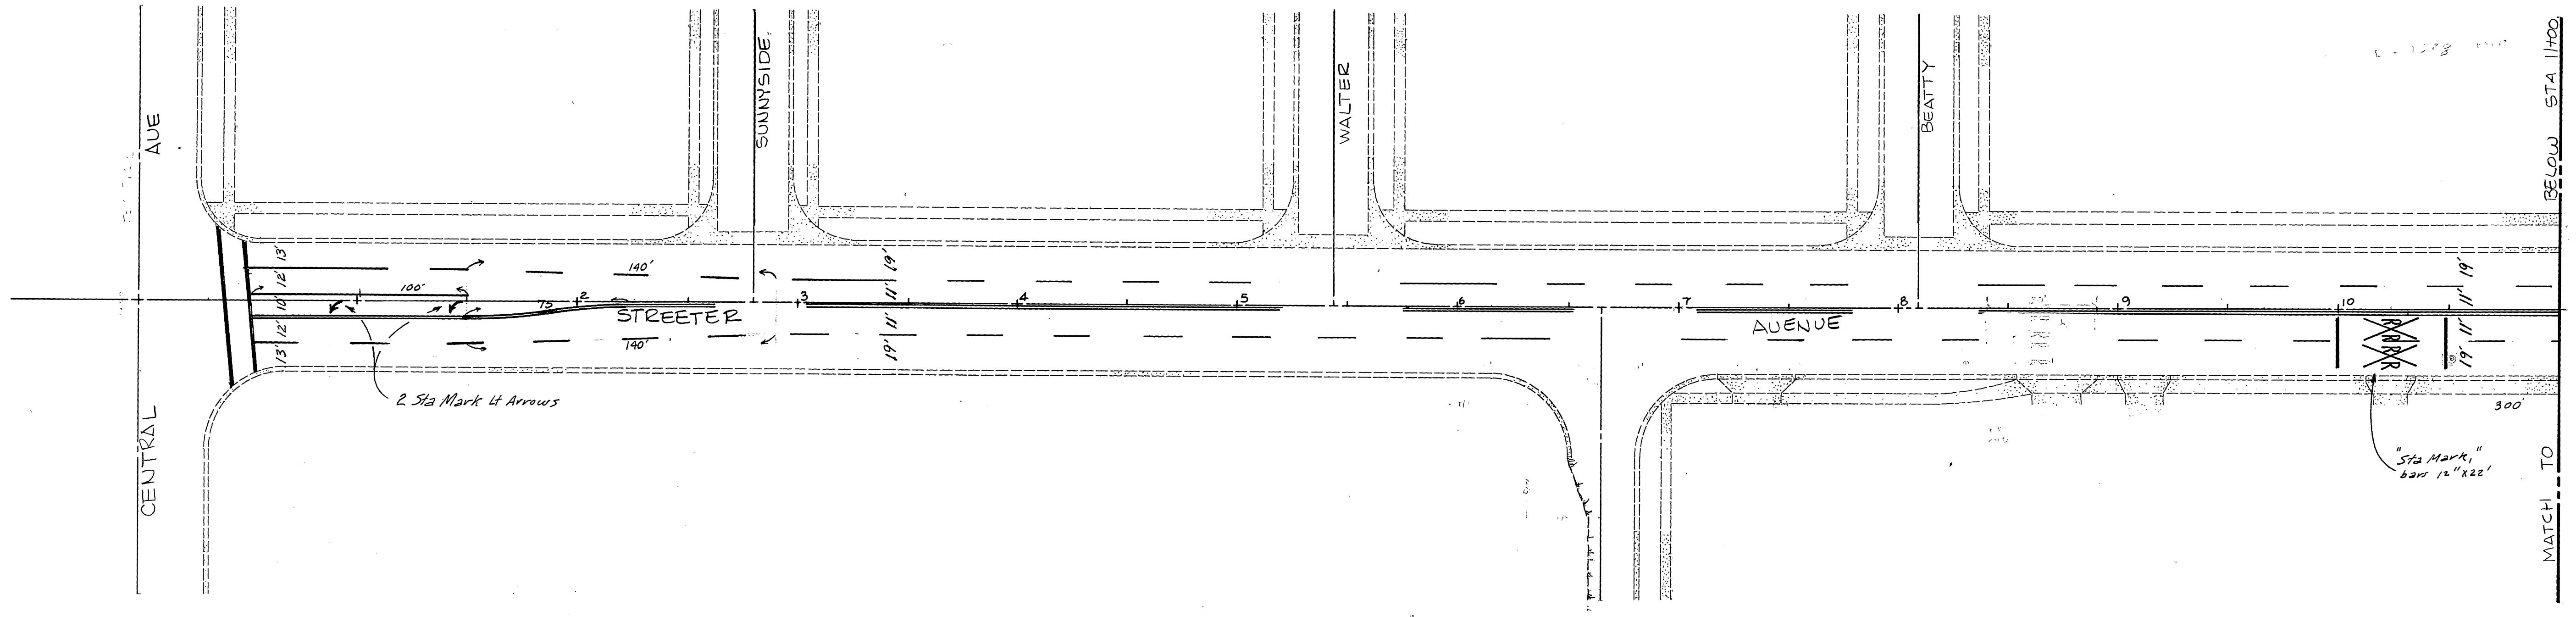

DESIGNED BY <i>D.Roy</i> DRAWN BY <i>G.J.</i> CHECKED BY <i>D.Roy</i>		<b>CITY OF RIVERSIDE</b> <b>PUBLIC WORKS DEPARTMENT</b>		ACCOUNT NO. 30-575-377-09	
REVISIONS: <i>Add Sta Mark RR Markings 1/2/02</i>		APPROVED BY: <i>[Signature]</i> DATE: <i>12/2/02</i>		STRIPING PLAN <b>STREETER AVE.</b> CENTRAL TO MOUNTAIN VIEW	
APPR. DATE: <i>12/2/02</i>		APPROVED BY: <i>[Signature]</i> DATE: <i>12/2/02</i>		XL-120 SHEET 1 OF 2	
HORIZ. SCALE: 1" = 40'		VERT. SCALE: 1" = 40'		12/2/02	

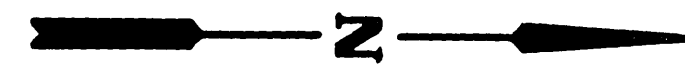