



STRIPING LEGEND

- INDICATES EXISTING STRIPING & PAVEMENT MARKINGS TO BE REMOVE.
- INDICATES EXISTING STRIPING & PAVEMENT MARKINGS TO REMAIN.
- INDICATES NEW STRIPING & PAVEMENT MARKINGS TO BE INSTALLED.
- INDICATES STENCIL INSTALLATION OF BIKE LANE W/ ARROW.
- INDICATES STENCIL INSTALLATION OF BIKE SYMBOL.

- STRIPING NOTES:**
1. BARRIER STRIPES (TURNING LANES) ARE 8" WHITE.
 2. BIKE LANE IS 6" WHITE.
 3. THIS PLAN ACCURATE FOR STRIPING AND MARKING ONLY.
 4. SEE TRAFFIC SIGNAL PLANS FOR INTERSECTION DETAILS.

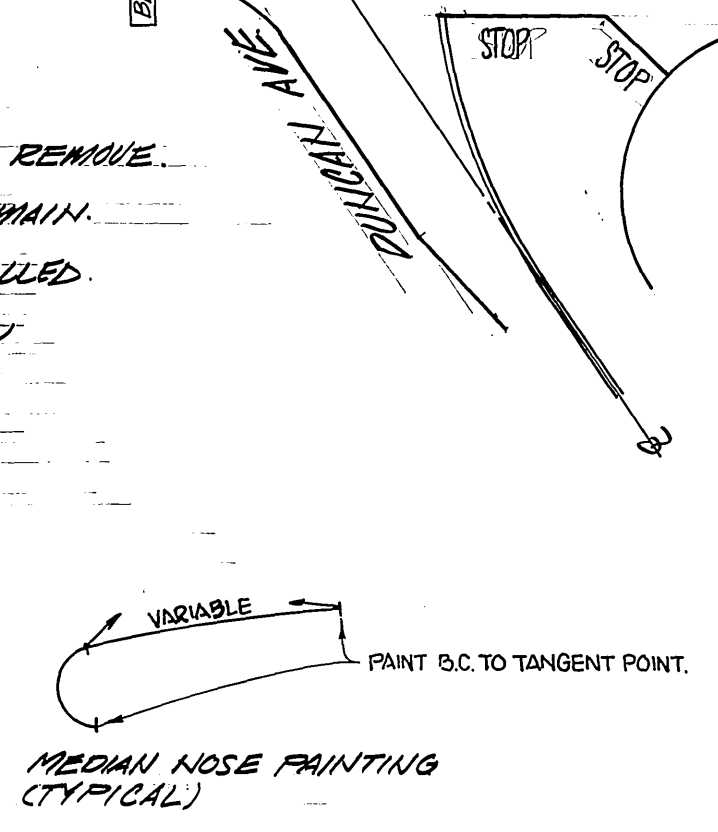

CITY OF RIVERSIDE PUBLIC WORKS DEPARTMENT		VAN BUREN BLVD. RECONSTRUCTION CALIFORNIA TO CYPRESS/JACKSON STRIPING PLAN		M-MG-R093 (2) ACCOUNT NO. 30-515-952-06 XL-202 SHEET 1 OF 2
APPROVED BY PRINCIPAL ENGINEER PARK DEPARTMENT TRAFFIC DIVISION CHIEF P. W. ENGINEER	DATE 6/17/83 BY [Signature]	APPROVED BY PUBLIC WORKS DIRECTOR	DATE 6/17/83	HORIZ. SCALE: 1" = 40' VERT. SCALE: 1" =
DESIGNED BY [Signature] DRAWN BY [Signature] CHECKED BY [Signature]				

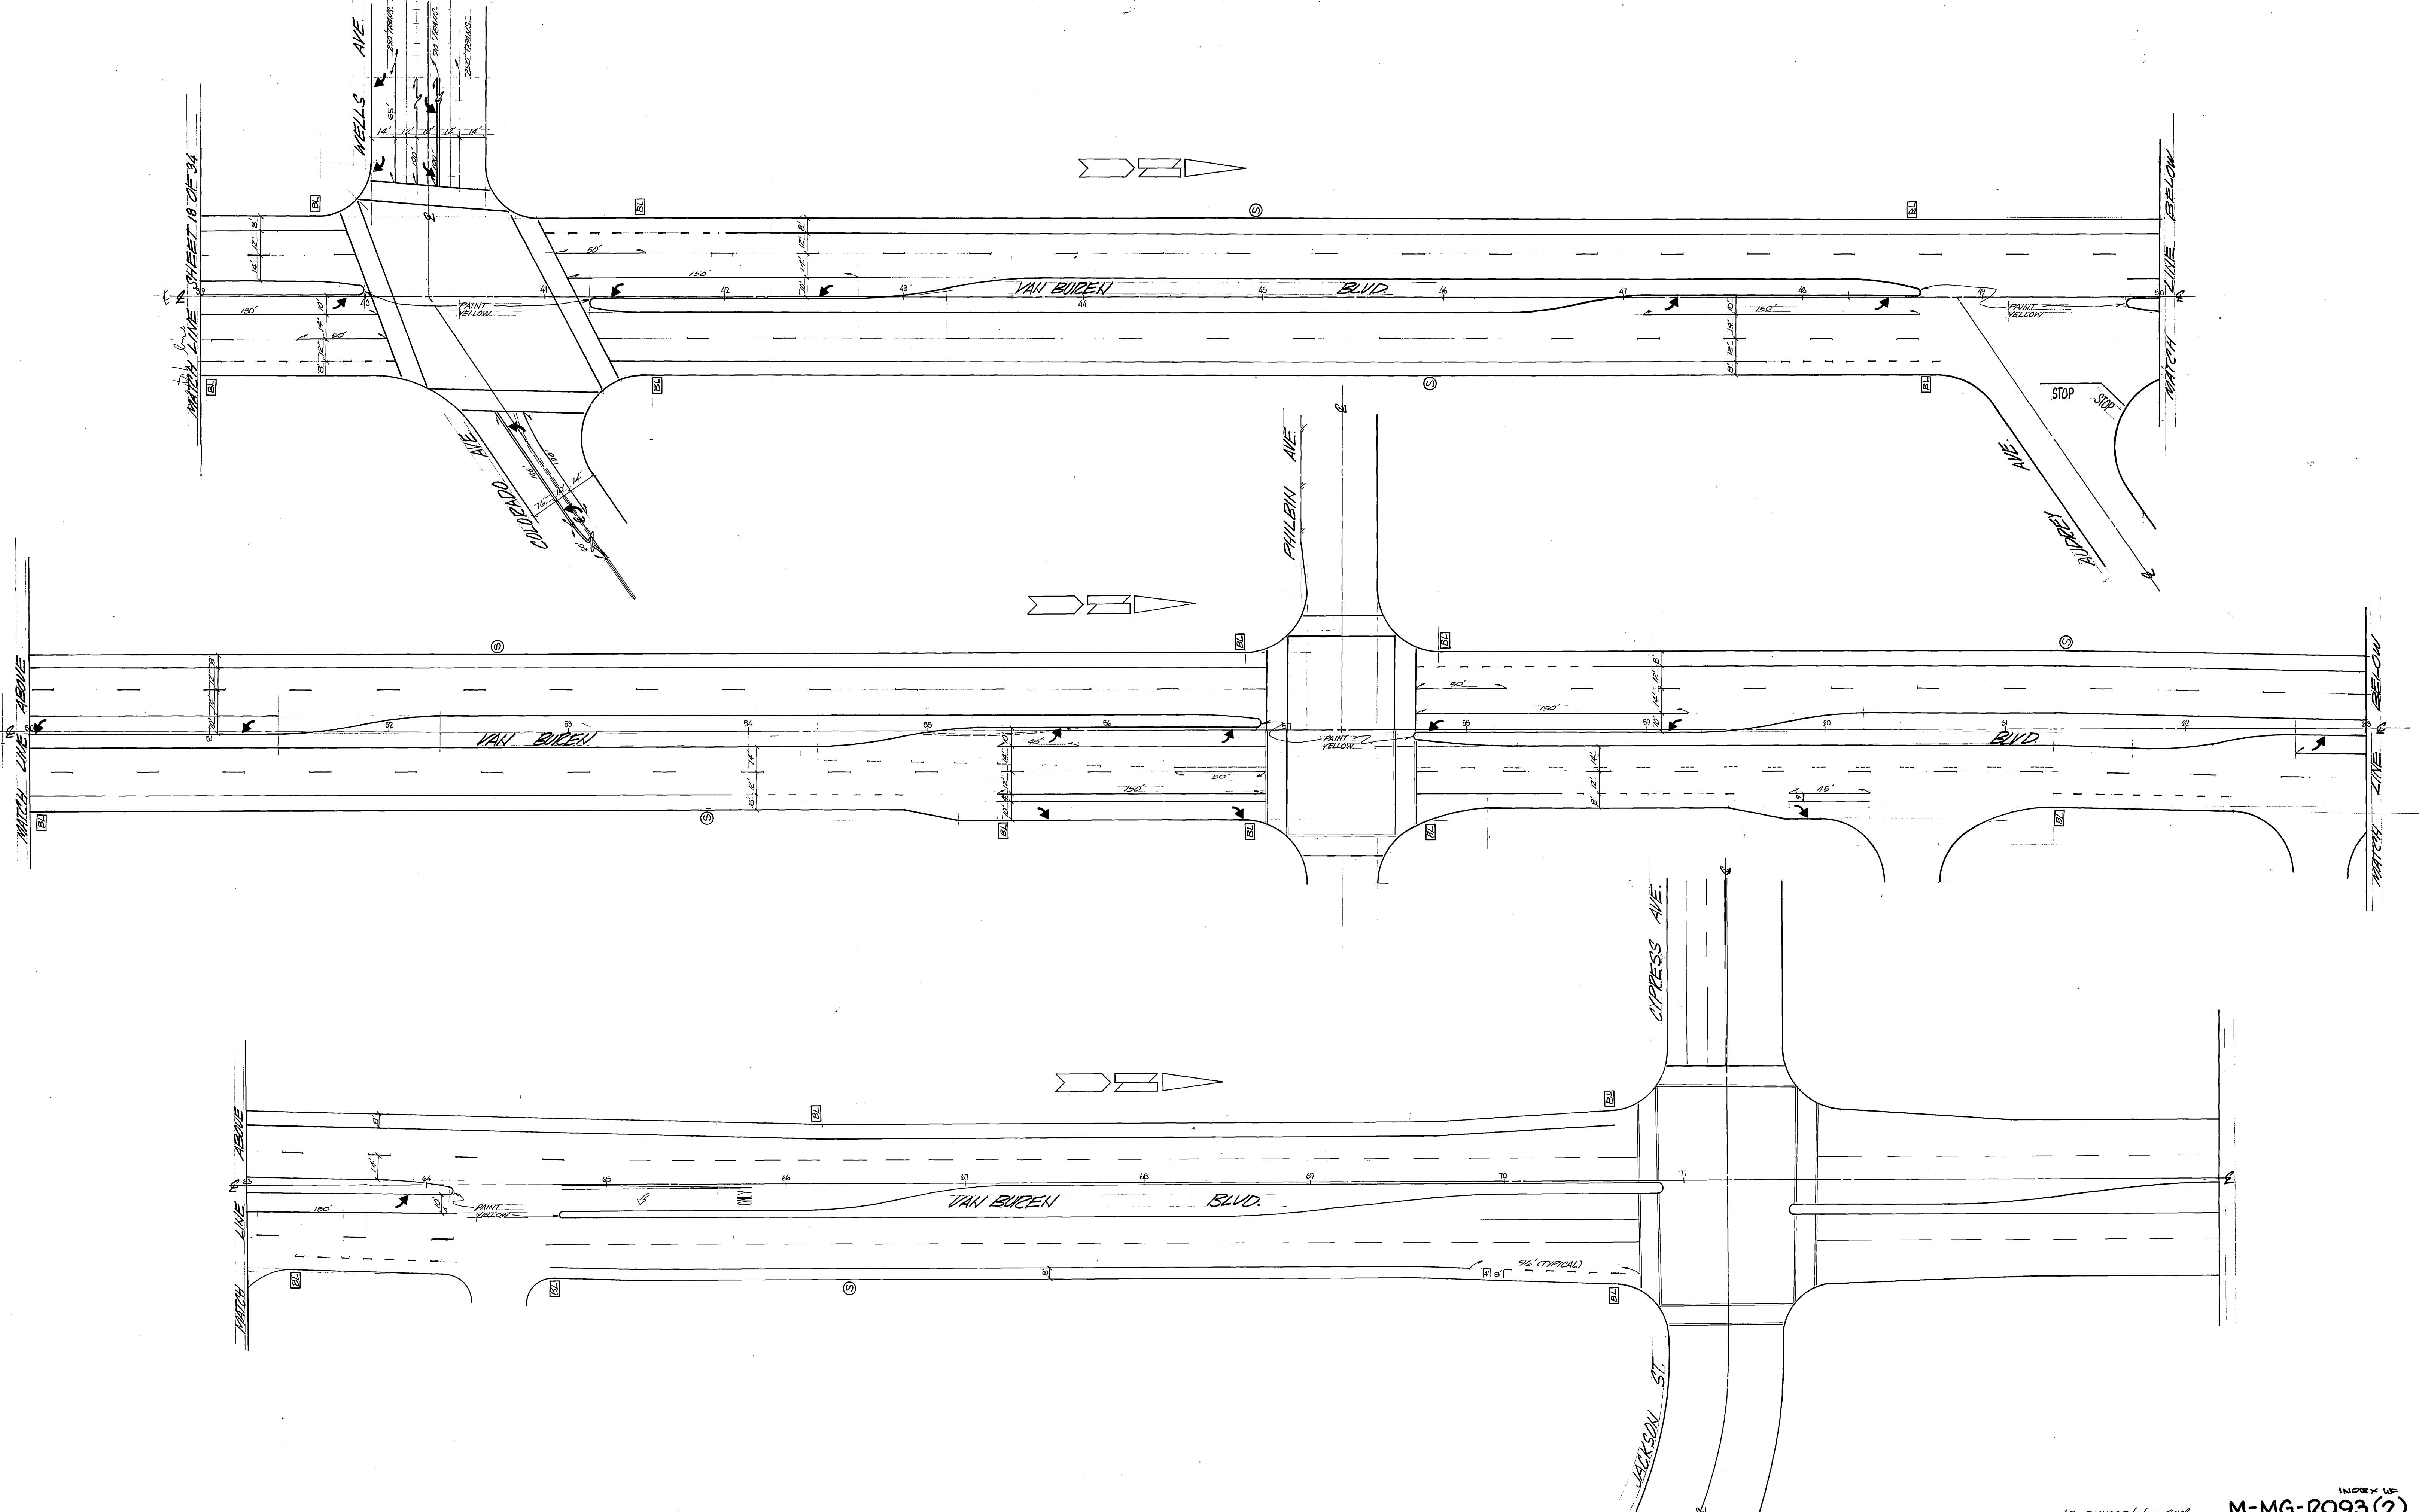

MARK	REVISIONS	APPR.	DATE

CITY OF RIVERSIDE
PUBLIC WORKS DEPARTMENT

APPROVED BY: *[Signature]* DATE: 6/17/83
 PRINCIPAL ENGINEER
 PARK DEPARTMENT
 TRAFFIC DIVISION
 CHIEF P. W. ENGINEER

DESIGNED BY: *[Signature]* DRAWN BY: *[Signature]* CHECKED BY: *[Signature]*

VAN BUREN BLVD.
RECONSTRUCTION
 CALIFORNIA TO CYPRESS/JACKSON
STRIPING PLAN

AS BUILT 2/15/85 RDM

DATE: 6/17/83

HORIZ. SCALE: 1" = 40' VERT. SCALE: 1" =

INDEX UP

M-MG-R093 (2)

ACCOUNT NO. 30-570-352-06

XL-202

SHEET 2 OF 2