


**STRIPING & MARKING LEGEND**

- (1) 4" SOLID DOUBLE YELLOW STRIPE
- (6) 4" SOLID WHITE STRIPE
- (7) 4" SKIP WHITE STRIPE (7' STRIPE, 17' GAP)
- (11) 8" SOLID WHITE STRIPE
- (13) 12" SOLID WHITE MARKING
- (19) WHITE "PED. XING" MARKING
- (28) WHITE "R X R" MARKING
- (24) WHITE "STOP" MARKING
- (28) WHITE HIGH VISIBILITY CROSSWALK
- (33) 4" SOLID YELLOW STRIPE
- (34) WHITE "YIELD" MARKING
- (16) WHITE "AHEAD" MARKING

<b>CITY OF RIVERSIDE</b>		<b>REHABILITATION OF MAJOR CITY STREETS 1990-1991</b>		ACCOUNT NO. 39-575-329-15
<b>PUBLIC WORKS DEPARTMENT</b>		<b>MADISON STREET VICTORIA TO INDIANA</b>		<b>XL-282</b>
APPROVED BY	DATE	BY	APPROVED BY	 PUBLIC WORKS DIRECTOR
DEPUTY P. W. ENGINEER	2/1/92	J.M.C.	DATE	
PRINCIPAL ENGINEER	2/1/92	J.M.C.	DATE	
SURVEYOR	2/1/92	J.M.C.	DATE	
MARK	REVISIONS	APPR.	DATE	DATE
DESIGNED BY J.R.C. DRAWN BY L.F.H./R.M. CHECKED BY		TRAFFIC DIVISION		DATE 2/7/92
STREET SERVICES			HORIZ. SCALE: 1" = 40' VERT. SCALE: 1" =	

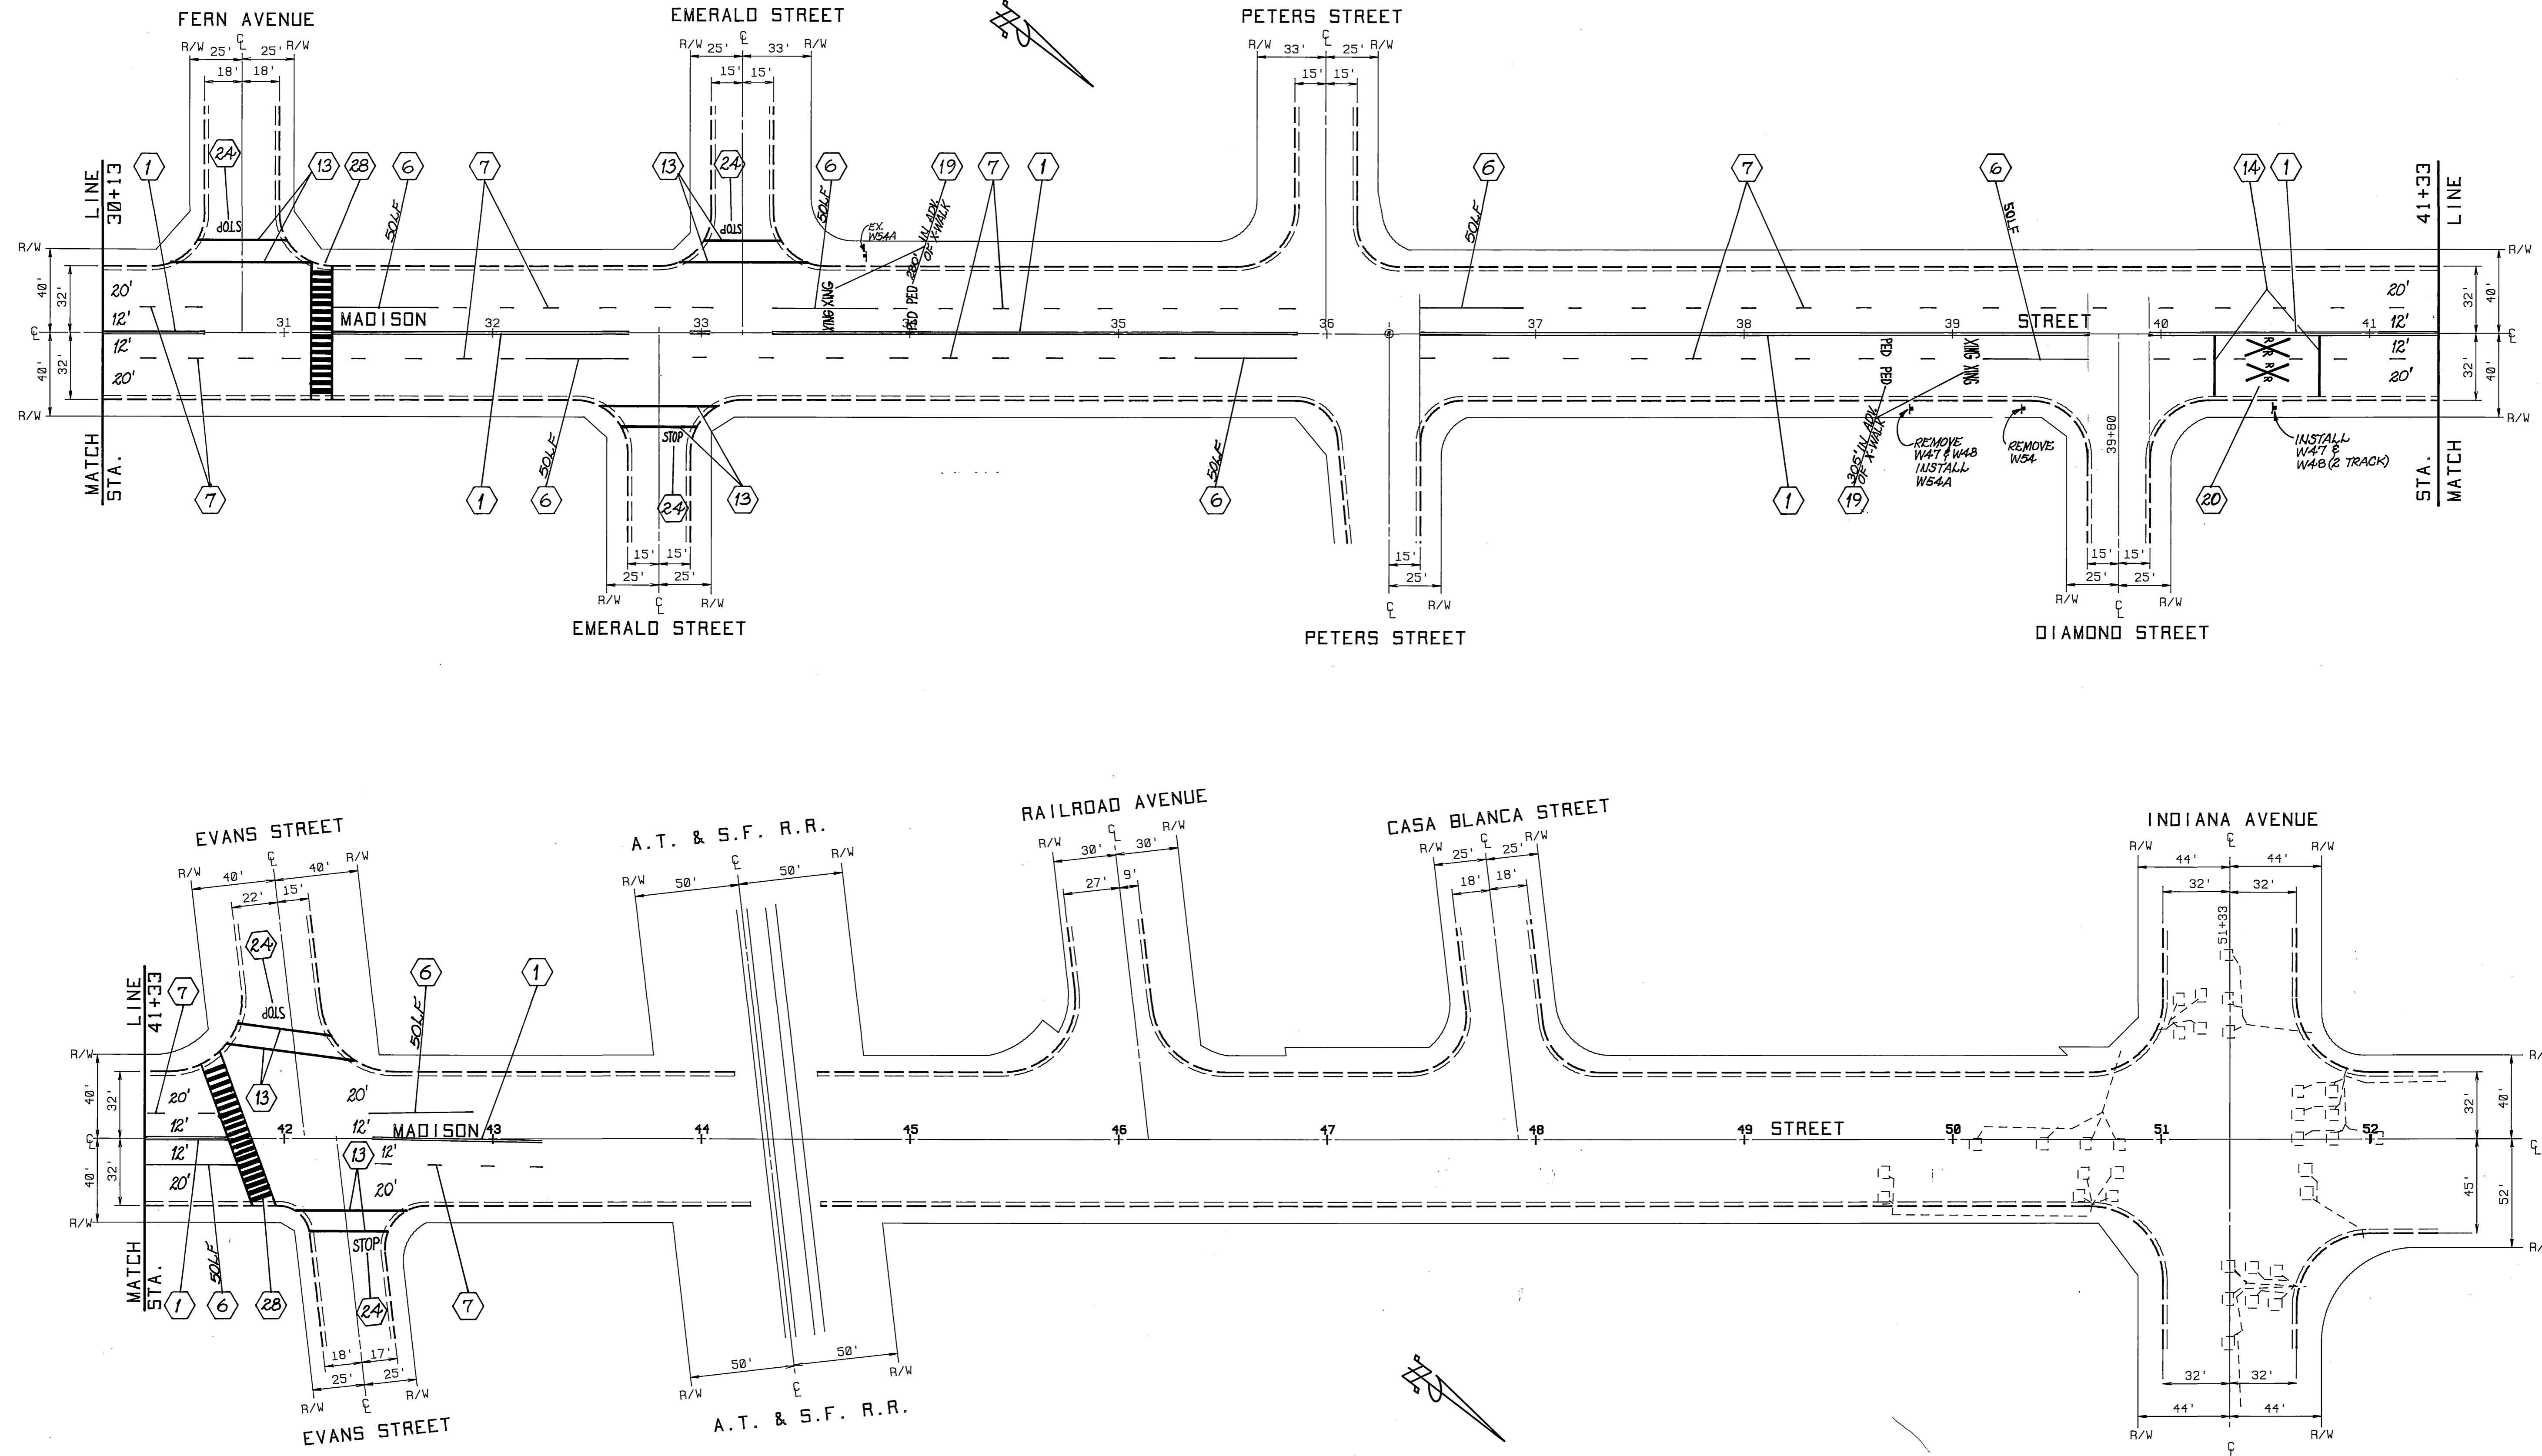

		<b>CITY OF RIVERSIDE</b>		<b>REHABILITATION OF MAJOR</b>		ACCOUNT NO. 38-575-929-15	
		<b>PUBLIC WORKS DEPARTMENT</b>		<b>CITY STREETS 1990-1991</b>		<b>XL-282</b>	
		APPROVED BY	DATE	BY	APPROVED BY		
		DEPUTY P.W. ENGINEER	2/19/92	DB	PUBLIC WORKS DIRECTOR		
		PRINCIPAL ENGINEER	4/5/92	DB			
		SURVEYOR					
		CHIEF P.W. INSPECTOR					
		TRAFFIC DIVISION	1/29/92	DB			
		STREET SERVICES					
MARK	REVISIONS	APPR. DATE	DATE		2/27/92		
DESIGNED BY	T.R.C.	DRAWN BY	LEH.R.W.	CHECKED BY			
						HORIZ. SCALE: 1" = 40'	
						VERT. SCALE: 1" =	
						SHEET 2 OF 2	