


- STRIPING & MARKING LEGEND
- (A) 4" WHITE LANELINE PER STATE OF CALIF., DEPT. OF TRANSPORTATION - DETAIL 8.
  - (B) 4" SOLID WHITE LANELINE (50 L.F.)
  - (C) 4" DOUBLE YELLOW CENTERLINE PER STATE OF CALIF., DEPT. OF TRANSPORTATION - DETAIL 21.
  - (D) 8" SOLID WHITE CHANNELIZING LINE PER STATE OF CALIF., DEPT. OF TRANSPORTATION - DETAIL 38A.
  - (E) 6" WHITE BIKE LANE LINE PER STATE OF CALIF., DEPT. OF TRANSPORTATION - DETAIL 39.
  - (F) 12' SOLID WHITE MARKING.
  - (G) SOLID WHITE "BIKE, LANE, →" MARKINGS.
  - (H) SOLID WHITE TYPE IV ARROW.
  - (J) SOLID WHITE TYPE V ARROW.
  - (K) SOLID WHITE TYPE I ARROW (24').
  - (L) TYPE "A" NON-REFLECTIVE MARKERS - LANE LINE EXTENSION THROUGH INTERSECTION PER STATE OF CALIF., DEPT. OF TRANSPORTATION - DETAIL 40A.

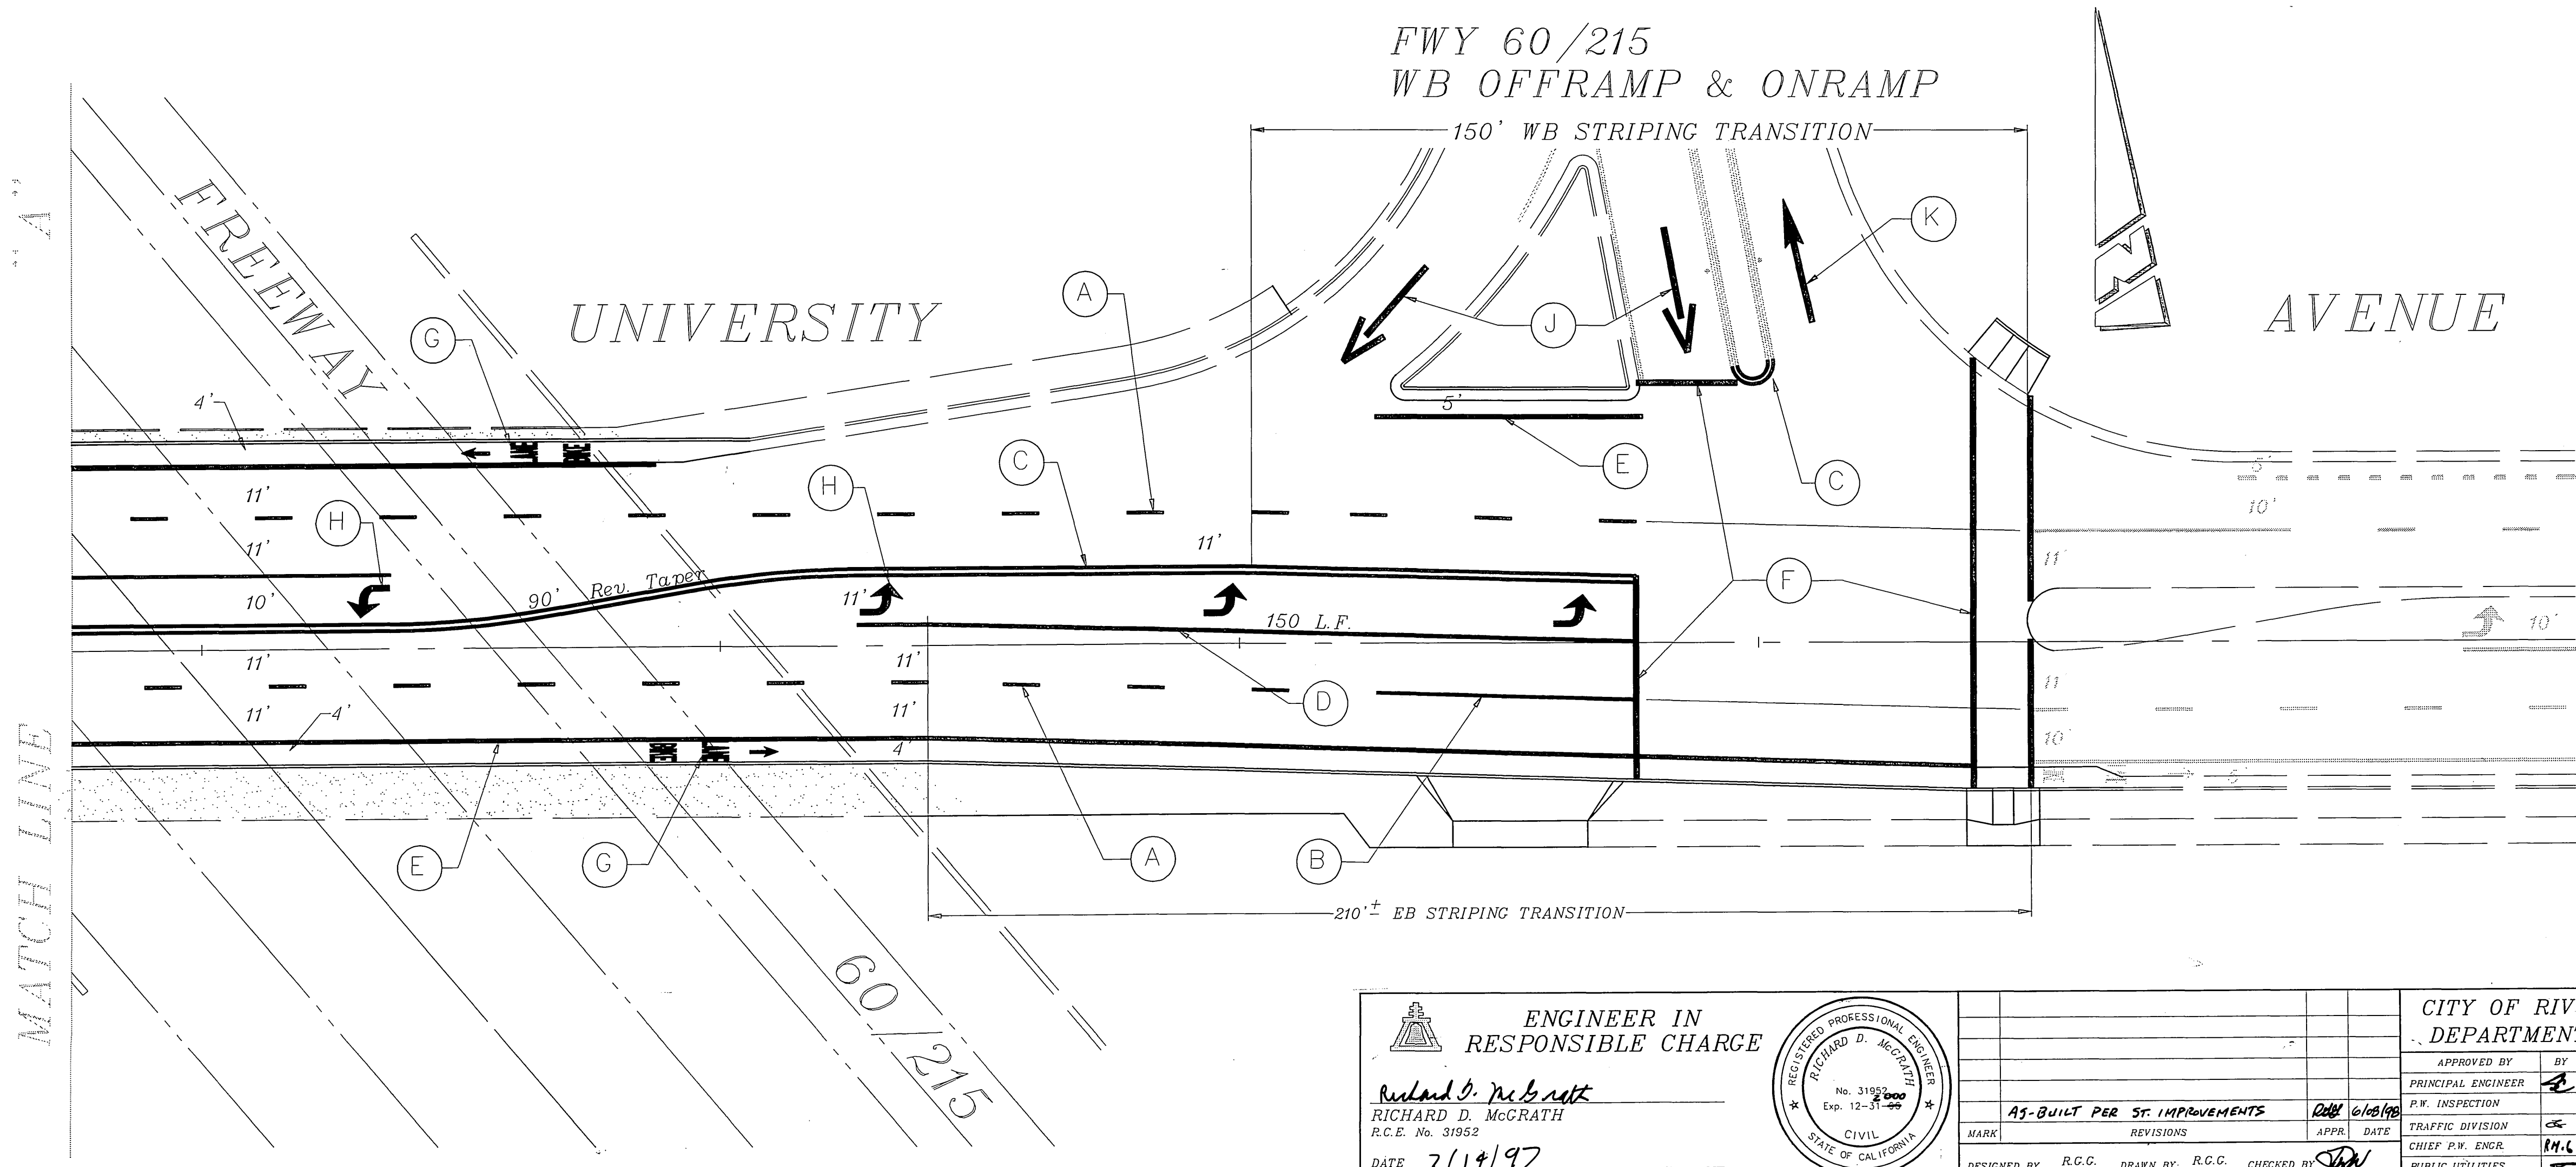

ENGINEER IN RESPONSIBLE CHARGE

*Richard D. McGrath*

RICHARD D. McGRATH  
R.C.E. No. 31952  
DATE 7/14/97

REGISTERED PROFESSIONAL ENGINEER  
RICHARD D. McGRATH  
No. 31952  
Exp. 12-31-99  
CIVIL  
STATE OF CALIFORNIA

CITY OF RIVERSIDE, CALIFORNIA DEPARTMENT OF PUBLIC WORKS		PAVEMENT DELINEATION PLAN		ACCT. NO. 470-520160-140-140-00102
APPROVED BY PRINCIPAL ENGINEER	BY <i>[Signature]</i>	DATE 7/14/97	APPROVED BY DIRECTOR OF PUBLIC WORKS	<i>[Signature]</i>
MARK	DESIGNED BY R.C.C.	DRAWN BY R.C.C.	CHECKED BY <i>[Signature]</i>	
AS-BUILT PER ST. IMPROVEMENTS	DATE 6/28/98	P.W. INSPECTION	DATE 7/14/97	
TRAFFIC DIVISION	DATE 7/14/97	CHIEF P.W. ENGR.	DATE 7/14/97	
PUBLIC UTILITIES				

UNIVERSITY AV.  
WIDENING  
@ 60/215 FREEWAY

SCALE: 1" = 20'

XL-374  
SHEET 1 OF 1  
FILE NAME: XL374.DWG