



XL-63

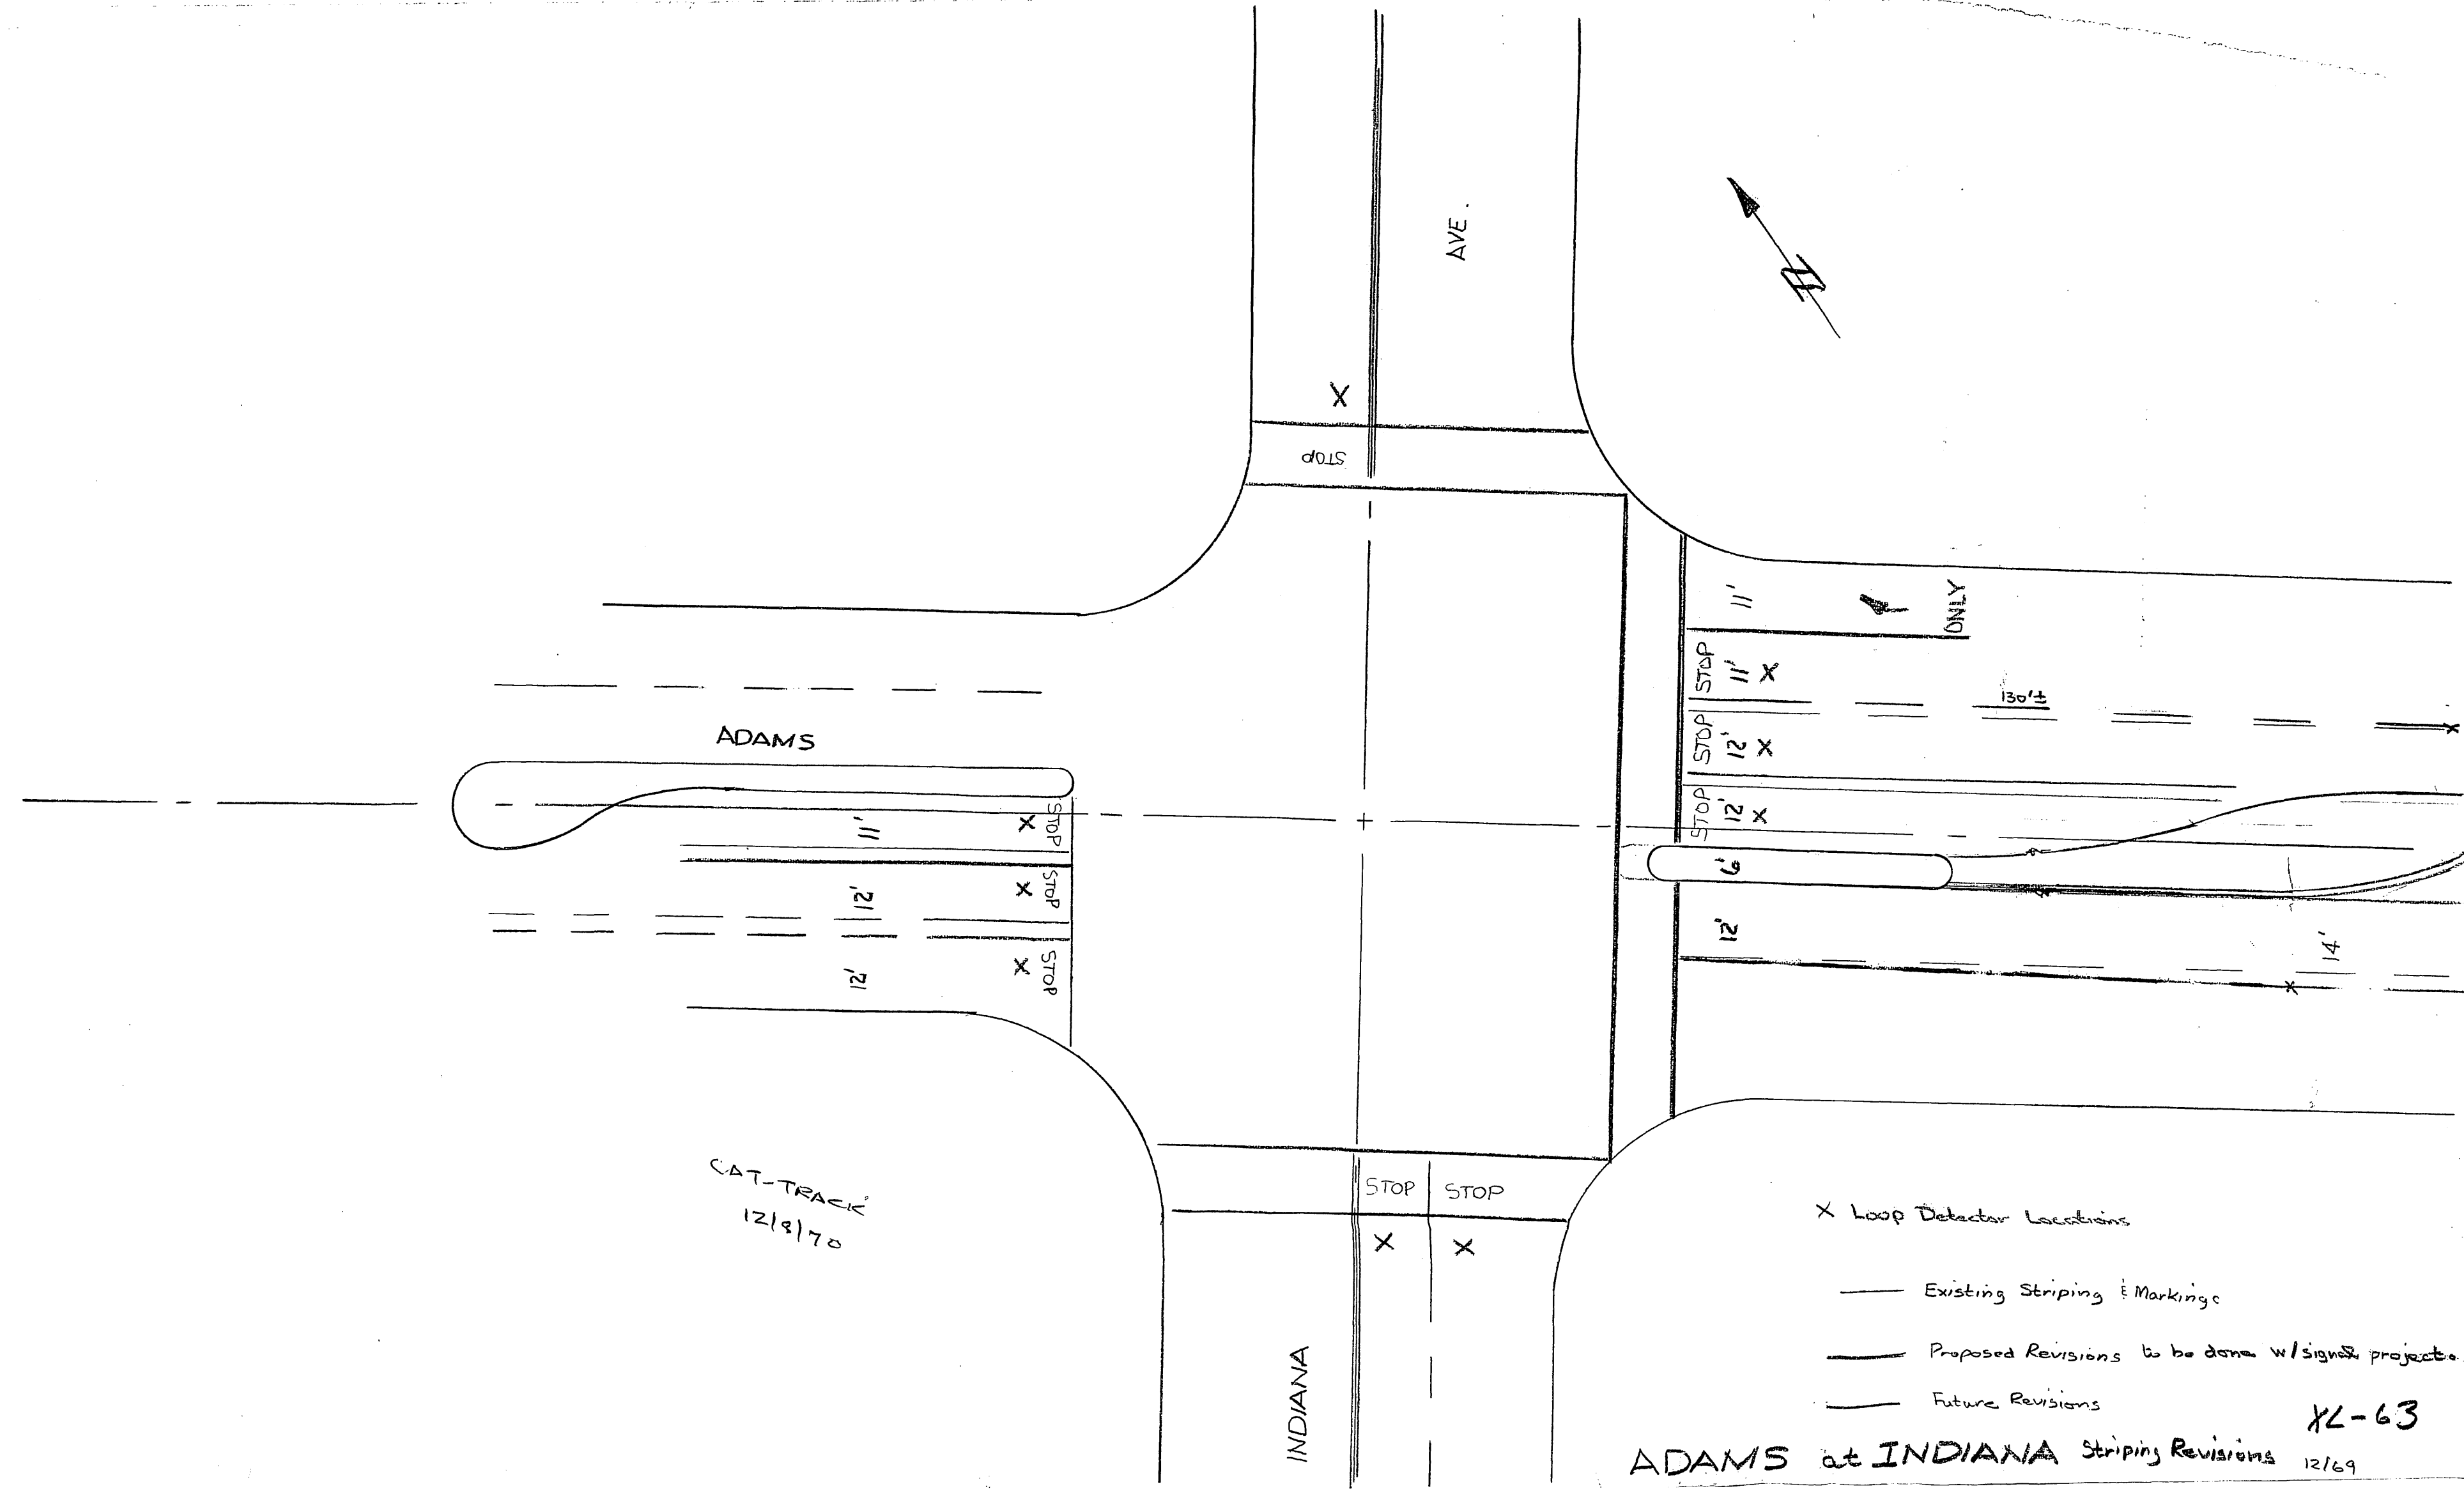


- X Loop Detector Locations
- Existing Striping & Markings
- - - Proposed Revisions to be done w/ signs & projectors
- - - Future Revisions

ADAMS at INDIANA Striping Revisions 12/69 **XL-63**

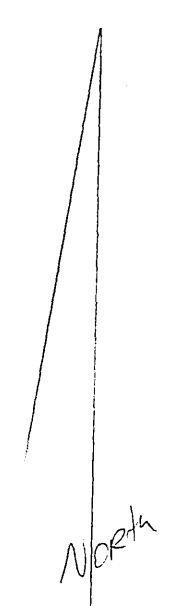

1"=20'

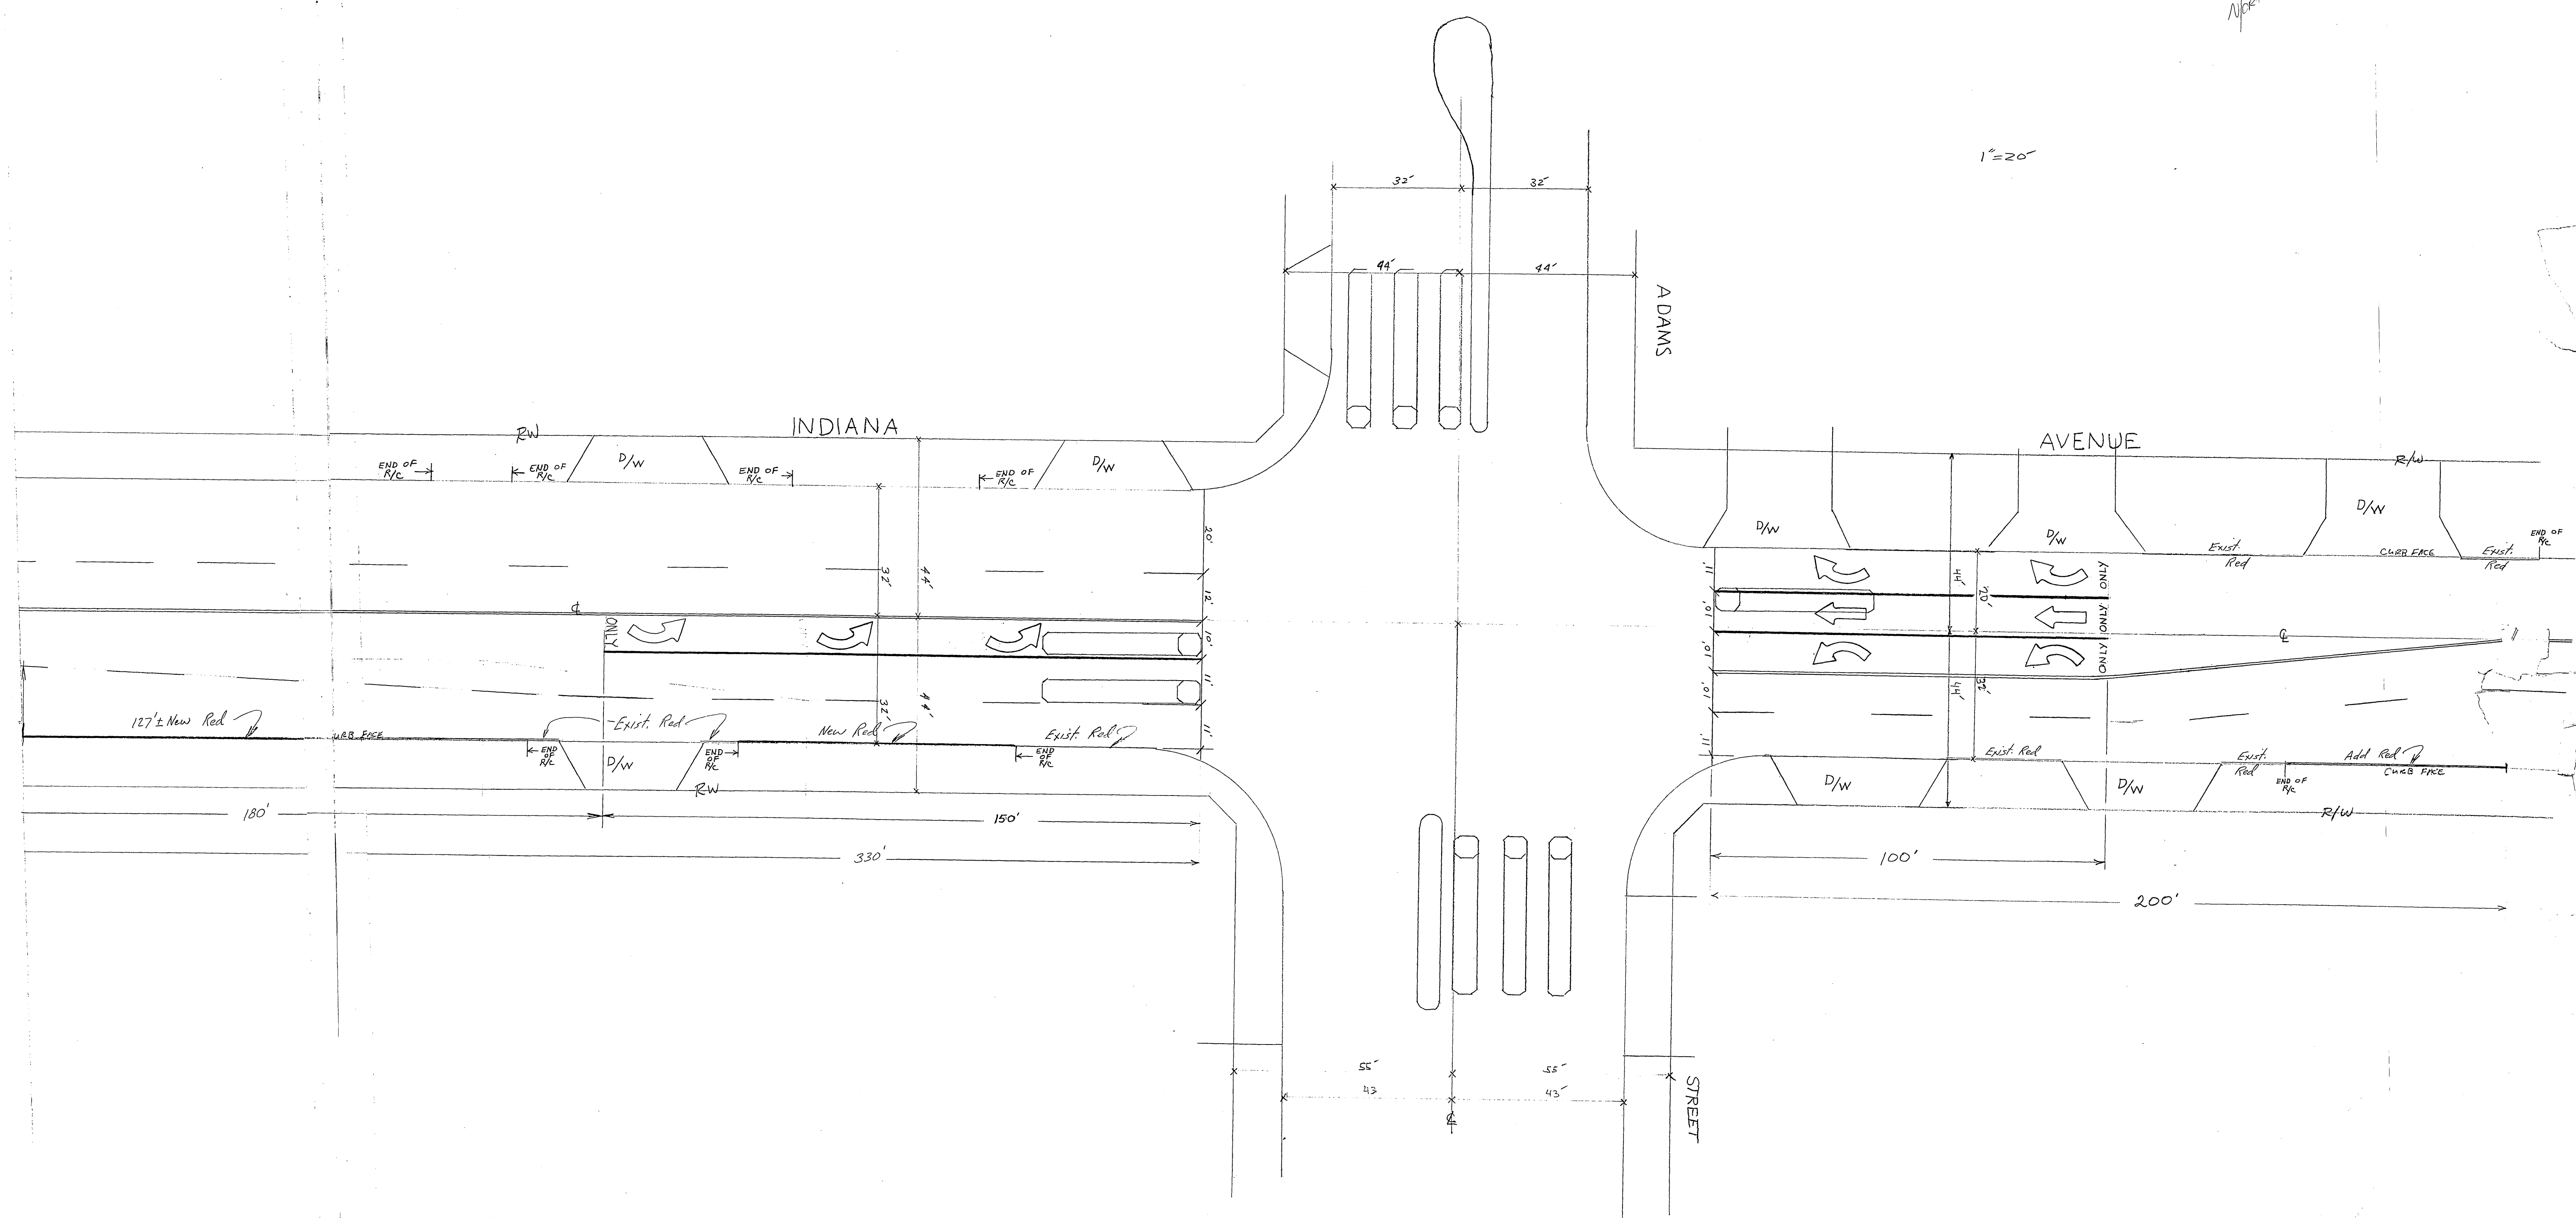

XL-63

ADAMS & INDIANA  
STRIPING

12/9/75 ee  
6-18-76 Bmm