

ENCROACHMENT PERMIT

Pursuant to Resolution No. 11065 of the City of Riverside; permission is hereby granted to Louise C. Alessio and Sarah Alessio
3590 Van Buren Blvd.
Riverside, CA 92503

their heirs and assigns, hereinafter referred to as "Permittee" to use and occupy the following described property.

That portion of Van Buren Boulevard a 55 foot public right of way adjacent to the northeasterly line of Lot 8, of Block 26 of Village of Arlington as shown by map on file in Book 1 of Maps, at Page 62 thereof records of San Bernardino County California and as dedicated by deeds recorded December 1, 1961 as Instrument No. 103426 of Official Records of Riverside County California and by deed recorded January 2, 1979 as Instrument No. 606 Official Records of Riverside County California.

in accordance with the terms hereof.

1. Permittee shall use and occupy the described property only in the manner and for the purposes as follows:

To maintain three existing signs, two existing canopys and an existing building encroaching into said right of way a maximum of 14.00 feet, as shown by Exhibit A attached and made a part hereof by this reference.

2. Permittee, by acceptance of the benefits hereunder, acknowledges title to the property to be in the City of Riverside and waives any right to contest the validity of the dedication or grant.

3. Permittee acknowledges that the described property is the site of a proposed or planned public improvement and that, accordingly, all rights and privileges of use permitted shall cease and expire upon notice of revocation by the City. Upon the expiration or revocation, Permittee shall, within the time prescribed by the City, remove all improvements or obstructions placed, constructed or maintained by the Permittee. If the Permittee fails to abide by the removal order of the City within the time prescribed, the City shall have the right to remove and destroy the improvements without reimbursement to the Permittee and the cost of such removal shall be paid by the Permittee to the City of Riverside and shall constitute a debt owed to the City of Riverside.

4. Permittee, by acceptance hereof, waives the right of claim, loss, damage or action against the City of Riverside arising out of or resulting from revocation, termination, removal of the improvements or any action of the City of Riverside, its officers, agents or employees taken in accordance with the terms hereof.

5. Finding and determination by the City Council of the City of Riverside that the Permittee, or his heirs and assigns or successors in interest, are in default of the terms hereunder shall be cause for revocation.

6. Permittee herewith agrees to hold the City of Riverside harmless from and against all claims, demands, costs, losses, damages, injuries, action for damages and/or injuries, and liability growing or arising out of or in connection with the construction, encroachment, and/or maintenance to be done by Permittee or his agents, employees or contractors within the described property.

DATED: June 16, 1980 CITY OF RIVERSIDE, a municipal corporation
By W. Brown Mayor
Attest Alice C. Han City Clerk

The foregoing is accepted by:

Louis C. Harris
(Signature(s) of Permittee)
Louis C. Harris

APPROVED AS TO CONTENT
Robert C. Wells
Department Head

APPROVED AS TO FORM
John Woodhead
City Attorney

CITY MANAGER APPROVAL
Robert C. Tremont
City Manager

E' PRIMROSE DRIVE

33'

33'

8700'

30 48'


SIGN - WINSTON
ALIGNMENT CENTER
30' HIGH

STANDARD GASOLINE
STATION, GASOLINE
ISLAND & CANOPY

PARCEL 1

CONCRETE
ISLAND


11.5'

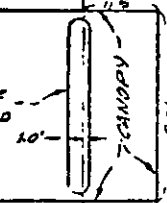

112.00'

55'

SIGN - THE
CACTUS - 30' HIGH

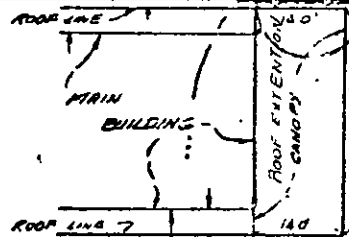


PARCEL 2

ROOF LINE 7

140'

10'

190'

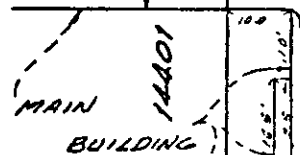


BLOCK BUILDING
WITH STUCCO &
DECORATIVE ROCK
FACE.

ROOF LINE

55'

ORIGINAL PROPERTY
CORNER

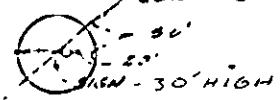

5705'

EXHIBIT "A"

SHEET 1 OF 1

E-757

E VAN BUREN BOULEVARD