BOOK	ONE	PAGE	28
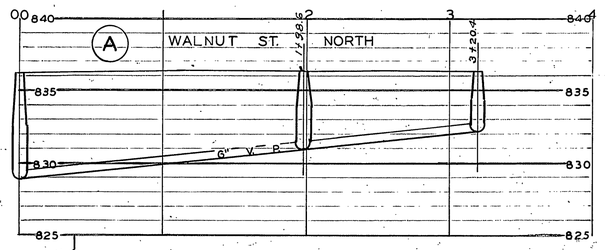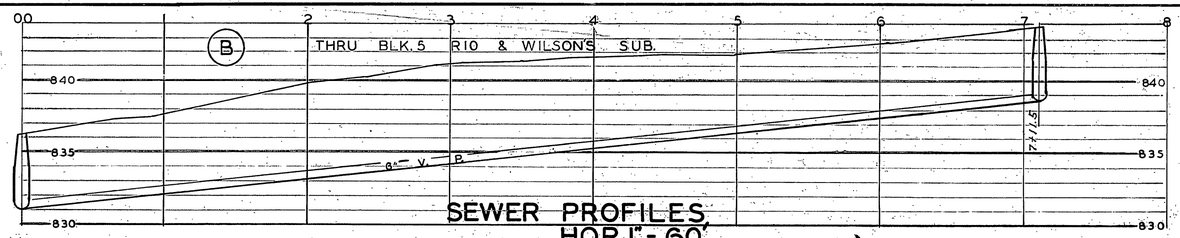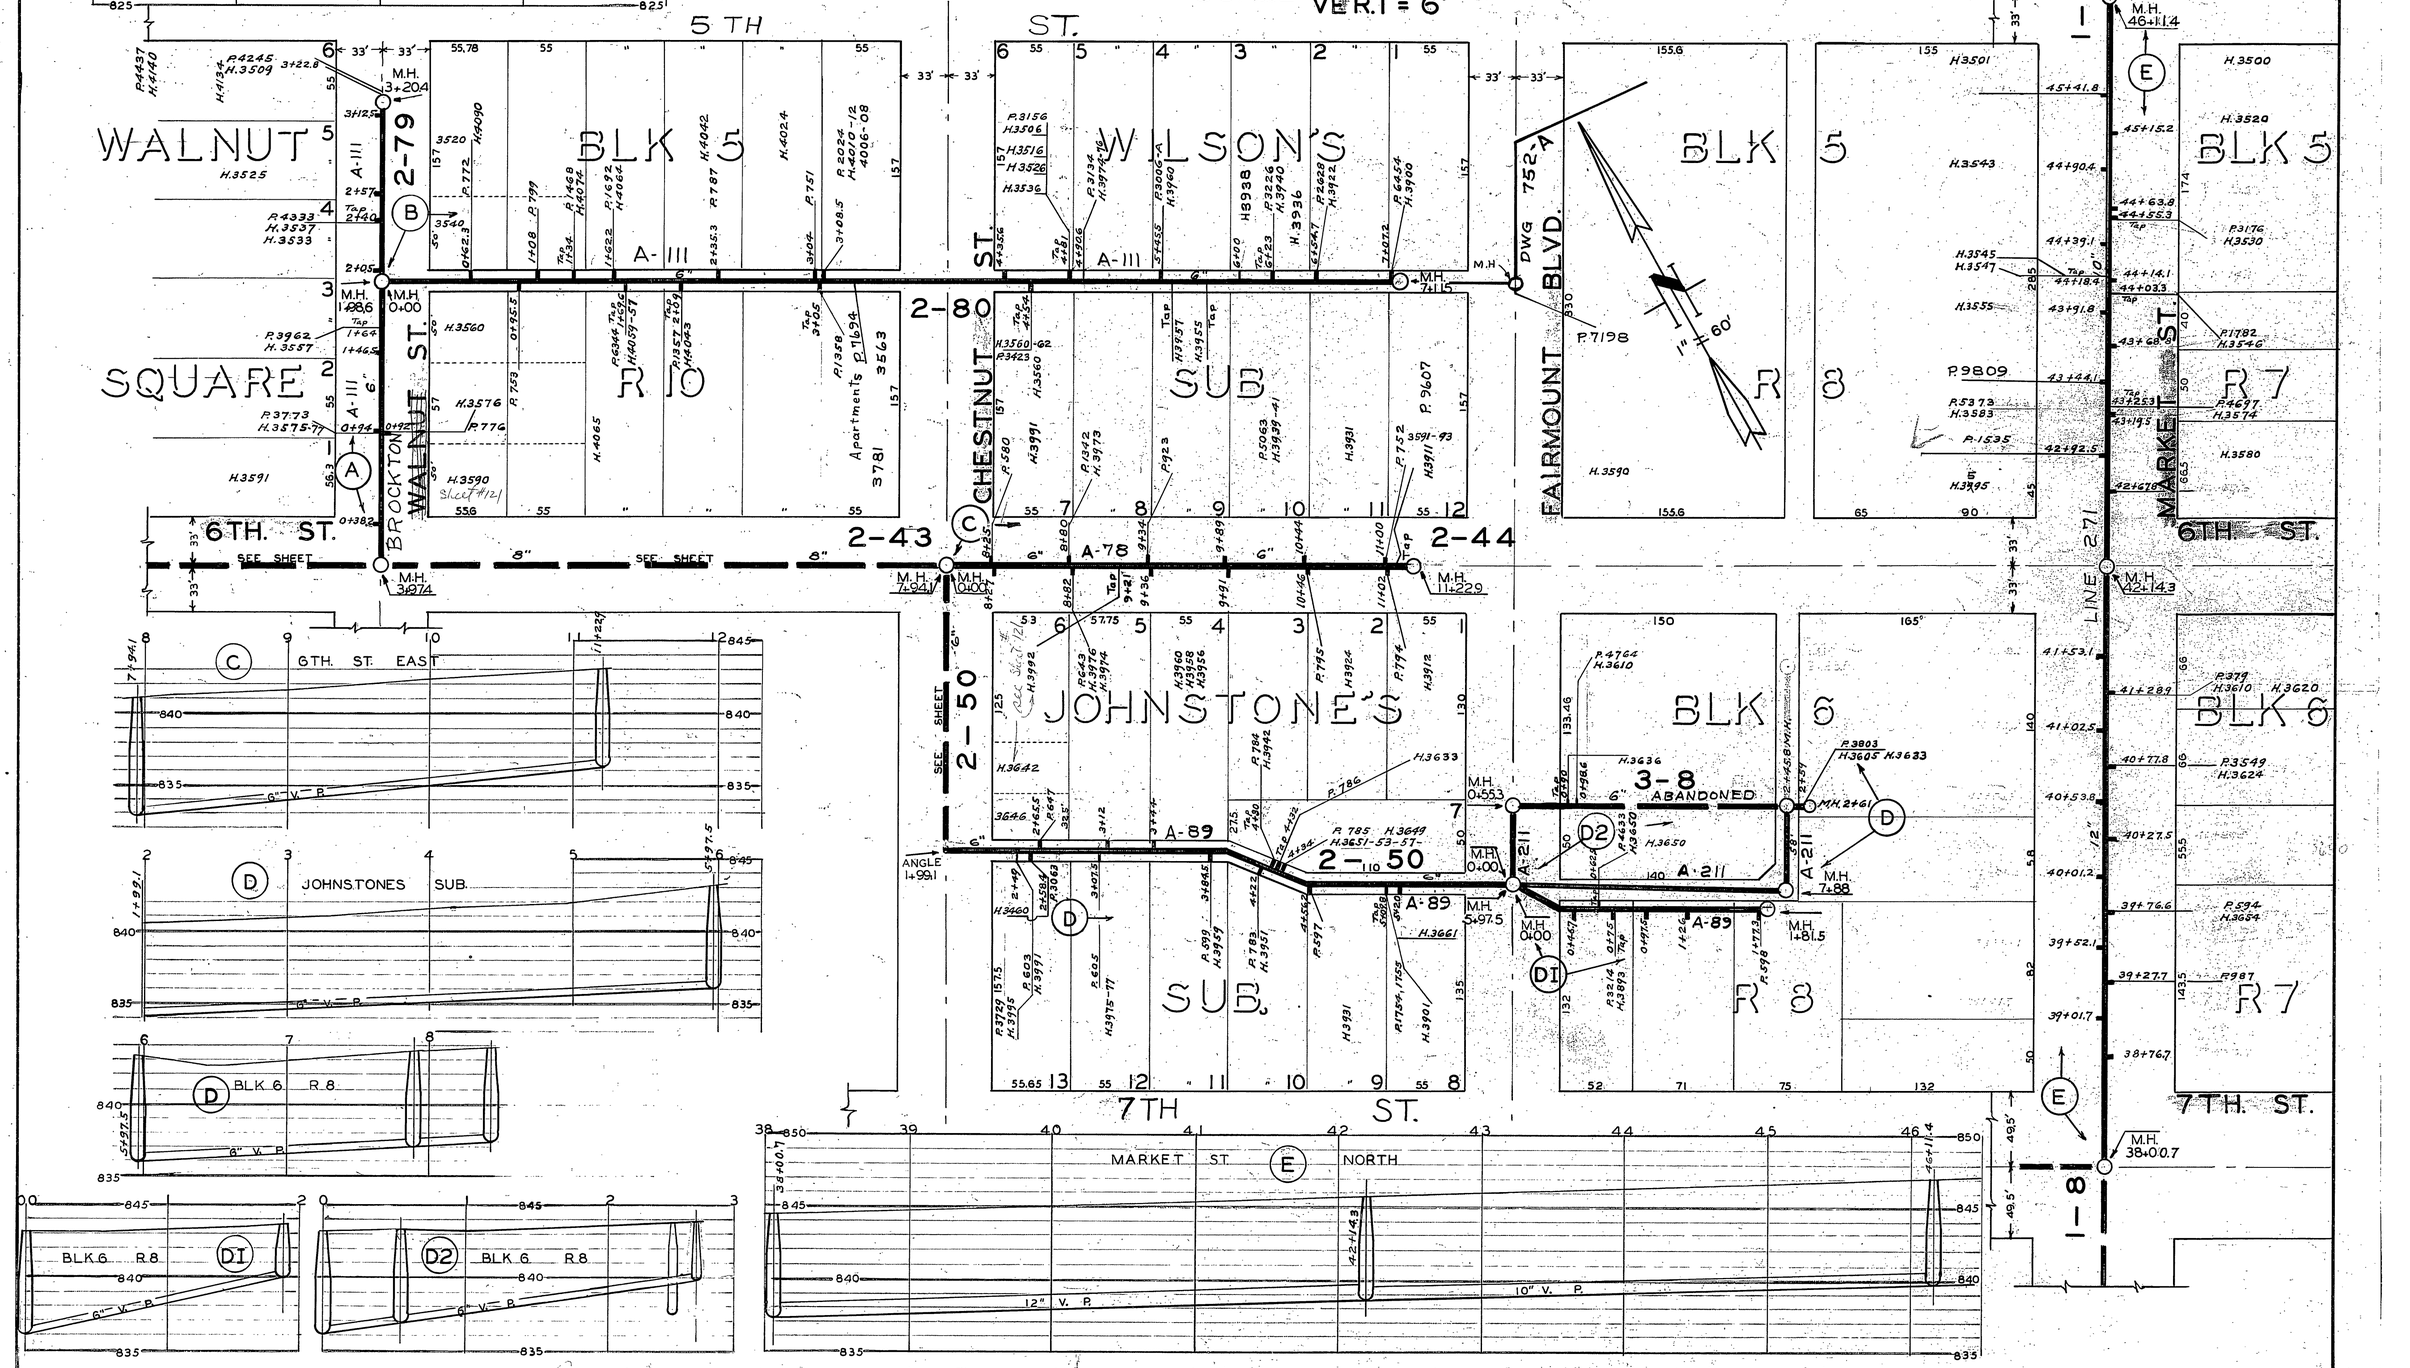
SEWER PROFILES
SCALE HOR. 1" = 60'
VER. 1" = 6'