
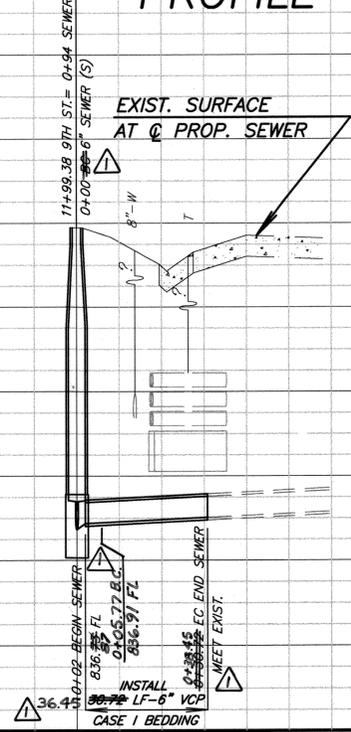


# 9th STREET PROFILE

# ALLEY PROFILE

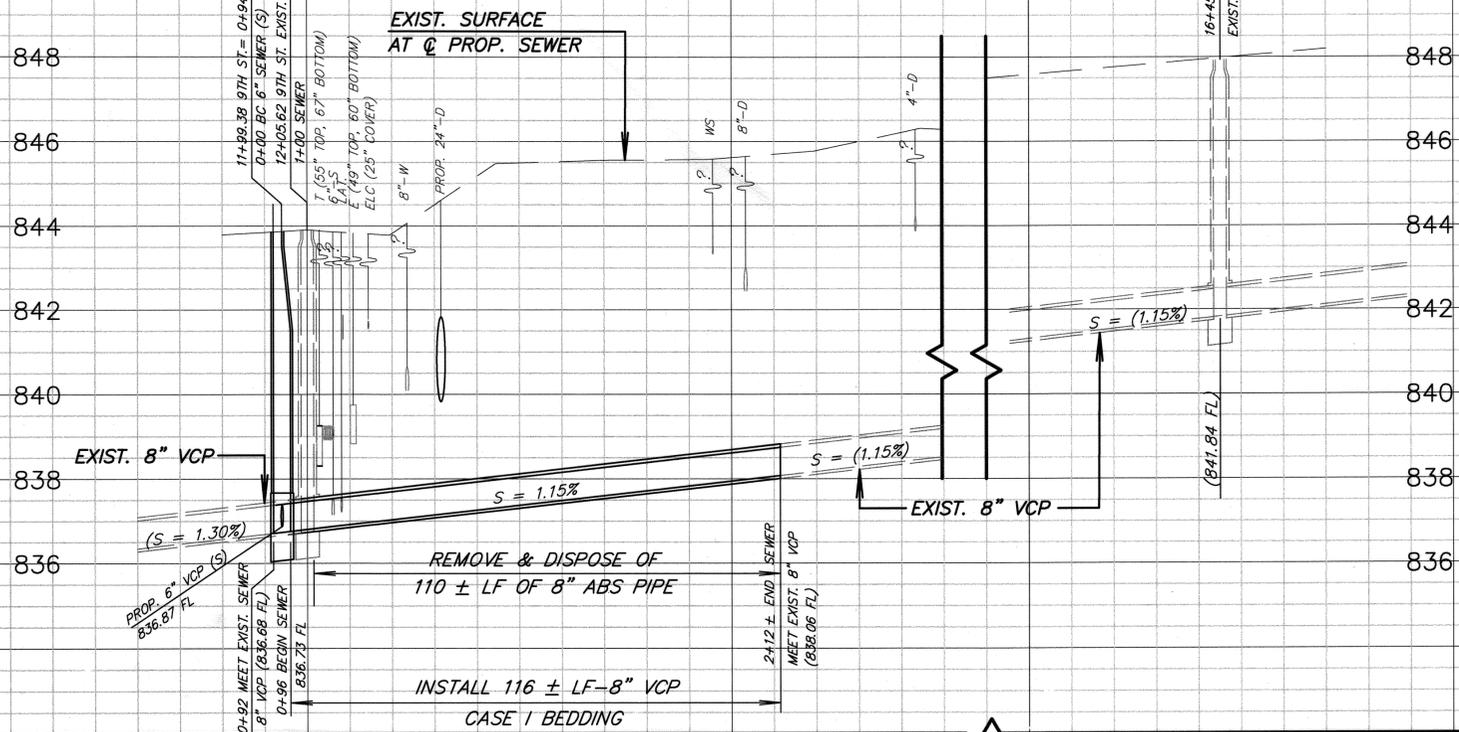

## GENERAL CONSTRUCTION NOTES:



- 1 EXISTING UTILITIES SHOWN ON THE PLAN, ARE PLOTTED FROM UTILITY RECORDS. THE CONTRACTOR IS REQUIRED TO TAKE DUE PRECAUTIONARY MEASURES TO LOCATE AND PROTECT ALL UTILITIES WHETHER OR NOT SHOWN ON THIS PLAN.
- 2 PRIME CONTRACTORS BIDDING THIS WORK SHALL HAVE A CLASS "A", "C-34", OR A "C-42" LICENSE.
- 3 ALL ELEVATIONS SHOWN ON THE PLANS SHALL BE STAKED IN THE FIELD.
- 4 CONSTRUCTION SHALL BE IN ACCORDANCE WITH THE CITY OF RIVERSIDE STANDARD DRAWINGS AND STANDARD SPECIFICATIONS FOR PUBLIC WORKS CONSTRUCTION, 2006 EDITION.
- 5 CONTRACTOR SHALL POTHOLE LOCATION OF PROP. SEWER MANHOLE FOR CONFLICTING UTILITIES.
- 6 CONTRACTOR SHALL EXPOSE MEET POINTS OF THE PROPOSED SEWERS AND SCHEDULE FOR CITY SURVEYOR TO VERIFY MEET ELEVATIONS PRIOR TO ISSUANCE OF GRADE SHEETS.
- 7 VITRIFIED CLAY PIPE JOINTS SHALL BE TYPE "G" AS SPECIFIED IN SECTION 208-2.3 OF THE STANDARD SPECIFICATIONS.

## CONSTRUCTION LEGEND:

- NUMBERS ABOVE 100 IN A HEXAGON ON THE PLAN REFER TO THE RESPECTIVE STANDARD DRAWING AND SHALL BE CONSTRUCTED ACCORDINGLY, UNLESS MODIFICATIONS ARE NOTED ON THE PLAN. ANY NUMBER SHOWN BELOW THE STANDARD DRAWING NUMBER INDICATES THE SPECIFIC ALTERNATE TO BE CONSTRUCTED.
- APPROX. LOCATION OF 14" THICK PCC SLABS, DOWN APPROX. 12' LEFT IN PLACE AFTER WATER TANK REMOVAL.
- REMOVE EXIST. MANHOLE AND BASE.

# PARKING GARAGE

# ALLEY

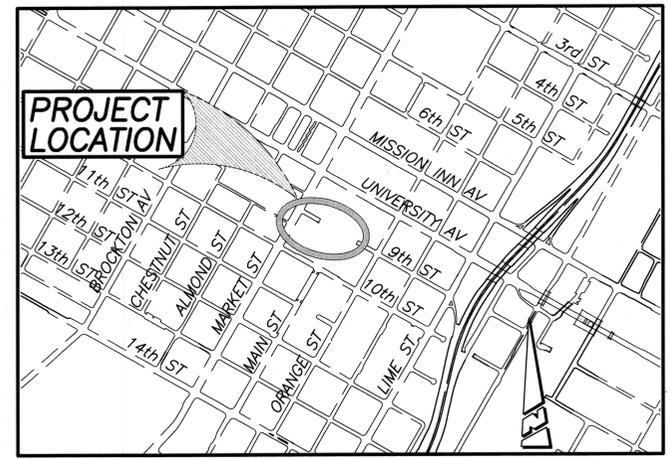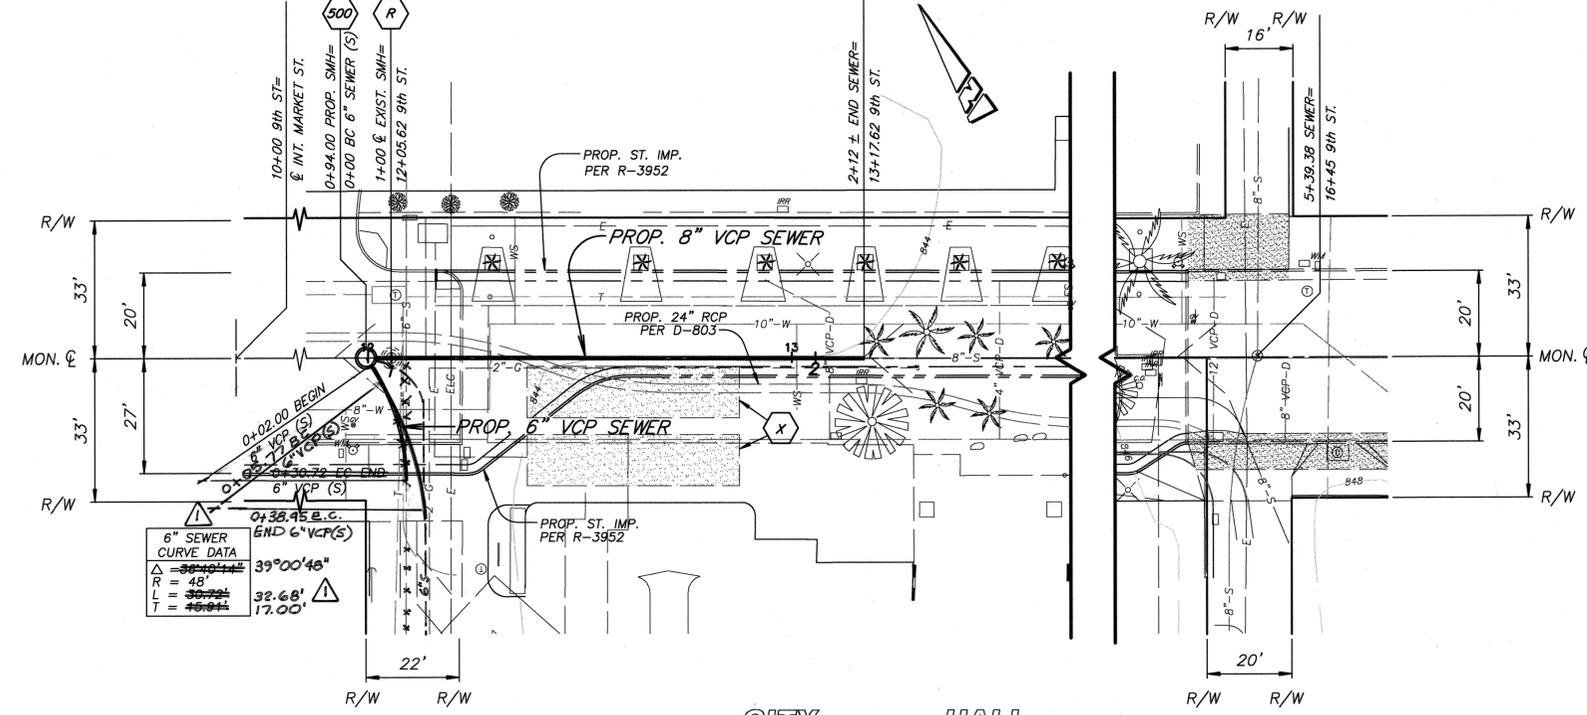

VICINITY MAP  
NO SCALE

**BENCHMARK:**  
16-13  
P.K. NAIL IN THE TOP OF CURB ALONG TENTH STREET, 12 FEET SOUTHEASTERLY OF THE CURB RETURN AT THE MOST SOUTHERLY CORNER OF TENTH STREET AND MARKET STREET.  
ELEV. - 705.516 840.914

**IMPORTANT NOTICE**  
Section 4216/4217 of the Government Code requires a Dig Alert Identification Number to be issued before a "Permit to Excavate" will be valid. For your Dig Alert I.D. Number call CALL TOLL FREE 48 HOURS BEFORE YOU DIG UNDERGROUND SERVICE ALERT 1-800-227-2600

**ENGINEER IN RESPONSIBLE CHARGE**  
LAUREN F. CALDWELL  
R.C.E. No. 39441 expires 12/31/2007  
CIVIL  
STATE OF CALIFORNIA

DESIGNED BY	DRAWN BY	CHECKED BY
	SK	

CITY OF RIVERSIDE, CALIFORNIA  
PUBLIC WORKS DEPARTMENT

APPROVED BY	BY	DATE
ENGINEERING MANAGER	DL	6-19-07
PRINCIPAL ENGINEER		
CONTRACT ADMINISTRATOR		
SURVEYOR		
SEWER DIVISION		
STREET SERVICES		

**9th STREET SEWER REPAIR**  
From Alley W'y of City Hall to 110 ± E'y

ACCT. NO. 9810823203-44030109  
**S-2021**  
SHEET 1 OF 1  
FILE NO.

HORIZ. SCALE: 1"=20'  
VERT. SCALE: 1"=2'