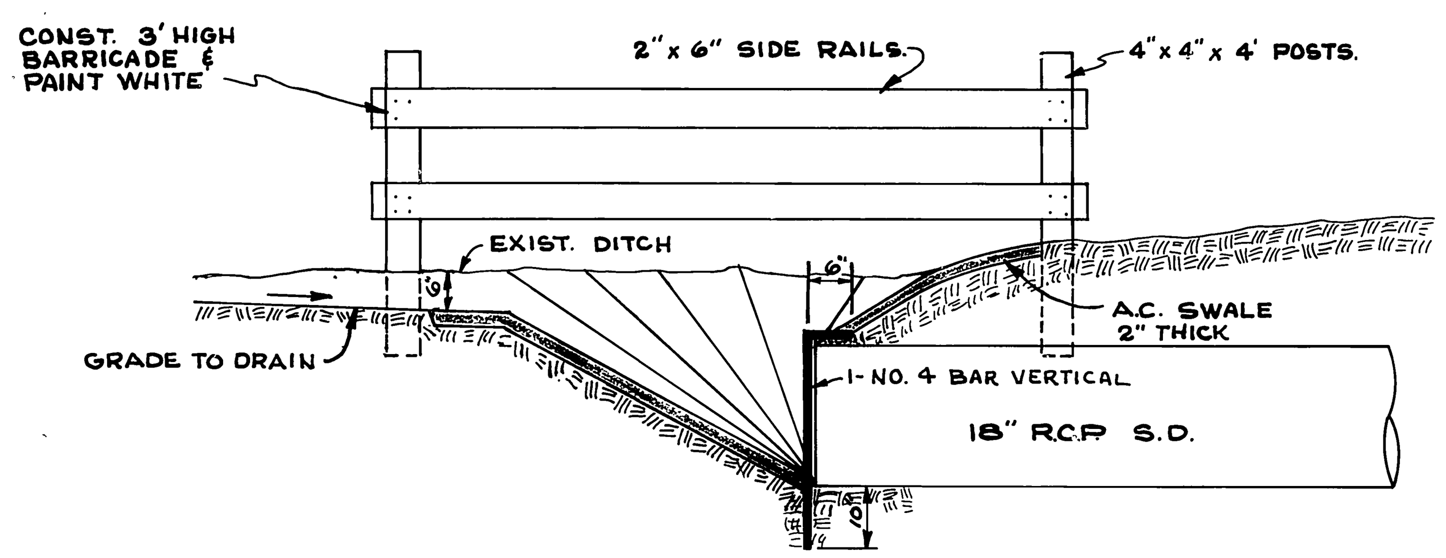

INLET DETAIL

STA. 29+50 - 34' LT.
SCALE: 1"=2'

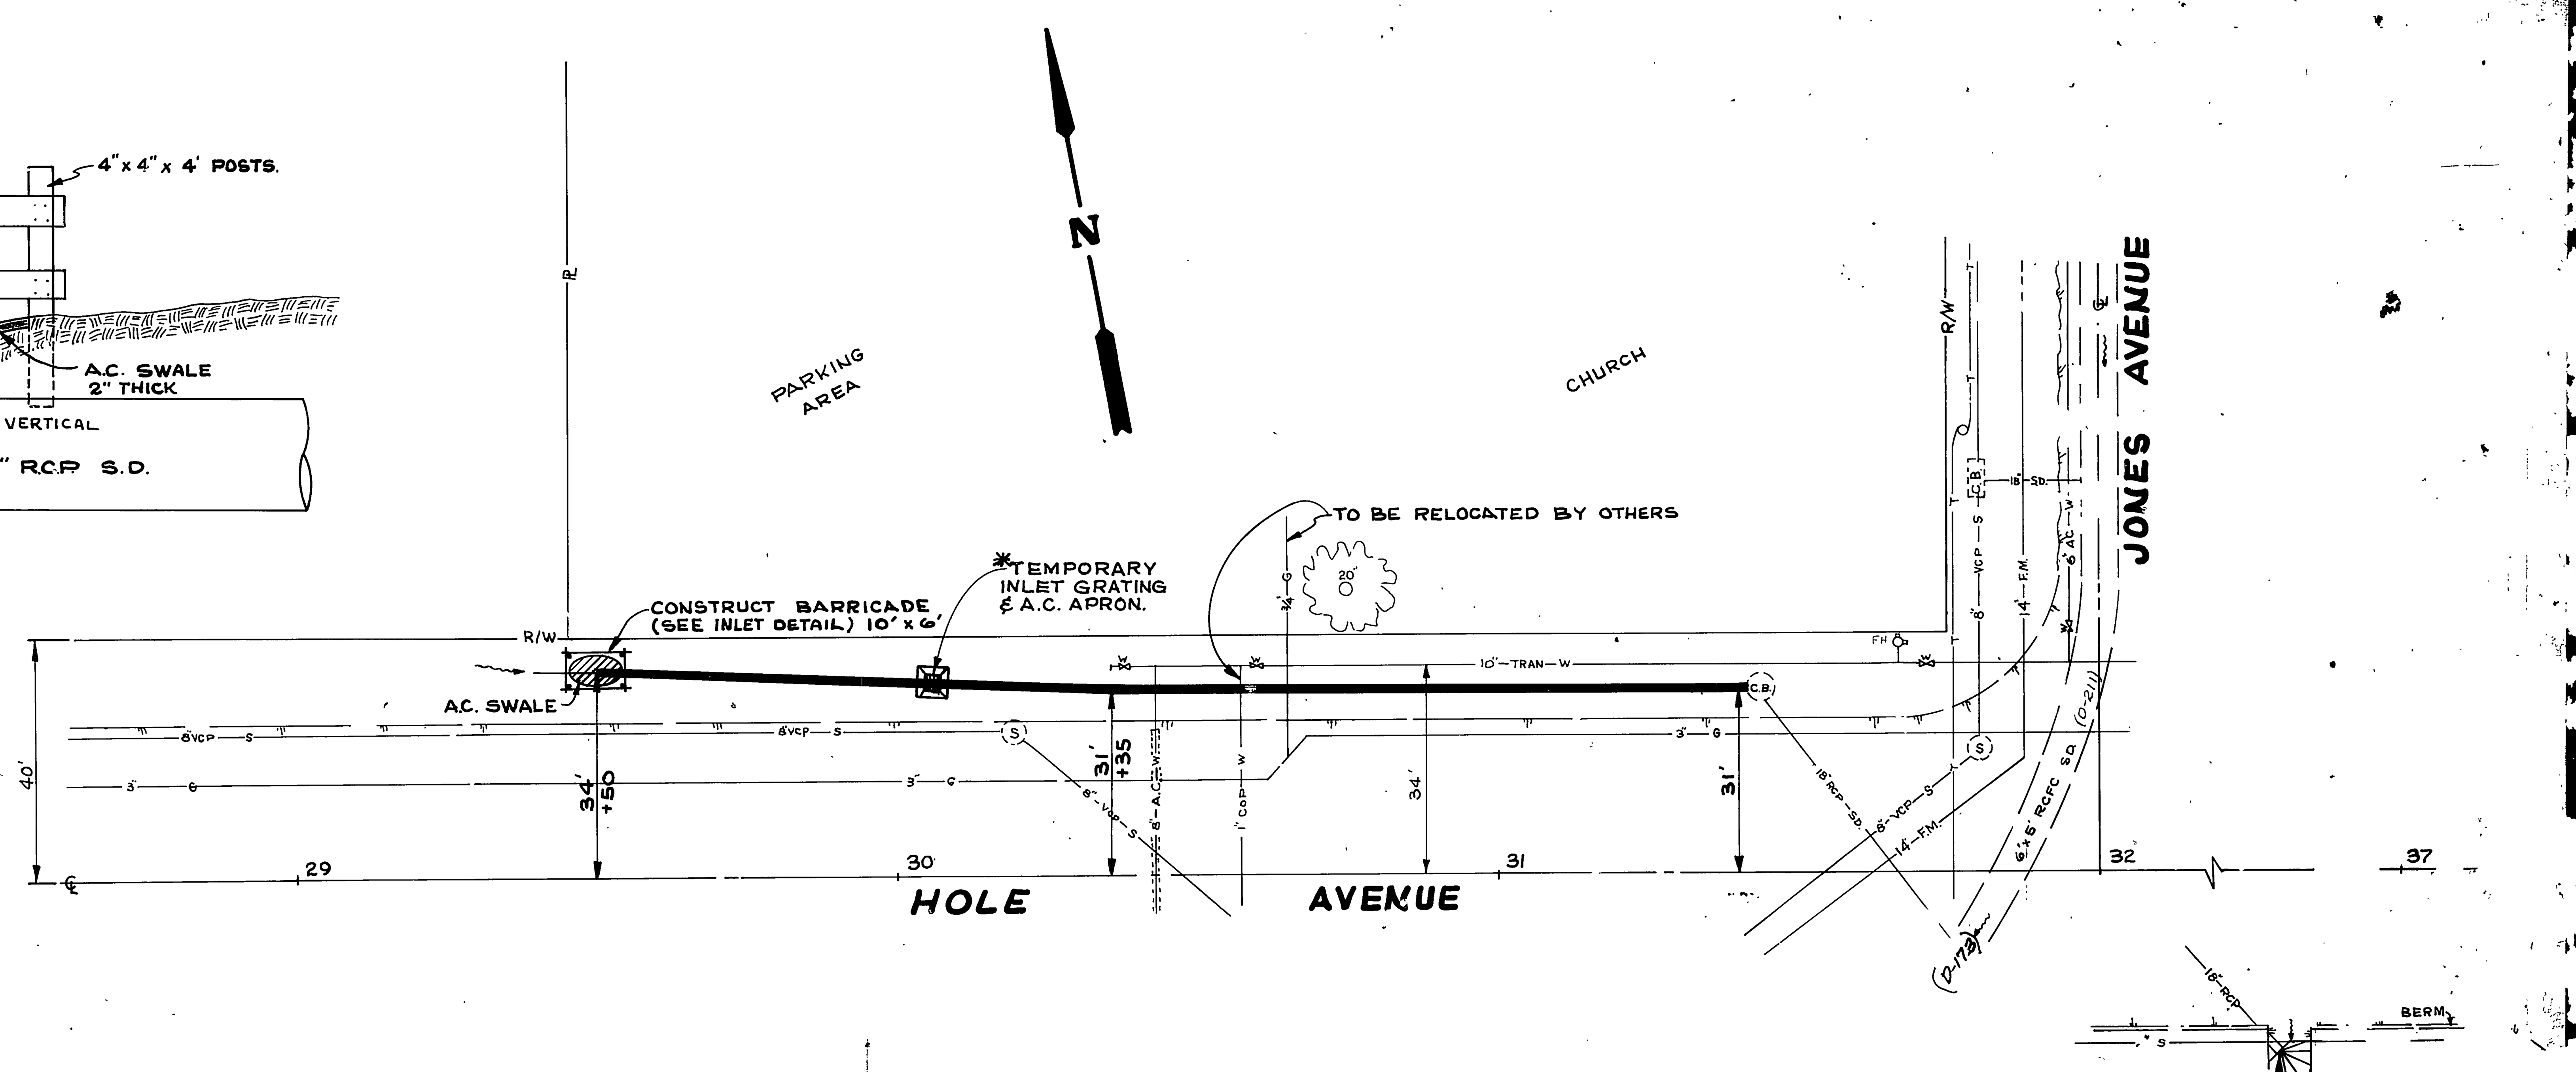

PLACE ANCHORED PROTECTION BAR (1-NO. 4 BAR VERTICAL) ACROSS EXIST. 18" RCP. 33' RT. STA. 36+80.

* AS BUILT 5/19/71 J.P.G.

CITY OF RIVERSIDE, CALIFORNIA DEPARTMENT OF PUBLIC WORKS	HOLE AVE LATERAL EXTENSION WEST OF JONES AVE.
APPROVED BY: William D. Gordon, Director of Public Works; Principal Engineer JW 11/2/70	PLAN AND PROFILE
DATE 11/4/70	SCALE: 1" = 20'
DESIGNED BY DCH; CHECKED DCH	D-213

P. N. 447