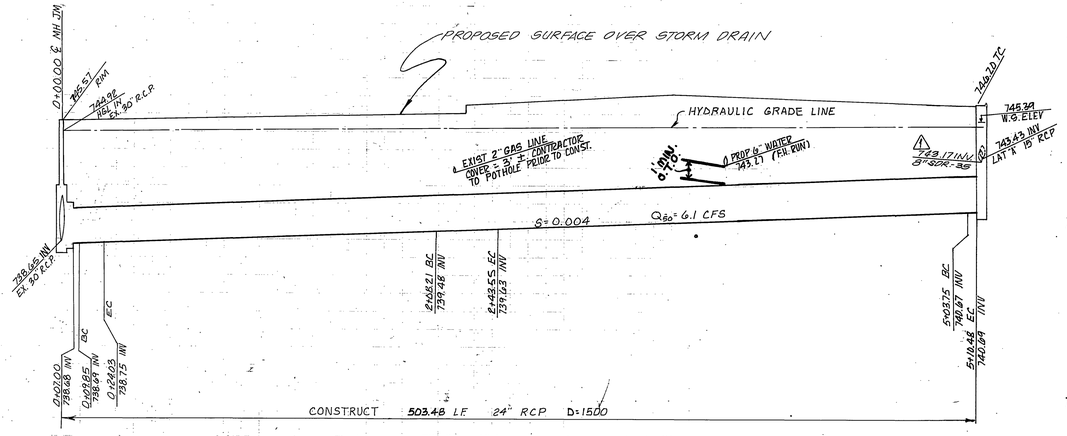

LINE "A"

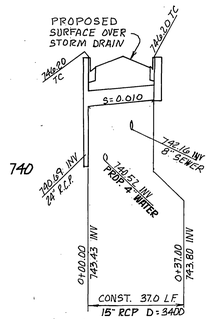

LATERAL "A"

GENERAL NOTES

1. It shall be the responsibility of the contractor to clear the right of way in accordance with the provisions of law as it affects each utility including irrigation lines and appurtenances and at no cost to the City.
2. Construction shall be in accordance with the City of Riverside, Department of Public Works, Standard Drawings, Standard Drawing No. 10 and the Standard Specifications for Public Works Construction, current edition.
3. The private engineer signing these plans is responsible for assuring the accuracy and acceptability of the work hereon. In the event of discrepancies arising during construction, the private engineer shall be responsible for determining an acceptable solution and revising the plans for approval by the City.
4. Quantities shown are for information only and the City of Riverside is not responsible for their accuracy.
5. In order to coordinate the City's portion of the work, the developer and/or contractor shall give the City 60 days' notice in order that the developer's and the City's work may be installed concurrently. The developer shall prepare and compact rough subgrade (+/- .1') and is responsible for the condition of the subgrade until accepted by the City and until the City's contractor starts working. The developer is also responsible for barricading during this time.
6. The developer and/or contractor shall contact the Public Works Department 30 days prior to beginning construction to negotiate the cost of the City's portion of the work.
7. The developer shall be responsible for preserving or re-establishing and referencing survey monuments destroyed, disturbed or buried as a result of construction shown hereon.
8. All flagged elevations shall be staked in the field by the private engineer.
9. Street opening permit for construction and/or modification of traffic signal facilities is required.
10. Any traffic control striping obliterated and/or badly worn during construction shall be restored by the contractor within five days after notification from the City Inspectors.
11. The contractor shall call in a location request to Underground Service Alert (USA), phone number 1-800-422-4133, two working days before digging. No construction permit will be issued by the Public Works Department involving excavation for underground facilities unless the applicant has been provided an inquiry identification number by USA.
12. Location of laterals to be determined in the field at the direction of the owner. Avoid conflict with proposed and/or existing facilities.
13. Developer and/or contractor to give RCFC 5 days' written notice prior to starting work on storm drain (or doing any work within RCFC easements). RCFC Encroachment Permit No. _____.
14. In pavement overlay areas, distressed existing pavement shall be removed and replaced as directed by the Inspector prior to overlaying with A.C. paving.

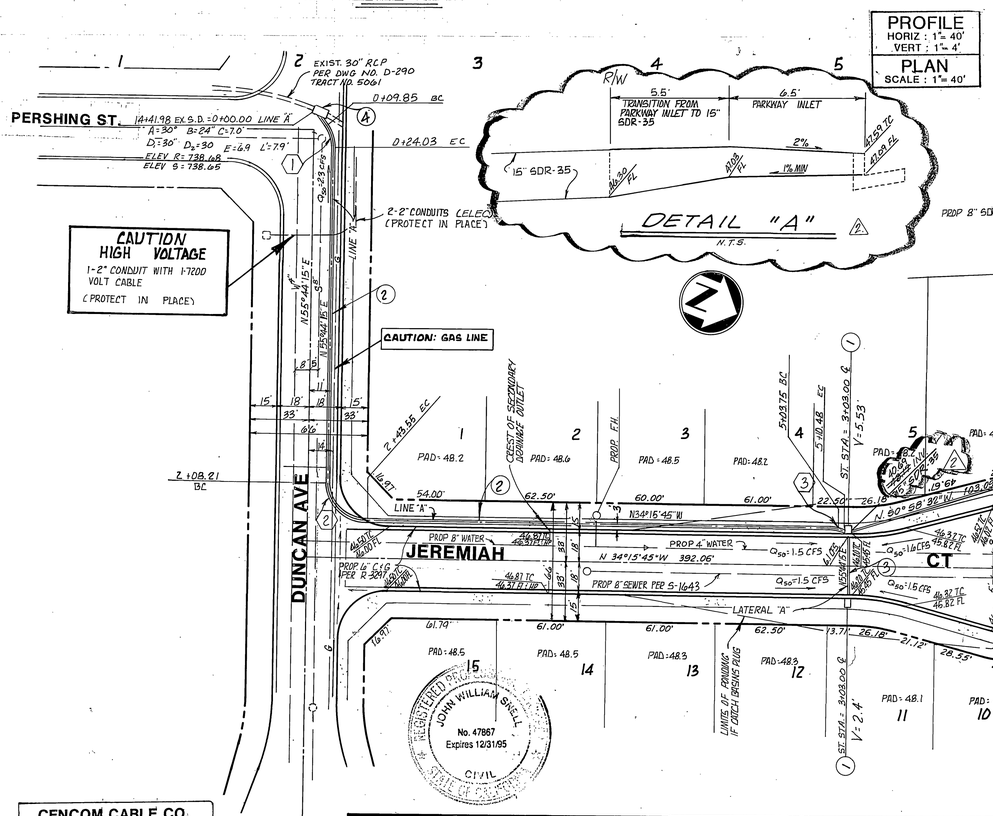

VICINITY MAP
N.T.S.

CONSTRUCTION NOTES AND QUANTITY OPINION

1	CONSTRUCT 4' CATCH BASIN PER CITY STD. DWG. NO. 405 "V" AS SHOWN ON PLAN	2 EA.
2	CONSTRUCT 24" RCP D=1400	504 LF
3	CONSTRUCT 15" RCP D=3400	37 LF
4	CONSTRUCT MANHOLE JM PER CITY STD. DWG. NO. 432	1 EA.
5	CONSTRUCT ~~12" SDR-35~~ 15" SDR-35	350 ~~258~~ L.F.
6	CONSTRUCT 12"X18" BROOKS BOX WITH STEEL TRAFFIC GRATE	1 EA.
7	CONSTRUCT CLEANOUT PER CITY STD. DWG. No. 425	3 ~~4~~ EA.
8	CONSTRUCT MODIFIED PARKWAY INLET PER CITY STD. No. 211 AND DETAIL "A" ON THIS SHEET WITH TRANSITION	1 EA.

CENCOM CABLE CO.
APPROVED BY DATE 7/21/92

SOUTHERN CALIFORNIA GAS CO.
APPROVED BY DATE 6-25-92

CITY OF RIVERSIDE ELECTRICAL DEPT.
APPROVED BY DATE 6/25/92

CITY OF RIVERSIDE WATER DEPT.
APPROVED BY Richard L. Drolet DATE 7-17-92

ADKAN ENGINEERS
CIVIL ENGINEERING, PLANNING, LAND SURVEYING
6830 AIRPORT DRIVE
RIVERSIDE, CA. 92504 (714) 688-0241
JOHN W. SNELL RCE 47867 EXP 12/31/95 DATE 7-10-92
CITY BUSINESS TAX CERTIFICATE NO. 022332 EXP. DATE 7/1/93

MARK	REVISIONS	APPR.	DATE
2	REVISED PIPE @ LOT 7 ADDED INLET: PIPE @ LOT 16	JWS	9/15/93
1	ADDED 8" SDR-35 & CLEANOUT	JWS	12/1/93

DESIGNED BY MDS DRAWN BY MDS CHECKED BY JWS

PROFILE HORIZ: 1"= 40' VERT: 1"= 4'
PLAN SCALE: 1"= 40'

CITY OF RIVERSIDE
PUBLIC WORKS DEPARTMENT

APPROVED BY	DATE	BY
PRINCIPAL ENGINEER	8/5/92	
PARK DEPARTMENT	7-20-92	MA
TRAFFIC DIVISION		
CHIEF P. W. ENGINEER	8/11/92	

APPROVED BY
PUBLIC WORKS DIRECTOR
DATE 8/14/92

STORM DRAIN PLAN
TRACT 27281
LINE "A"
STA 0+00.00 TO STA 5+10.48
LATERAL "A"
STA 0+00.00 TO STA 0+37.00
HORIZ. SCALE: 1"=40' VERT. SCALE: 1"=4'

ACCOUNT NO. D-617
SHEET 1 OF 1

AS BUILT 3/31/94 RMM

INDEXED 9-9-92 LH