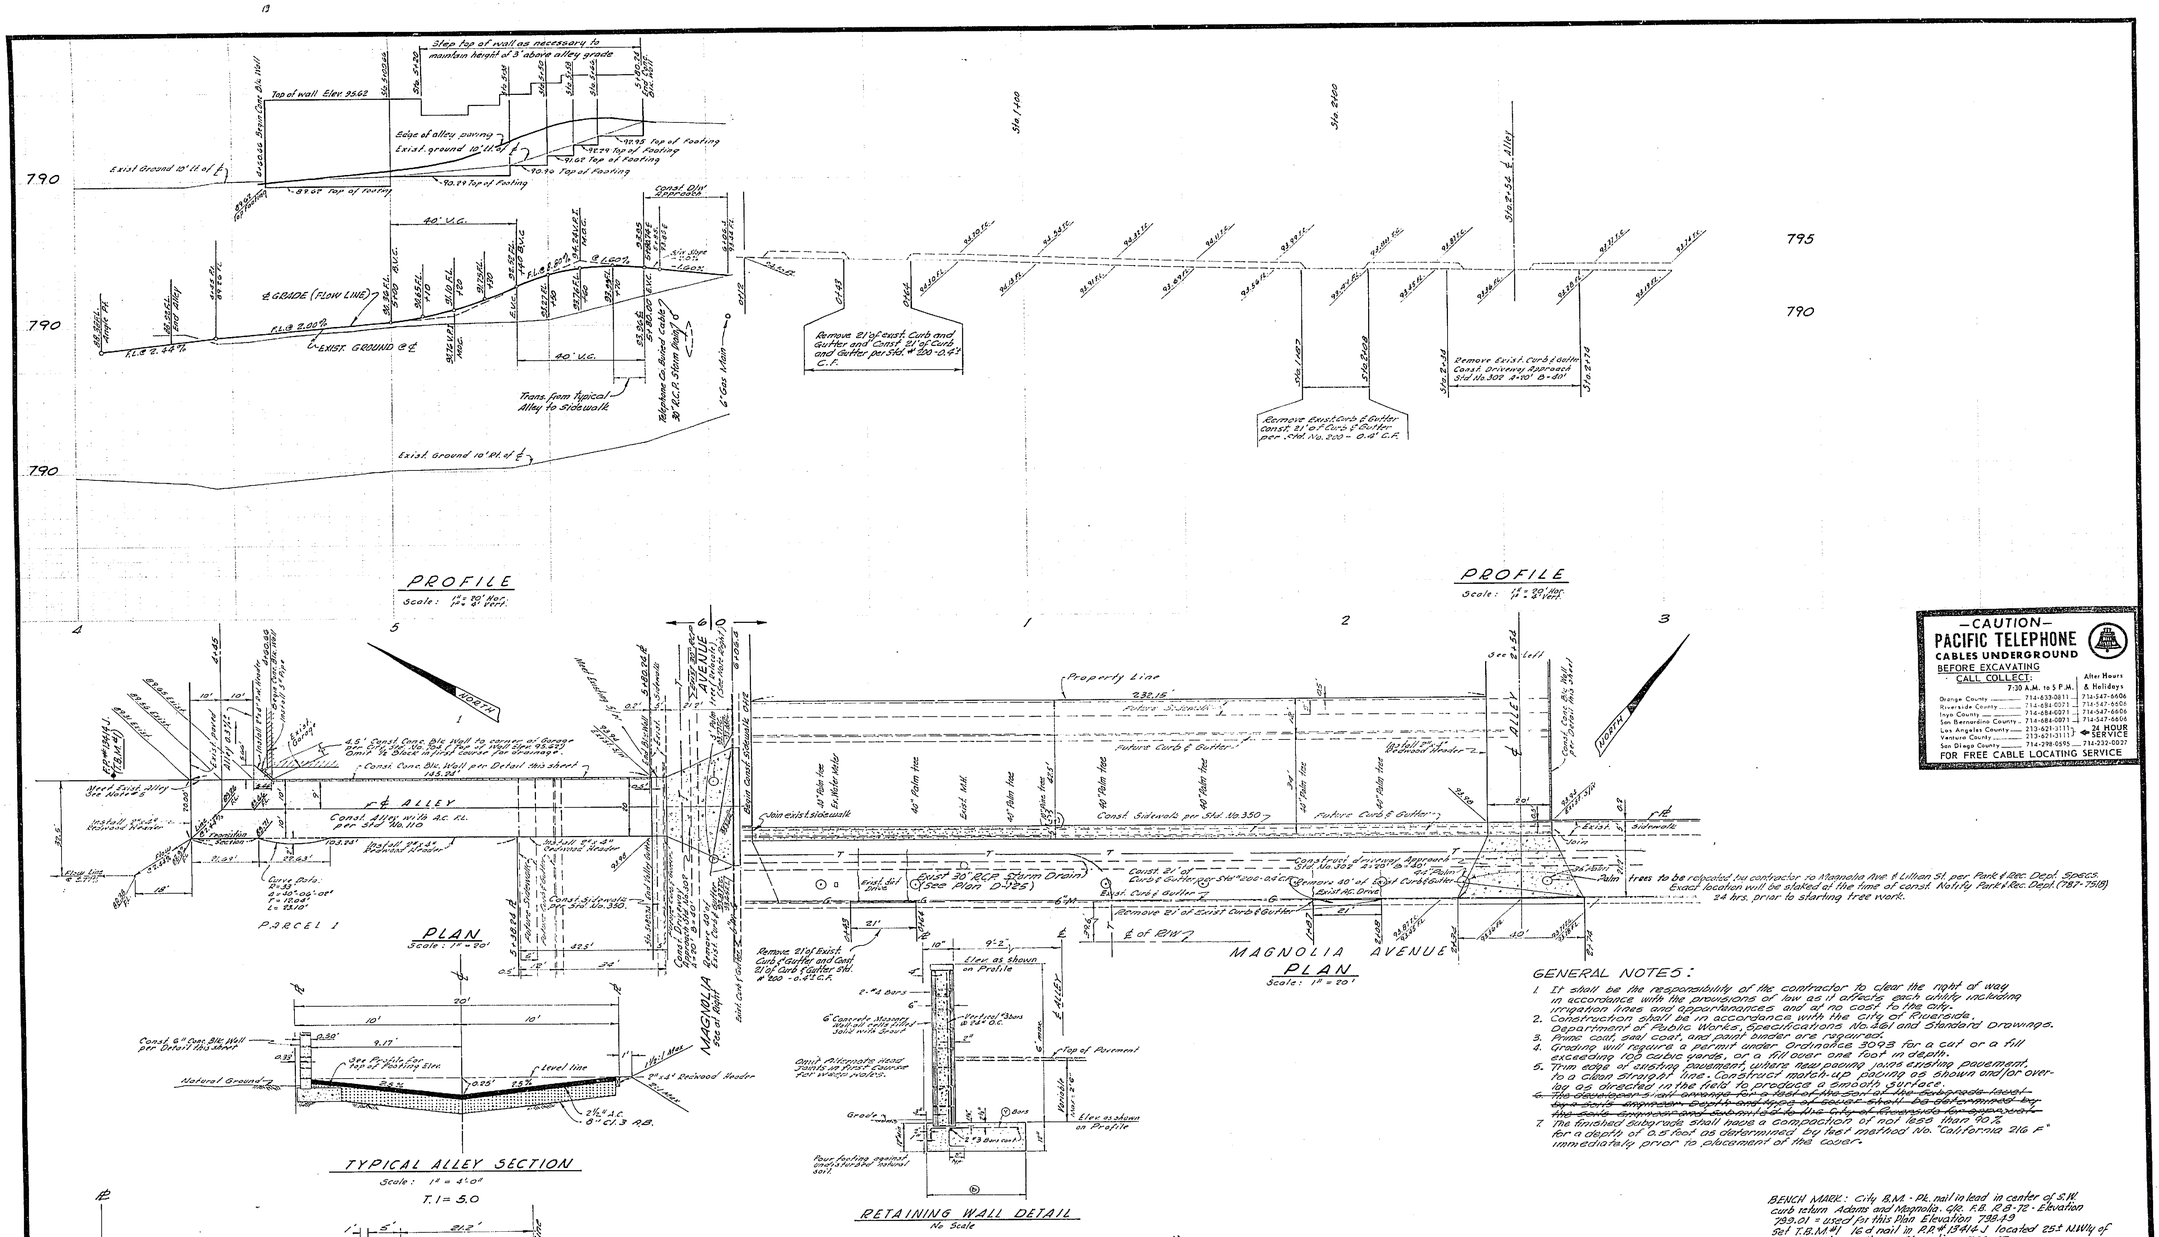

—CAUTION—
PACIFIC TELEPHONE
CABLES UNDERGROUND
BEFORE EXCAVATING
CALL COLLECT:

	7:30 A.M. to 5 P.M.	After Hours & Holidays
Orange County	714-633-0811	714-547-6606
Riverside County	714-684-0021	714-547-6606
Inyo County	714-684-0021	714-547-6606
San Bernardino County	714-684-0021	714-547-6606
Los Angeles County	213-621-3111	24 HOUR SERVICE
Ventura County	213-621-3111	24 HOUR SERVICE
San Diego County	714-298-0595	714-232-0027

FOR FREE CABLE LOCATING SERVICE

TABLE OF LIMITS	Ⓑ	Ⓒ BARS
Sta. 3+60.36 to Sta. 3+20	2'-0"	NONE
Sta. 3+20 to Sta. 3+00.00	2'-3"	#3 at 24" o.c.
Sta. 3+00 to Sta. 2+80.24	2'-0"	NONE

Note: Concrete in footing to test 2000 lbs per Sq. in. at 28 days. Concrete Block - Grade 'A' units ASTM. C-90 Grout - 1 Part Cement, 3 Parts Sand, 2 Parts Pea Gravel. Mortar - 1 Part Cement, ½ Part Lime Putty, 4½ Parts Sand.

CRAWLEY & HAWKINS
SURVEYORS AND ENGINEERS
Riverside, California
Approved George O. Crawley R.E. No. 9155
Field Bk. 67/38
Date 6-20-65
J.O. No. 384

MARK	REVISIONS	APPR.	DATE
Corrected alley grade, Sta. 3+00 to Sta. 3+60.36	George O. Crawley	WHS	5-21-65
Changed Alley Grade Sta. 3+00 to Sta. 3+60.36	George O. Crawley	WHS	5-21-65
Changed Alley Grade Sta. 3+00 to Sta. 3+60.36	George O. Crawley	WHS	5-21-65

DESIGNED BY L.D.M. DRAWN BY L.M. CHECKED BY

CITY OF RIVERSIDE, CALIFORNIA
DEPARTMENT OF PUBLIC WORKS

APPROVED BY	BY	DATE
OFFICE ENGINEER	[illegible]	1-26
PARK DEPARTMENT	[illegible]	1-25
TRAFFIC DIVISION	[illegible]	1-24
ASSISTANT CITY ENG.	[illegible]	1-25

APPROVED BY [illegible]
DIRECTOR OF PUBLIC WORKS
DATE Jan. 27, 1966

STREET PLAN & PROFILE
ALLEY, BETWEEN CANTERBURY RD. & ADAMS ST. N. OF MAGNOLIA AVE. BETWEEN STA. 4+45 & STA. 6+06.5 (R.S. 1049)
SIDEWALK ON MAGNOLIA AVENUE BETWEEN CANTERBURY RD. & ADAMS ST.

HORIZ. SCALE: 1" = 20' VERT. SCALE: 1" = 4

PROJECT NO. R-1044
SHEET 1 OF 1
FILE NO. 4071

GENERAL NOTES:

1. It shall be the responsibility of the contractor to clear the right of way in accordance with the provisions of law as it affects each utility including irrigation lines and appurtenances and at no cost to the city.
2. Construction shall be in accordance with the city of Riverside, Department of Public Works, Specifications No. 361 and Standard Drawings.
3. Prime coat, seal coat, and paint binder are required.
4. Grading will require a permit under Ordinance 3023 for a cut or a fill exceeding 100 cubic yards, or a fill over one foot in depth.
5. Trim edge of existing pavement, where new paving joins existing pavement, to a clean straight line. Construct match-up paving as shown and/or ordered by or directed in the field to produce a smooth surface.
6. ~~The Developer's civil engineer for a part of the soil mechanics investigation shall be employed by a soils engineer. Depth and type of cover shall be determined by the soils engineer and approved by the City of Riverside for approved subgrade.~~
7. The finished subgrade shall have a compaction of not less than 90% for a depth of 0.5 feet as determined by test method No. "California 216 F" immediately prior to placement of the cover.

BENCH MARK: City B.M. - Pk. nail in lead in center of S.W. curb return Adams and Magnolia. Elev. R.B. R.B-72 - Elevation 799.01 = used for this Plan Elevation 798.19
Set T.B.M. #1 16d nail in R.R. # 1341 (+) located 25± N.W'ly of N.W'ly end of Alley. - Elevation 793.57